



THIS DRAWING IS FOR
PLANNING PURPOSES ONLY

BUILDING No. 1

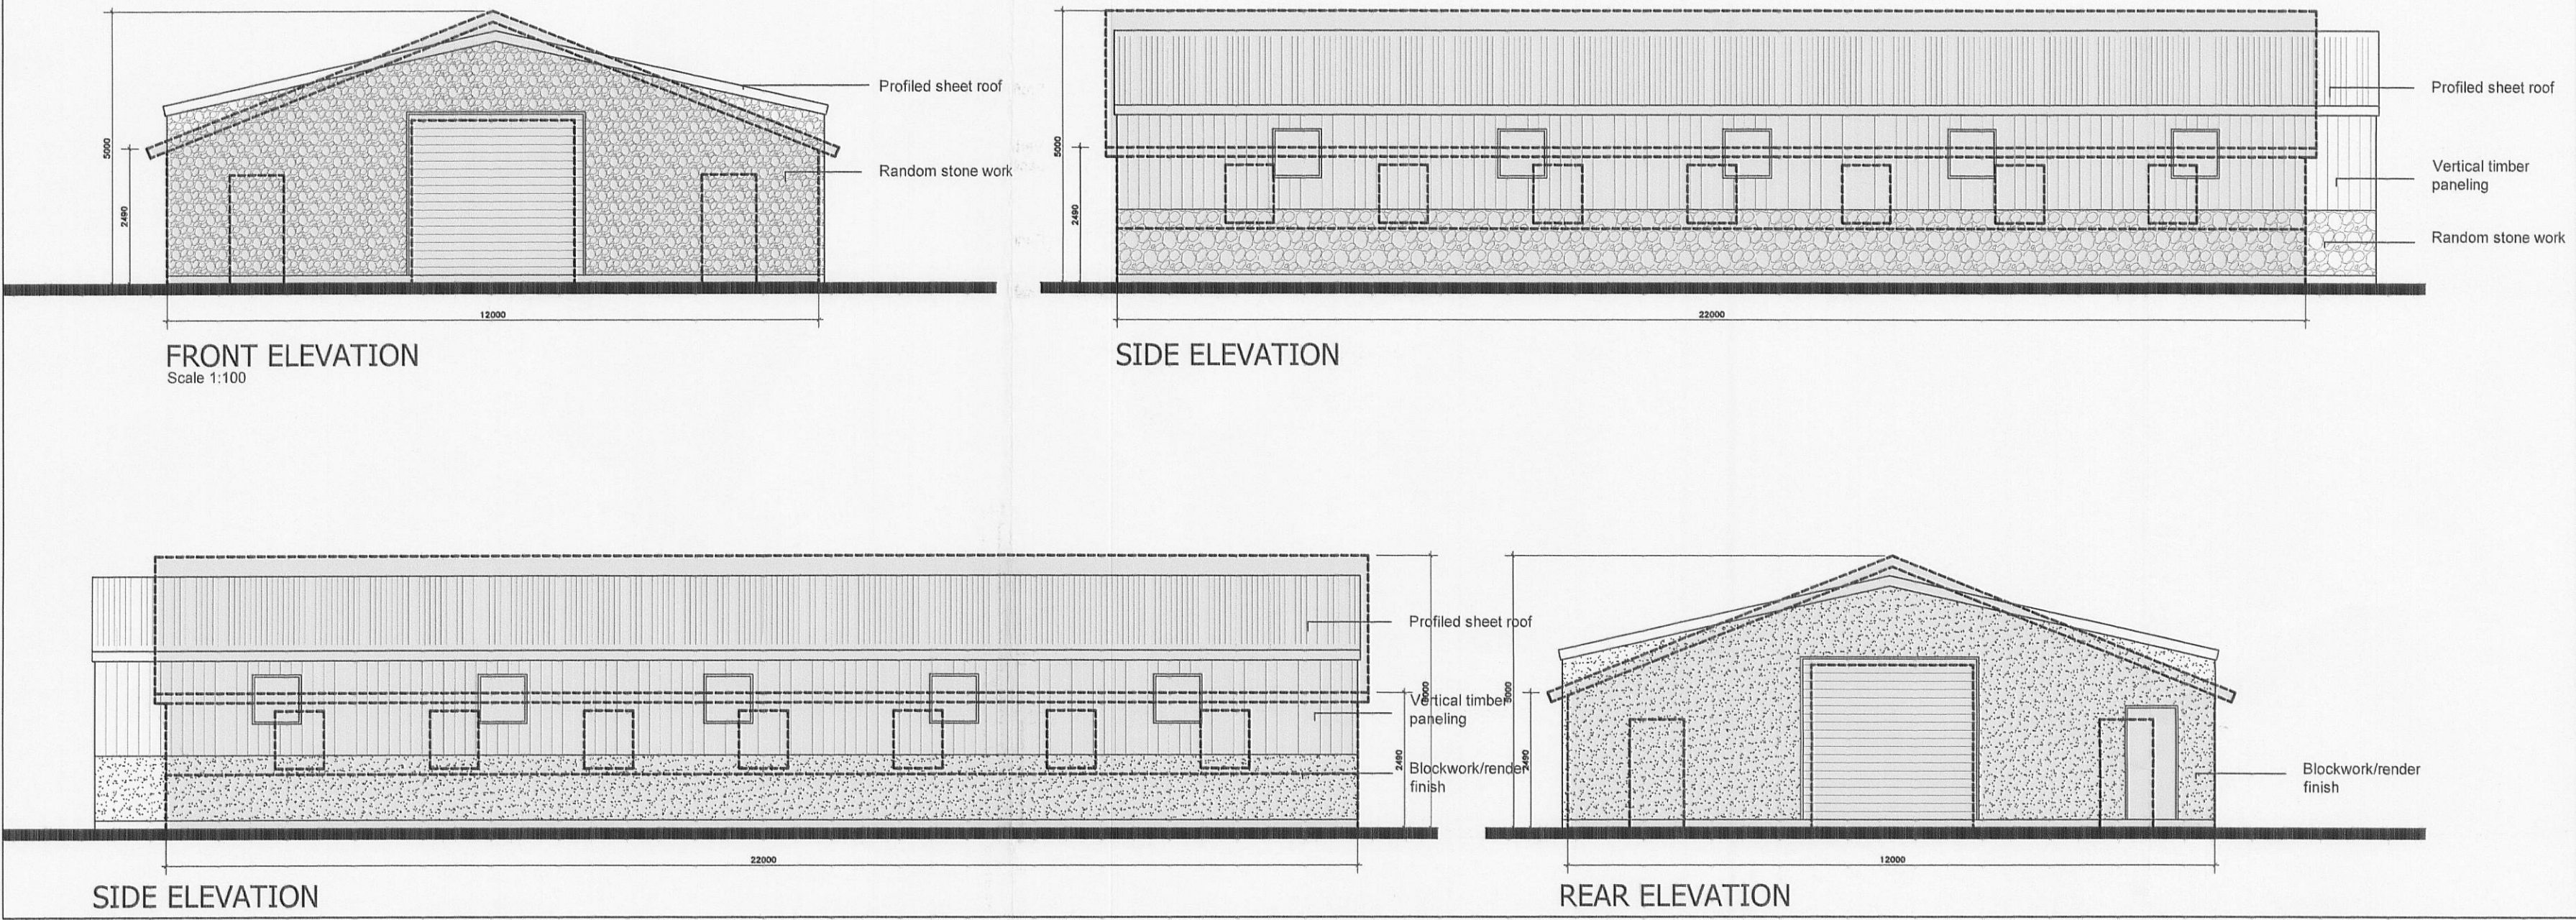

BUILDING No. 2

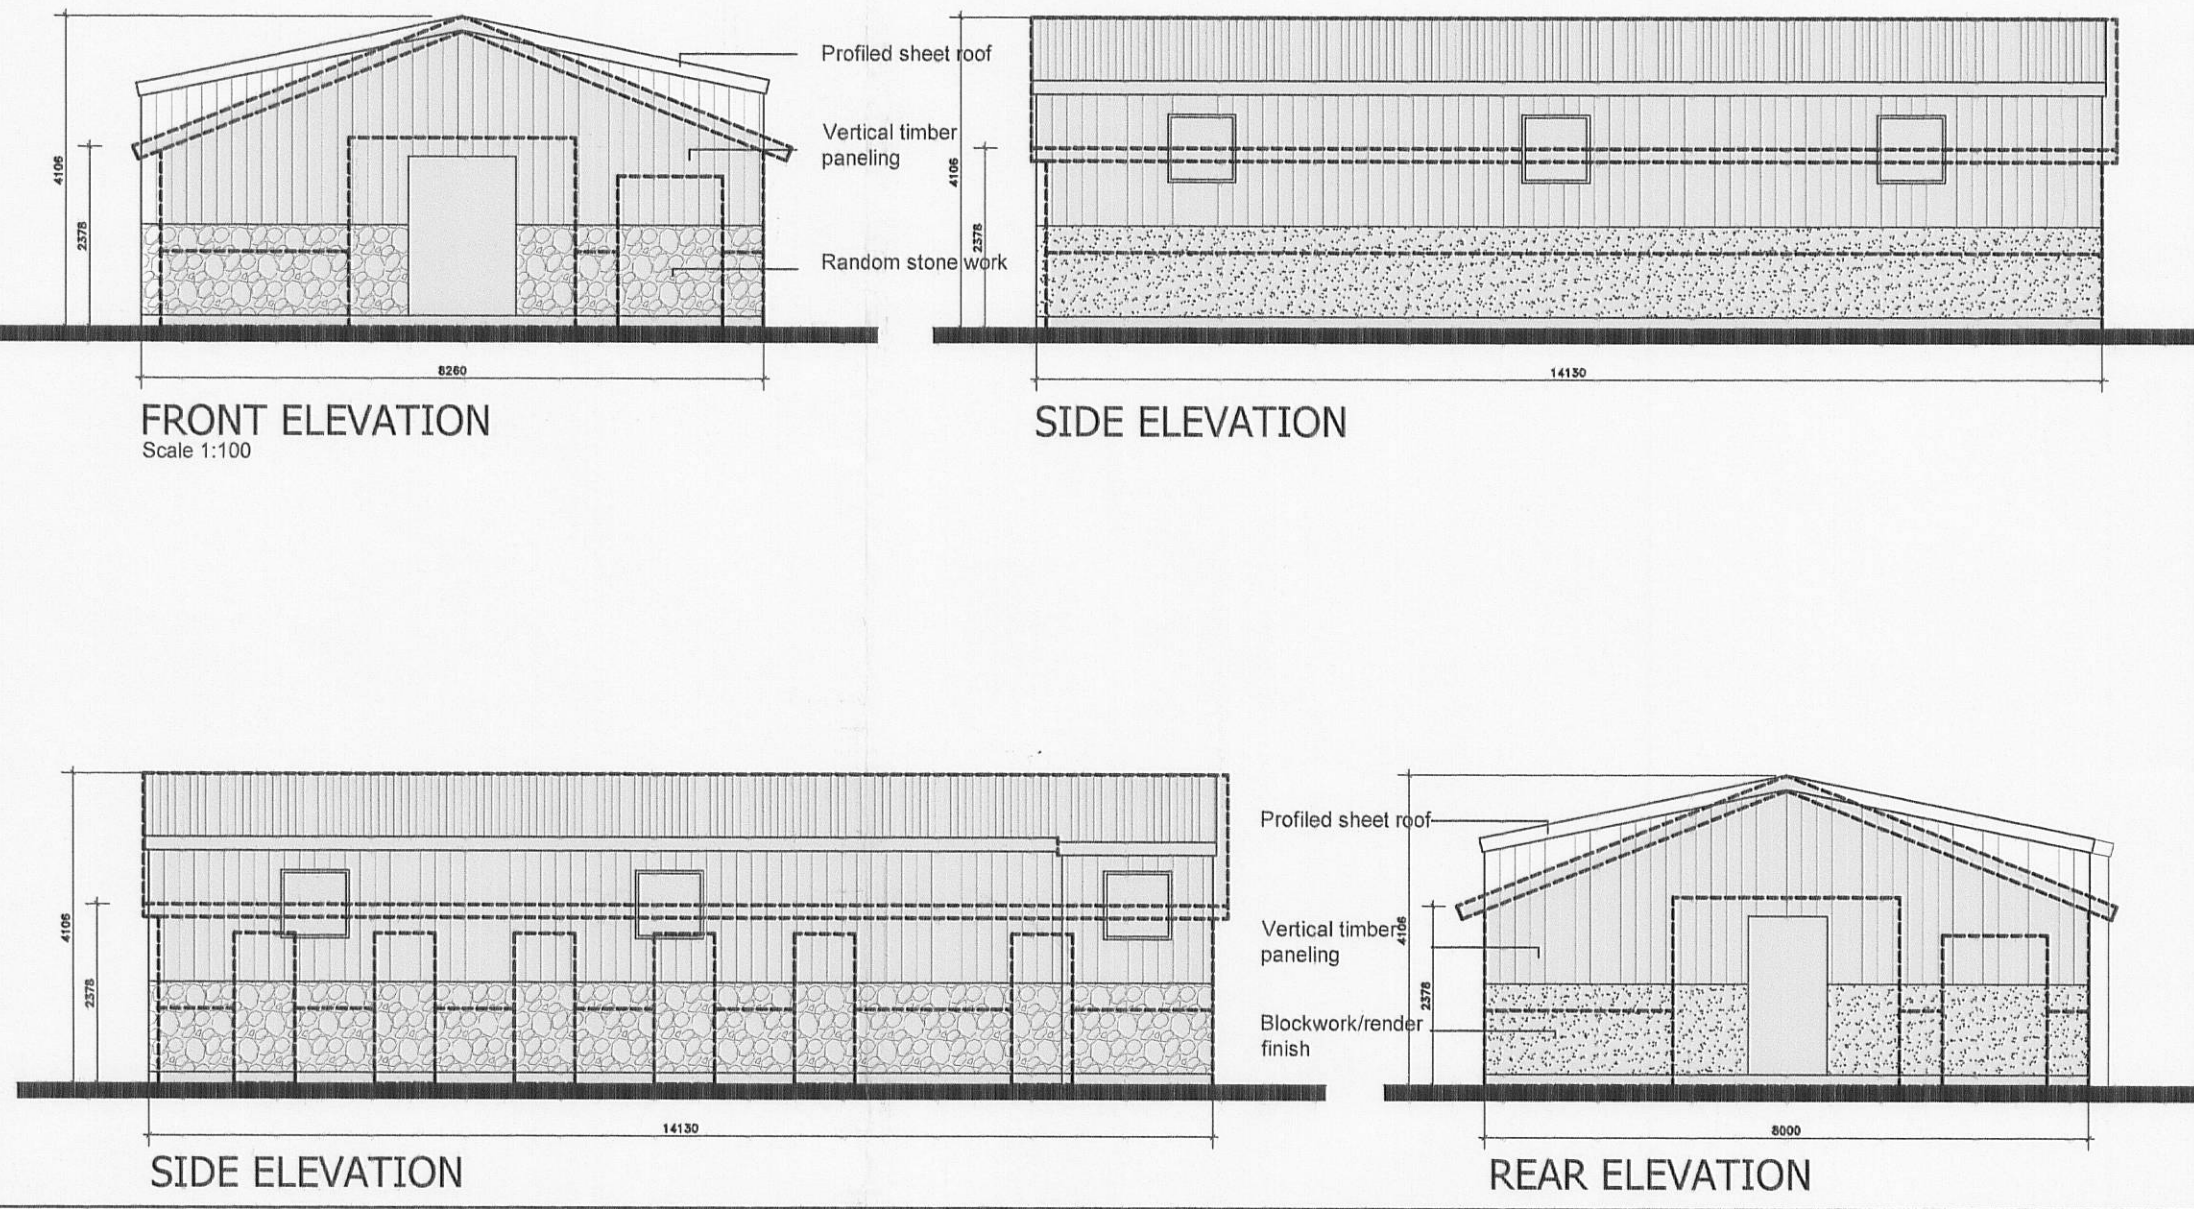


PROPOSED SITE LAYOUT
Scale 1:100

General Notes:
This drawing/design is for use solely in connection with the project.
This drawing/design is the copyright of the designer and must not be issued, loaned or
copied without written consent.
Do not scale the drawing. All dimensions to be checked on site prior to commencement of
work and any discrepancy shall be immediately reported and resolved prior to work
commencing. This drawing is to be read in conjunction with all relevant drawings and
specifications relating to the job, whether or not located on this drawing.

Shaded area denotes extent of
buildings previously approved.
Reference number: 3040614

3 2 0 0 7 0 6 2 9 P

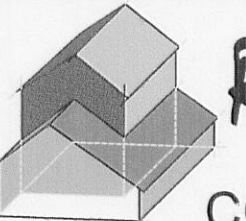A External dimensions added to elevations.		27/06/07
Rev.	Description	Date
 RS DESIGN CONSULTANCY 7 cromwell way, penwortham, preston, pr1 9eb tel : 01772 330245		
Client BOWLAND FELL PORK SAUSAGES		
Project BLUE BELL FARM LONGRIDGE		
Drawing Title COMPARISON OF AS BUILT PLANS AND ELEVATIONS WITH APPROVED SCHEME		
Scale 1:100	Date MAY 07	
Dwg No PR-02	Rev. A	Job No 07-121
Drawing Status PLANNING		