




Proposed stable building & outdoor Menage at, York Field, York Lane, Langho, Blackburn~

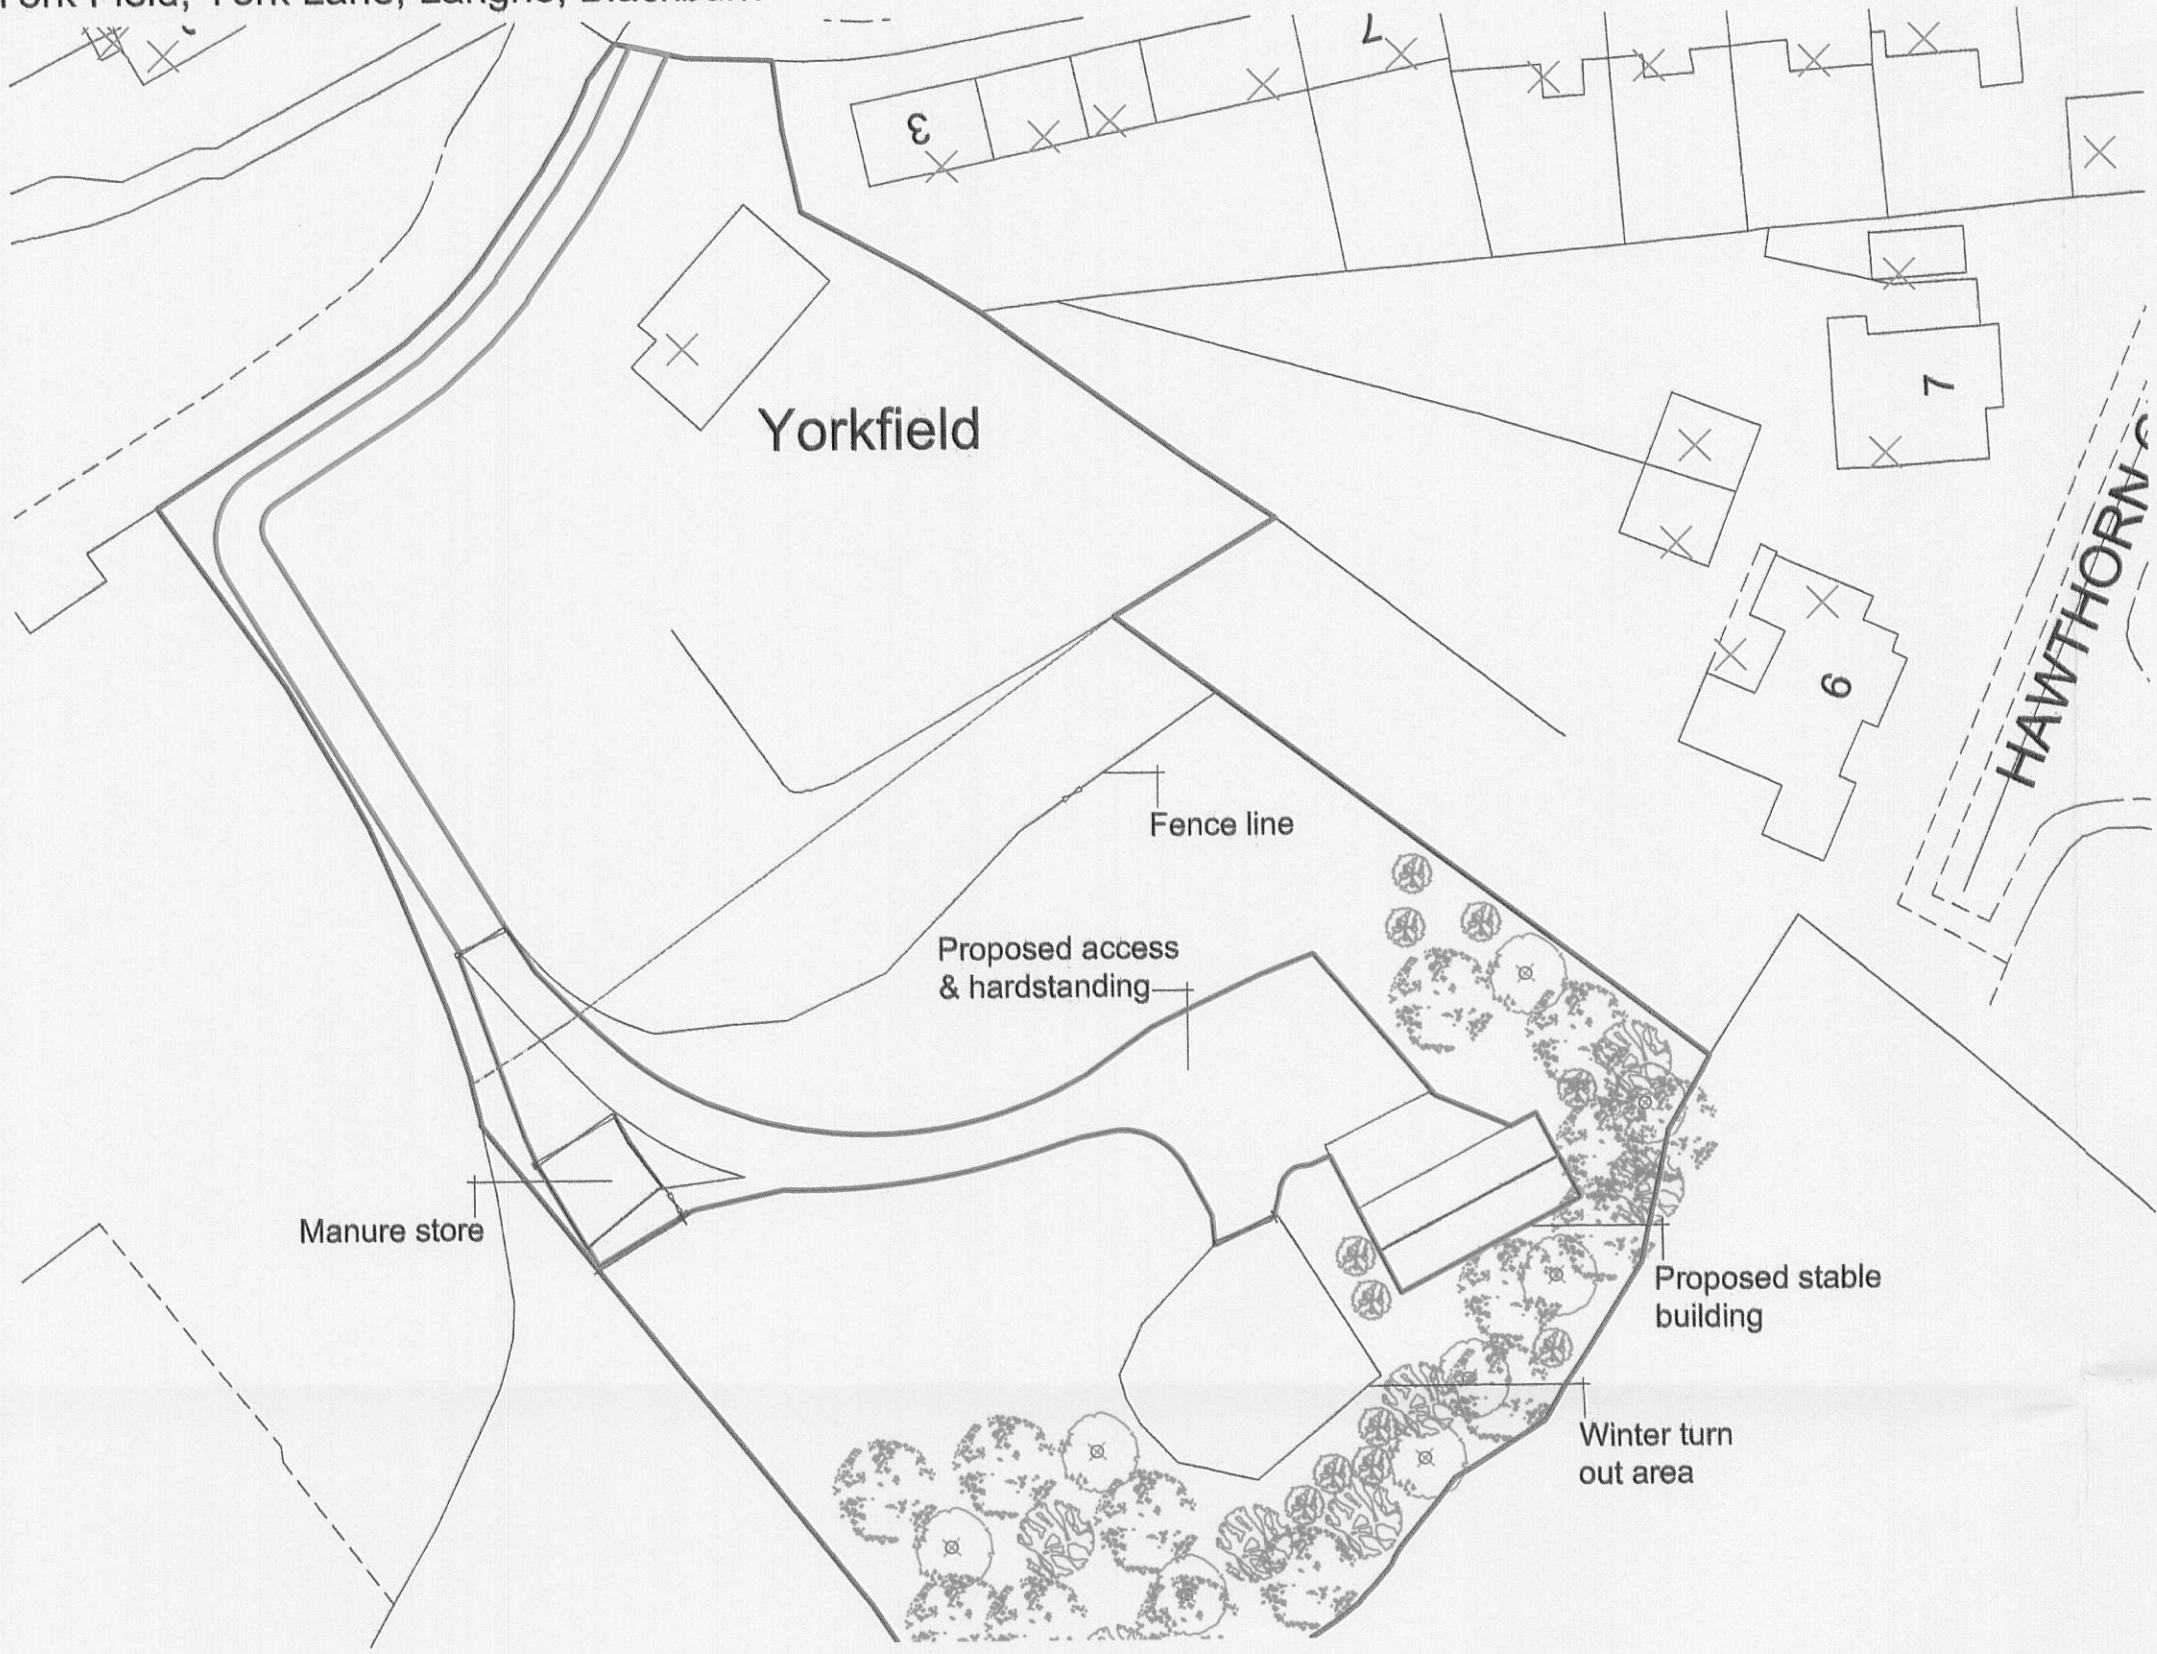


Proposed Site Plan 1:500

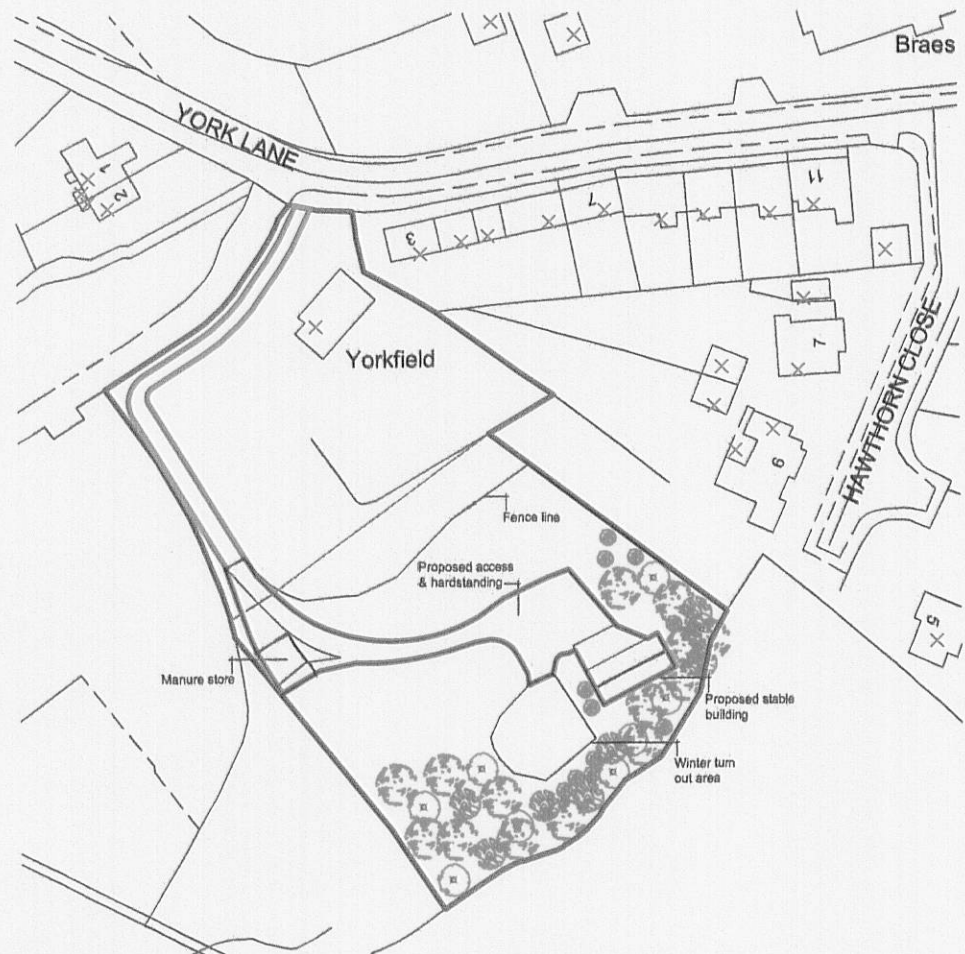


Proposed Location Plan 1:1250

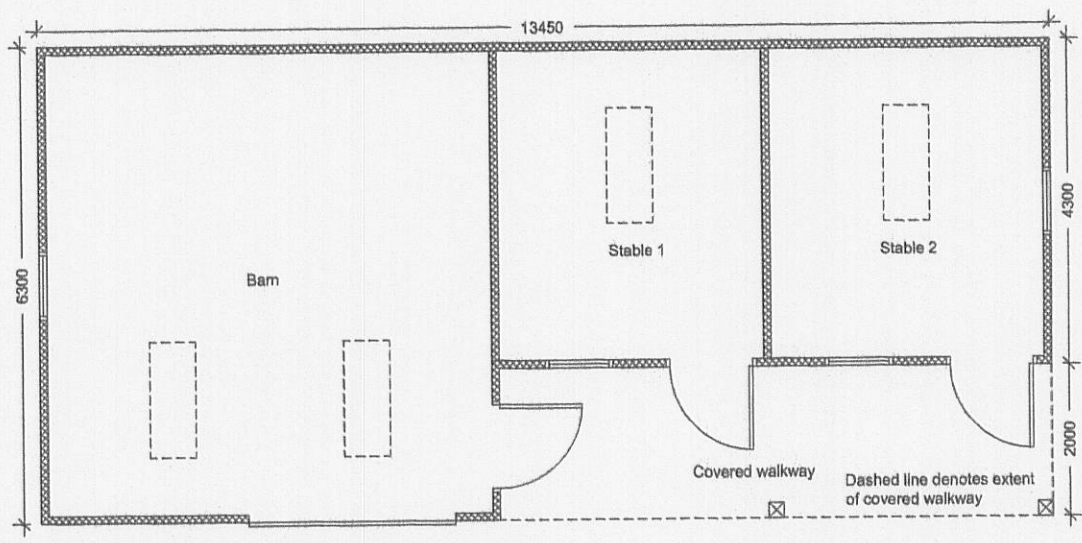


Proposed Floor Plan 1:100

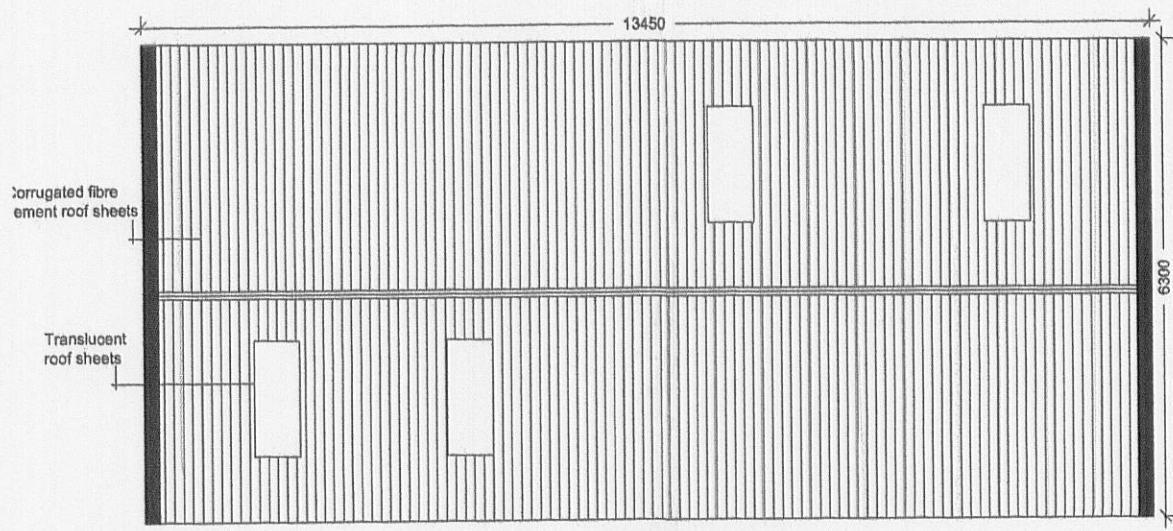


Proposed Roof Plan 1:100

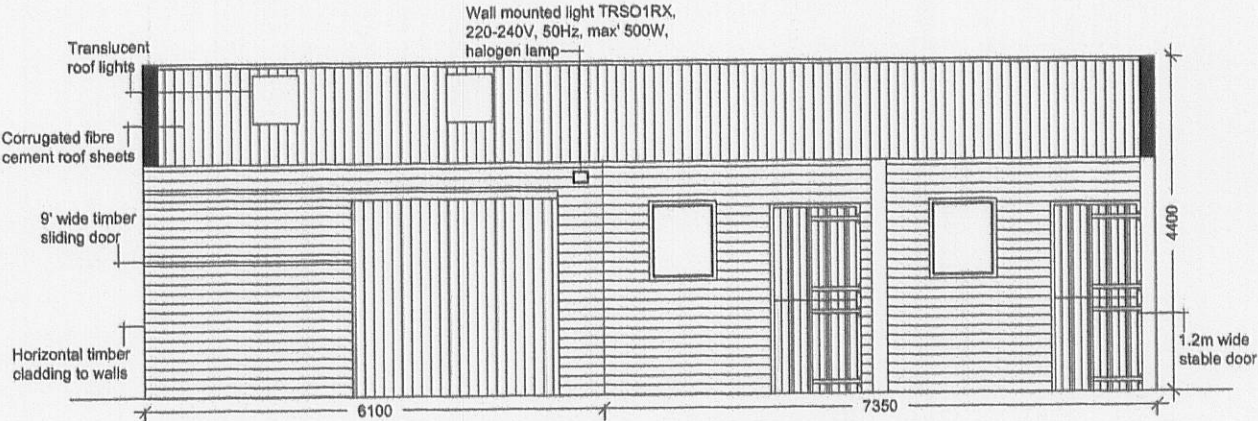


Proposed North Westerly Elevation 1:100

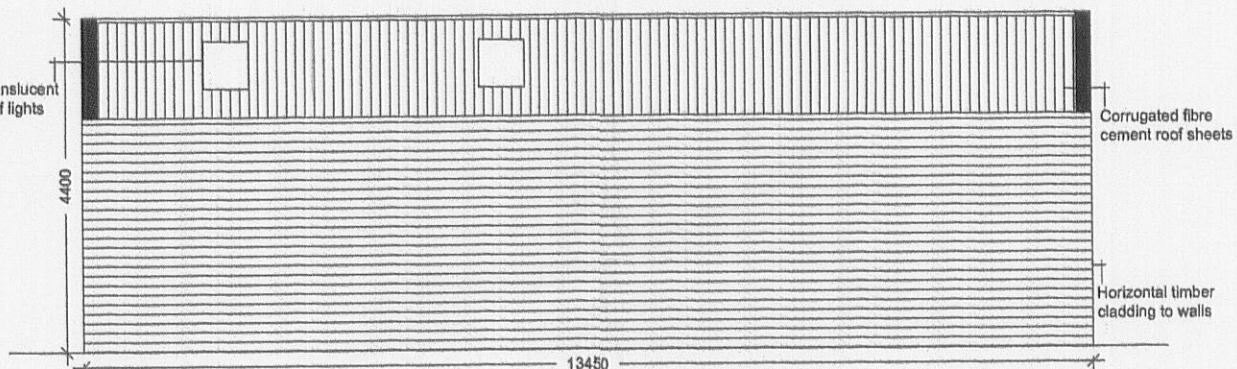


Proposed South Easterly Elevation 1:100

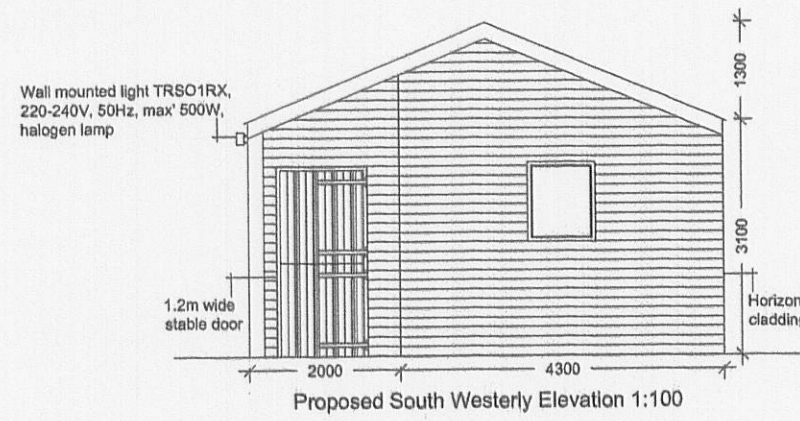

Proposed South Westerly Elevation 1:100

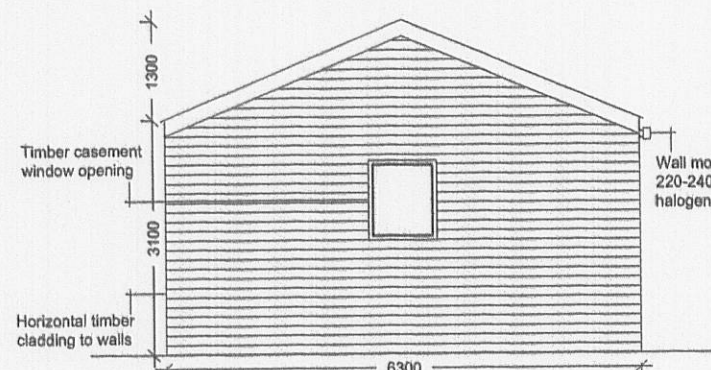

Proposed North Easterly Elevation 1:100

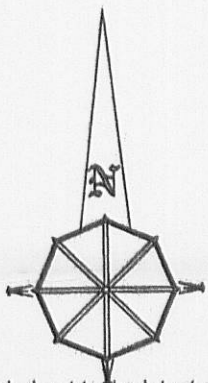

Notes:

All work is to be carried out to the latest current British standards Codes of Practice and recognised working practices.

All work and materials should comply with Health and Safety legislation.

All dimensions are in millimetres where explicitly shown otherwise.

The contractor should check and certify all dimensions as work proceeds and notify the architect of any discrepancies.

Do not scale off the drawings, if in doubt ask.

Amendment A: 06.01.11 amend plans to reflect as built details. Plans re-submitted to LPA for approval

PLANNING DRAWINGS - proposed elevations, floor plan, roof plan, site plan & location plan



Chartered Surveyors
34 Wellgate
Clitheroe
Lancashire BB7 2DP

T: 01200 442301
F: 01200 442302
Email: info@ghaonline.co.uk

Title: Proposed stable building & outdoor Menage at York Field
York Lane
Langho
Blackburn
BB6 8DT

Project No: Ken/288/721/01 Drawn: AJM

Client: Mr & Mrs Kenyon

Date: 06.01.11 Scale: 1:100/500/1250

Amendments: A