




Notes

Jennings Design Associates take no responsibility for any dimensions obtained by scaling from this drawing. If no dimension is shown the recipient must ascertain the dimension specifically from the Architect or by site measurement. Supplying this drawing in digital form is solely for convenience and no reliance may be placed on digital data. All data must be checked against hard copy. Dimensions must be checked on site. Any discrepancies must be reported to the Architect immediately. This drawing is copyright of Jennings Design Associates

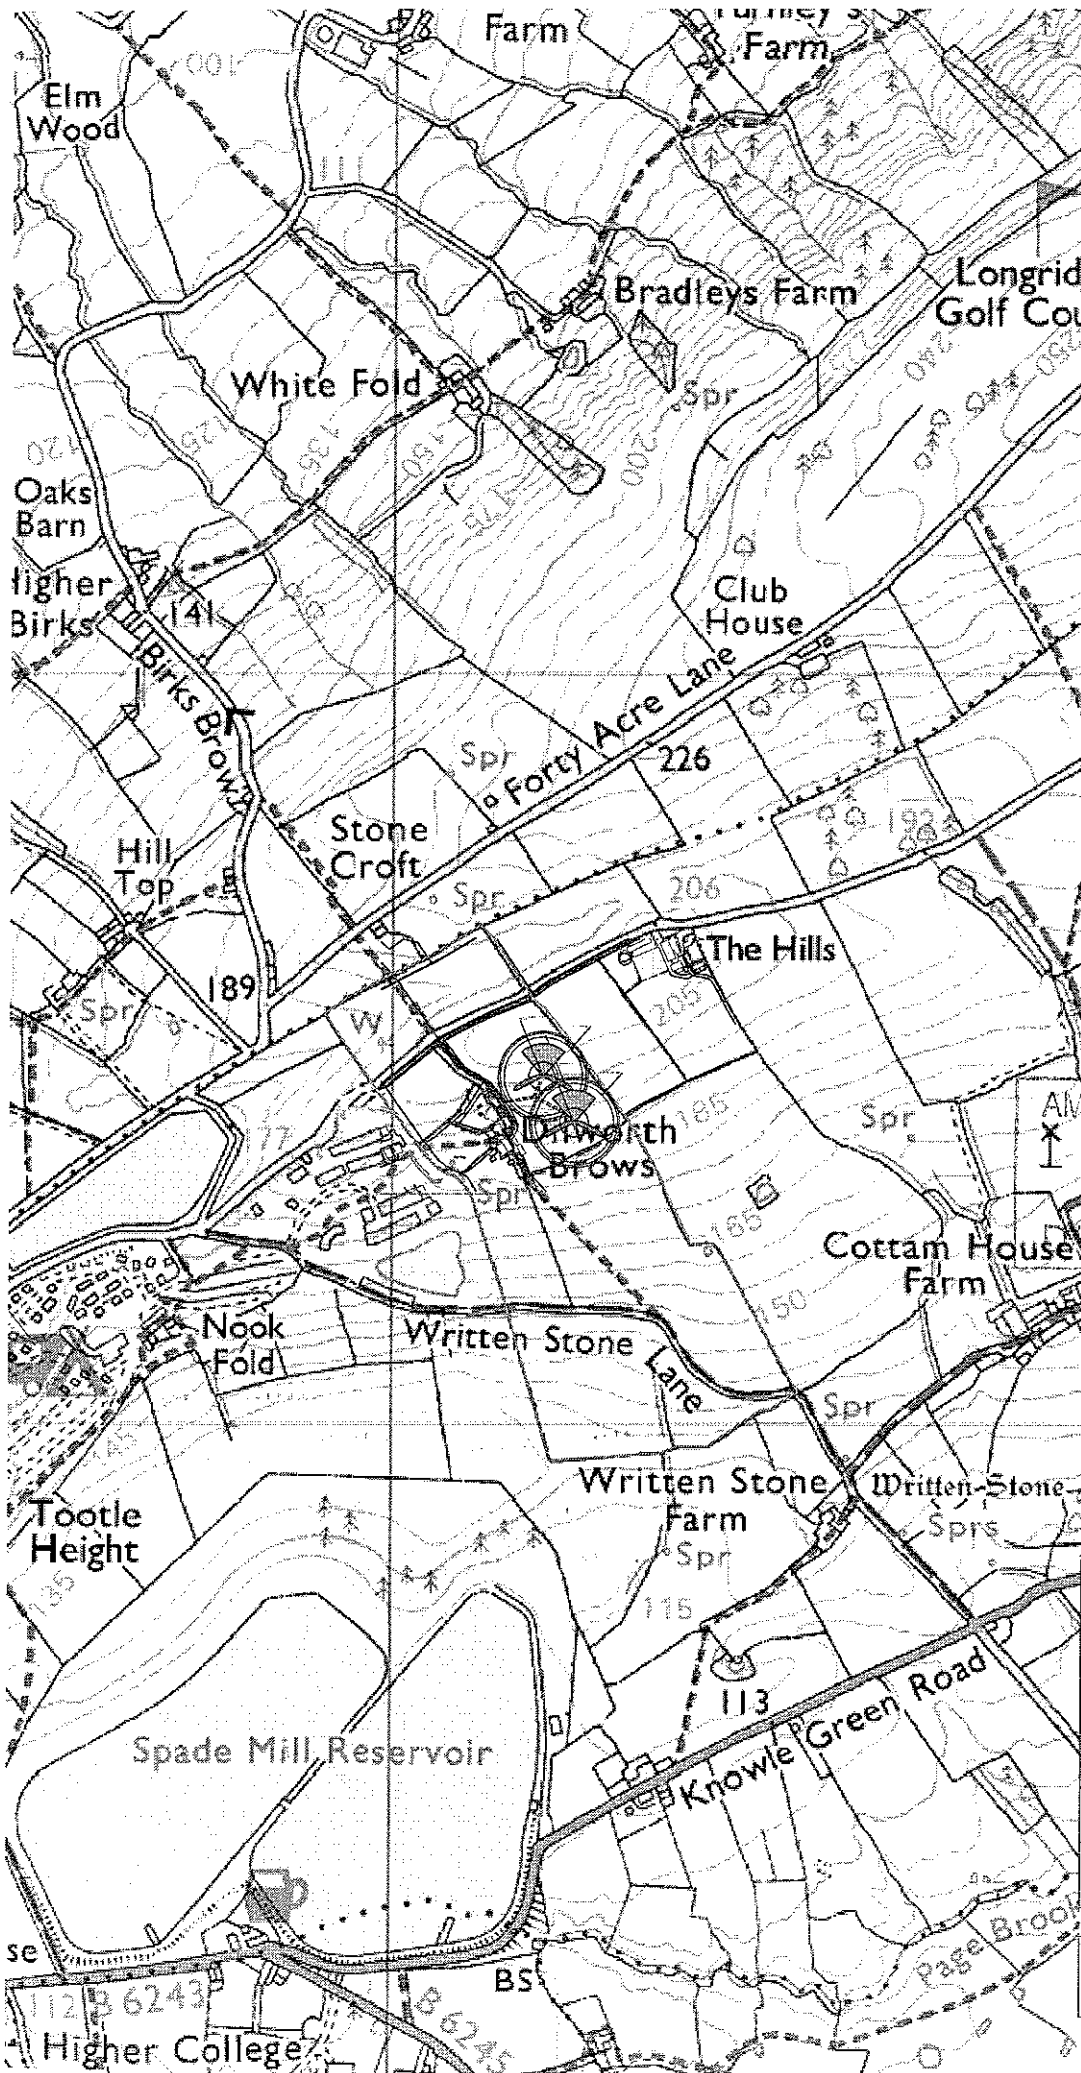

Proposed installation of 2 No Wind Turbines

TURBINE 1
362198 - Easting
438464 - Northing

TURBINE 2
362241 - Easting
438400 - Northing

320110734P

AMENDED PLANS RECEIVED

DATE	16/01/12		
C	Change to turbine location, Changes made to boundary fence zone	10-01-2012	NS
B	Added Site Boundary	13-10-2011	NS
A	Removed Zone of Audibility	04-10-2011	NS
Rev	Description	Date	By


Jennings Design Associates
Architects

Architects Designers Project Managers
The Warehouse Saxon Street Denton
Manchester M34 3DS
T: 0161 335 5011 F: 0161 320 0512 E: jda@jda-architects.co.uk
Mr John Proctor
Brow's Farm, Higher Road Longridge
Preston, PR3 2YX - Wind Turbines
Location Plan 1: 10 000

Drawing Number	KE0033-003	Rev	C	Scale	1:10,000	Sheet	A4	Date	31-08-2013
Drawn by	Craig M	Checked by	BJ						

Pr	Preliminary	C	Contract
P	Feasibility	Cr	Construction
F	Planning	As	As Built
T	Tender	Other	

Z:\N630 - Kinetic Energy 01 TURBINE PROJECTS\KE0033 John Proctor - The Browns Farm - Longridge Drawings\Xrefs\Xref-John Proctor - Browns Farm.dwg

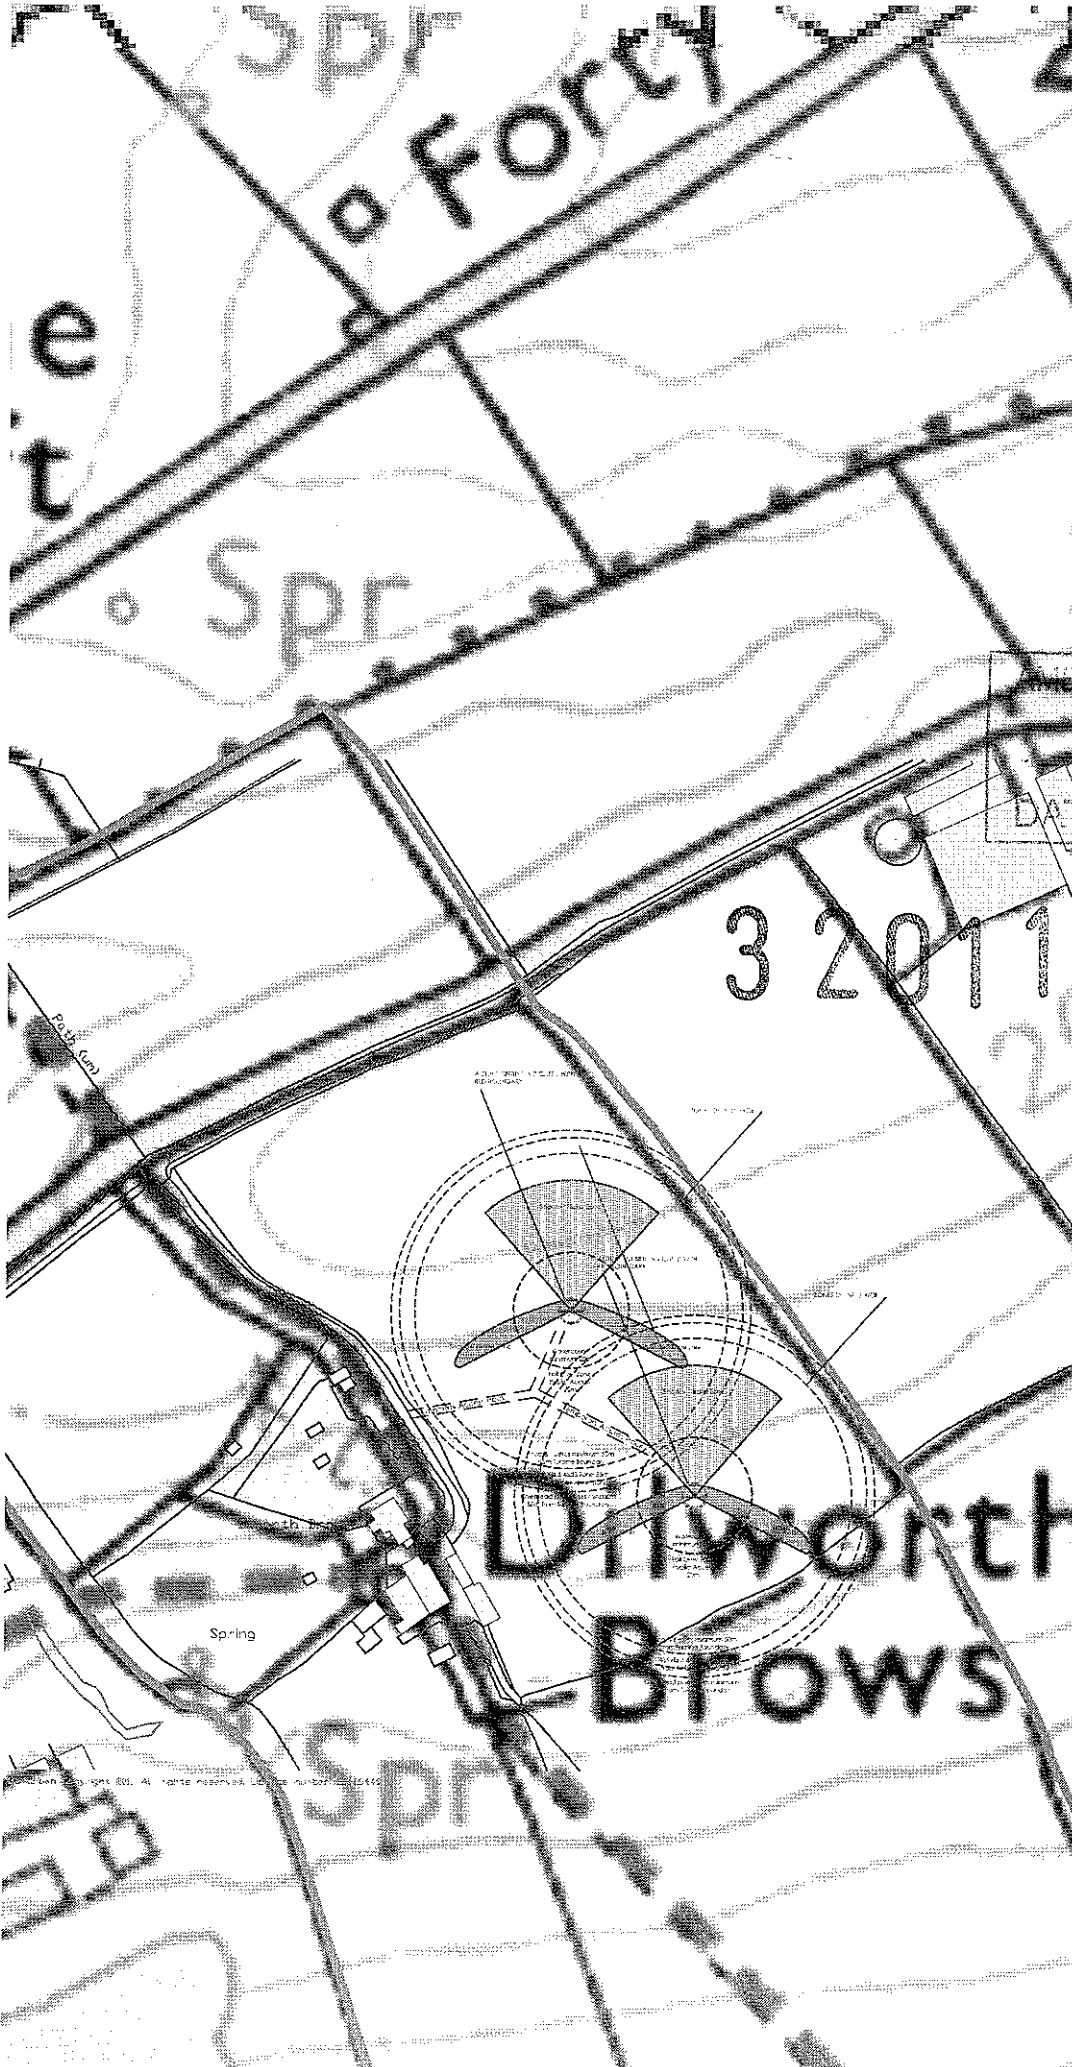

Notes

Jennings Design Associates take no responsibility for any dimensions obtained by scaling from this drawing. If no dimension is shown the recipient must ascertain the dimension specifically from the Architect or by site measurement. Supplying this drawing in digital form is solely for convenience and no reliance may be placed on digital data. All data must be checked against hard copy. Dimensions must be checked on site. Any discrepancies must be reported to the Architect immediately. This drawing is copyright of Jennings Design Associates.



Proposed installation of 2 No Wind Turbines

TURBINE 1
362198 - Easting
438464 - Northing

TURBINE 2
362241 - Easting
438400 - Northing

AMENDED PLANS RECEIVED
DATE 16/01/12

Rev	Description	Date	By
C	Change turbine location. Changes made to Turbine 1 and 2	03-01-2012	NS
B	Add Site Boundary	13-10-2011	NS
A	Removed Zone of Audibility	26-10-2011	NS

Jennings Design Associates
Architects

Architects Designers Project Managers
The Warehouse Saxon Street Denton Manchester M34 3DS
T: 0161 326 501 F: 0161 320 0312 E: jda@jda-archi.co.uk

Mr John Proctor
Brows Farm, Higher Road Longridge Preston, PR3 2YX - Wind Turbines

Site Plan 1: 2 500

Drawing Number	Ref	Scale	Sheet
KE0033-002	C	1:2500	A4
		Drawn by: Craig M	Checked by: BJ

Pr	Preliminary	C	Contract
F	Feasibility	Cn	Construction
P	Planning	As	As Built
T	Tender	Other	

Z:\630 - Kinetics Energy\01 TURBINE PROJECTS\KE0033 John Proctor - The Brows Farm - Longridge\Drawings\Xrefs\Xref-John Proctor - Brows Farm.dwg


Notes

Jennings Design Associates take no responsibility for any dimensions obtained by scaling from this drawing. If no dimension is shown the recipient must ascertain the dimension specifically from the Architect or by site measurement. Supplying this drawing in digital form is solely for convenience and no reliance may be placed on digital data. All data must be checked against hard copy. Dimensions must be checked on site. Any discrepancies must be reported to the Architect immediately. This drawing is copyright of Jennings Design Associates.



ACTUAL TURBINE INDICATED WITH RED BOUNDARY

ZONES OF INFLUENCE

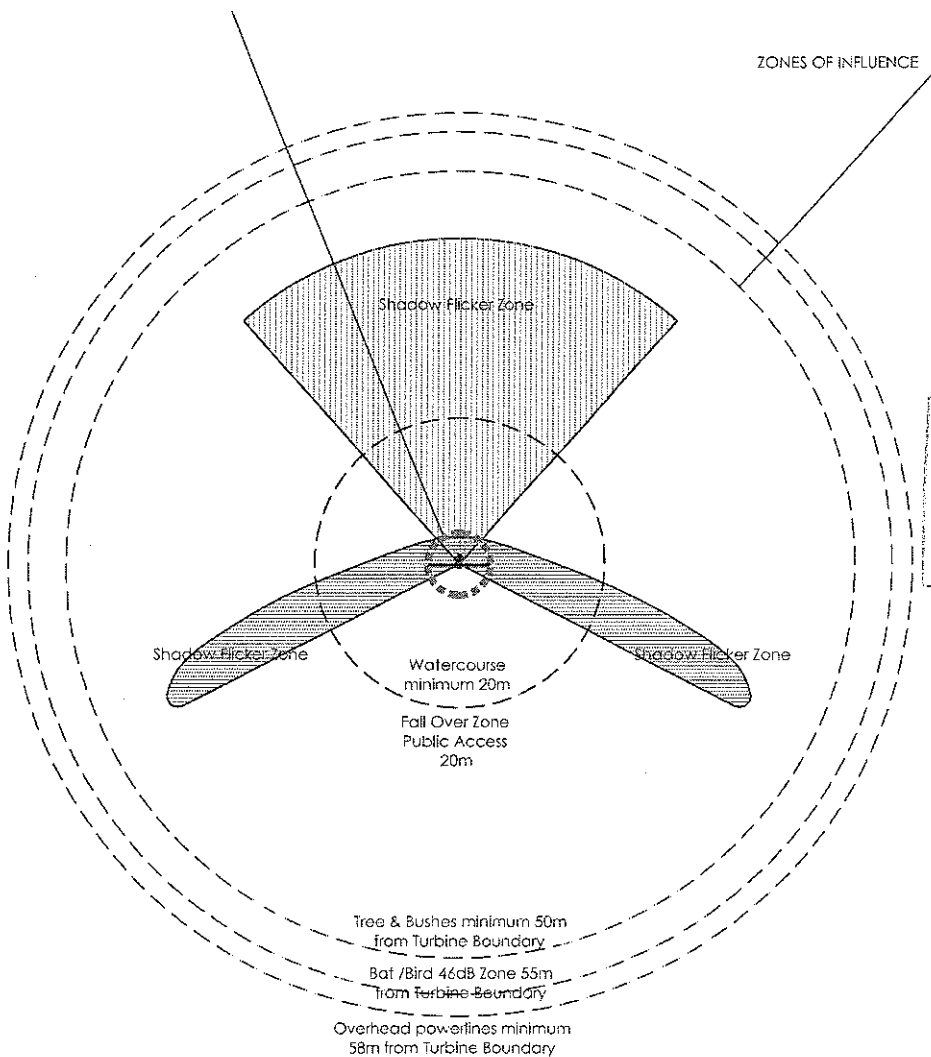

AMENDED PLANS RECEIVED


DATE 16/01/12

Rev	Description	Date	By
B	Change made to Shadow Flicker Zone	09-01-2012	NS
A	Removed Zone of Audibility	04-10-2011	NS

Jennings Design Associates
Architects

Architects Designers Project Managers			
The Warehouse Saxon Street Denton Manchester M34 3DS			
Tel: 0161 334 5011 Fax: 0161 320 0512 E: jda@jda-architects.com			
Mr John Proctor			
Brows Farm, Higher Road Longridge Preston, PR3 2YX - Wind Turbines			
Turbine Plan 1: 1 000			
Drawing Number	Rev	Scale	Date
KE0033-004	B	1:1000	21-03-2011
		Drawn by: Craig M	Checked by: SJ

Pr	Preliminary	C	Contract
F	Feasibility	Cn	Construction
P	Planning	As	As Built
T	Tender	Other	

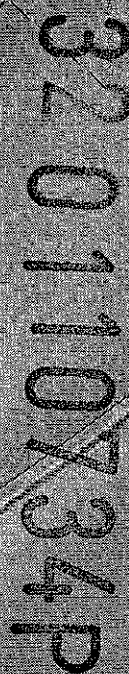

16/01/12

[illegible]



Notes

Jennings Design Associates have no responsibility for any dimensions obtained by scaling from this drawing. If no dimension is shown the recorder must ascertain the dimension specifically from the Architect or by site measurement. Supplying this drawing in digital form is solely for convenience and no reliance may be placed on digital data. All data must be checked against hard copy. Dimensions must be checked on site. Any discrepancies must be reported to the Architect immediately. This drawing is copyright of Jennings Design Associates.



Proposed installation of 2 No Wind Turbines

TURBINE 1
362198 - Easting
438464 - Northing

TURBINE 2
362241 - Easting
438400 - Northing

AMENDED PLANS RECEIVED

DATE 16/01/12

320110734P

Rev	Description	Date	By
C	Change turbine location, Change side to Shadow Flicker Zone	04-01-2012	NS
B	Added Site Boundary	12-10-2011	NS
A	Removed Zone of Audibility	06-02-2011	NS

Jennings Design Associates
Architects

Architects Designers Project Managers
The Warehouse Saxon Street Denton
Manchester M34 3DS
T: 0161 336 5011 F: 0161 326 0022 E: jda@jda-uk.co.uk

Mr John Proctor
Brows Farm, Higher Road Longridge
Preston, PR3 2YX - Wind Turbines

Site Plan 1: 1250
Drawing Number: KE0033-001
Rev: C
Scale: 1:1250
Date: 31-08-2011
Drawn by: Craig M
Checked by: BJ

P	Preliminary	C	Contract
F	Feasibility	Cn	Construction
P	Planning	As	As Built
T	Tender	Other	-



Notes

Jennings Design Associates take no responsibility for any dimensions obtained by scaling from this drawing. If no dimension is shown the recipient must ascertain the dimension specifically from the Architect or by site measurement. Supplying this drawing in digital form is solely for convenience and no reference may be placed on digital data. All data must be checked against hard copy. Dimensions must be checked on site. Any discrepancies must be reported to the Architect immediately. This drawing is copyright of Jennings Design Associates.



Proposed installation of 2 No Wind Turbines

TURBINE 1
362198 - Easting
438464 - Northing

TURBINE 2
362241 - Easting
438400 - Northing

3 201 10734

AMENDED PLANS RECEIVED
DATE 16/01/12

Rev	Description	Date	By

Jennings Design Associates
Architects

Architects Designers Project Managers			
The Warehouse, Saxon Street, Denton, Manchester M34 3DS			
T: 0161 336 5011 F: 0161 226 0512 E: jda@jda-architects.com			
Mr John Proctor			
Brows Farm, Higher Road Longridge, Preston, PR3 2YX - Wind Turbines			
Site Plan 1: 1250 Without Zones			
Drawing Number	Rev	Scale	Date
KE0033-006	-	1:1250 A3	03-01-2012
Drawn by	NS	Checked by	BJ

Pr	Preliminary	C	Contract
F	Feasibility	Cn	Construction
P	Planning	As	As Built
T	Tender	Other	-

Z:\630 - Kinetic Energy\01 TURBINE PROJECTS\KE0033 John Proctor - The Brows Farm - Longridge Drawings\Xrefs\Xref-John Proctor - Brows Farm.dwg