


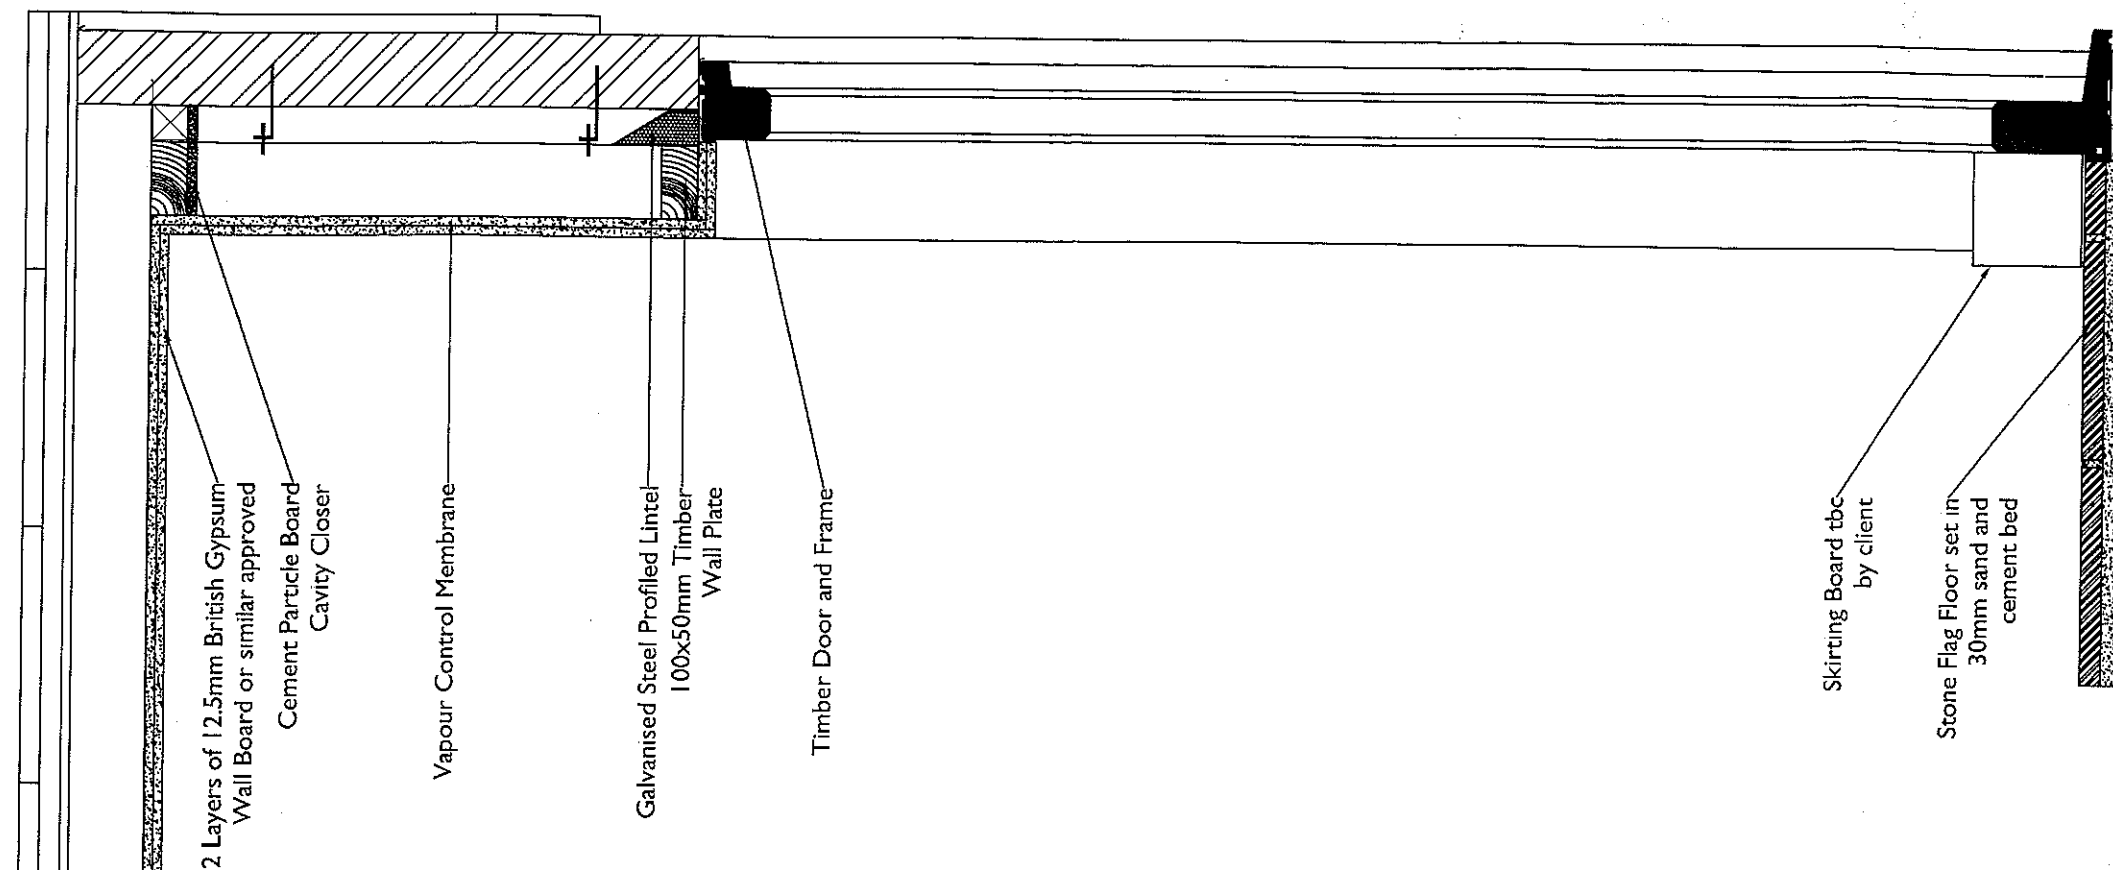


Section A-A
Scale 1:10


320120066P

Notes
For Plans and Elevations refer to DNA drawing
1022-CG-100
All Dimensions in mm
Do Not Scale


Notes				DNArchitectural 8 Grosvenor Court, Kendal. LA9 4BE			DNArchitectural 		
Rev	Detail	Date	Initial		Initials	Date	Cow Gill House		
				Drawn	DN	01.12.2011			
				Checked	DN	01.12.2011			
				Drawing Number					
				1022-CG-101					
							Extension Sectional Details		
							Rev First		

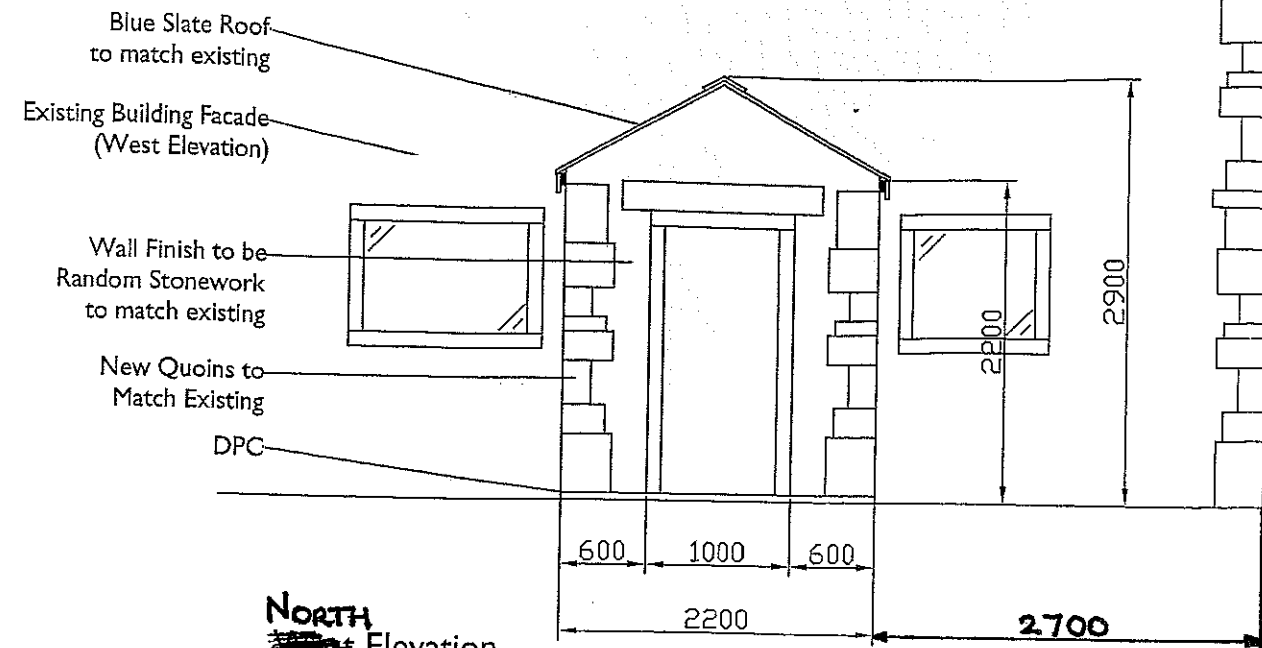


NORTH
~~West~~ Elevation
Scale 1:50

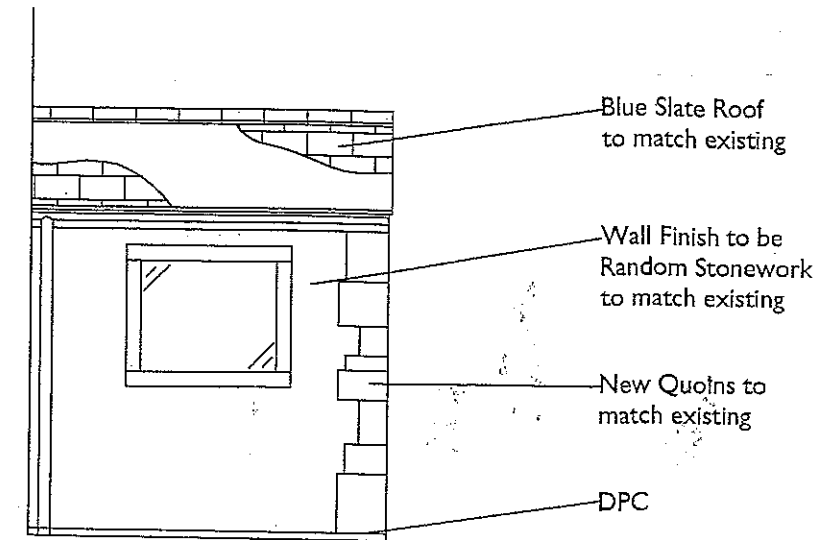

EAST + WEST
~~South~~ Elevation
Scale 1:50

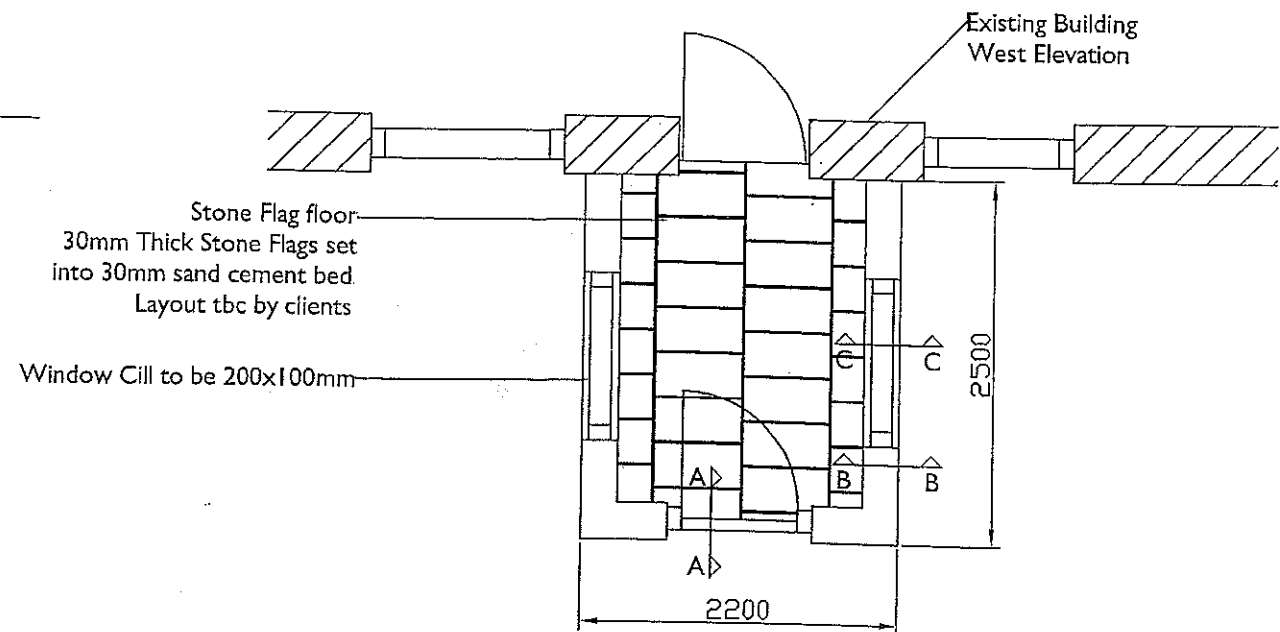

Plan Layout
Scale 1:50

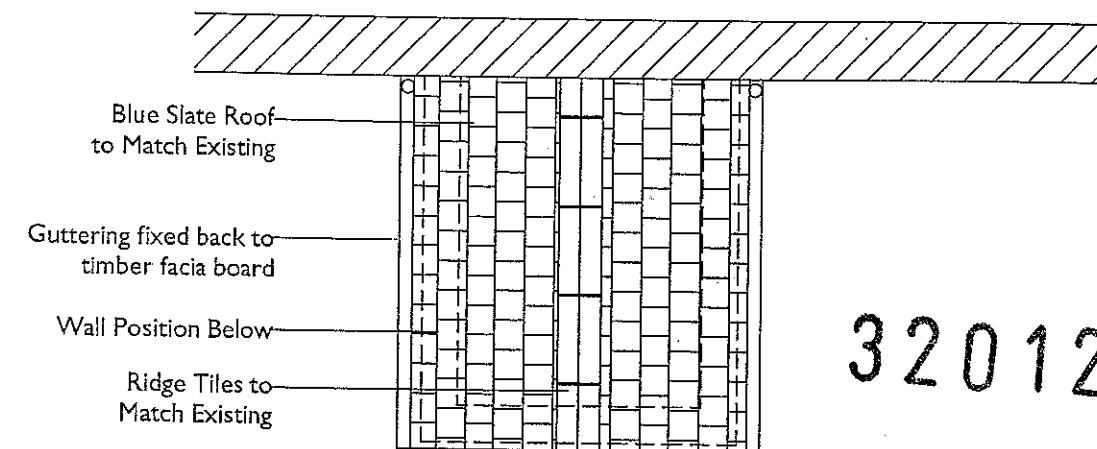

Roof Plan
Scale 1:50

Notes
For Sections A, B and C refer to DNA drawings
1022-CG-101 to 103
All Dimensions in mm
Do Not Scale

Notes				DNArchitectural 8 Grosvenor Court, Kendal. LA9 4BE			DNArchitectural 	
Rev	Detail	Date	Initial		Initials	Date	Cow Gill House	
				Drawn	DN	01.12.2011		
				Checked	DN	01.12.2011		
				Drawing Number			Extension Plans and Elevations	
				1022-CG-100				
							Rev First	

320120066 P