
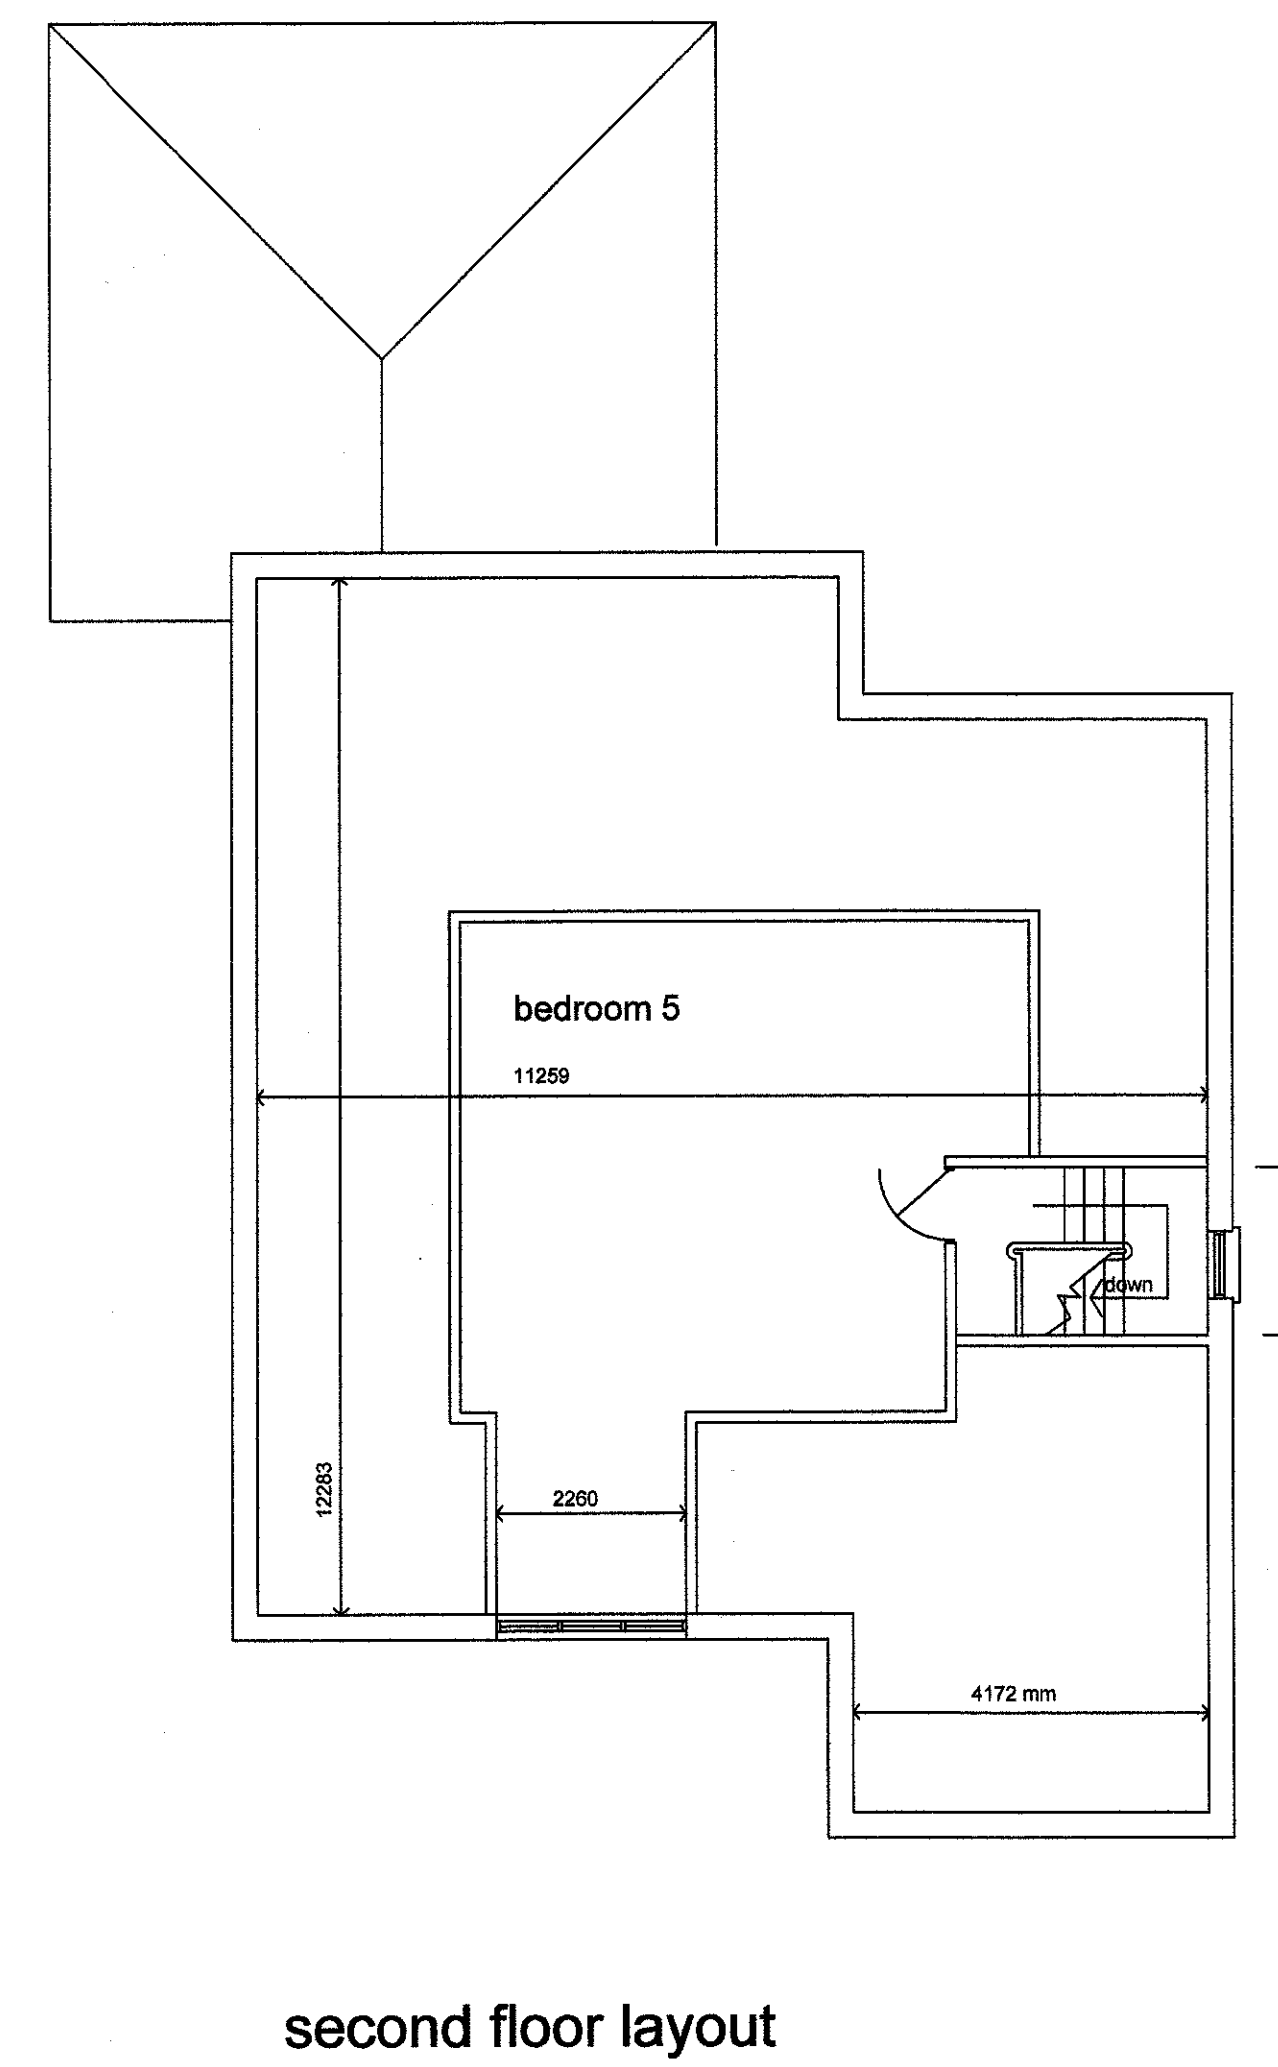
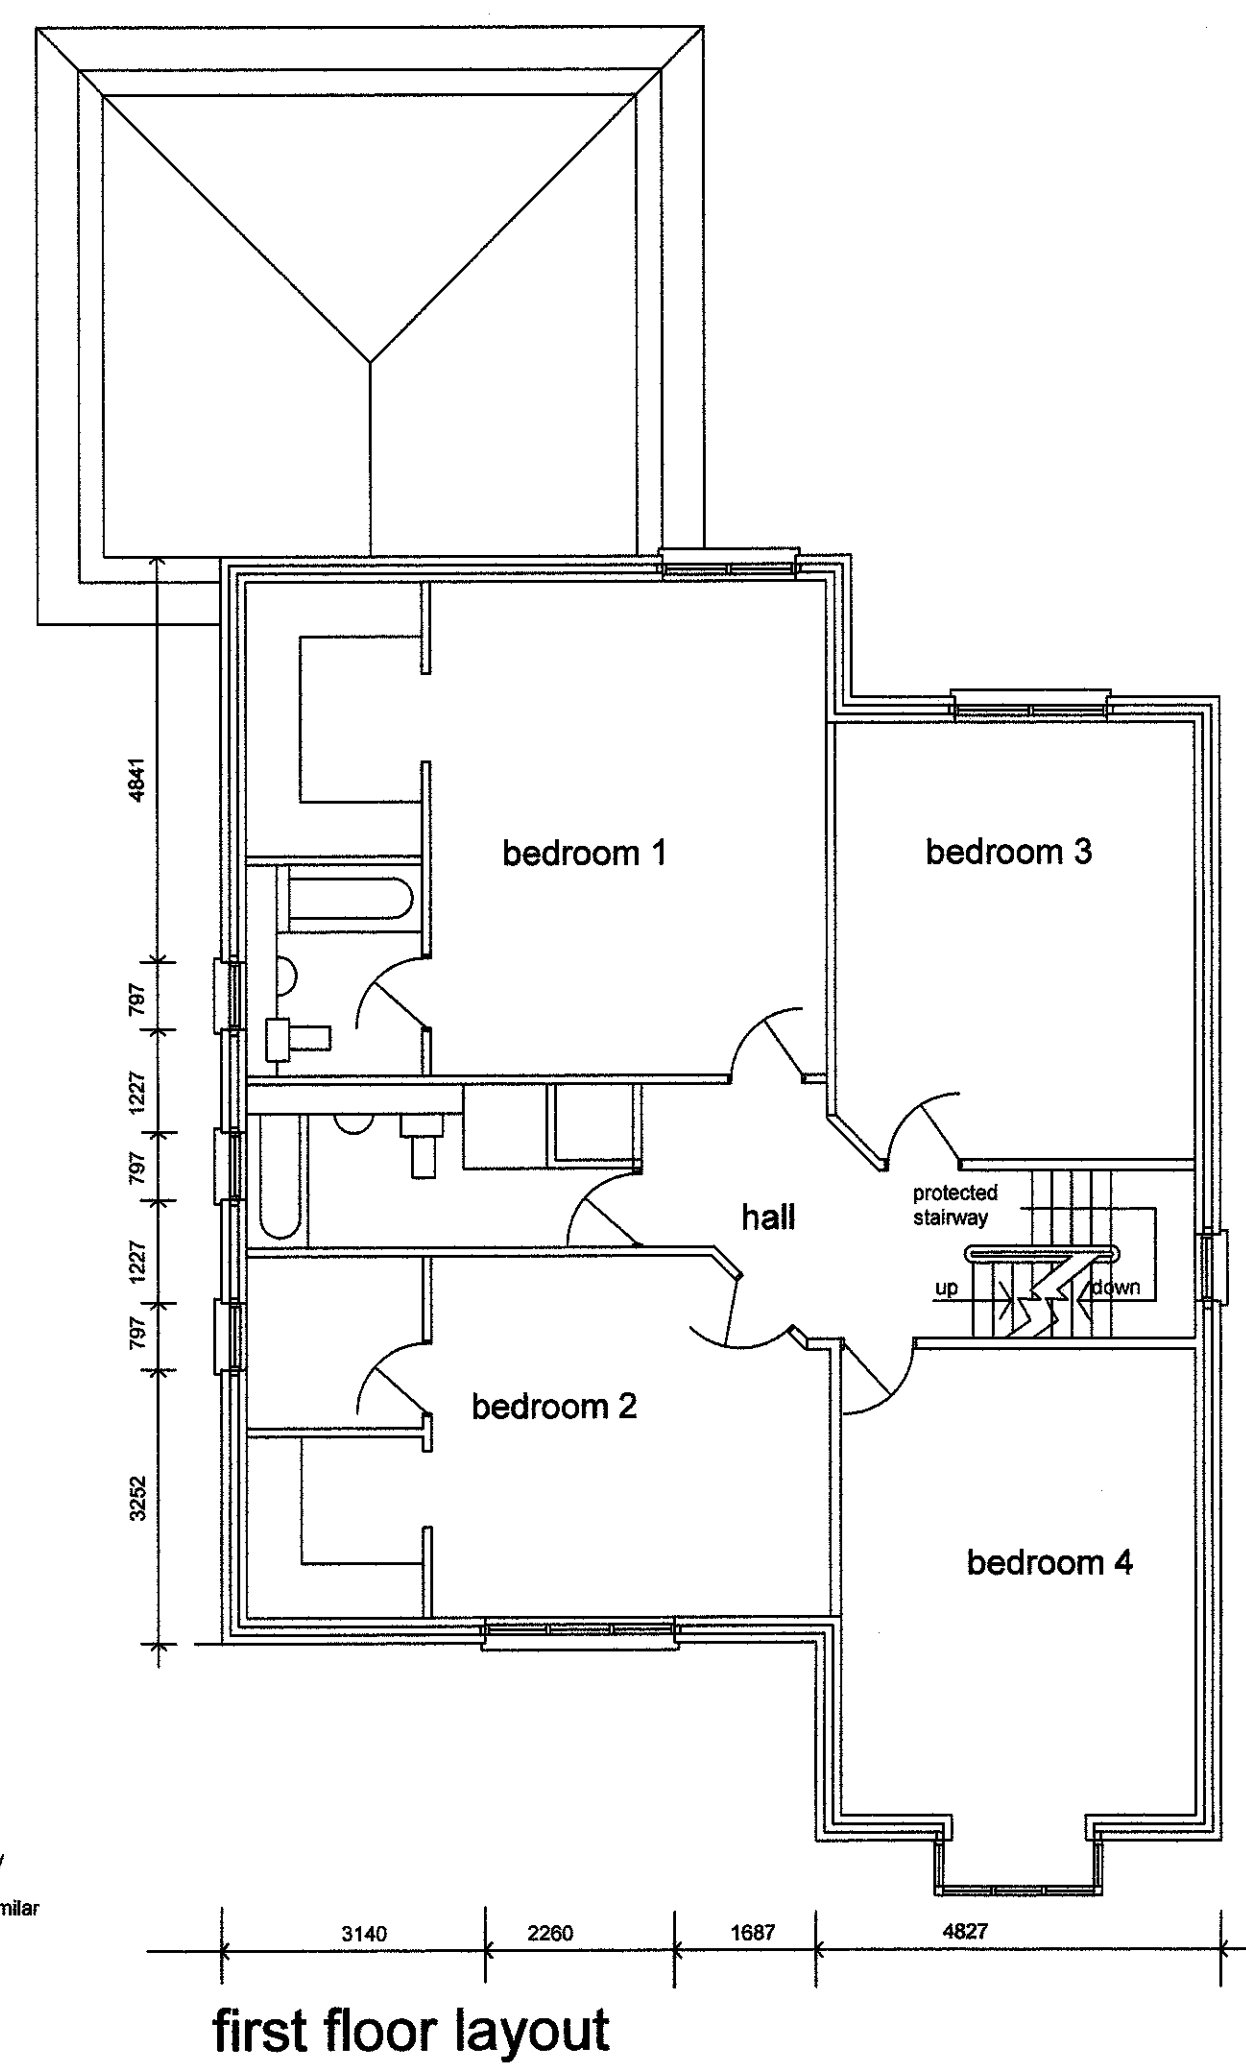
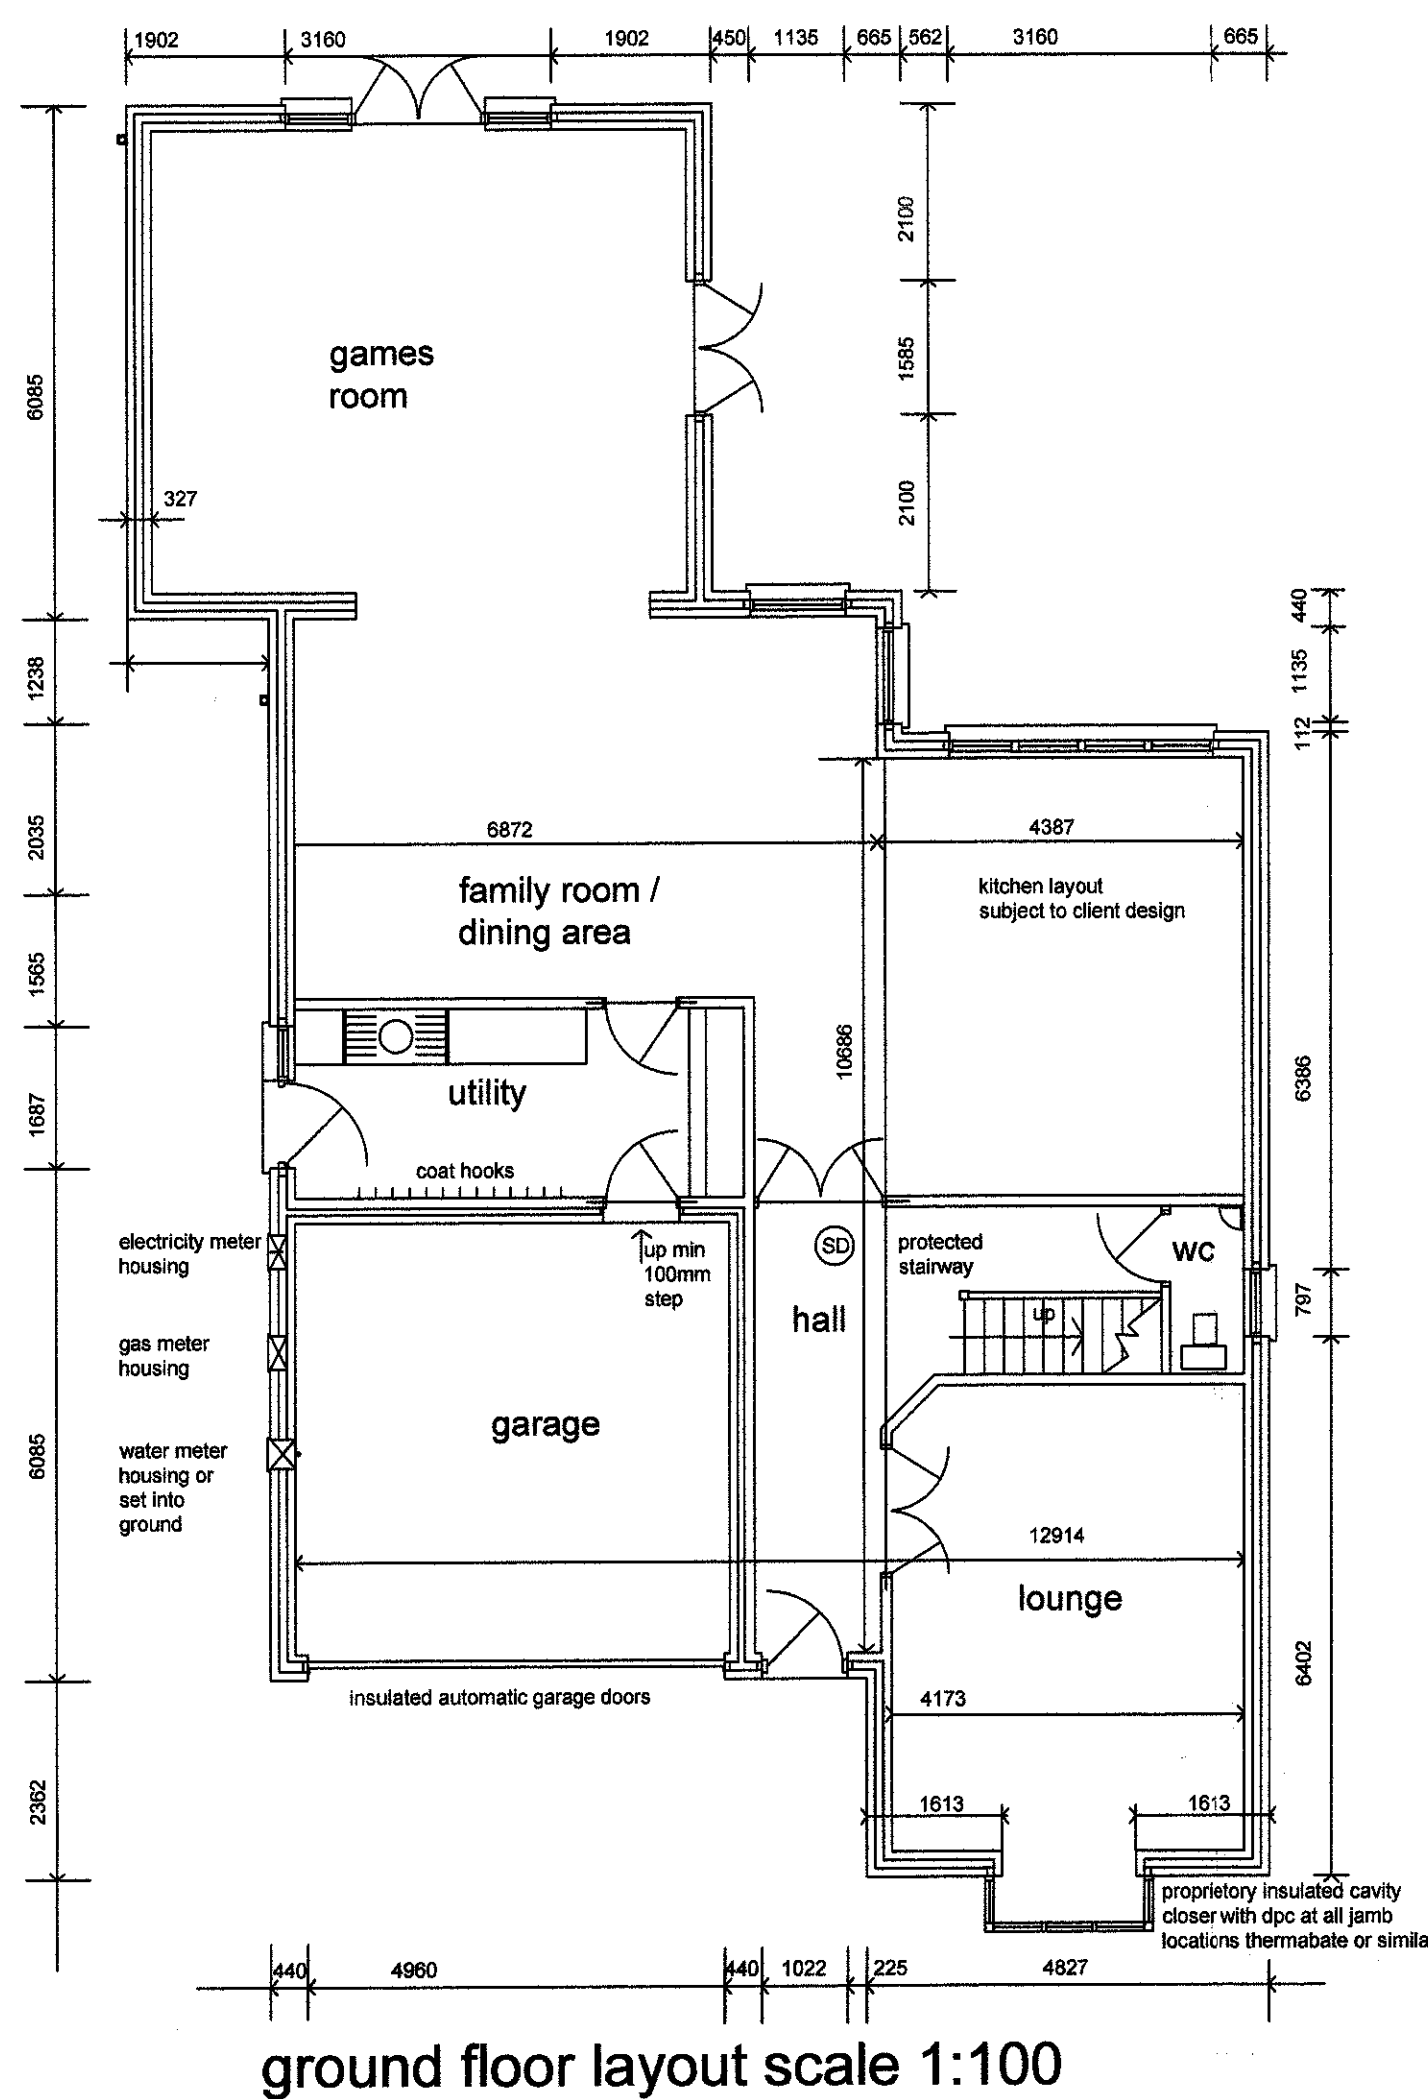
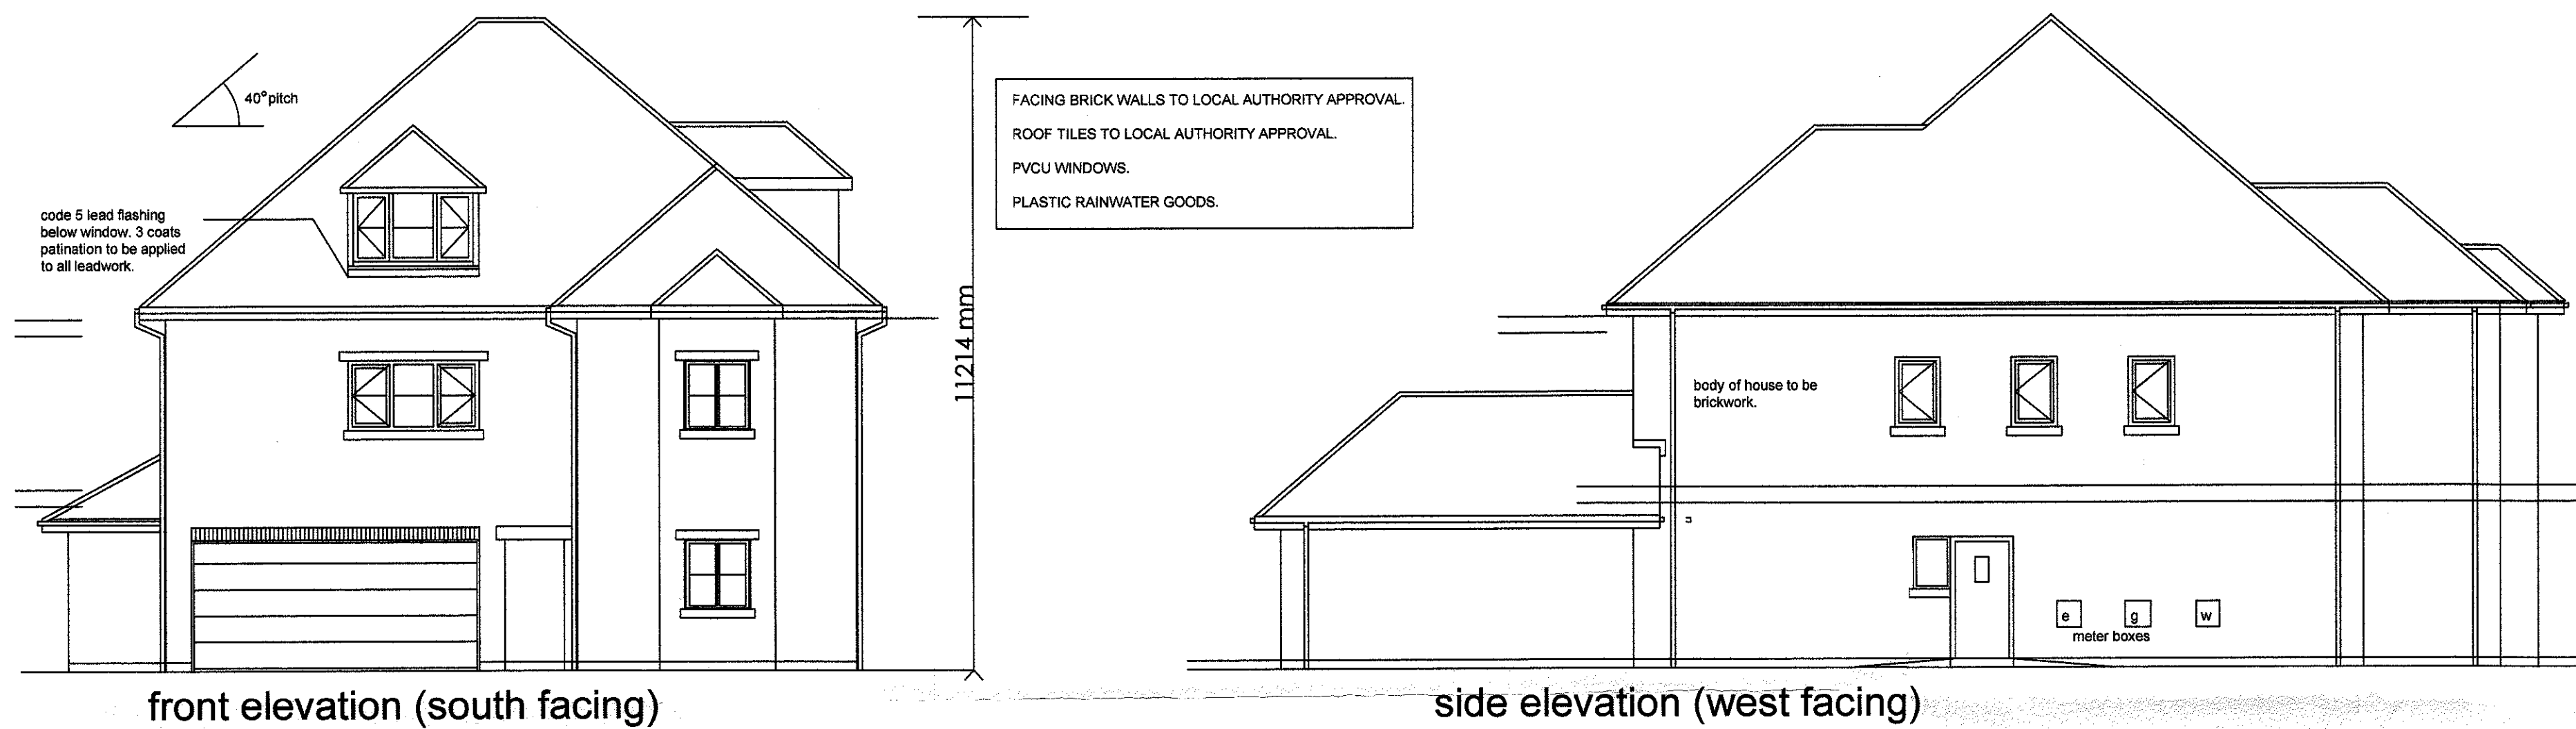


Do not scale this drawing. Discrepancies should be referred to: tasc. This drawing is copyright and should not be reproduced or issued to others without the express permission of the author. Contractor to ensure that the measurements are taken / checked prior to the manufacture of any installation, e.g. stairs, windows and other fixtures and fittings. This drawing should be read in conjunction with the relevant Consultants drawn or written notes. If contradictory information is found then clarity should be sought by the Principal Contractor before work commences. Adherence to all aspects of the CDM Regulations is required (if project qualifies). Do not start work until an F10 notice has been issued and appropriate method statements/risk assessments are in place.

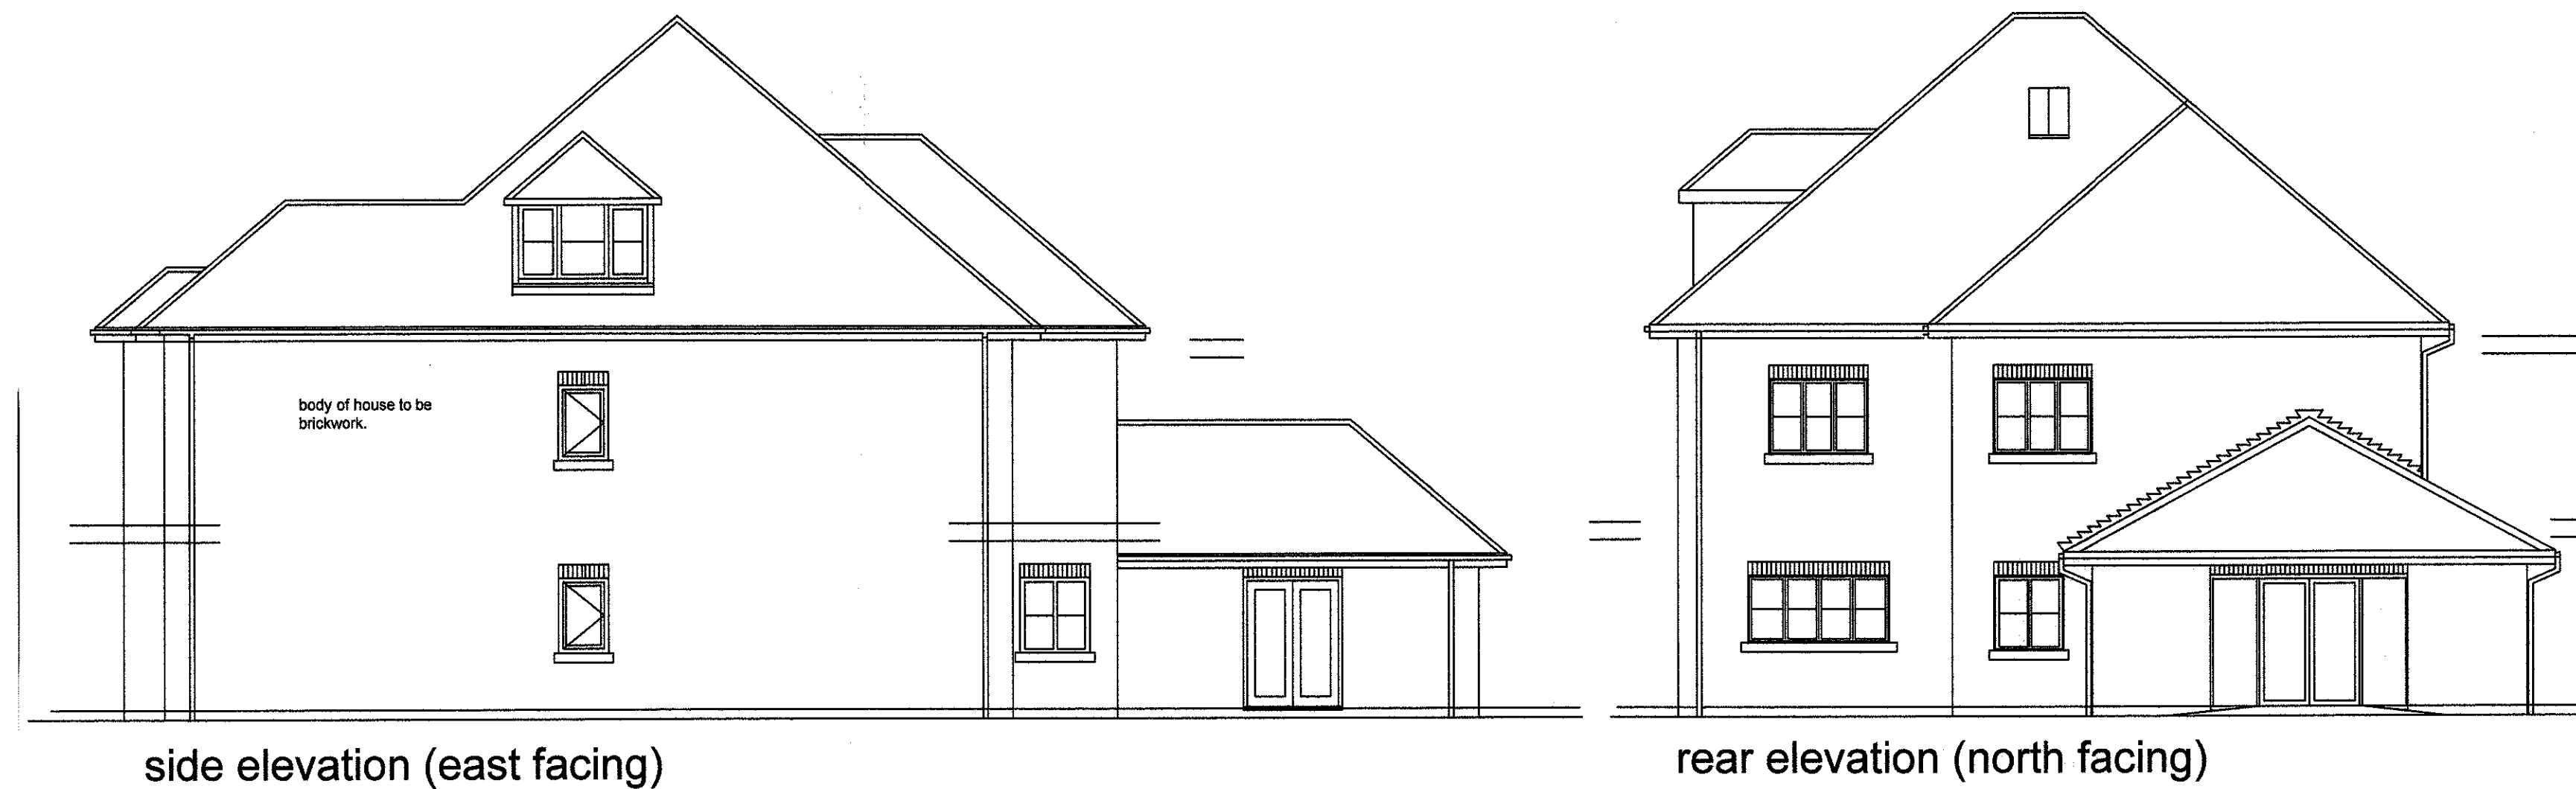

320130054P

AMENDED PLANS RECEIVED
DATE 15 APRIL 2013

A : Various alterations to correct drawing and to elevate 'as built' situation. JT March 2013

Revision:

tasc studios.. ☐ ☐ ☐		207 revidge road, blackburn, BB2 6DT		tel: 01254 660422	
architectural design & management		e-mail: tasc-studios@live.co.uk		mob: 07809417500	
Client	Mr and Mrs Leigh		Description	Proposed New House Plans and Elevations.	
Project	Proposed New House Weavers Loft, Plot 2 Brockhall Village.		Status	Retrospective planning drawing	
	Scale	1:100	Drawn	JT	Date Nov 2012
	Job number	211	Drawing number	(02)p	Revision A

tasc studios...architectural design and project management.