




320140836

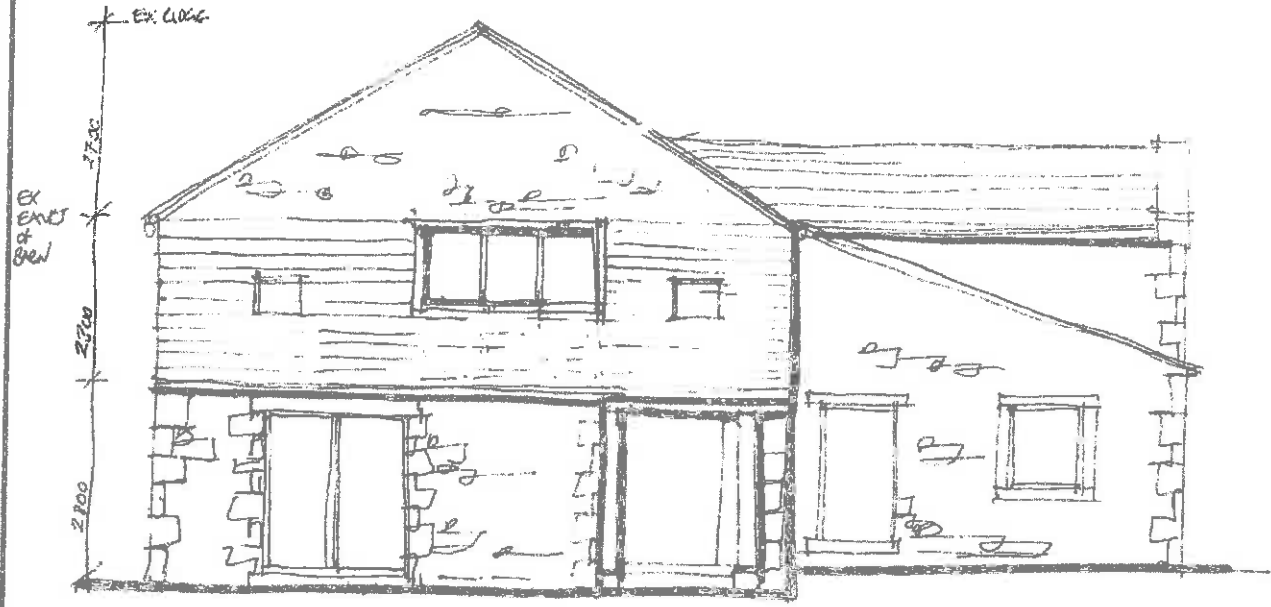


SOUTH ELEVATION.
2.700 (EXISTING GABLE)

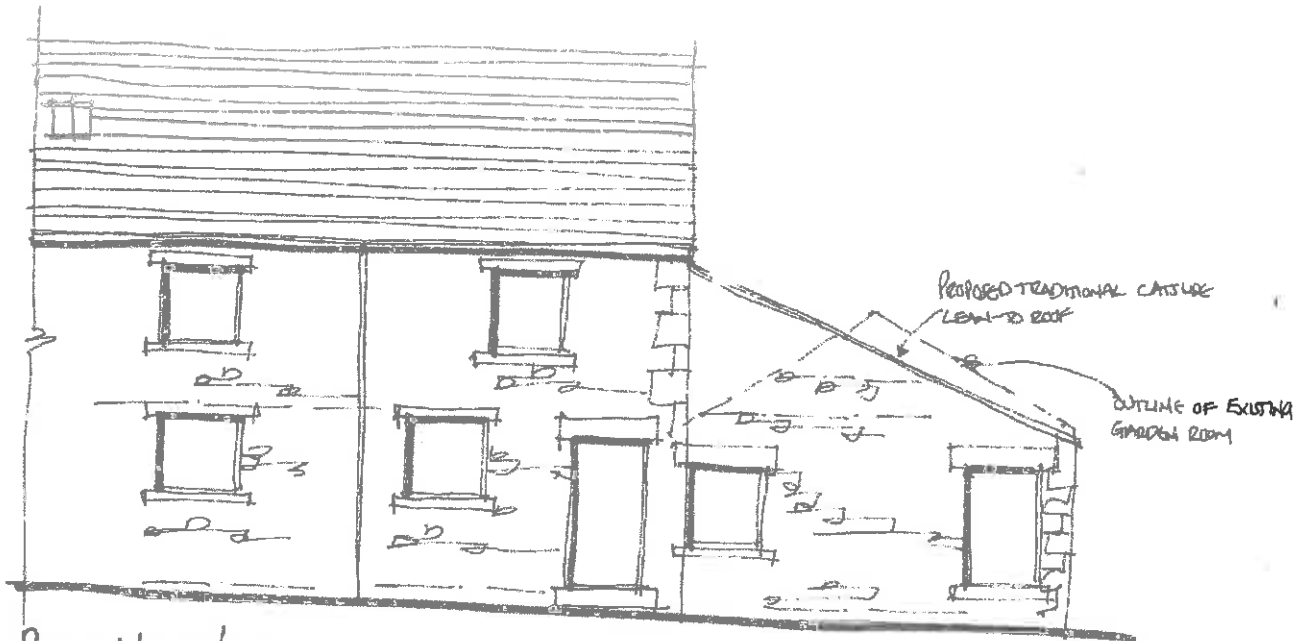


PART WEST/REAR ELEVATION.

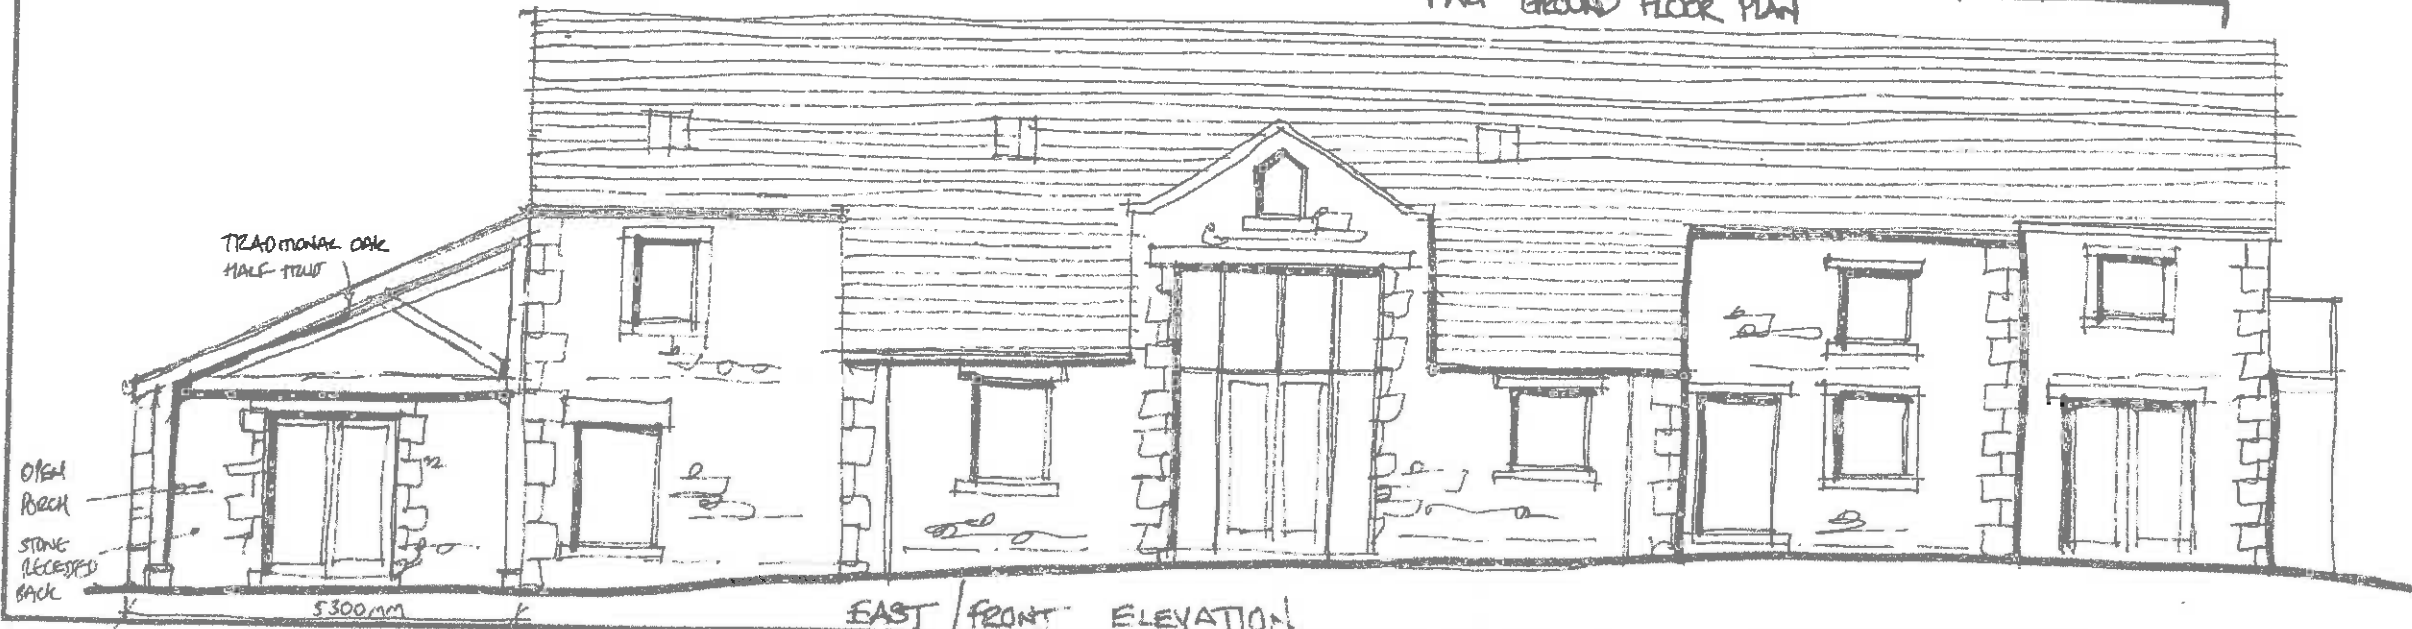

EAST/FRONT ELEVATION

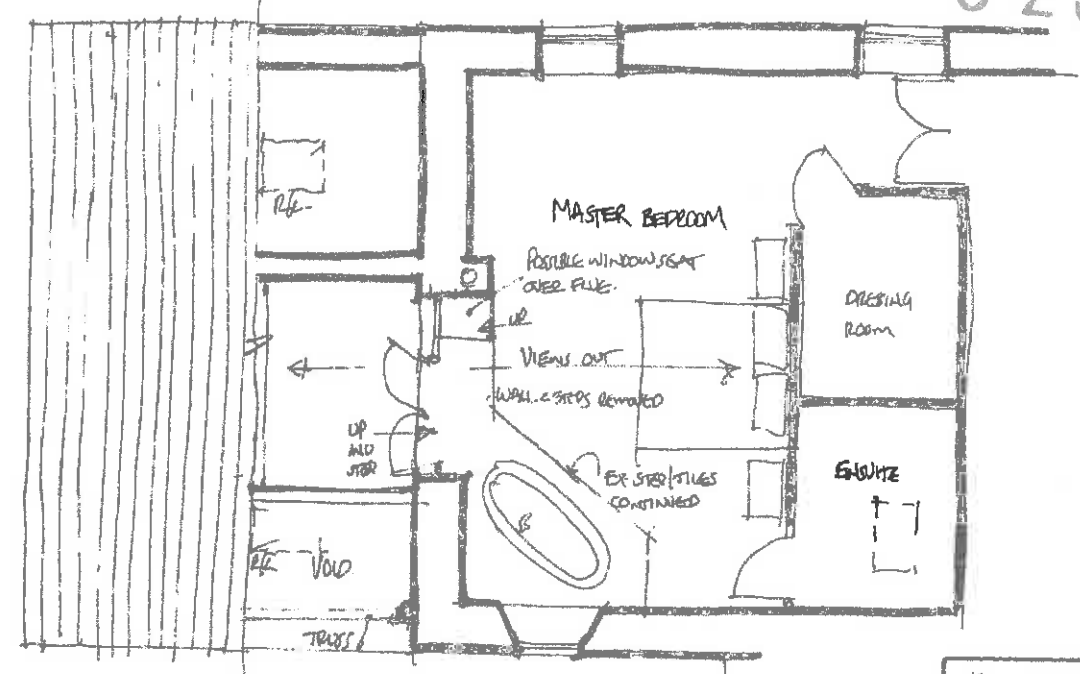

PART FIRST FLOOR PLAN

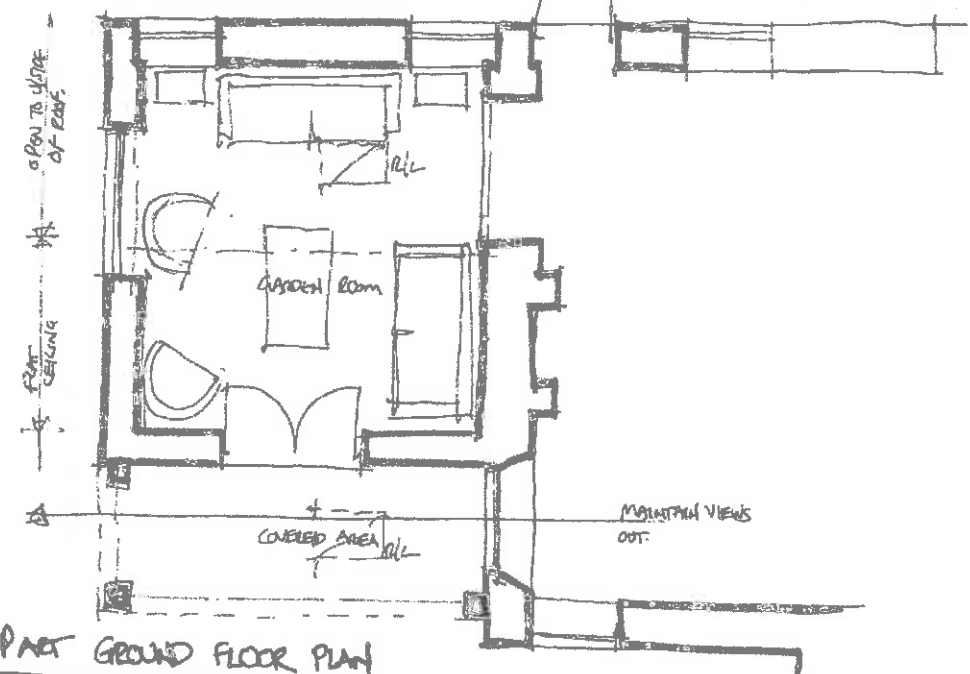

PART GROUND FLOOR PLAN

REV A PROPOSED GABLE EXTENSION REMOVED & EXTERNAL DOORS SET INTO CANTILE LEND TO ROOF. AS DISCUSSED WITH PLANNING OFFICE ON 16/4/13 SCH.

REV B MASTER BEDROOM EXT. DOORS ALTERED & WINDOW SEAT ADDED, WINDOW OMITTED FROM BATH AREA - ALL AS DISCUSSED WITH THE CLIENT. DIMS ADDED 24/6/13 SH.

Client
MR AND MRS LOWERY

Job Title
PROPOSED ALTERATIONS TO
HIGH HOUSE BARN (102)
DILWORTH
LONGRIDGE
PR3 2YX

Drawing Title
PROPOSED SKETCH DESIGN
PLANS & ELEVATIONS

Scale 1:100 CAS Date FEB. 2013 Drawn SCH

spa


SUNDERLAND PEACOCK
SUNDERLAND PEACOCK & ASSOCIATES LTD.
HAZELWIRE, PHILICO ROAD, CLITHEROE,
LANCASHIRE, BB7 2AG
T 01200 423178 F 01200 427325
E info@sunderlandpeacock.com
www.sunderlandpeacock.com



4344 - 01X-B

320140836P

PURPOSE OF ISSUE: PLANNING

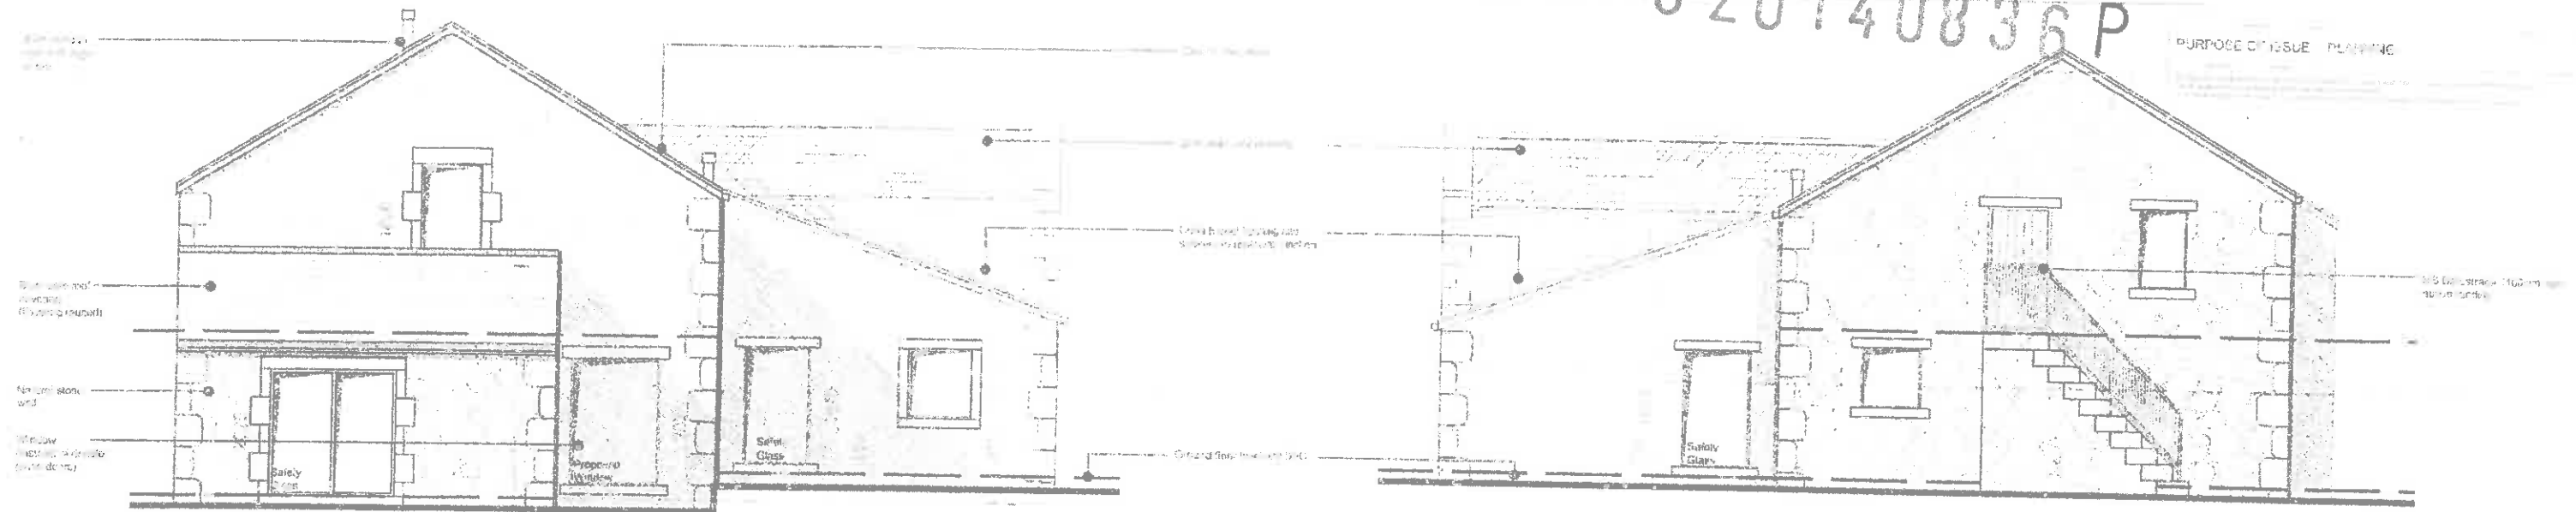

South Elevation


North Elevation

4

3

2

1

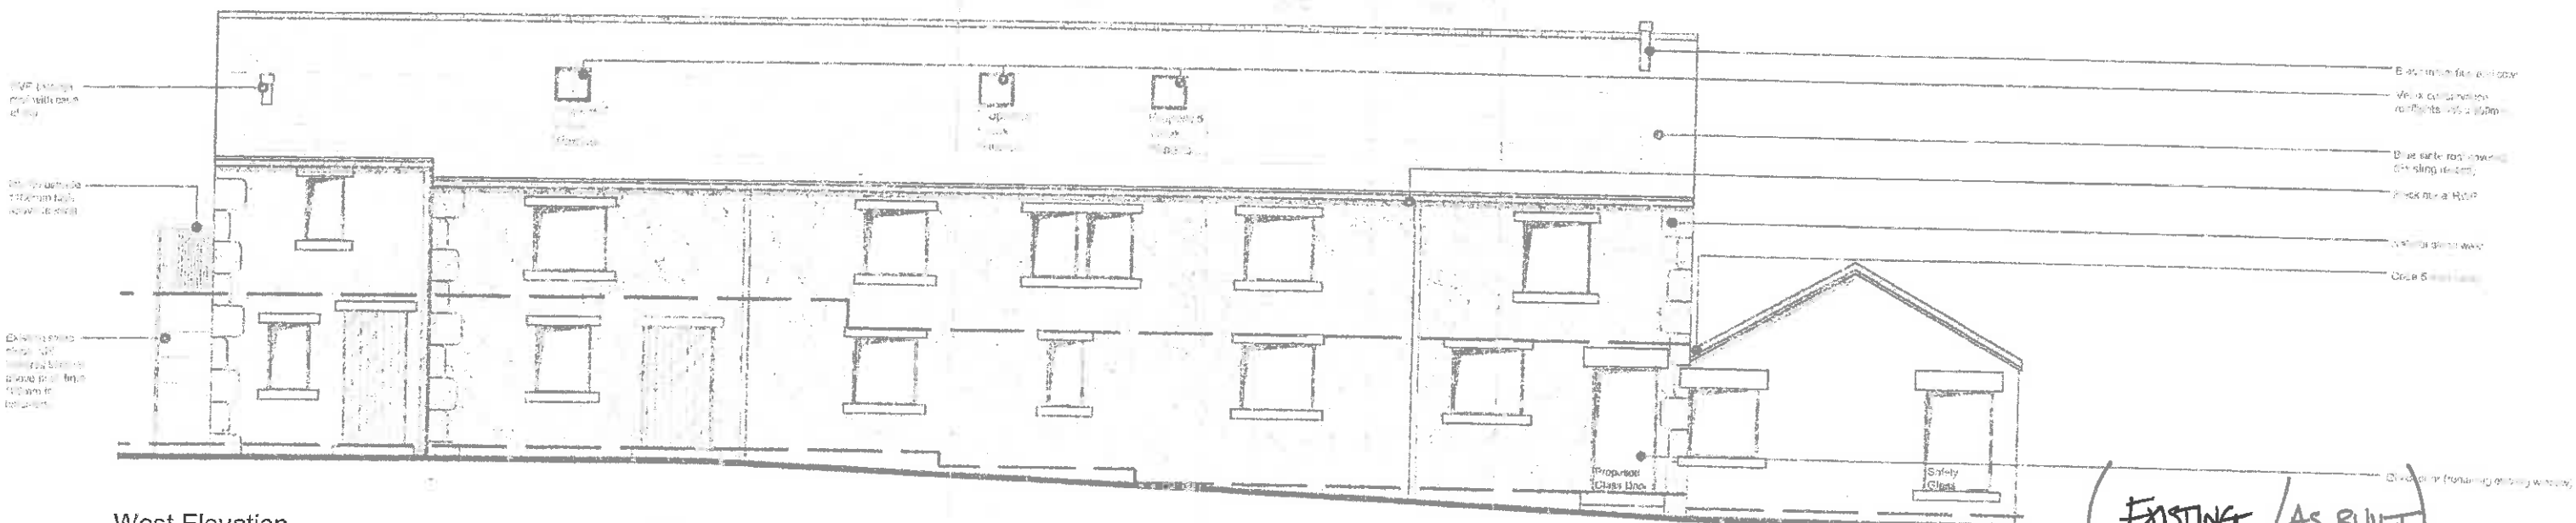

West Elevation

1


2

3

4

(EXISTING / AS BUILT)

320110385P

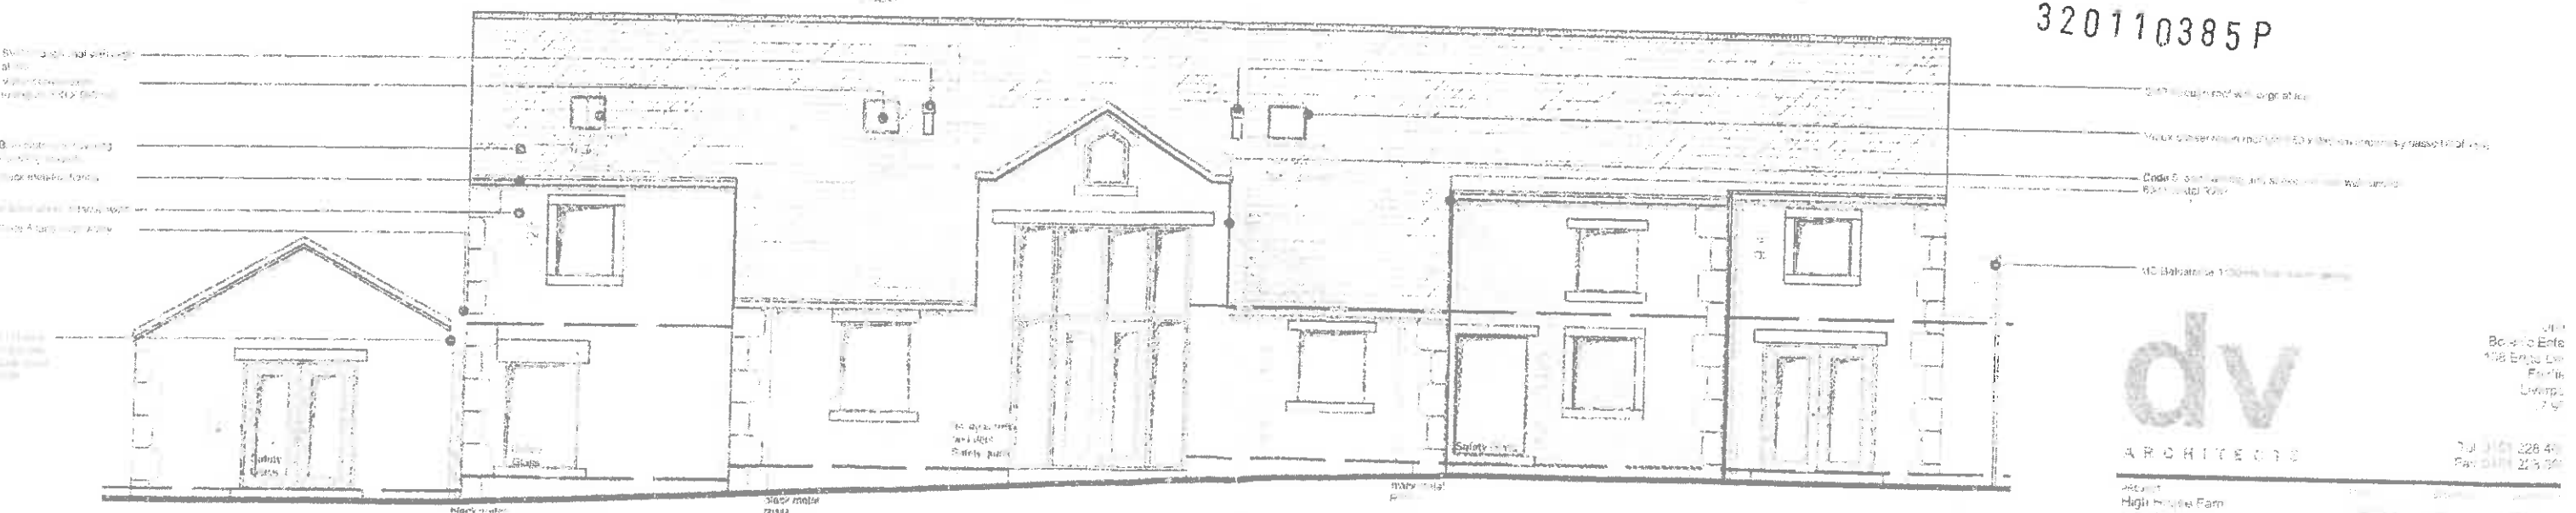

dv

ARCHITECTS

108 Endeavour
Levensham
SA 5024

108 Endeavour
Levensham
SA 5024

Tel: 08 226 4111
Fax: 08 226 4111

PURPOSE OF ISSUE PLANNING

¹ For example, in the case of $\mathbb{R}^n$, $\mathcal{A} = \mathbb{R}^n$ and $\mathcal{B} = \mathbb{R}^n$, the condition $\mathcal{A} \cap \mathcal{B} = \mathcal{A} \cap \mathcal{B}$ is satisfied for all $\mathcal{A}$ and $\mathcal{B}$.



(EXISTING / AS BUILT)

320110385 P

5250

7900

Proposed Ground Floor Plan

Un
Botanic Est
198 Edge Le
Fairfi
Liverp
L7 9

Tel: 0151 228 4666
Fax: 0151 228 8161

ARCHITECTS

PROJECT
High House Farm
Longridge
DRAWING

DATE	DRAWN BY:	CHECKED
14.02.11	JB	BH

320140836P


PURPOSE OF ISSUE: PLANNING

1 2 ③ 4

5250

20'120"

3450

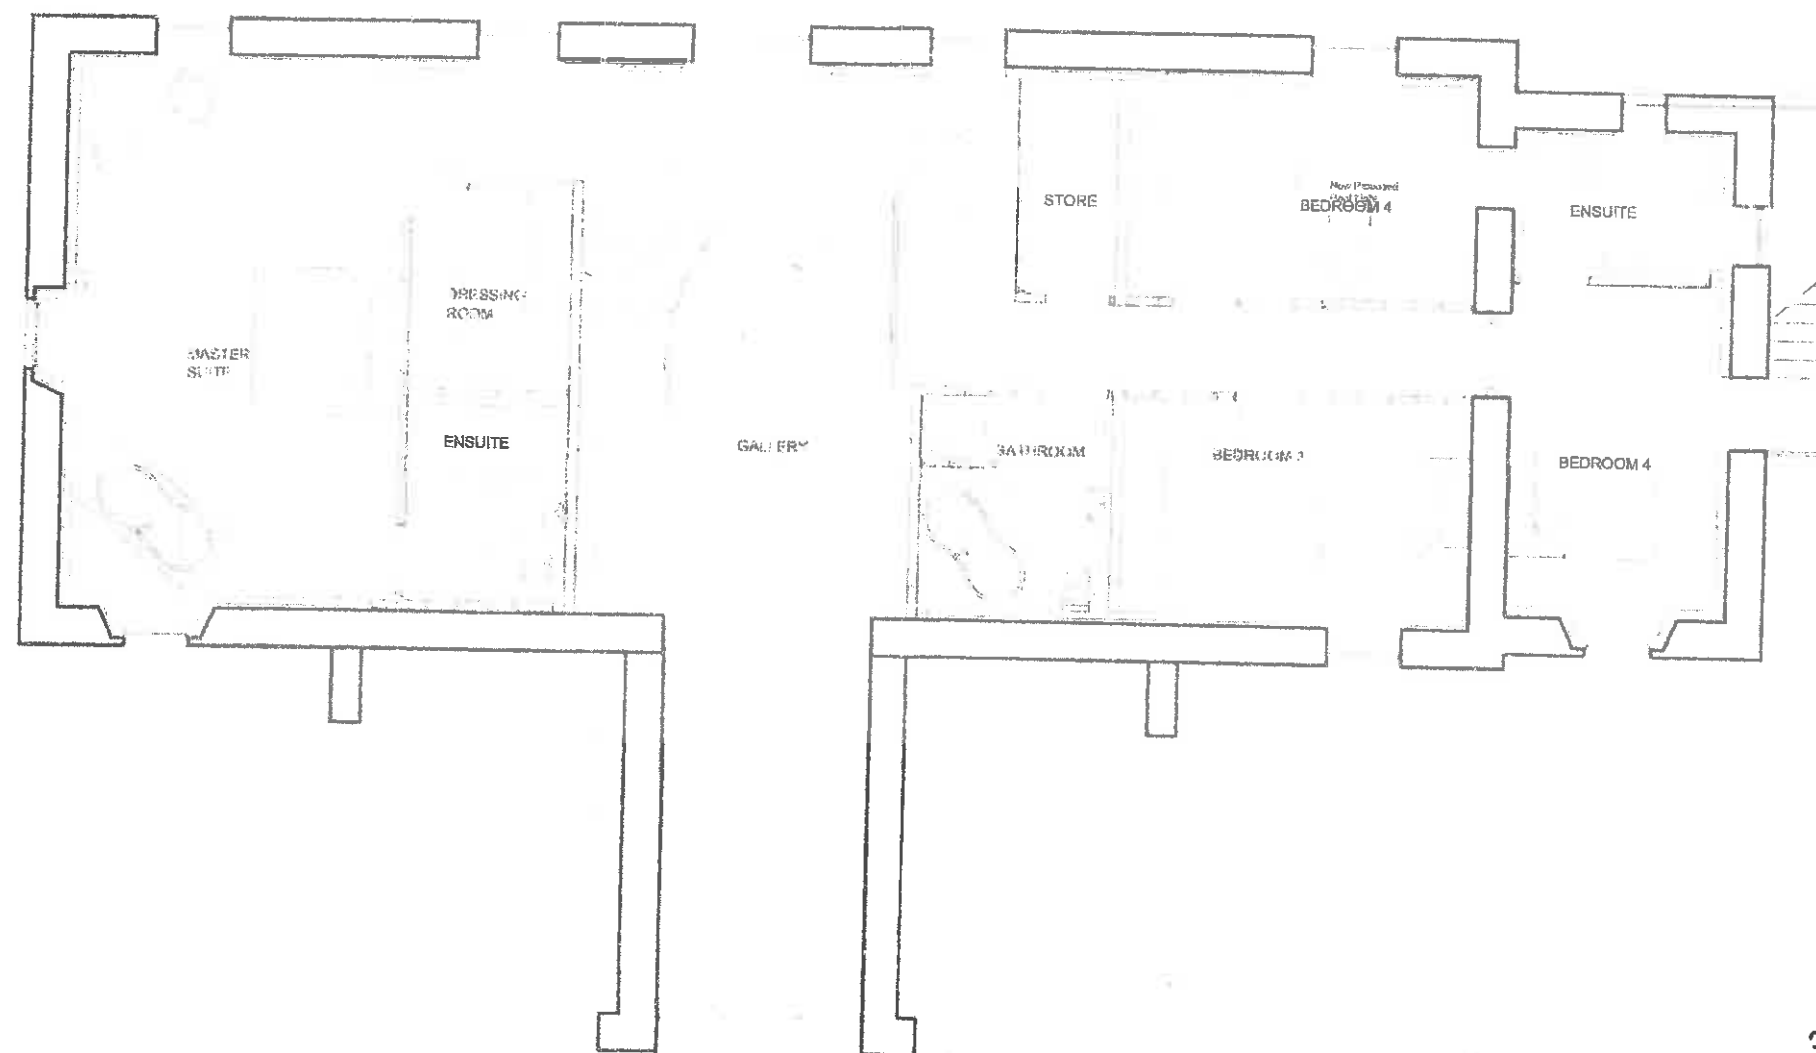

5250

4315

(EXISTING / AS BUILT)

320110385P

Proposed First Floor Plan

DATE REV COMMENTS

dv

ARCHITECTS

Unit 4
Botanic Estate
198 Edge Lane
Fairfield
Liverpool
L7 9PL

Tel: 0151 228 4666
Fax: 0151 228 8666

PROJECT:	DATE:	DRAWN BY:	CHECKED BY:
High House Farm Longridge	14.02.11	JB	BH
DRAWING:			