

Enquiry Summary Manual Print

You will receive formal confirmation of this enquiry by email. Subject always to our standard terms and conditions, this enquiry result is valid for 28 days only from the date of enquiry and is based on the confirmed information you entered. If the location of the work changes then a further enquiry must be made. Should the work not be undertaken within 28 days of the enquiry then a further enquiry must be made.

Where applicable listed below are those registered Asset Owners who have been notified, those to whom you need to send further information and those who have no apparatus within your search area. In addition your response will include other non-registered Asset Owners contact details who have NOT been notified, which may be of interest to you.

Please be aware that the lists below are not exhaustive and that not all Asset Owners are registered with this service. In particular please note that the LinesearchbeforeUdig system only contains information on National Grid's Gas above 2 bar asset and all National Grid Electricity Transmission asset. For National Grid Gas below 2 bar asset information please go to www.beforeudig.nationalgrid.com

If you are required to email additional info please note that we need the following: Site contact name and number, Location plan, Detailed plan (minimum scale 1:2500), Cross sectional drawings (if available), Work Specification.

Enquiry Lodging Details

LSBUD Ref	7081019
Job lodged on	10/07/2015 - 16:14:20 pm

Enquiry Details

Enquiry Type	Initial Enquiry
Work Category	Planning Applications
Work Type	Single property
Job Start Date	01/08/2015
Job End Date	02/08/2015
Scheme/Reference	New Hall Barn
Preferred Plan Size	A4 - Portrait
Working on Behalf of	Private
Searched Location	Ribchester
Confirmed Location	366204 435352
Search Type	Circle
Search Size	100 m

Thank you for your enquiry

Shortly you will receive an email confirming your enquiry and listing the Asset Owners who will contact you regarding the location of their assets.

It is **your responsibility** to identify the presence of any underground/aboveground assets in and around your proposed work site. Please be aware that not all Asset Owners are registered with this service so it is **your responsibility** to identify and contact any Asset Owners not listed here as either Inside or Outside the Zone of Interest.

If you are required to email additional info please note that we need the following:
Site contact name and number, Location plan, Detailed plan (minimum scale 1:2500), Cross sectional drawings (if available), Work Specification.

In the Zone of Interest

Asset Owners who DO have assets near your proposed work site.

Asset Owner	Phone/Email	Emergency Only	Status
Electricity North West Limited	08001954141	08001954141	Notification Sent

Not in the Zone of Interest

LinesearchbeforeUdig Asset Owners who DO NOT have assets in the immediate vicinity of your proposed work site.

Asset Owner	Asset Owner	Asset Owner
AWE Pipeline	FibreSpeed Limited	Oikos Storage Limited
BOC Limited (A Member of the Linde Group)	Gamma	Perenco UK Limited (Purbeck Southampton Pipeline)
BP Midstream Pipelines	Humbly Grove Energy	Phillips 66
BPA	HV Cables	Premier Transmission Ltd (SNIP)
Carrington Gas Pipeline	IGas Energy	Redundant Pipelines - LPDA
Centrica Energy	Ineos Enterprises Limited	RWEpower (Little Barford and South Haven)
Centrica Storage Ltd	INEOS Manufacturing (Scotland and TSEP)	SABIC UK Petrochemicals
CLH Pipeline System Ltd	Lark Energy	Scottish Power Generation
ConocoPhillips (UK) Ltd	Lightsource SPV Limited	Seabank Power Ltd
Coryton Energy Co Ltd (Gas Pipeline)	Mainline Pipelines Limited	Shell Pipelines
CSP Fibre c/o Centara	Manchester Jetline Limited	Total (Finaline, Colnbrook & Colwick Pipelines)
EirGrid	Manx Cable Company	Transmission Capital
E-on UK Plc (Gas Pipelines Only)	Marchwood Power Ltd (Gas Pipeline)	Vattenfall
ESP Utilities Group	National Grid Gas (above 2 bar) and National Grid Electricity Transmission	Western Power Distribution
ESSAR	Northumbrian Water Group	Wingas Storage UK Ltd
Esso Petroleum Company Limited	NPower CHP Pipelines	Zayo Group UK Ltd c/o JSM Group Ltd

Not Notified


The following Asset Owners are NOT currently members of LinesearchbeforeUdig, however you should contact them before proceeding.

Asset Owner	Preferred Contact Method	Phone	Status
BskyB Telecommunications	nrswa@bskyb.com	02070323234	Not Notified
BT	https://www.swns.bt.com/pls/mbe/welcome.home	08009173993	Not Notified
Colt	plantenquiries@catelecomuk.com	01227768427	Not Notified
Energetics Electricity	plantenquiries@energetics-uk.com	01698404646	Not Notified
Fulcrum	FPLplantprotection@fulcrum.co.uk	03330146455	Not Notified
GTC	https://pe.gtc-uk.co.uk/PlantEnqMembership	01359240363	Not Notified
Instalcom	plantenquiries@instalcom.co.uk	02087314613	Not Notified
Interoute	interoute.enquiries@plancast.co.uk	02070259000	Not Notified
Lancashire County Council	highways@lancashire.gov.uk	03001236701	Not Notified
National Grid Gas Distribution (below 2 bar)	plantprotection@nationalgrid.com	0800688588	Not Notified
Tata, KPN (c/- McNicholas)	plantenquiries@mcnicholas.co.uk	03300558469	Not Notified
Teliasonera	telenttelia.plantenquiries@telent.com	0800526015	Not Notified
United Utilities	property.searches@uuplc.co.uk	08707510101	Not Notified
Verizon Business	osp-team@uk.verizonbusiness.com	01293611736	Not Notified
Virgin Media	http://www.digdat.co.uk	08708883116	Not Notified

Vodafone	osm.enquiries@atkinsglobal.com	01454662881	Not Notified
Vtesse Networks	https://vtplant.vtesse.com	01992532100	Not Notified

Disclaimer

The results of this Enquiry have been provided for the sole use of the Enquirer and no other party. The asset information on which the Enquiry results are based has been provided by LinesearchbeforeUdig members, LinesearchbeforeUdig will provide no guarantee that such information is accurate or reliable nor does it monitor such asset information for accuracy and reliability going forward. There are also asset owners which do not participate in the enquiry service operated by LinesearchbeforeUdig, including but not exclusively those set out above. Therefore, LinesearchbeforeUdig cannot make any representation or give any guarantee or warranty as to the completeness of the information contained in the enquiry results. LinesearchbeforeUdig and its employees, agents and consultants accept no liability (except insofar as liability under any statute that cannot be excluded) arising in respect thereof or in any other way for errors or omissions including responsibility to any person by reason of negligence. Please refer to LinesearchbeforeUdig's Terms of Use for full terms of use available at www.linesearchbeforeudig.co.uk

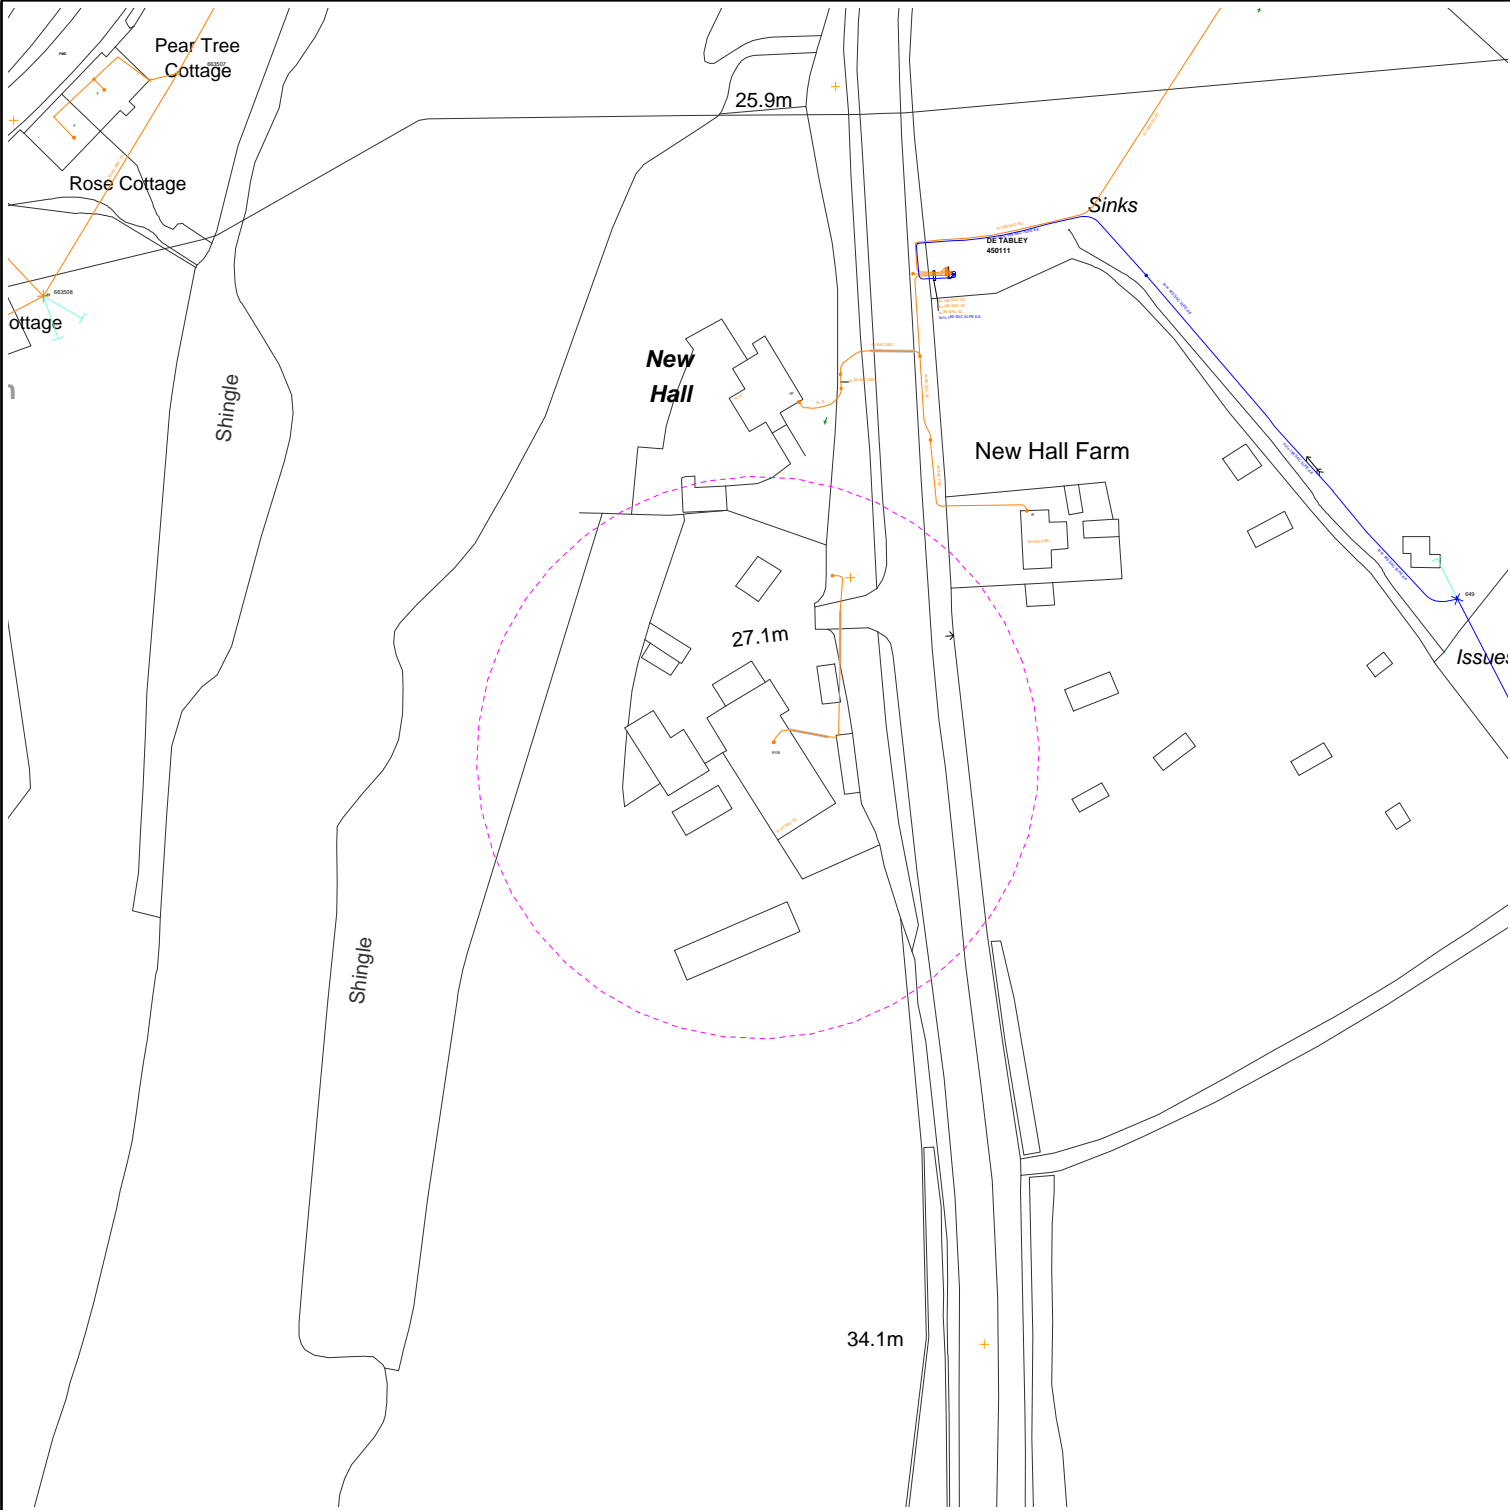

<p>Requested by: Alice Edmondson Company: Stanton Andrews Date Requested: 10/07/2015 Job Reference: 7081019 Your Scheme/Reference: New Hall Barn</p>	<table border="1"><thead><tr><th>Operating Voltage</th><th>Colour Code</th><th>Line Colour</th></tr></thead><tbody><tr><td>132kV</td><td>Black</td><td></td></tr><tr><td>33kV</td><td>Green</td><td></td></tr><tr><td>22kV-25kV</td><td>Yellow</td><td></td></tr><tr><td>11kV</td><td>Red</td><td></td></tr><tr><td>6kV-6.6kV</td><td>Blue</td><td></td></tr><tr><td>1kV-6kV</td><td>Violet</td><td></td></tr><tr><td>LV</td><td>Orange</td><td></td></tr><tr><td>Unknown Voltage</td><td>Brown</td><td></td></tr></tbody></table>	Operating Voltage	Colour Code	Line Colour	132kV	Black		33kV	Green		22kV-25kV	Yellow		11kV	Red		6kV-6.6kV	Blue		1kV-6kV	Violet		LV	Orange		Unknown Voltage	Brown		<p>Data Management Electricity North West Linley House Dickinson Street Manchester, M1 4LF Phone: 0800 195 4141 Email: planrequest@enwl.co.uk</p> <p>Scales on A4 paper: 1:1250 Area dig site 1:250 Line dig site</p>
Operating Voltage	Colour Code	Line Colour																											
132kV	Black																												
33kV	Green																												
22kV-25kV	Yellow																												
11kV	Red																												
6kV-6.6kV	Blue																												
1kV-6kV	Violet																												
LV	Orange																												
Unknown Voltage	Brown																												
<p>Dig Sites: Area Line </p>																													
<p>Unless otherwise indicated the depth of Electricity North West Limited cables are in accordance with NJUG (450mm for Low Voltage & 600mm for 11kV cables) 33kV and 132kV cables are laid at depths as marked. The depth and positions of Electricity North West Limited equipment was accurate as shown when the equipment was installed. However third parties may have altered the level & other reference data. Therefore Electricity North West Limited accept no responsibility for the position of Electricity North West Limited equipment being different from shown. No person, body or company, shall be relieved from liability for damage caused to Electricity North West Limited equipment by reason of being located differently to the indications on this drawing. Service cables are not necessarily shown but must be assumed to exist to all premises, streetlights and signs. There may be other Electricity North West Limited apparatus in the vicinity which is not indicated on the cable records. Other apparatus may also be present which is owned by a third party other than Electricity North West Limited.</p> <p>Reproduced from or based upon Ordnance Survey's map with the permission of Her Majesty's Stationary Office. Crown Copyright Reserved. LICENCE No. 100017892. Unauthorised reproduction may lead to Prosecution or Civil Proceedings.</p> <p>Reference should be made to HSE Guidance, HS(G)47 "Avoiding Danger from Underground Services" and GS6 "Avoidance of Danger from Overhead Power Lines".</p> <p>Electricity North West Limited 304 Bridgewater Place, Birchwood Park, Warrington WA3 6XG. Registered in England and Wales. Registered No 02366949</p>																													