

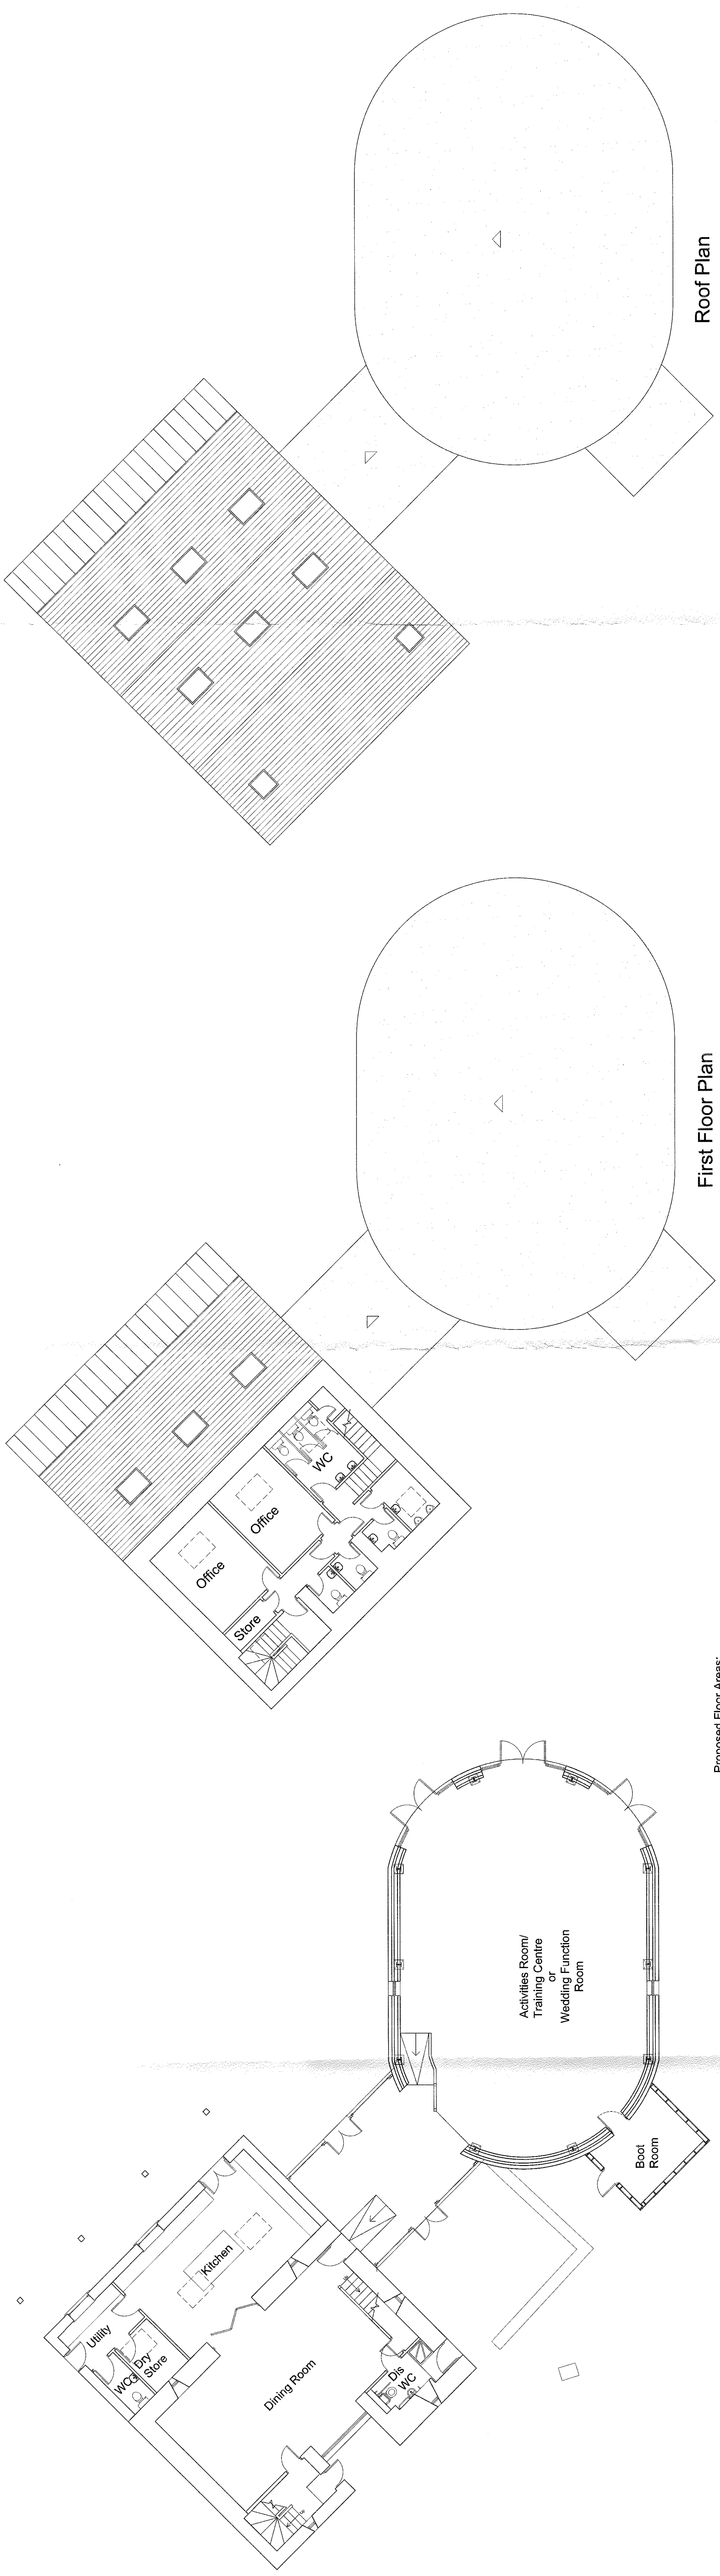


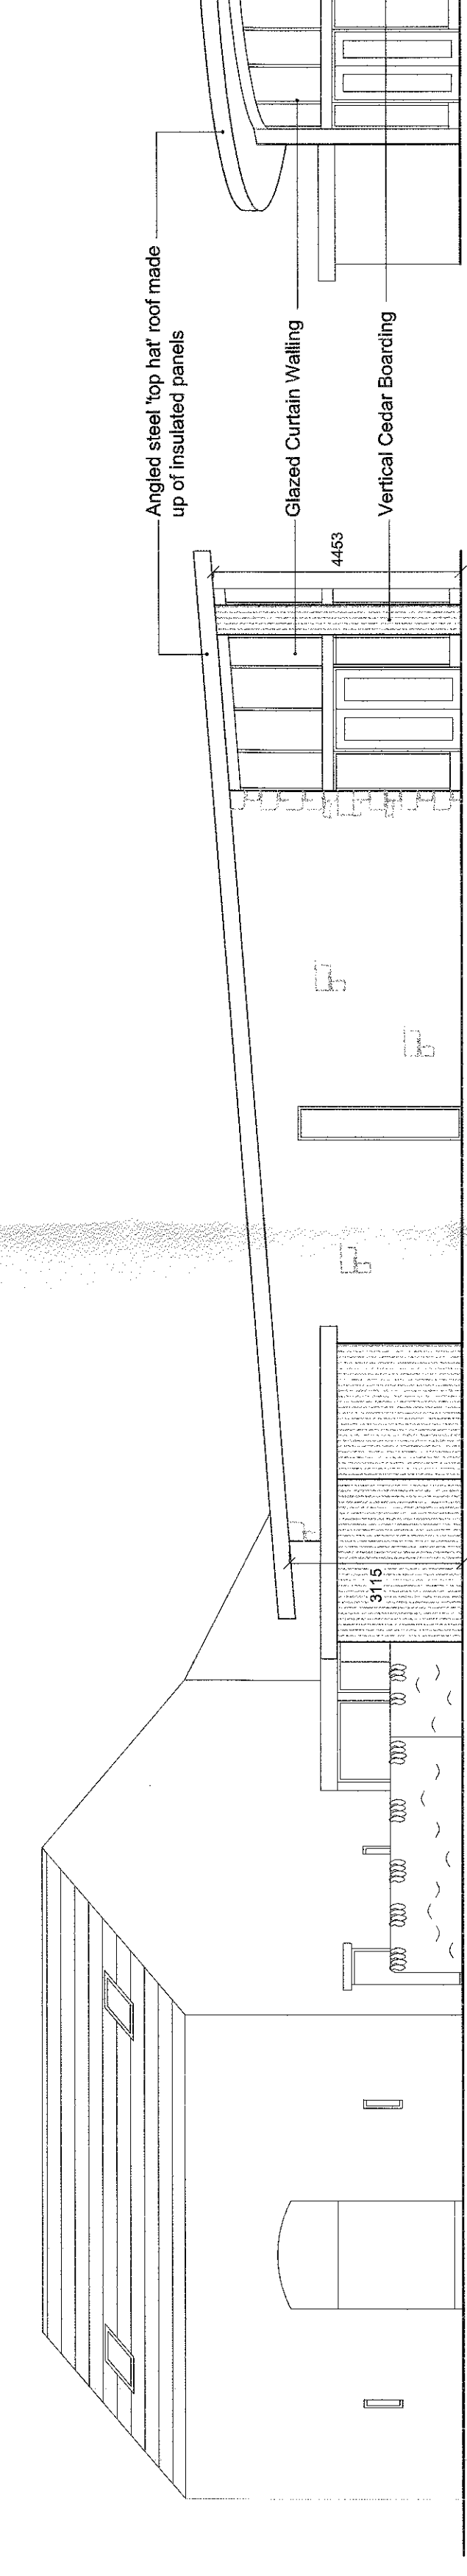


Proposed Floor Areas:


Activities Room/Training Centre	142m ²
Boot Room	11m ²
Glazed Link	27m ²
Main Building:	
Dining Room	52m ²
Kitchen	35m ²
Utility	8.4m ²
Dry Store	4.7m ²

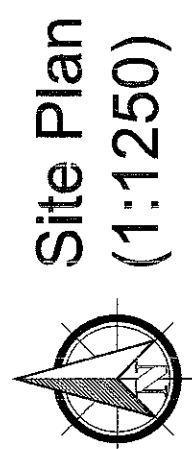


South Elevation

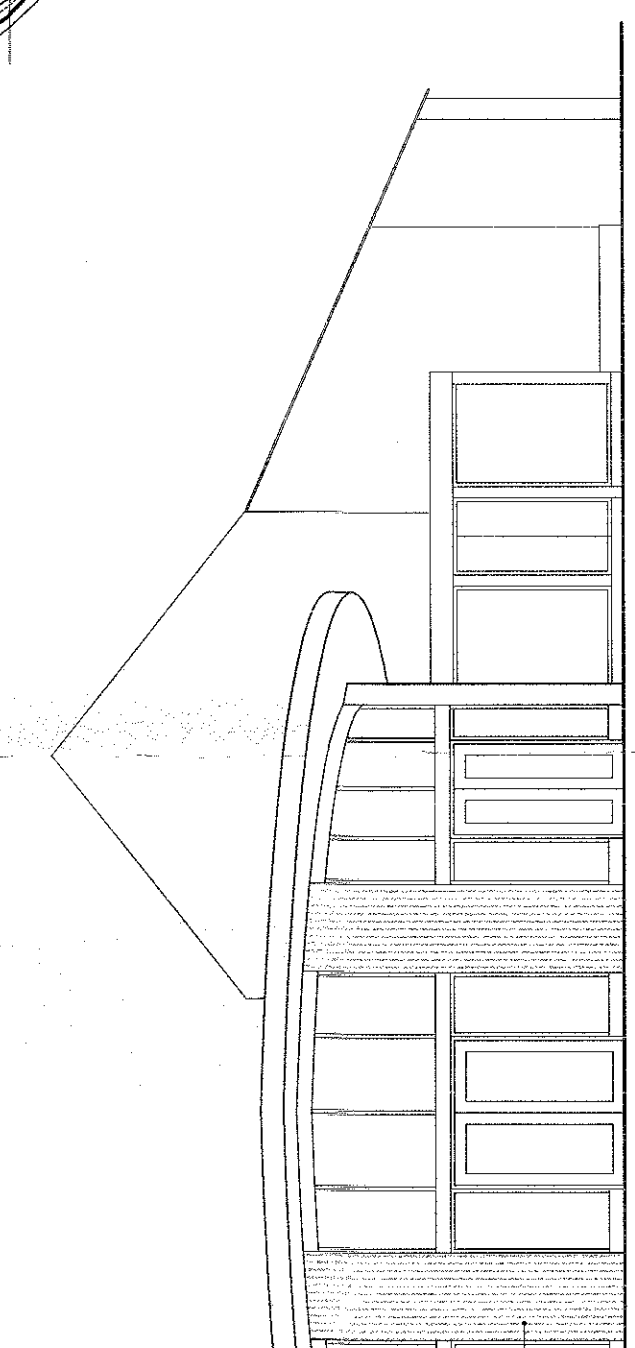

East Elevation

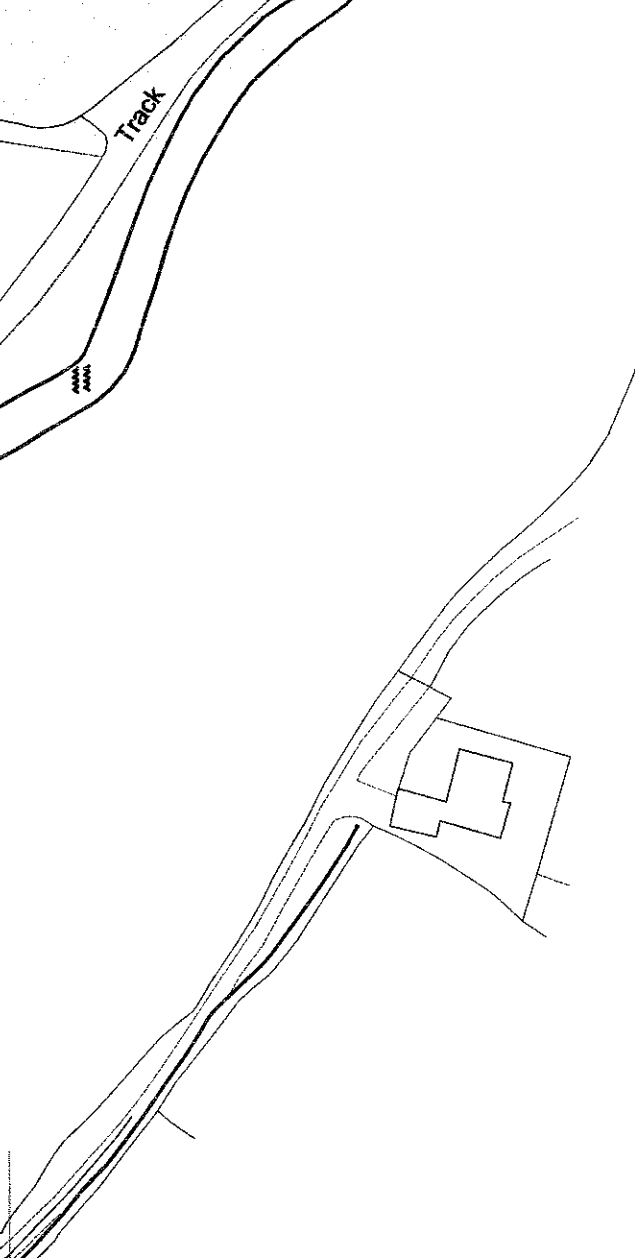


West Elevation

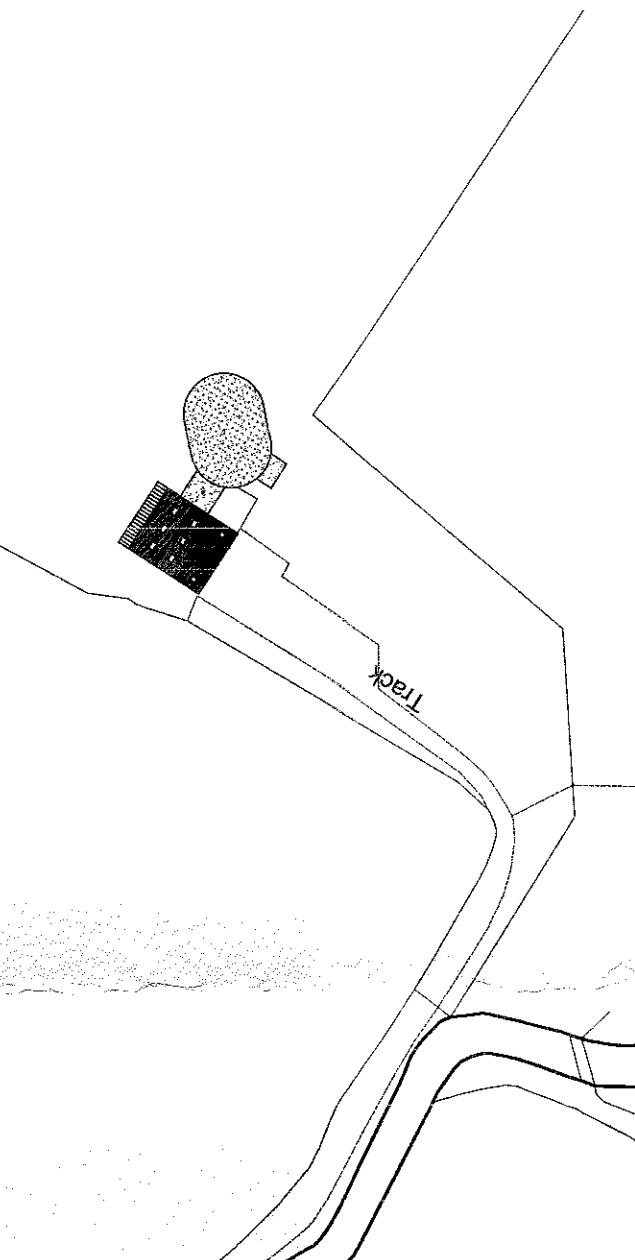


Rear (North East) Elevation




Side (North West) Elevation

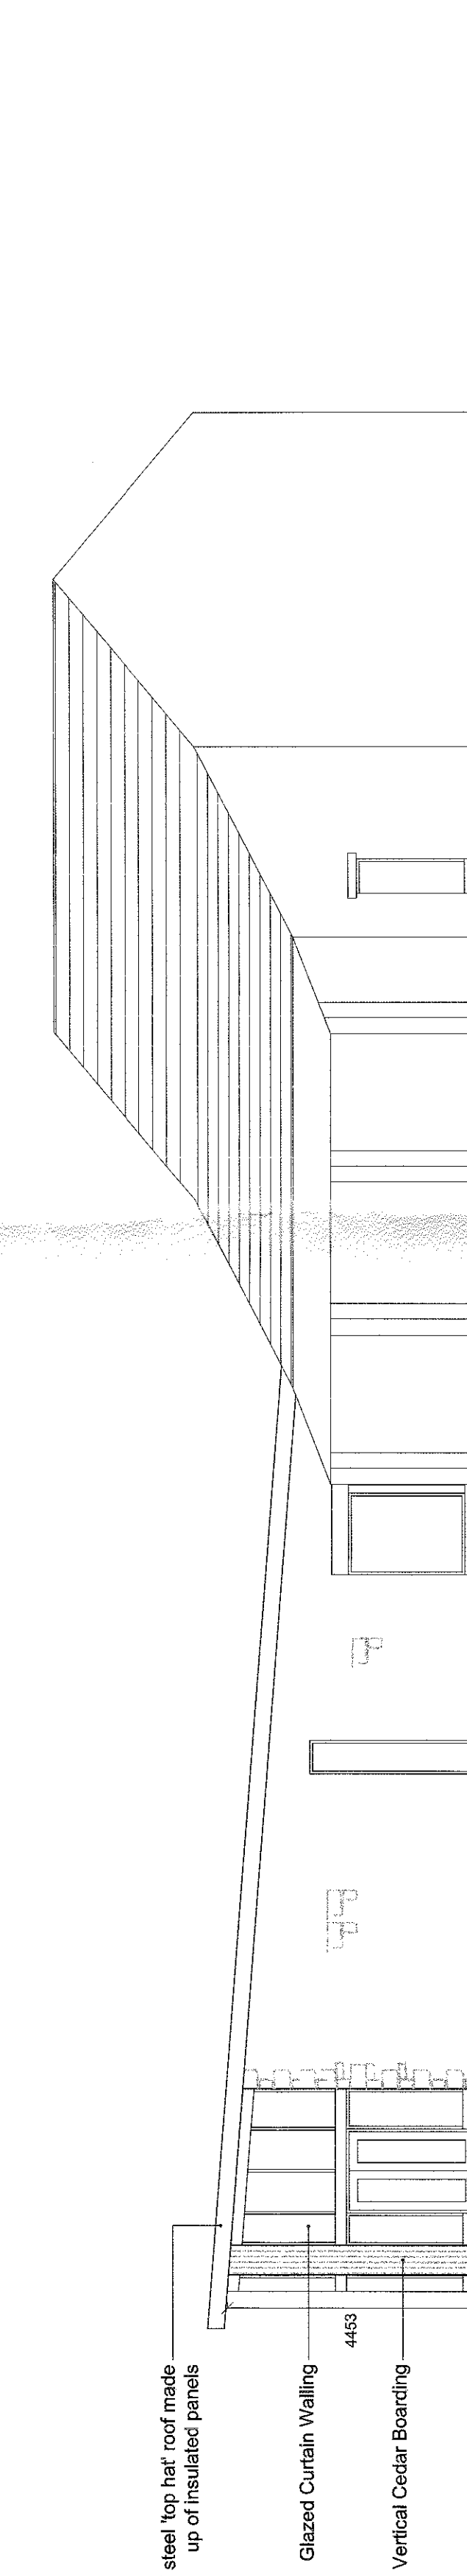


North Elevation

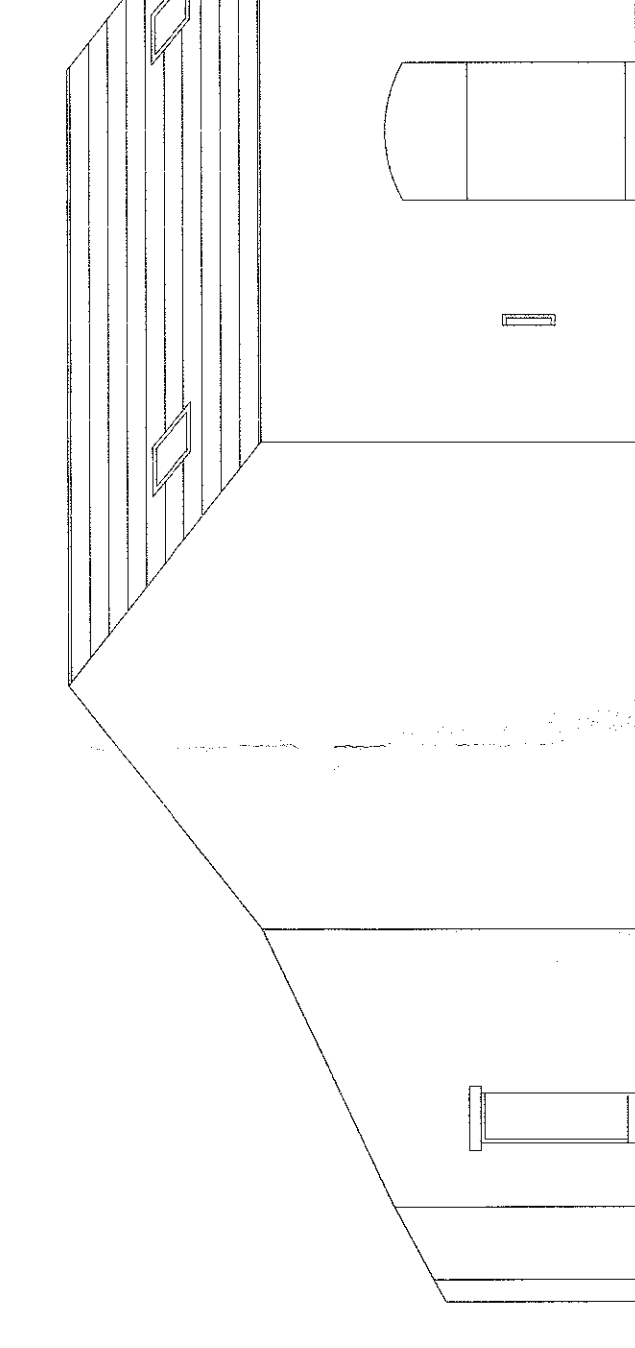

Side (South East) Elevation

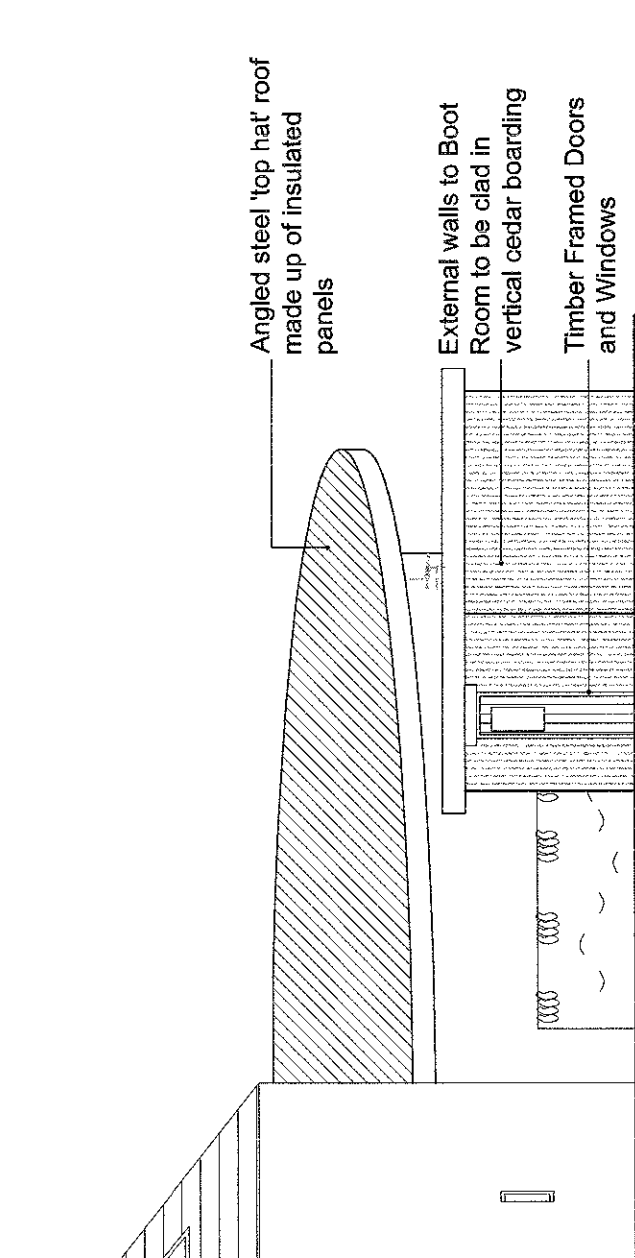

Front (South West) Elevation

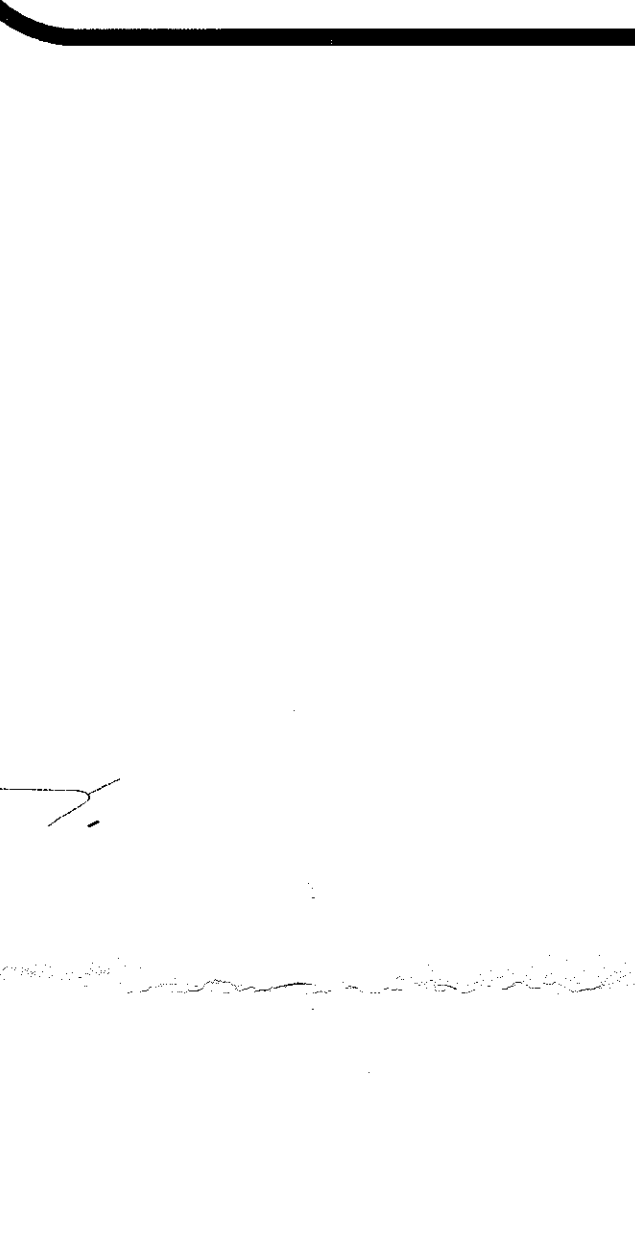

PROPOSED ELEVATIONS OF EXISTING BUILDING

North Elevation


West Elevation

Rear (North East) Elevation


Side (North West) Elevation

Side (South East) Elevation


PROPOSED ELEVATIONS OF EXISTING BUILDING

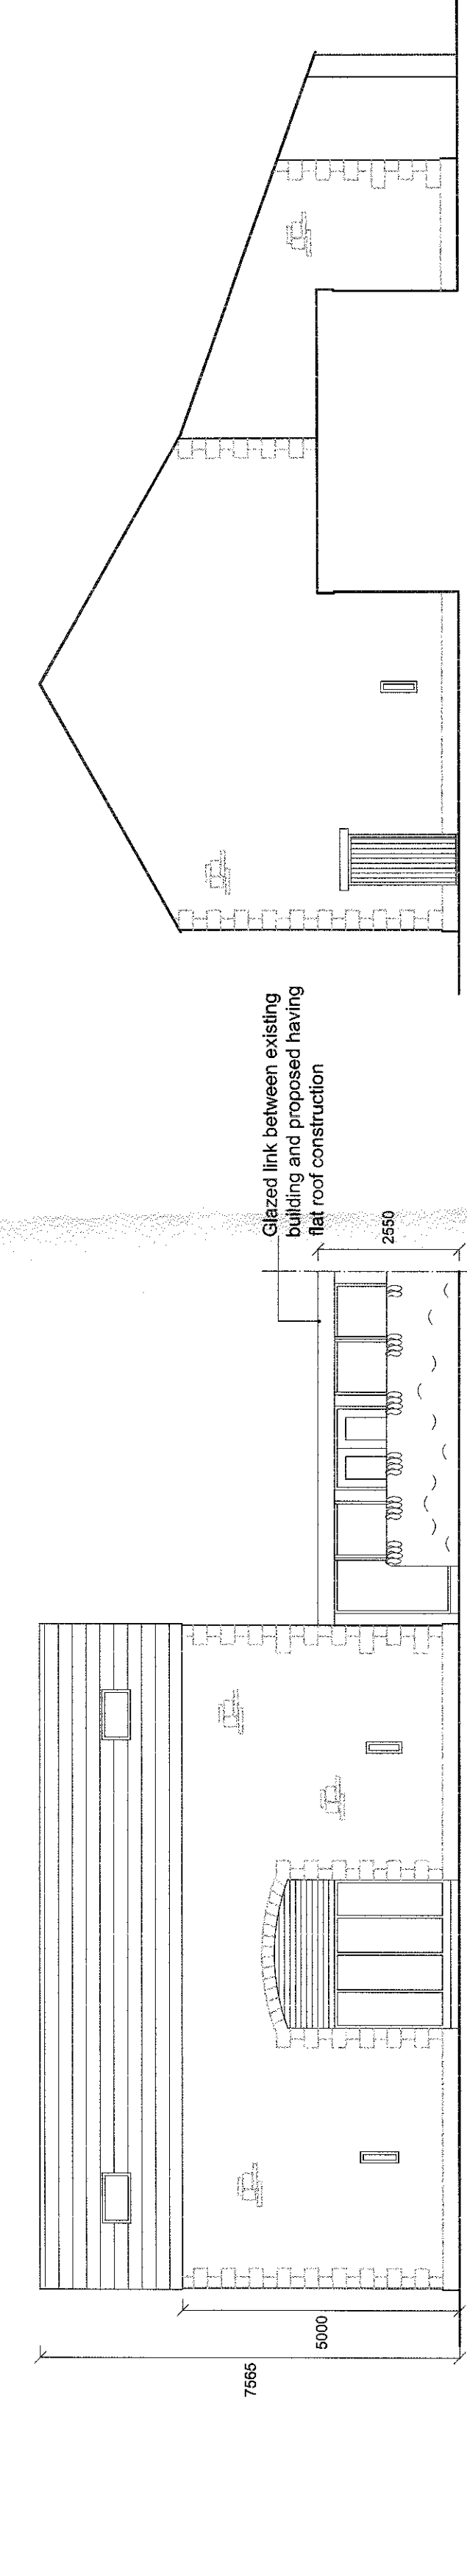


Front (South West) Elevation

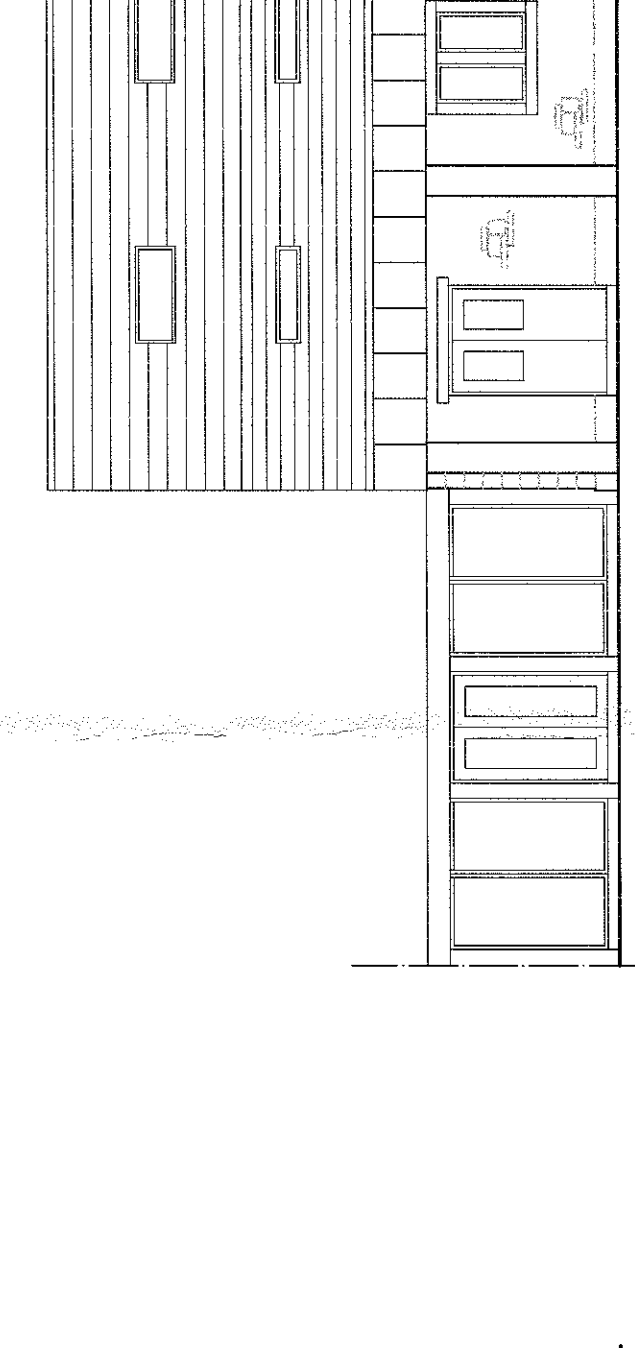

Side (South East) Elevation

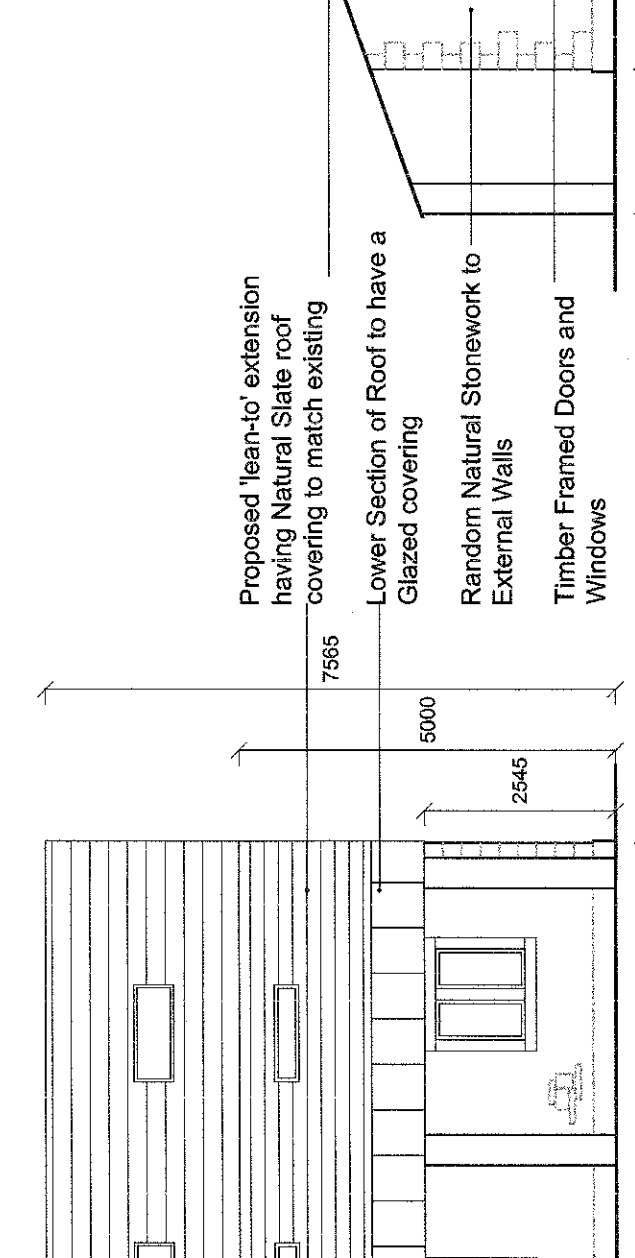

Rear (North East) Elevation

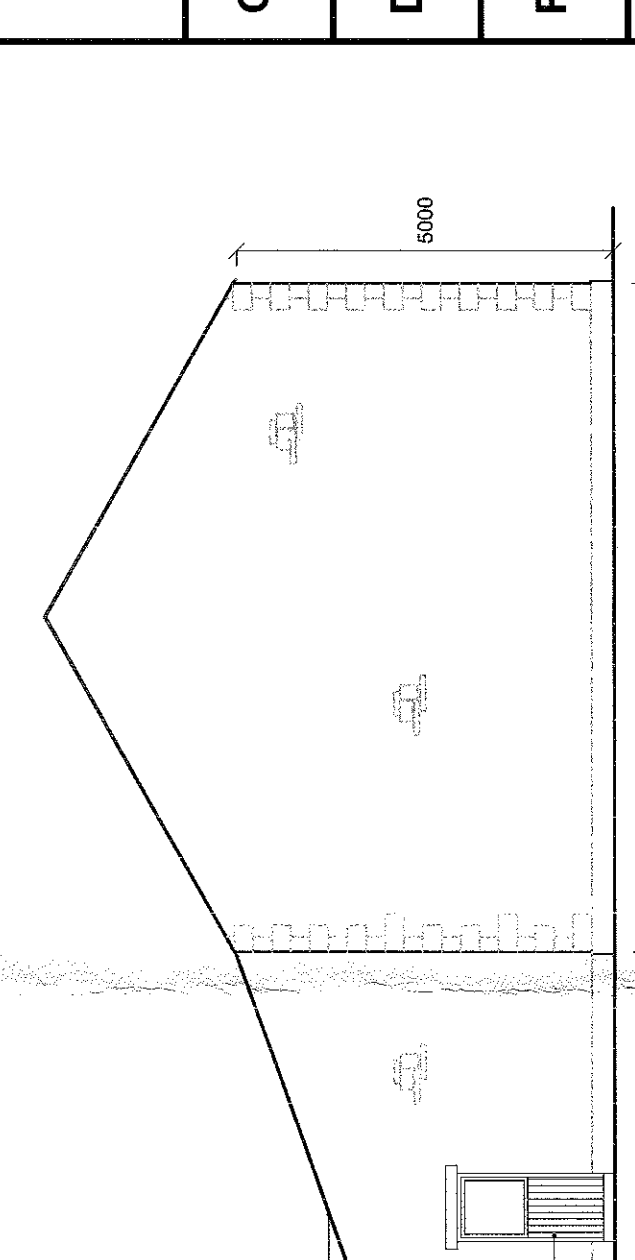

Side (North West) Elevation

Amendment A: 12.11.14 Drawings amended to incorporate the Proposed Extension(s) 'As Built'

Avalon
Chartered Town Planning

Town Planning - Architectural Design - Building Regulations - Surveying

Phone: 01282 834834 Fax: 01282 451666
West: www.avalon.co.uk Email: planning@avalon.co.uk
2 Redhill Business Centre, Redhill Road, Basingstoke, Hampshire, RG1 0 2TY

PROPOSED PLANS AND ELEVATIONS									
Site: Proposed Alterations Clough Bottom Barn Rabbit Lane Bashall Claves									
Client: Mr Harry Backhouse									
Date: 12.11.14				Scale: 1:100 @ A0					
Project No: BAC/O1c Dwg 02				Drawn: DS					
Amendments:									