


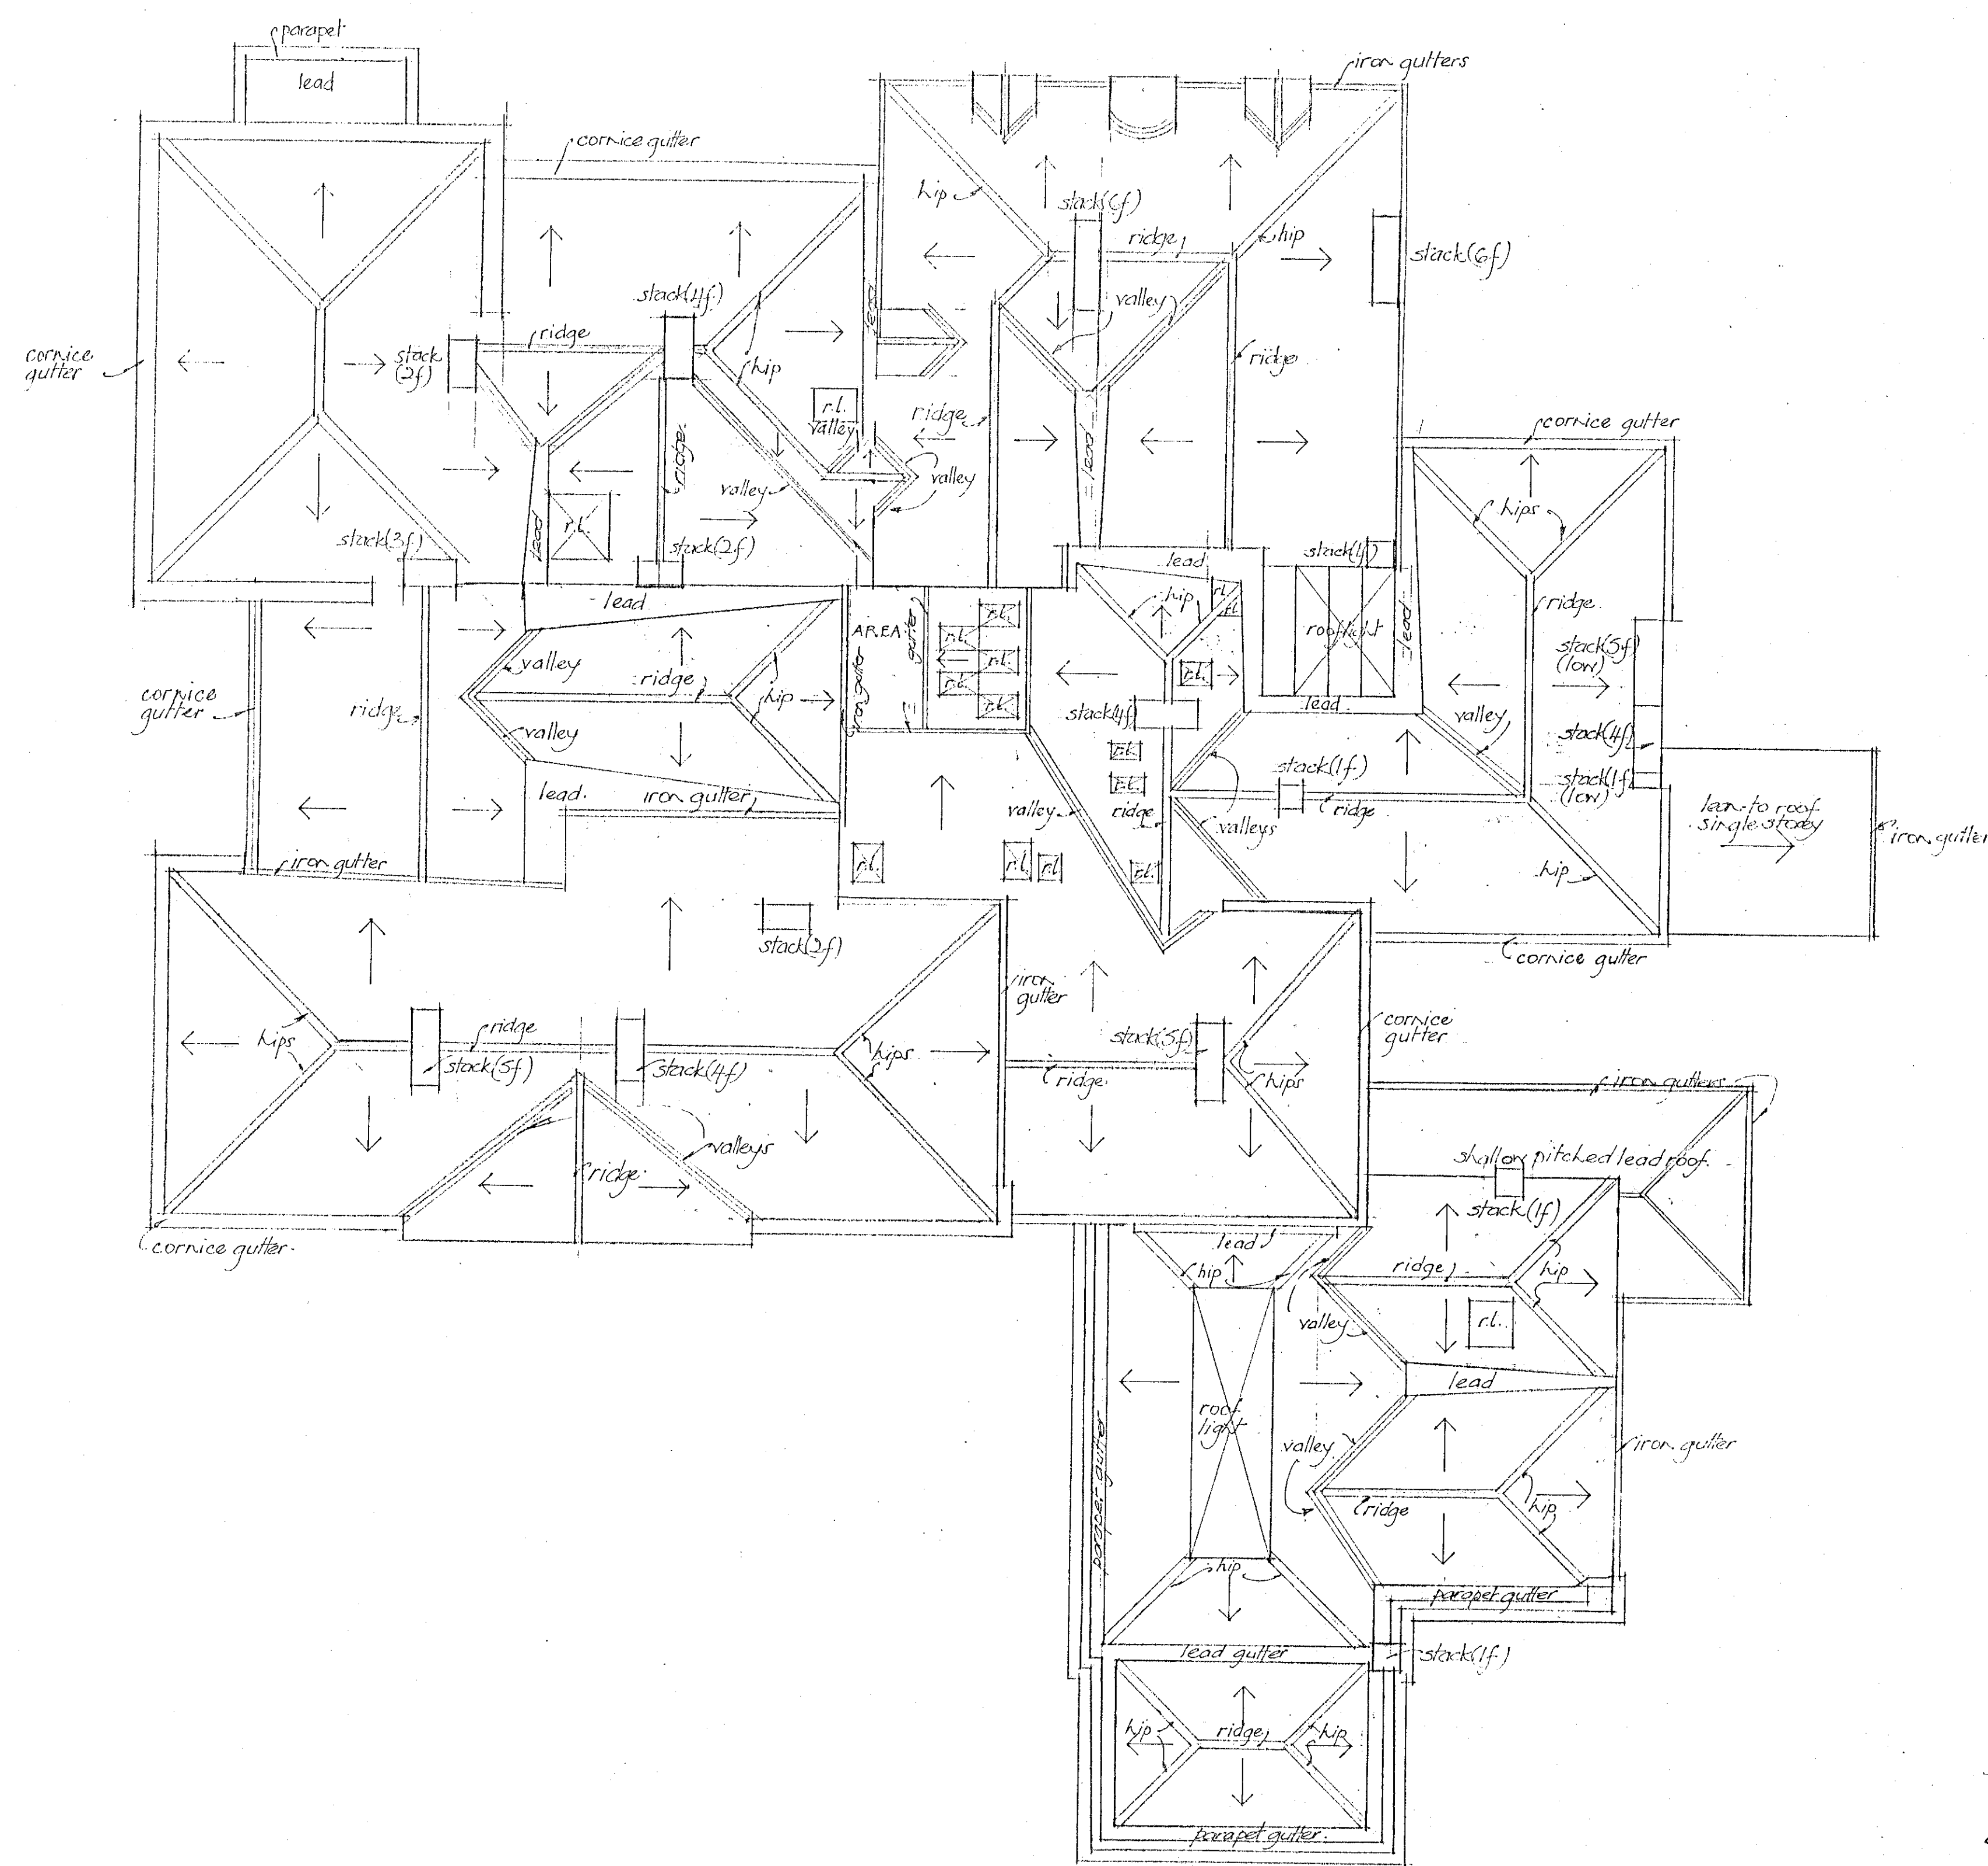

## Survey Plans - Roof Plan

Francis Johnson & Partners  
Architects. 'Craven House'  
16 High Street, Endlington  
East Yorkshire YO16 4PT  
Tel 01262 674043  
info@francis-johnson-architects.co.uk

2743/109

Record copy.