



this drawing is to be read in conjunction with all relevant consultants and specialists drawings. the architect is to be notified of any discrepancies before proceeding. do not scale from this drawing. all dimensions are to be checked on site. this drawing is subject to copyright.

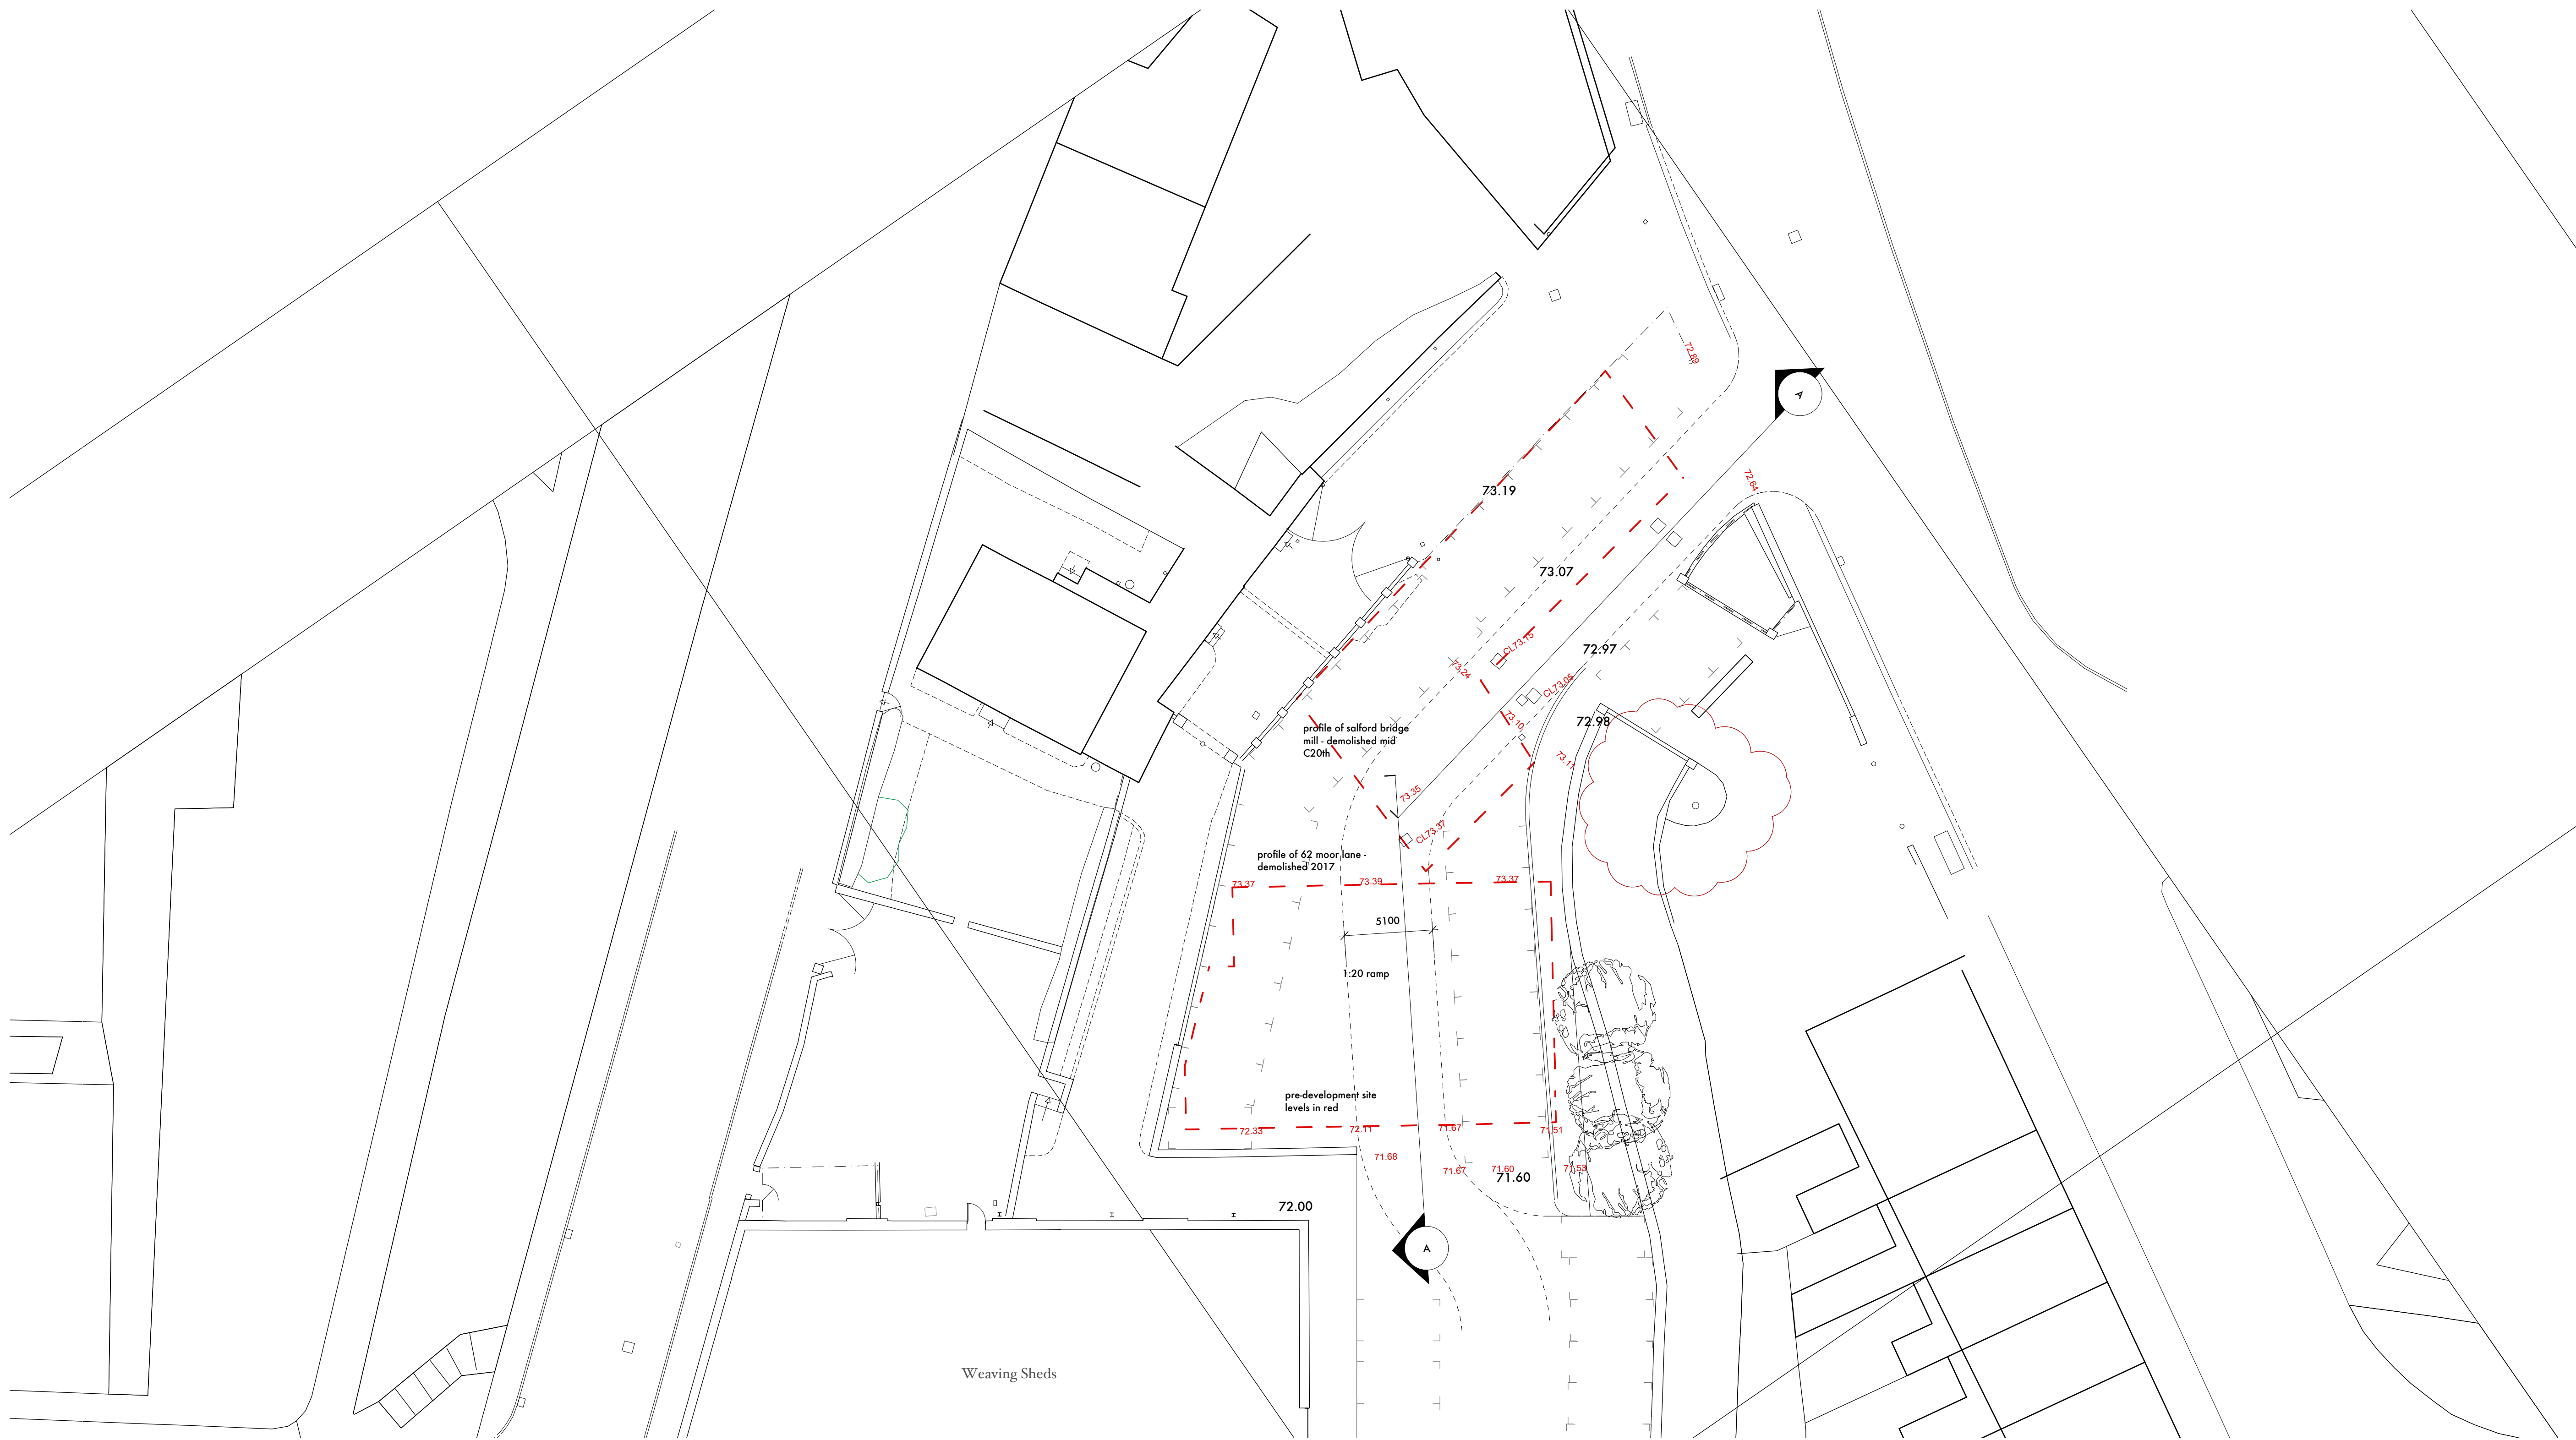


A Issued for Information Apr 2016

The temporary access has confirmed that 62 moor lane was built on a thick layer of hard core to raise the levels artificially. The new access will not break through the C20th century build up across the site. There is also anecdotal evidence that there is a buried fuel tank at the front of the site

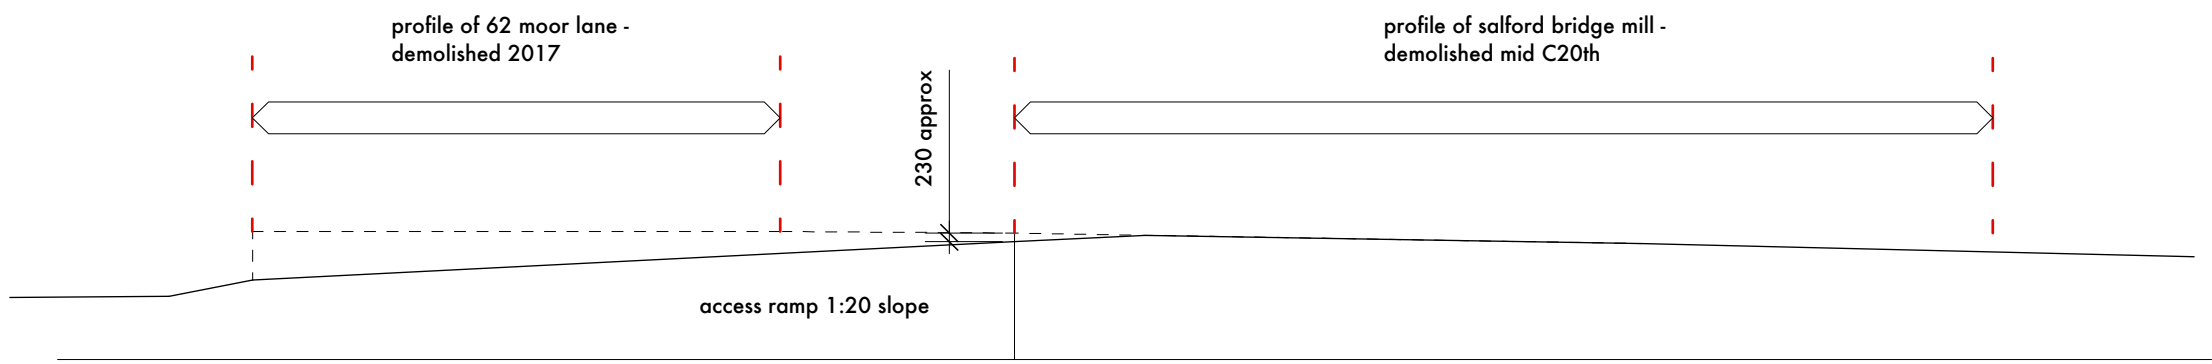

A Section Scale: 1:200

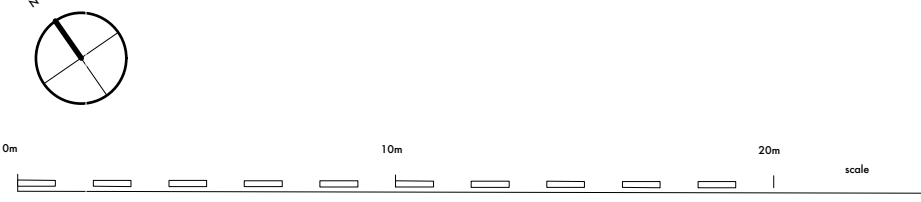

stanton andrews architects

44 york street
clitheroe
BB7 2DL

t 01200 444490
e mail@stantonandrews.co.uk
w stantonandrews.co.uk

Emporia Leisure Limited
Holmes Mill

Holmes Mill
Ramp Access

drg.no. 14/59 SK10 rev. A

drawn. cs date. dec 2016 scale. 1 to 250 @A1