



This drawing is to be read in conjunction with all relevant Architect, consultants' and specialists' drawings and specifications. The Architect is to be notified of any discrepancies before proceeding. Do not scale from this drawing. All dimensions and levels are to be checked on site. This drawing is subject to copyright. All work carried out before Planning and Building Permission has been granted is at the contractor/clients risk.




Part Front Elevation

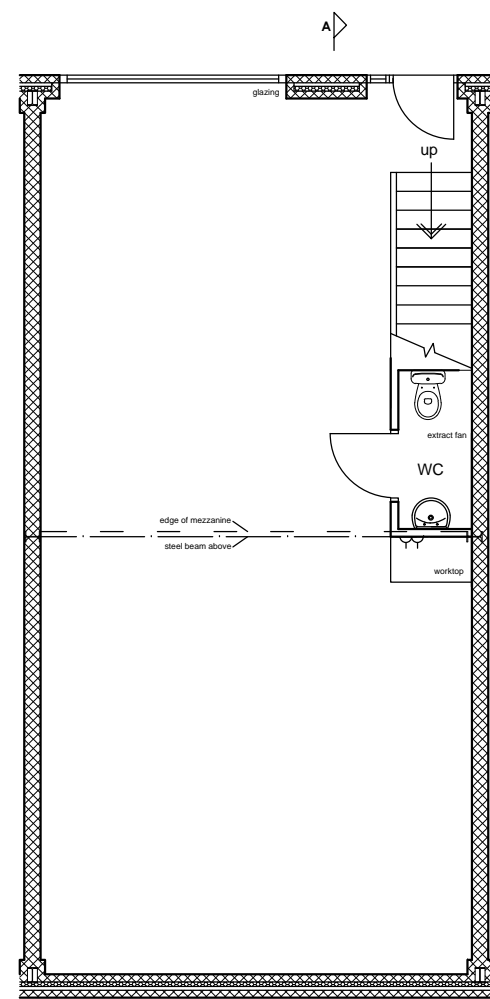

Ground Floor Plan

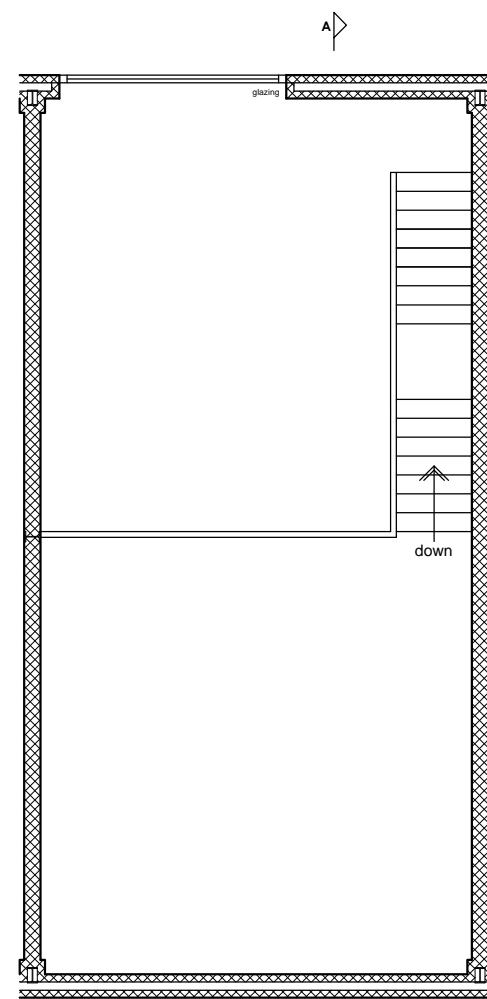

First Floor Plan

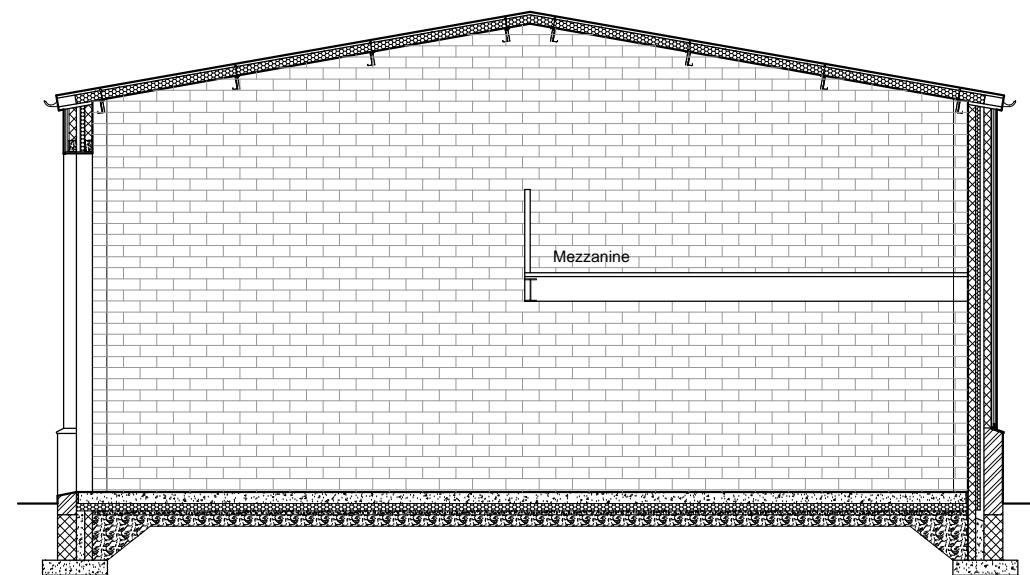

Section AA

Client  
A.I Land Ltd

Job Title  
Mitton Road Business Park  
Mitton Road  
Whalley

Drawing Title  
UNIT 13 AS BUILT

Scale 1:100 @ A3	Date May 2017	Drawn LFG
---------------------	------------------	--------------

**spa**  
SUNDERLAND PEACOCK ARCHITECTS  
SUNDERLAND PEACOCK & ASSOCIATES LTD.  
HAZELMERE, PIMLICO ROAD, GLITHEROE  
LANCASHIRE, BB7 2AG  
T 01200 423178 F 01200 427328  
E info@sunderlandpeacock.com  
www.sunderlandpeacock.com



**MRBP -13**