




Front Elevation (north)

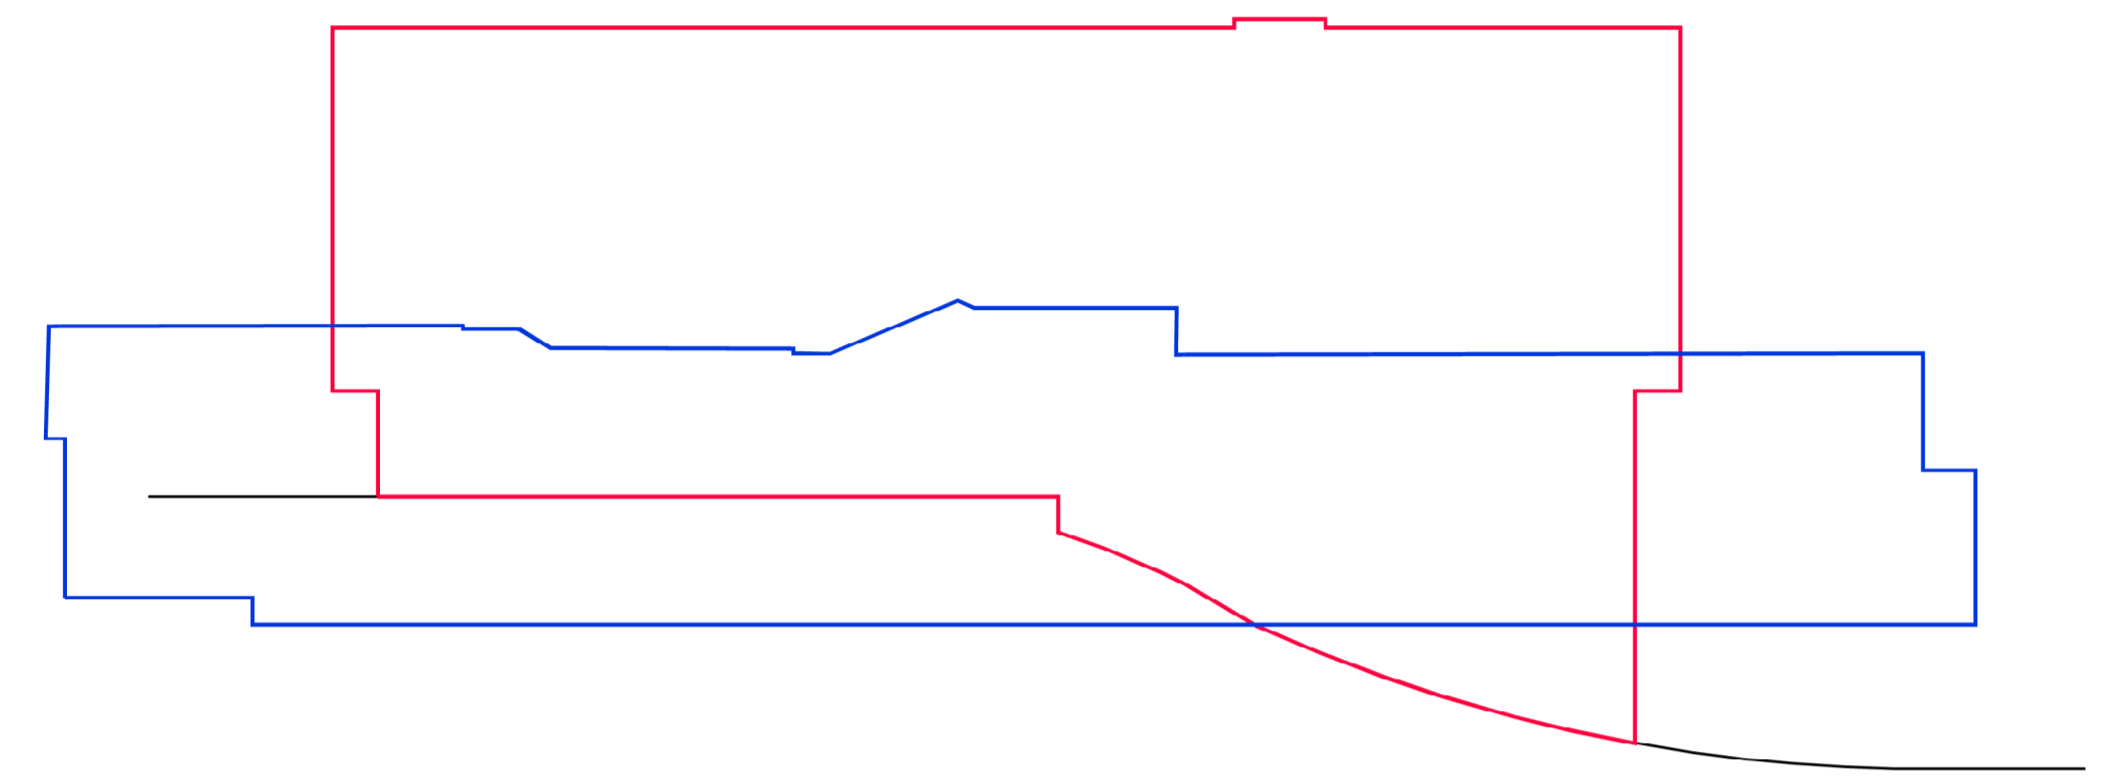



Side Elevation (east)

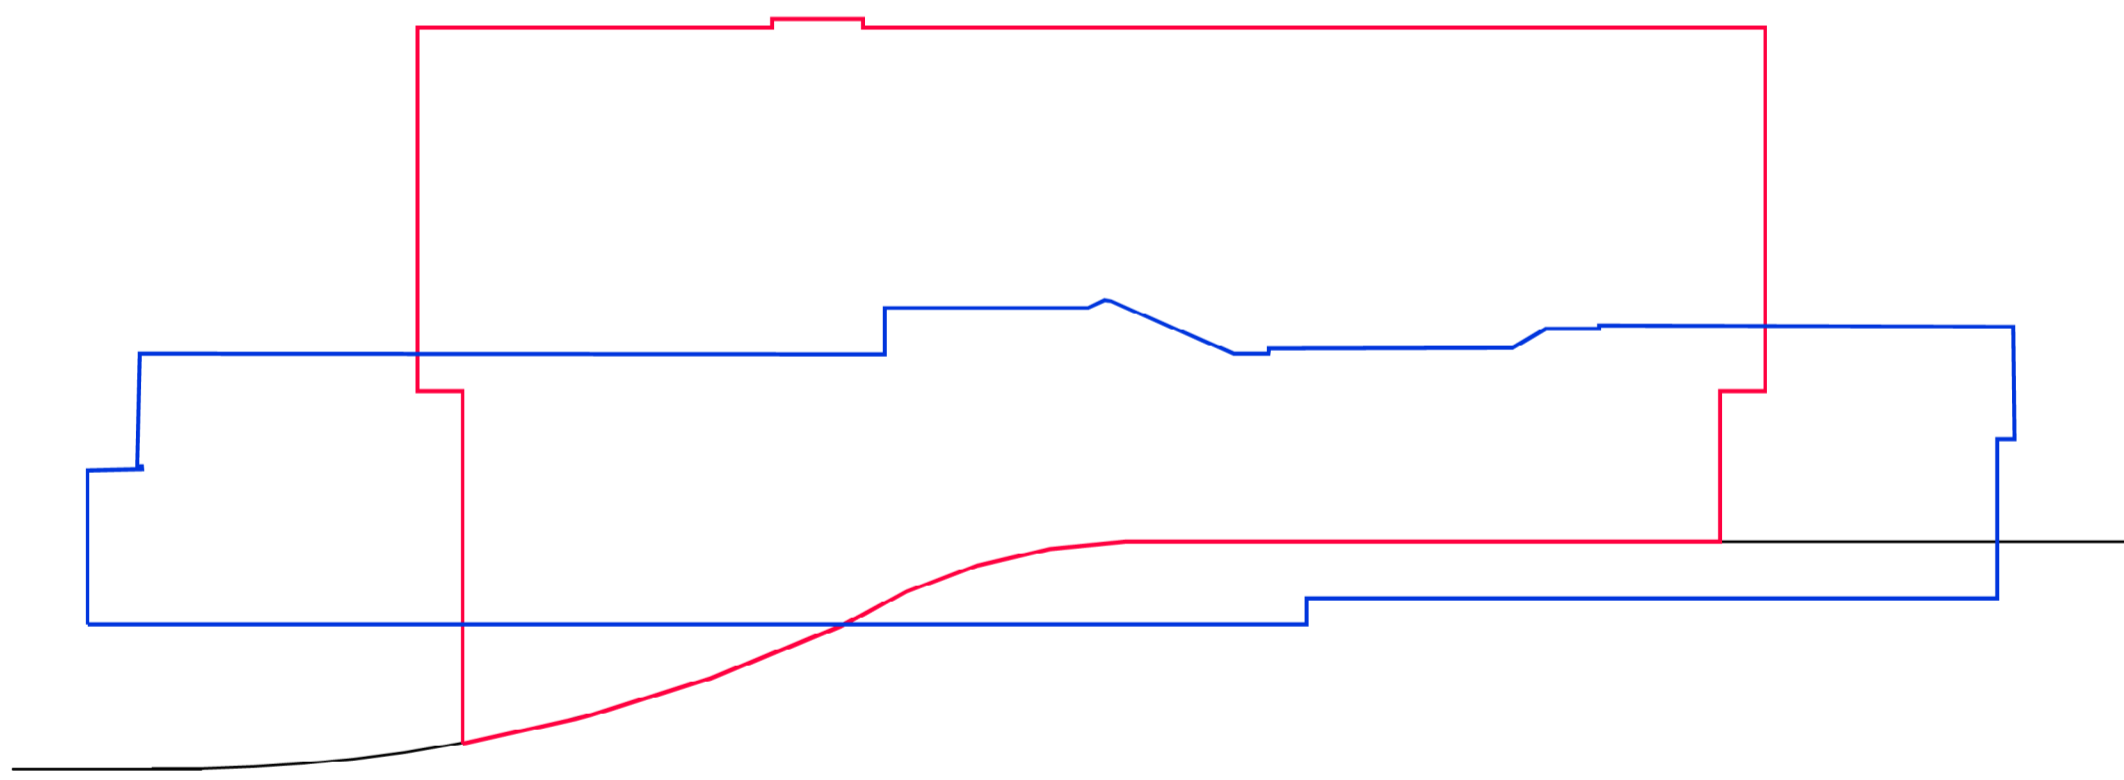

Side Elevation (west)

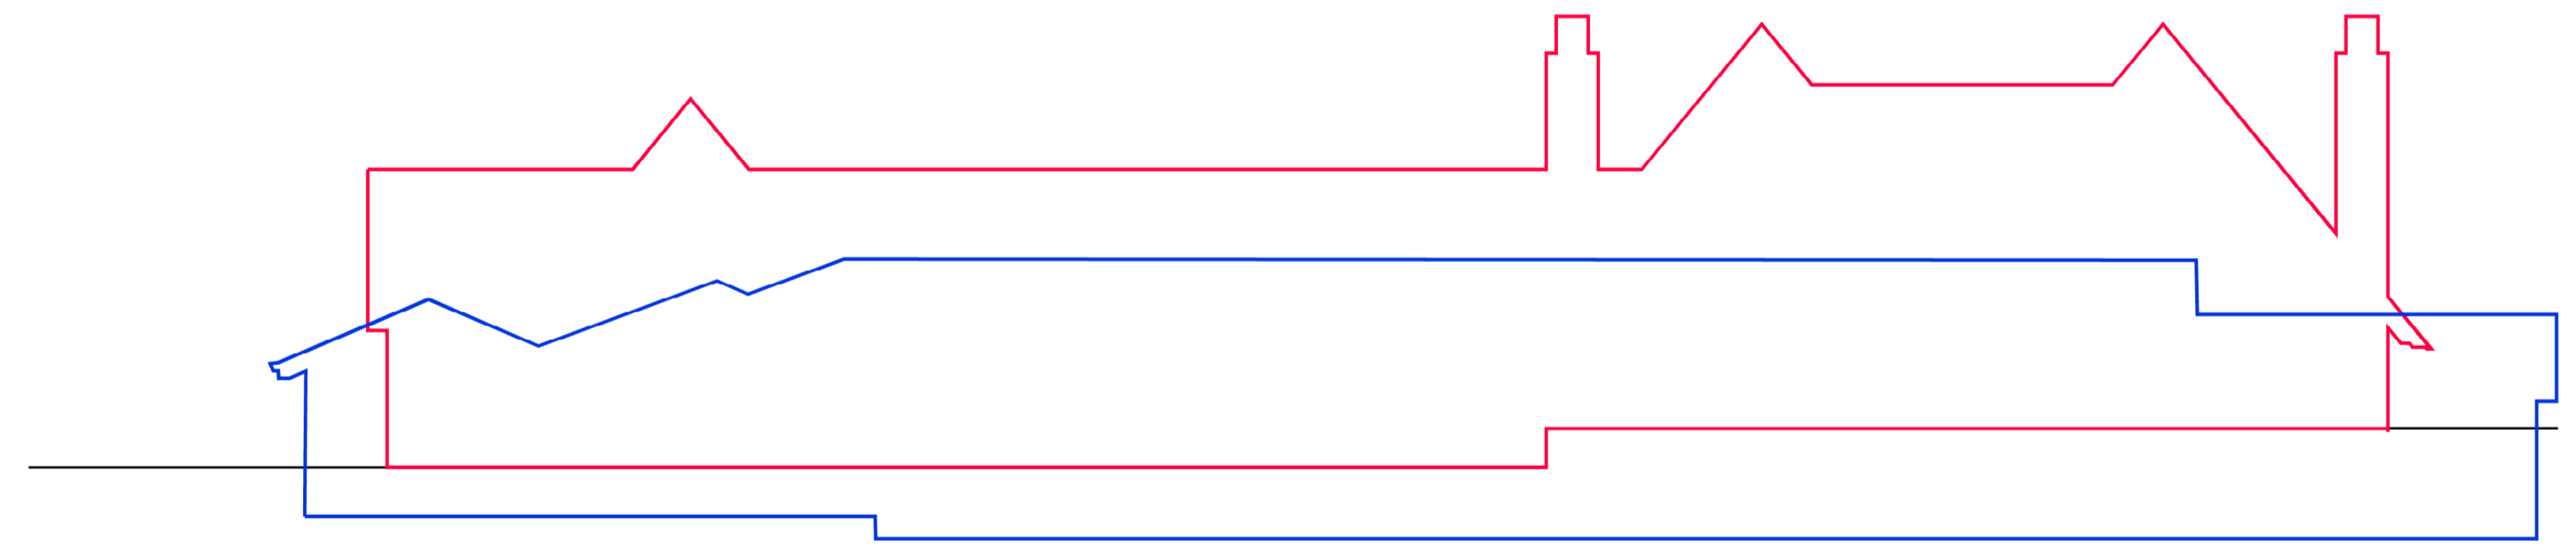

Rear Elevation (south)

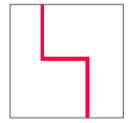-  Red line - proposed elevation
-  Blue line - existing elevation