


3/2017/1066

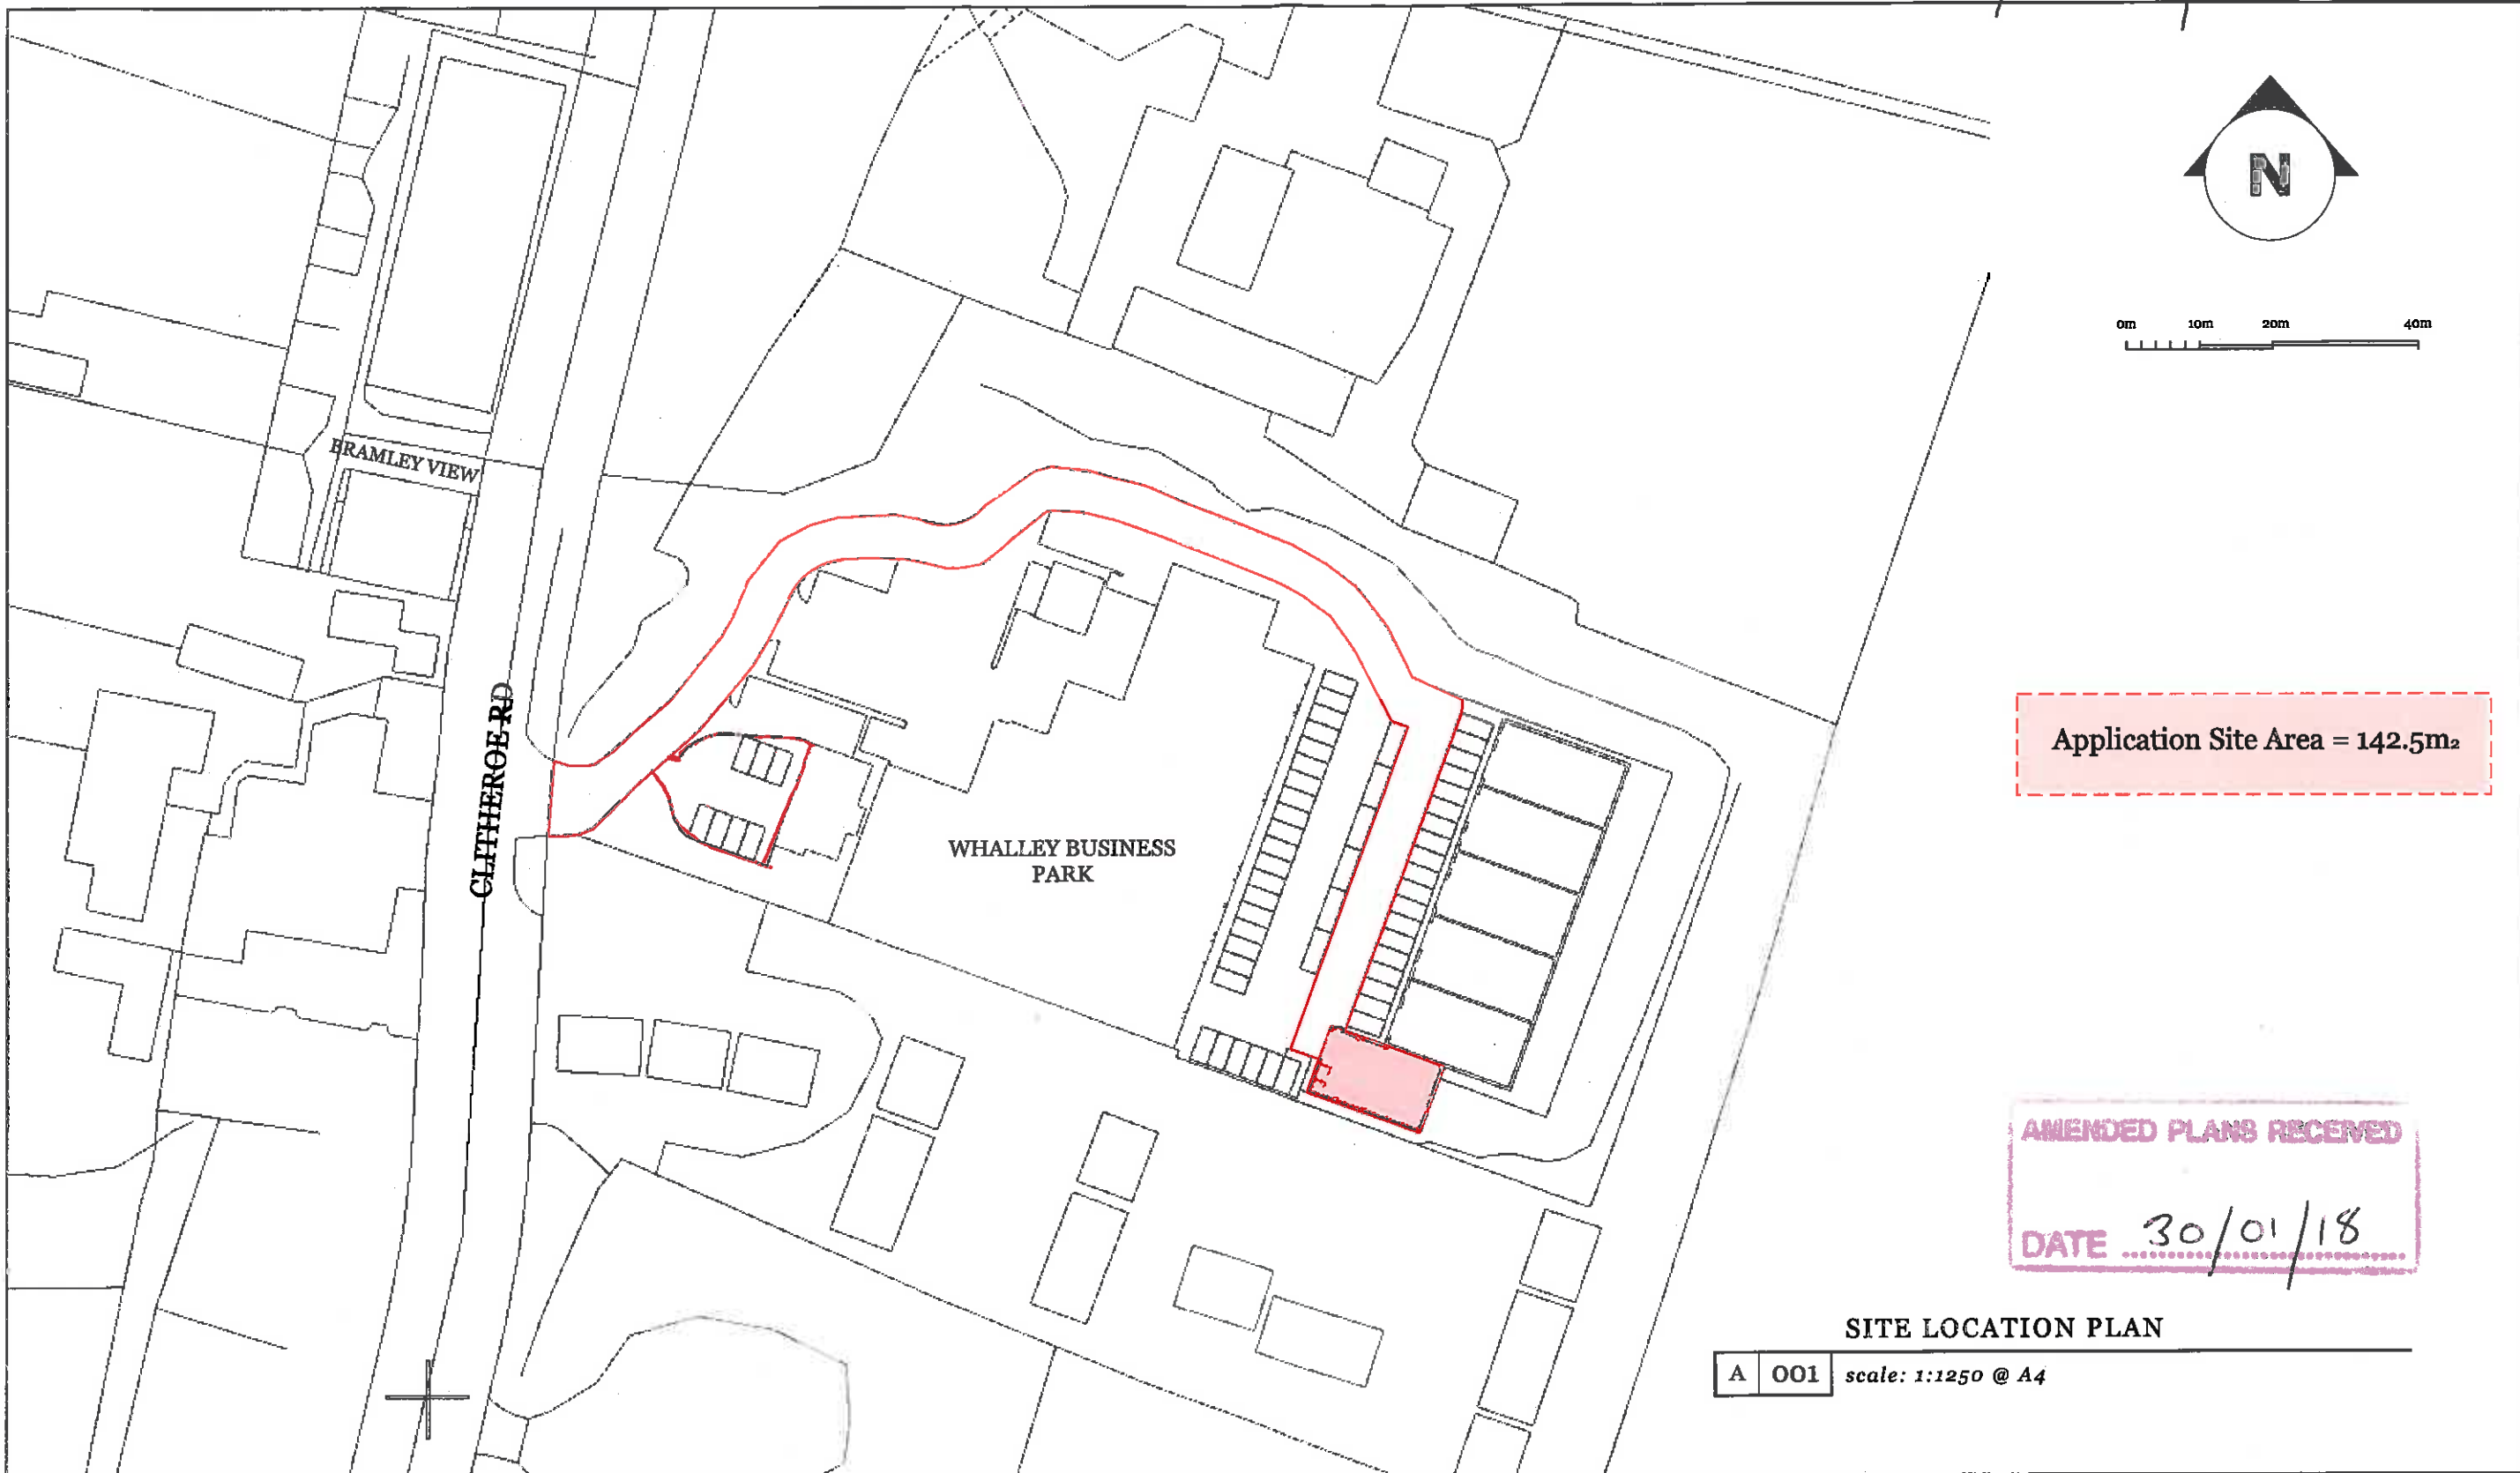

Application Site Area = 142.5m²

AMENDED PLANS RECEIVED
DATE 30/01/18

SITE LOCATION PLAN

A 001 scale: 1:1250 @ A4

SITE LOCATION PLAN

**HUNTAR
HAUS**

Design Studio
15 Plover Close
West Lancs
PR9 8RU

P: 01704 232068
E: design@huntarhaus.co.uk
W: www.huntarhaus.co.uk
F: @huntarhaus


17.003_Whalley Business Park, Clitheroe Rd

REVISIONS

	MM/DD/YY	REMARKS
1	16/11/17	Red line extended to full vehicular access at LA request
2	30/01/17	Site layout revised to indicate parking
3	---/---/---	...
4	---/---/---	...
5	---/---/---	...

A 01

3/2017/1066

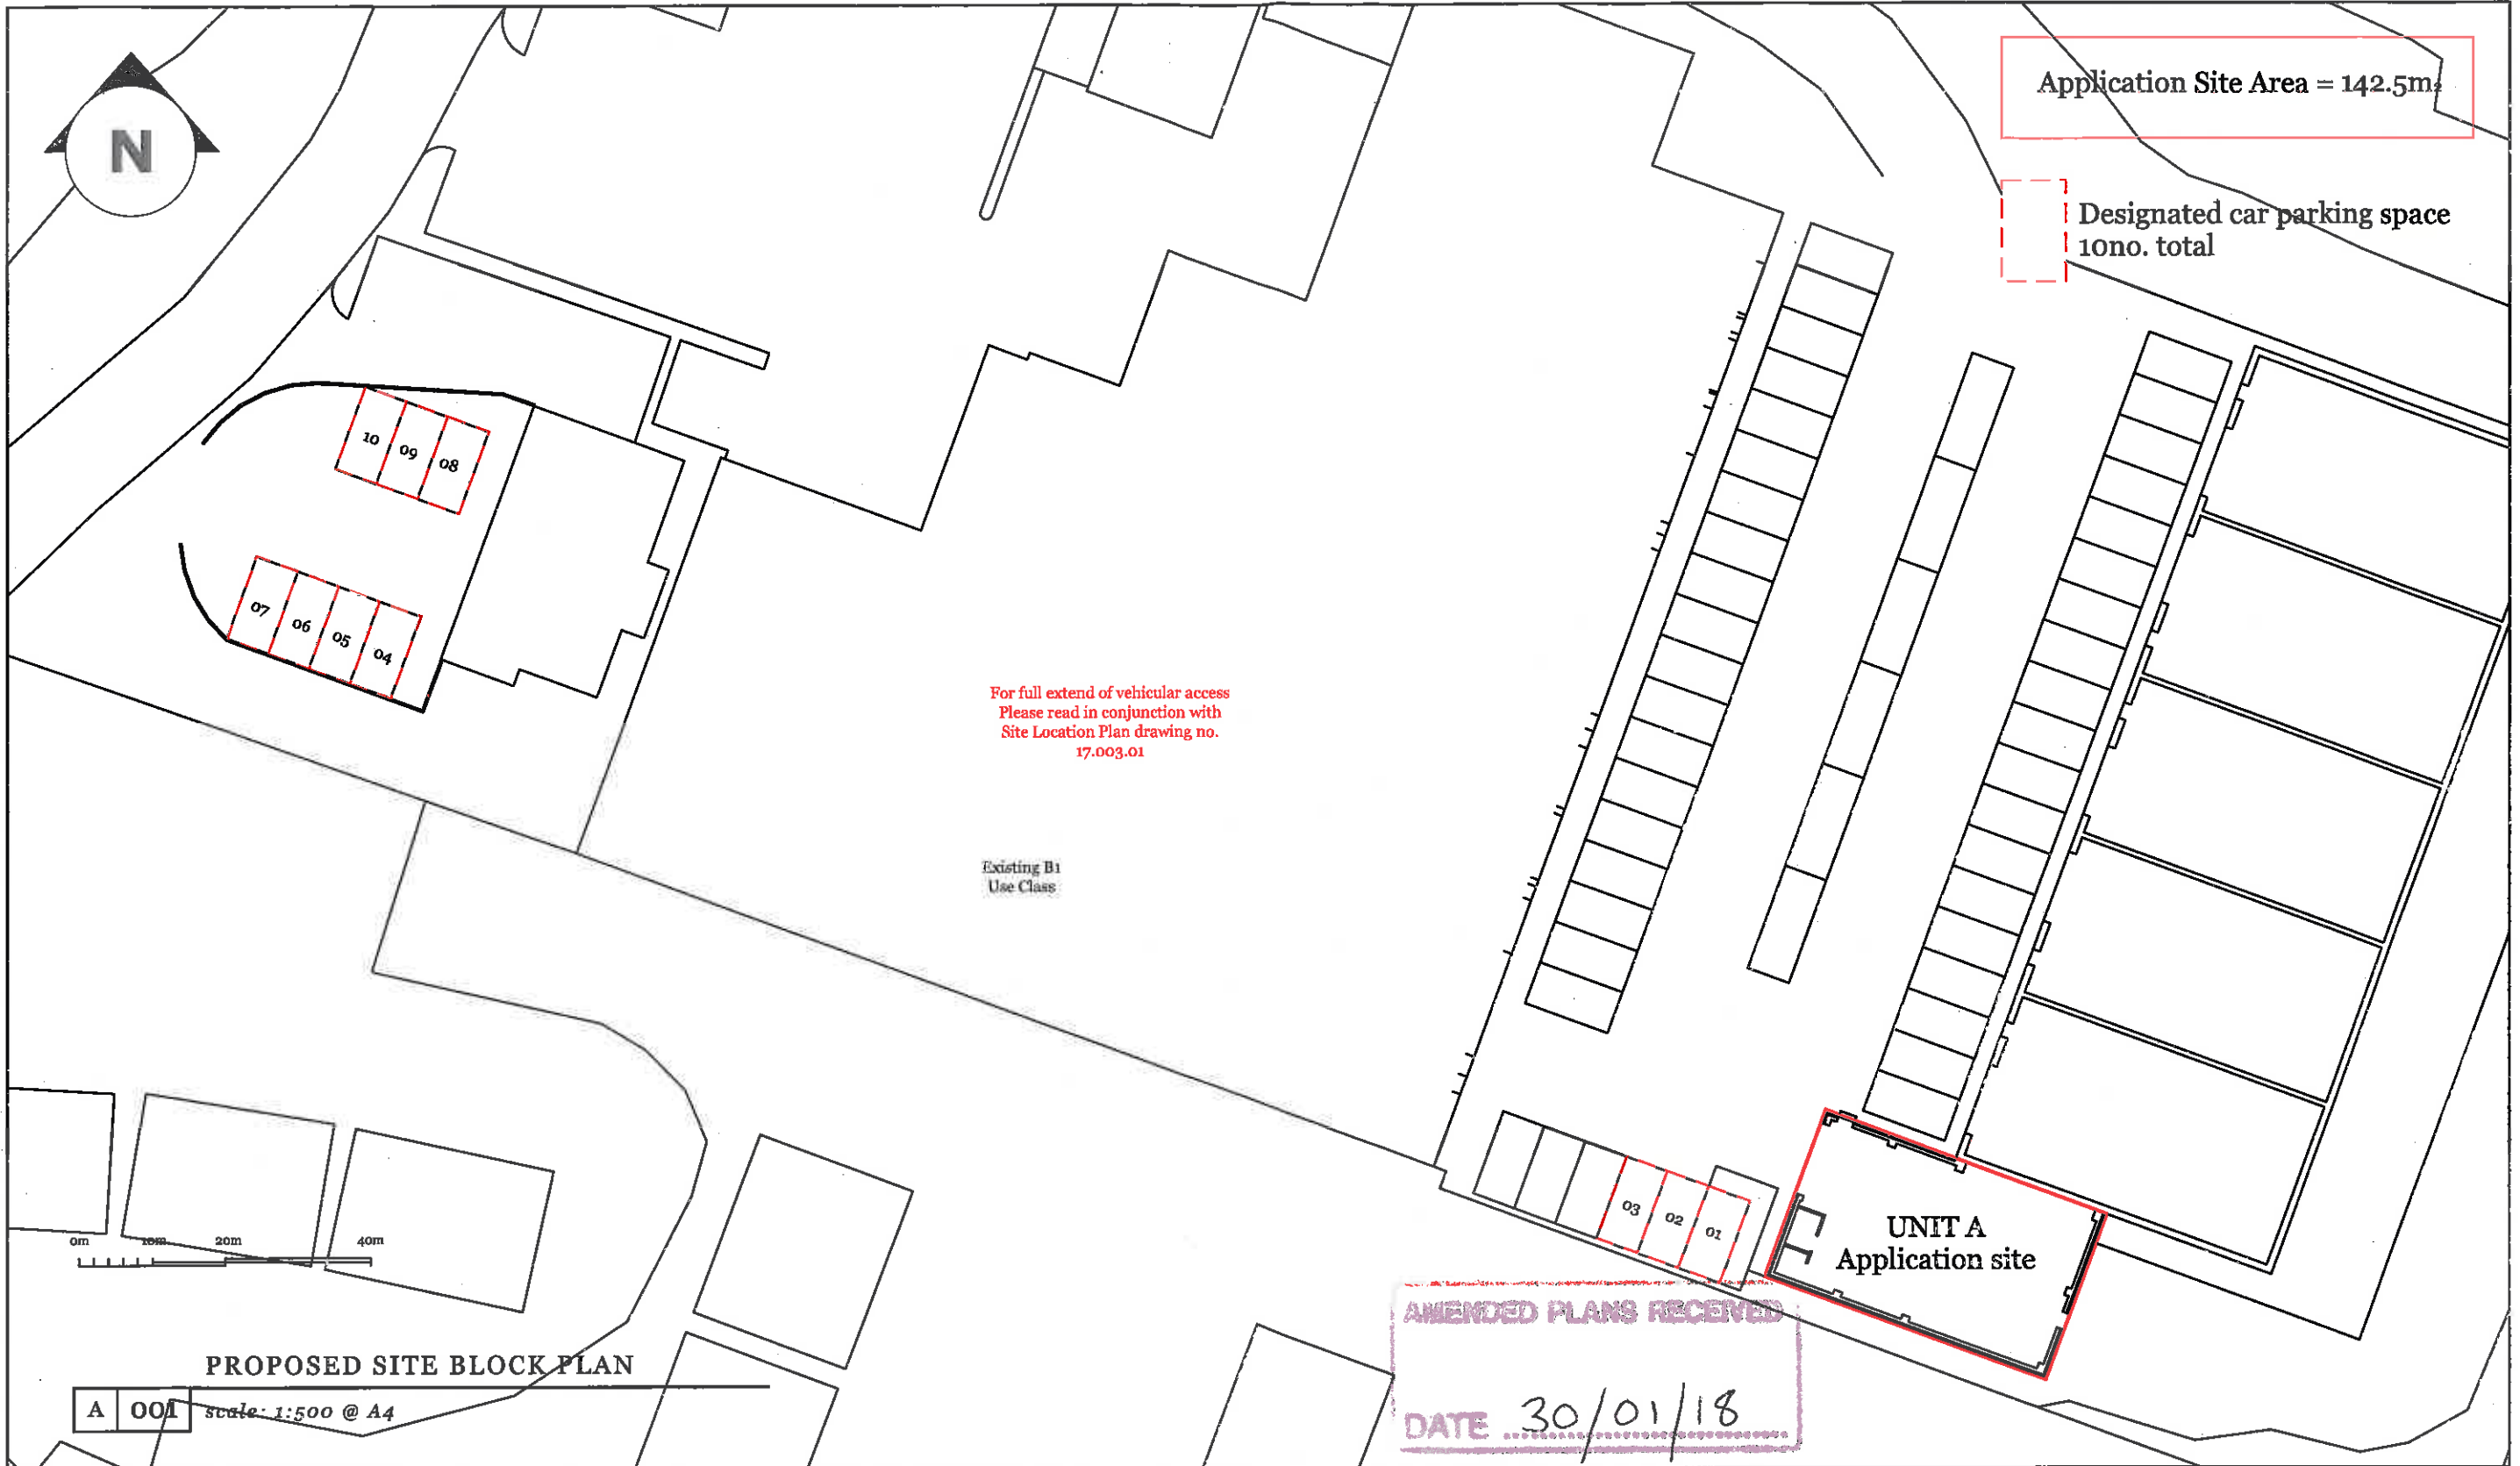

SITE BLOCK PLAN

HUNTAR HAUS
 Design Studio
 15 Plover Close
 West Lancs
 PR9 8RU
 P: 01704 232068
 E: design@huntarhaus.co.uk
 W: www.huntarhaus.co.uk
 F: @huntarhaus
 17.003_Whalley Business Park, Clitheroe Rd

REVISIONS	
MM/DD/YY	REMARKS
1 16/11/17	Red line extended to full vehicular access at LA request
2 30/01/17	Site layout revised to indicate parking
3	...
4	...
5	...

A 02