


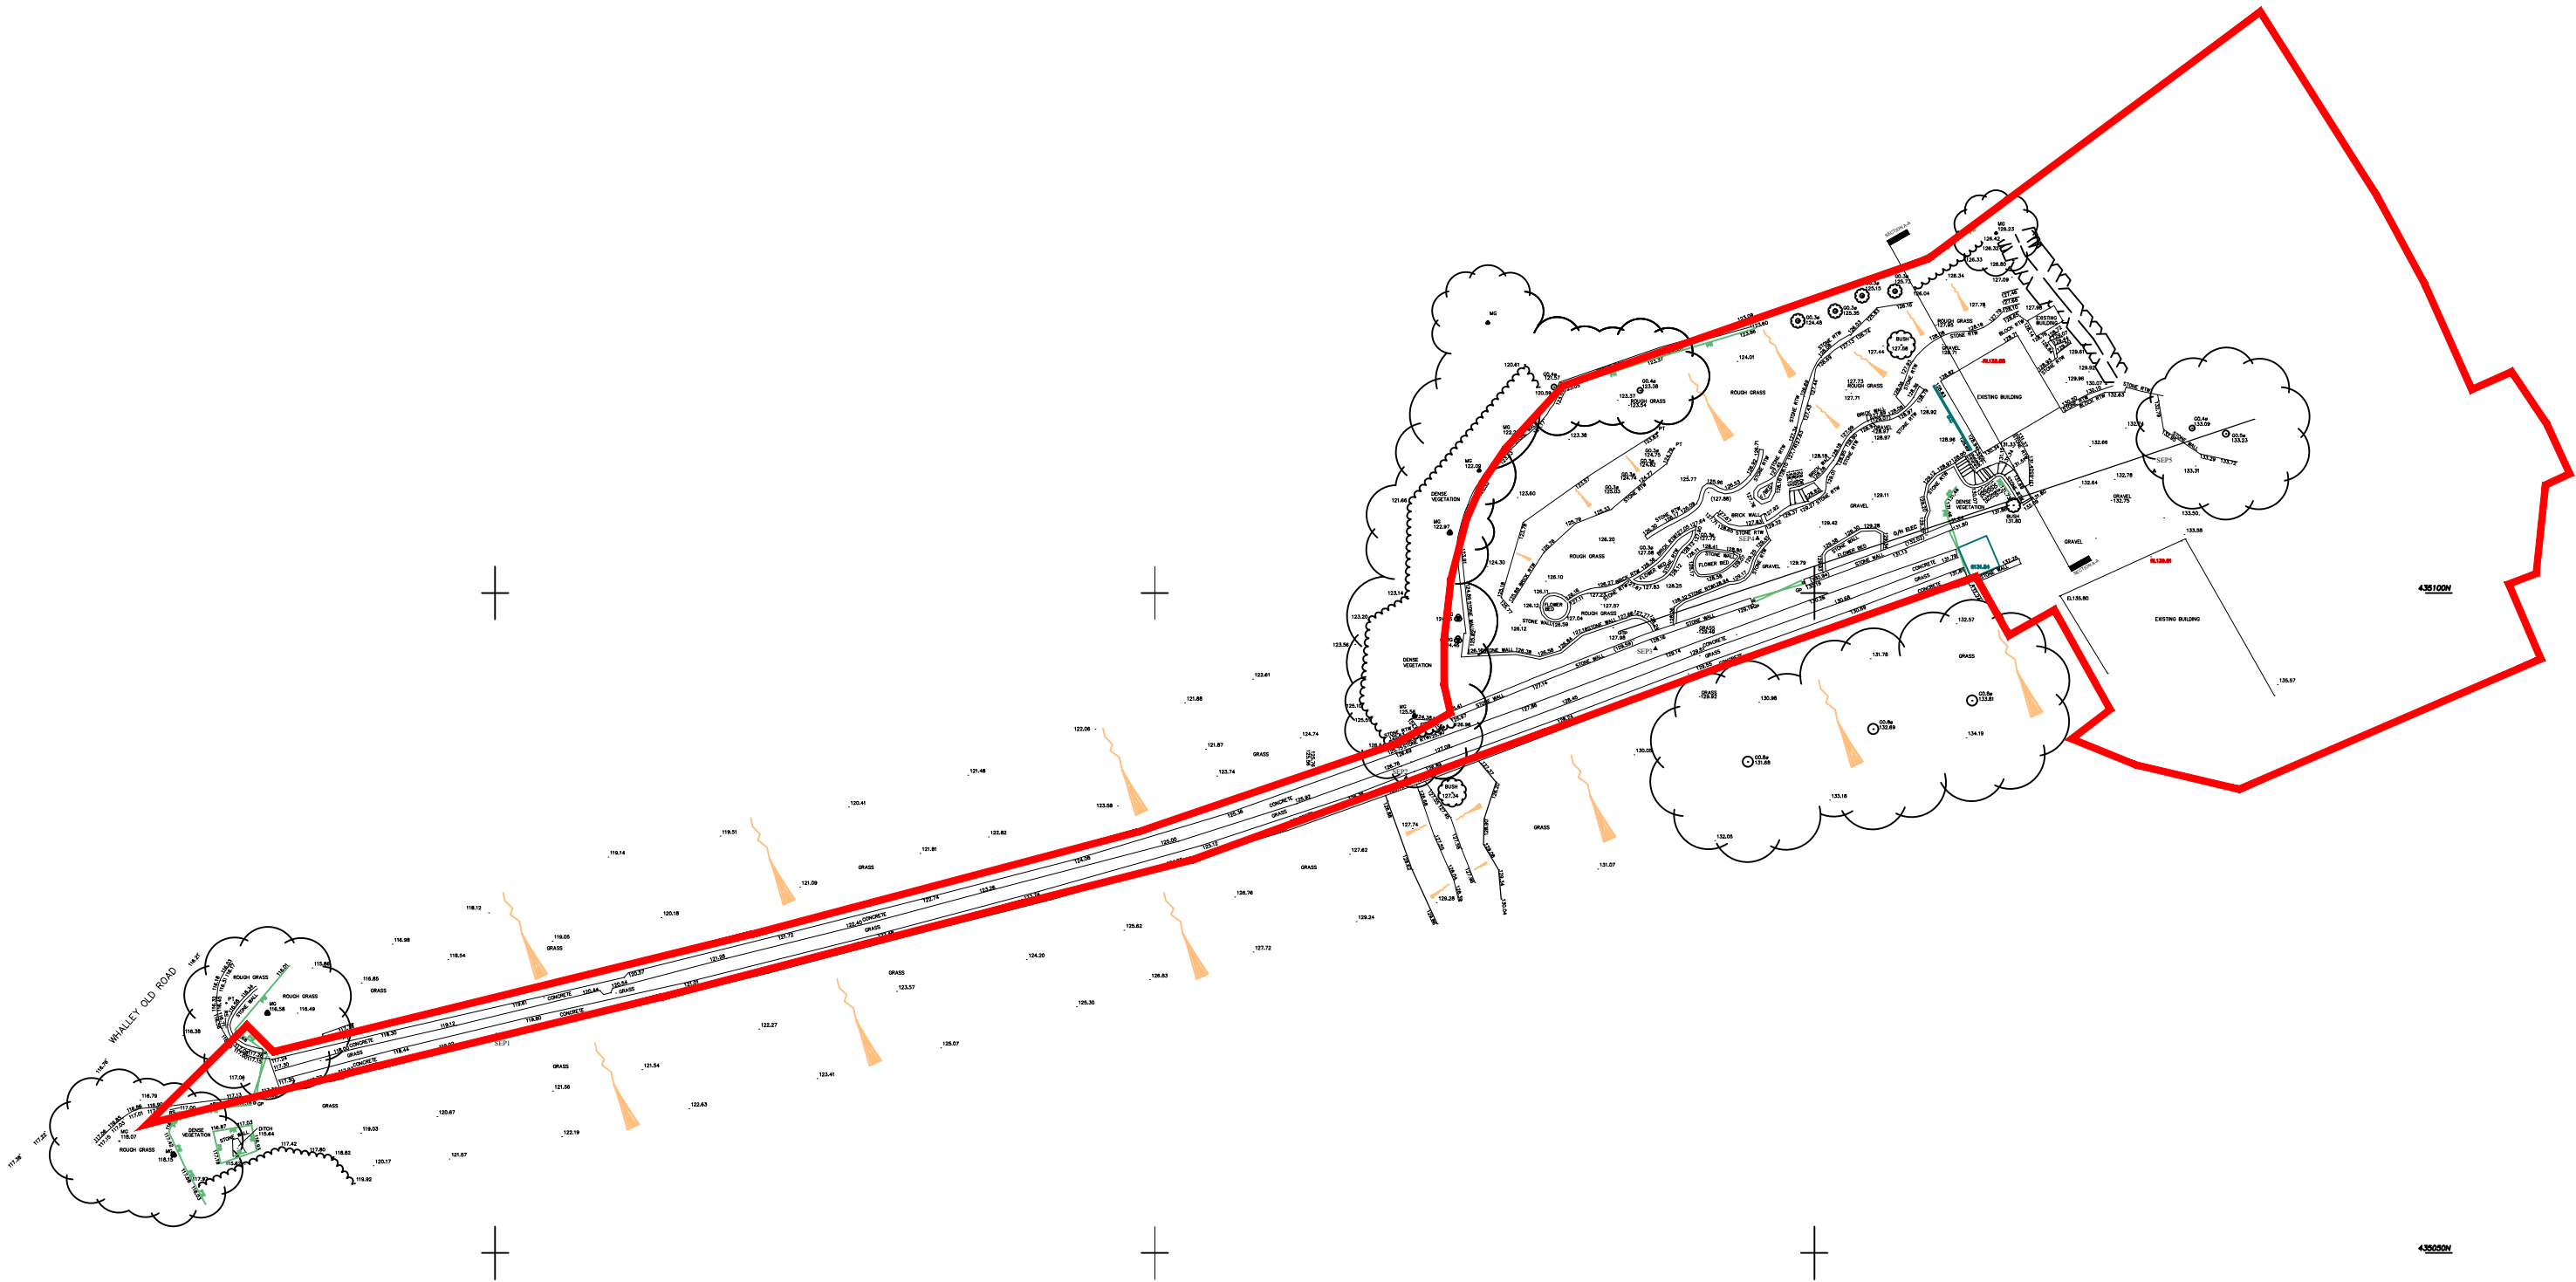

RED LINE DENOTES SITE BOUNDARY

Project
Calder Bank Cottage, Whalley Old Road,
BB7 0JE

Drawing Title
Existing Topographical Survey

Drawn	Checked	Paper Size	Scale	Date
PL	PL	A3	1:500 @ A3	JULY 2018
Project No.	18 - 262	Drawing No.	002	Revision
				A



Philip Lambert Architecture Ltd.
3 Eastbourne Grove, Bolton, BL1 5TR
Tel. 07811118904