




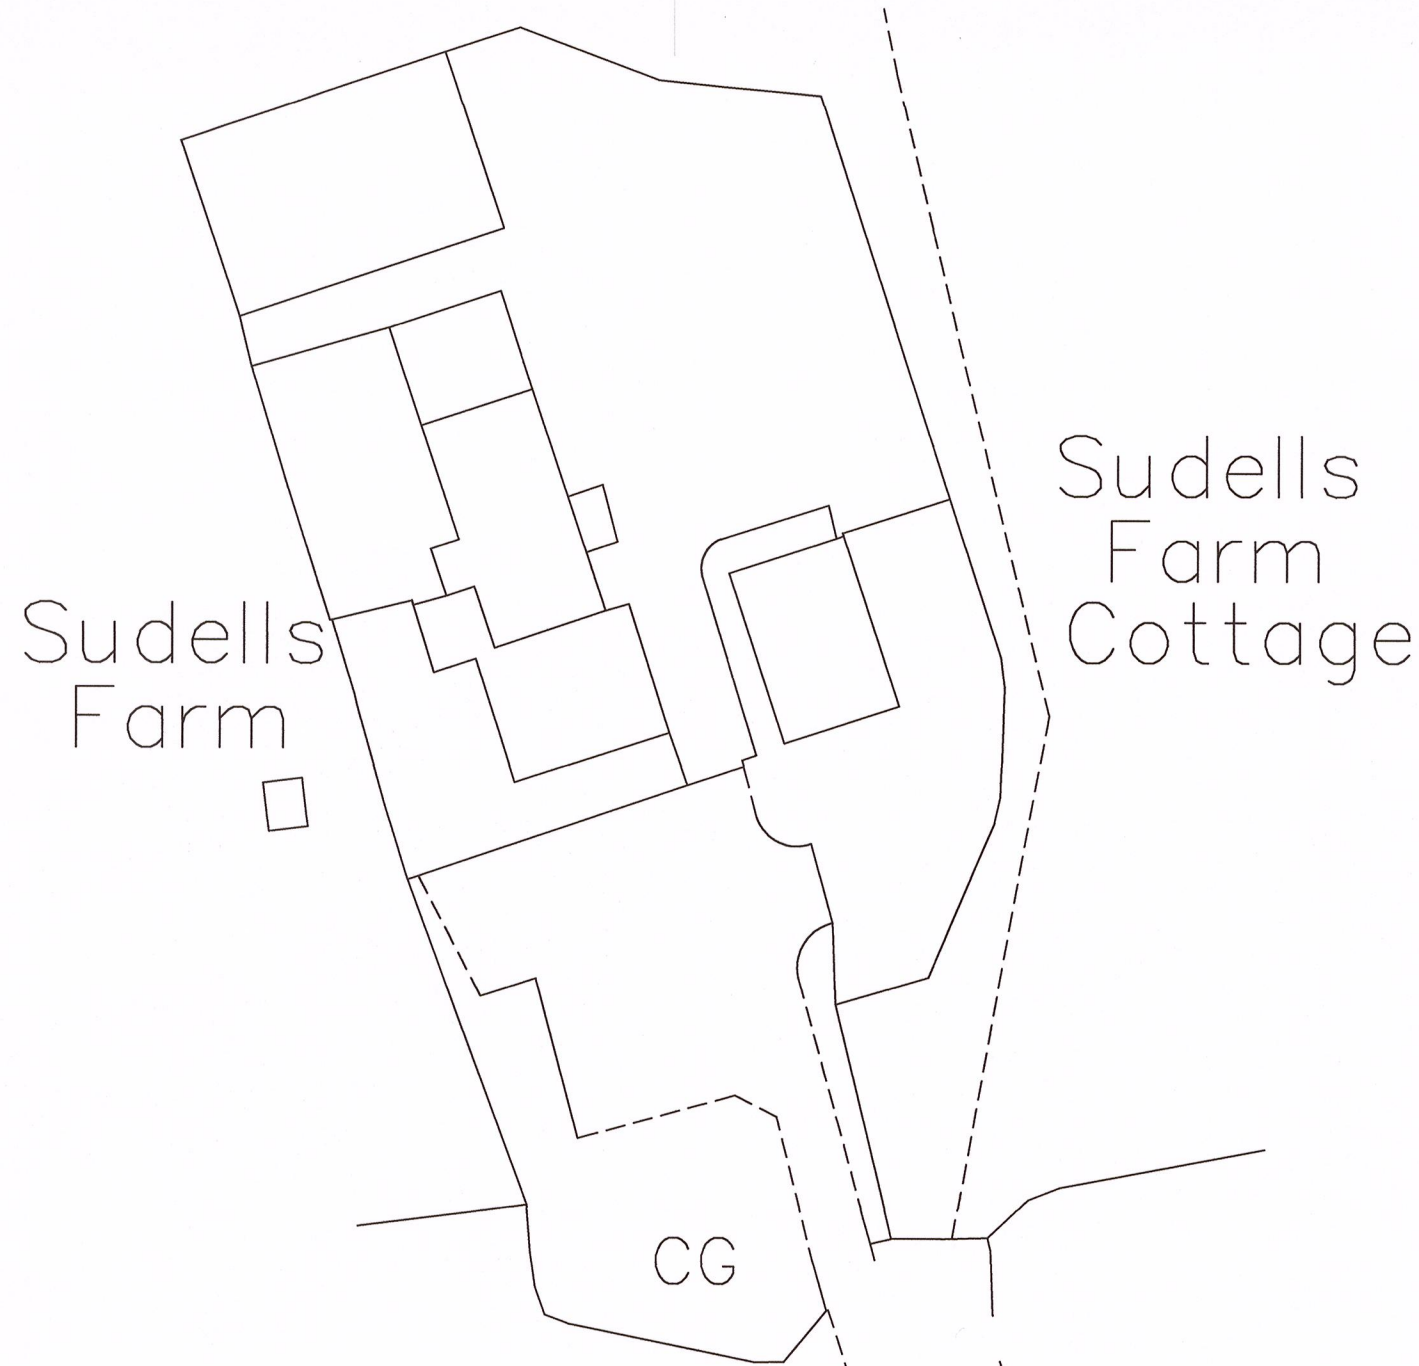


Site Plan - 1:500

Black outline denotes proposed location of building.

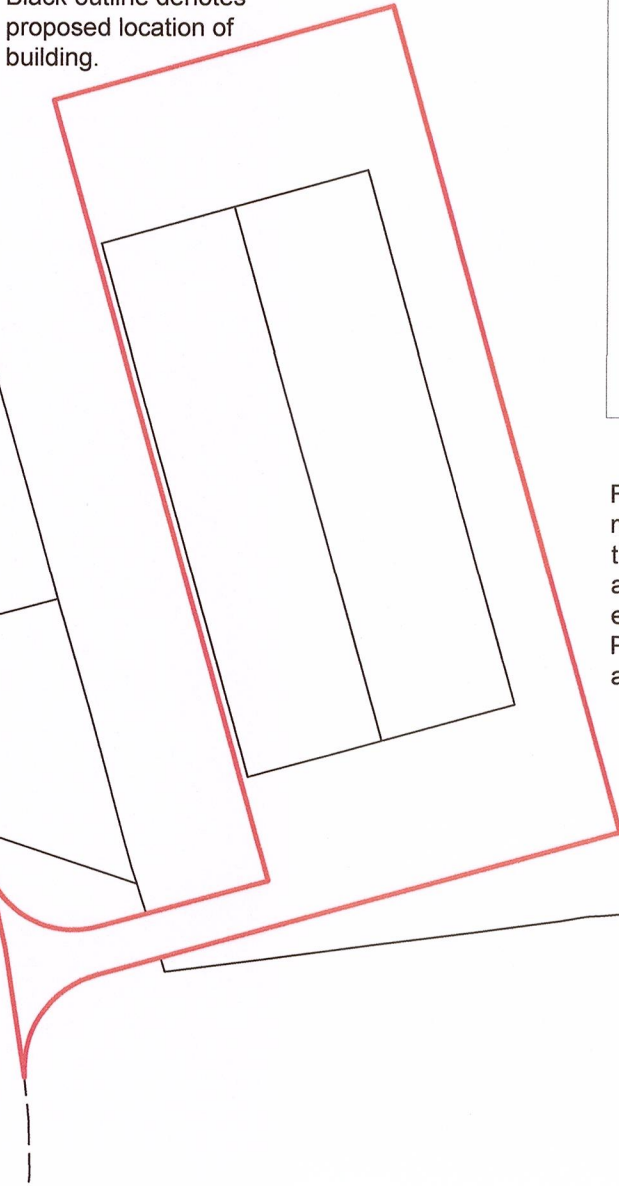

Red outline denotes a 1 metre deep yard area to the north and south end and a 5 metre track to the east side of building. Proposed new access also shown in Red.

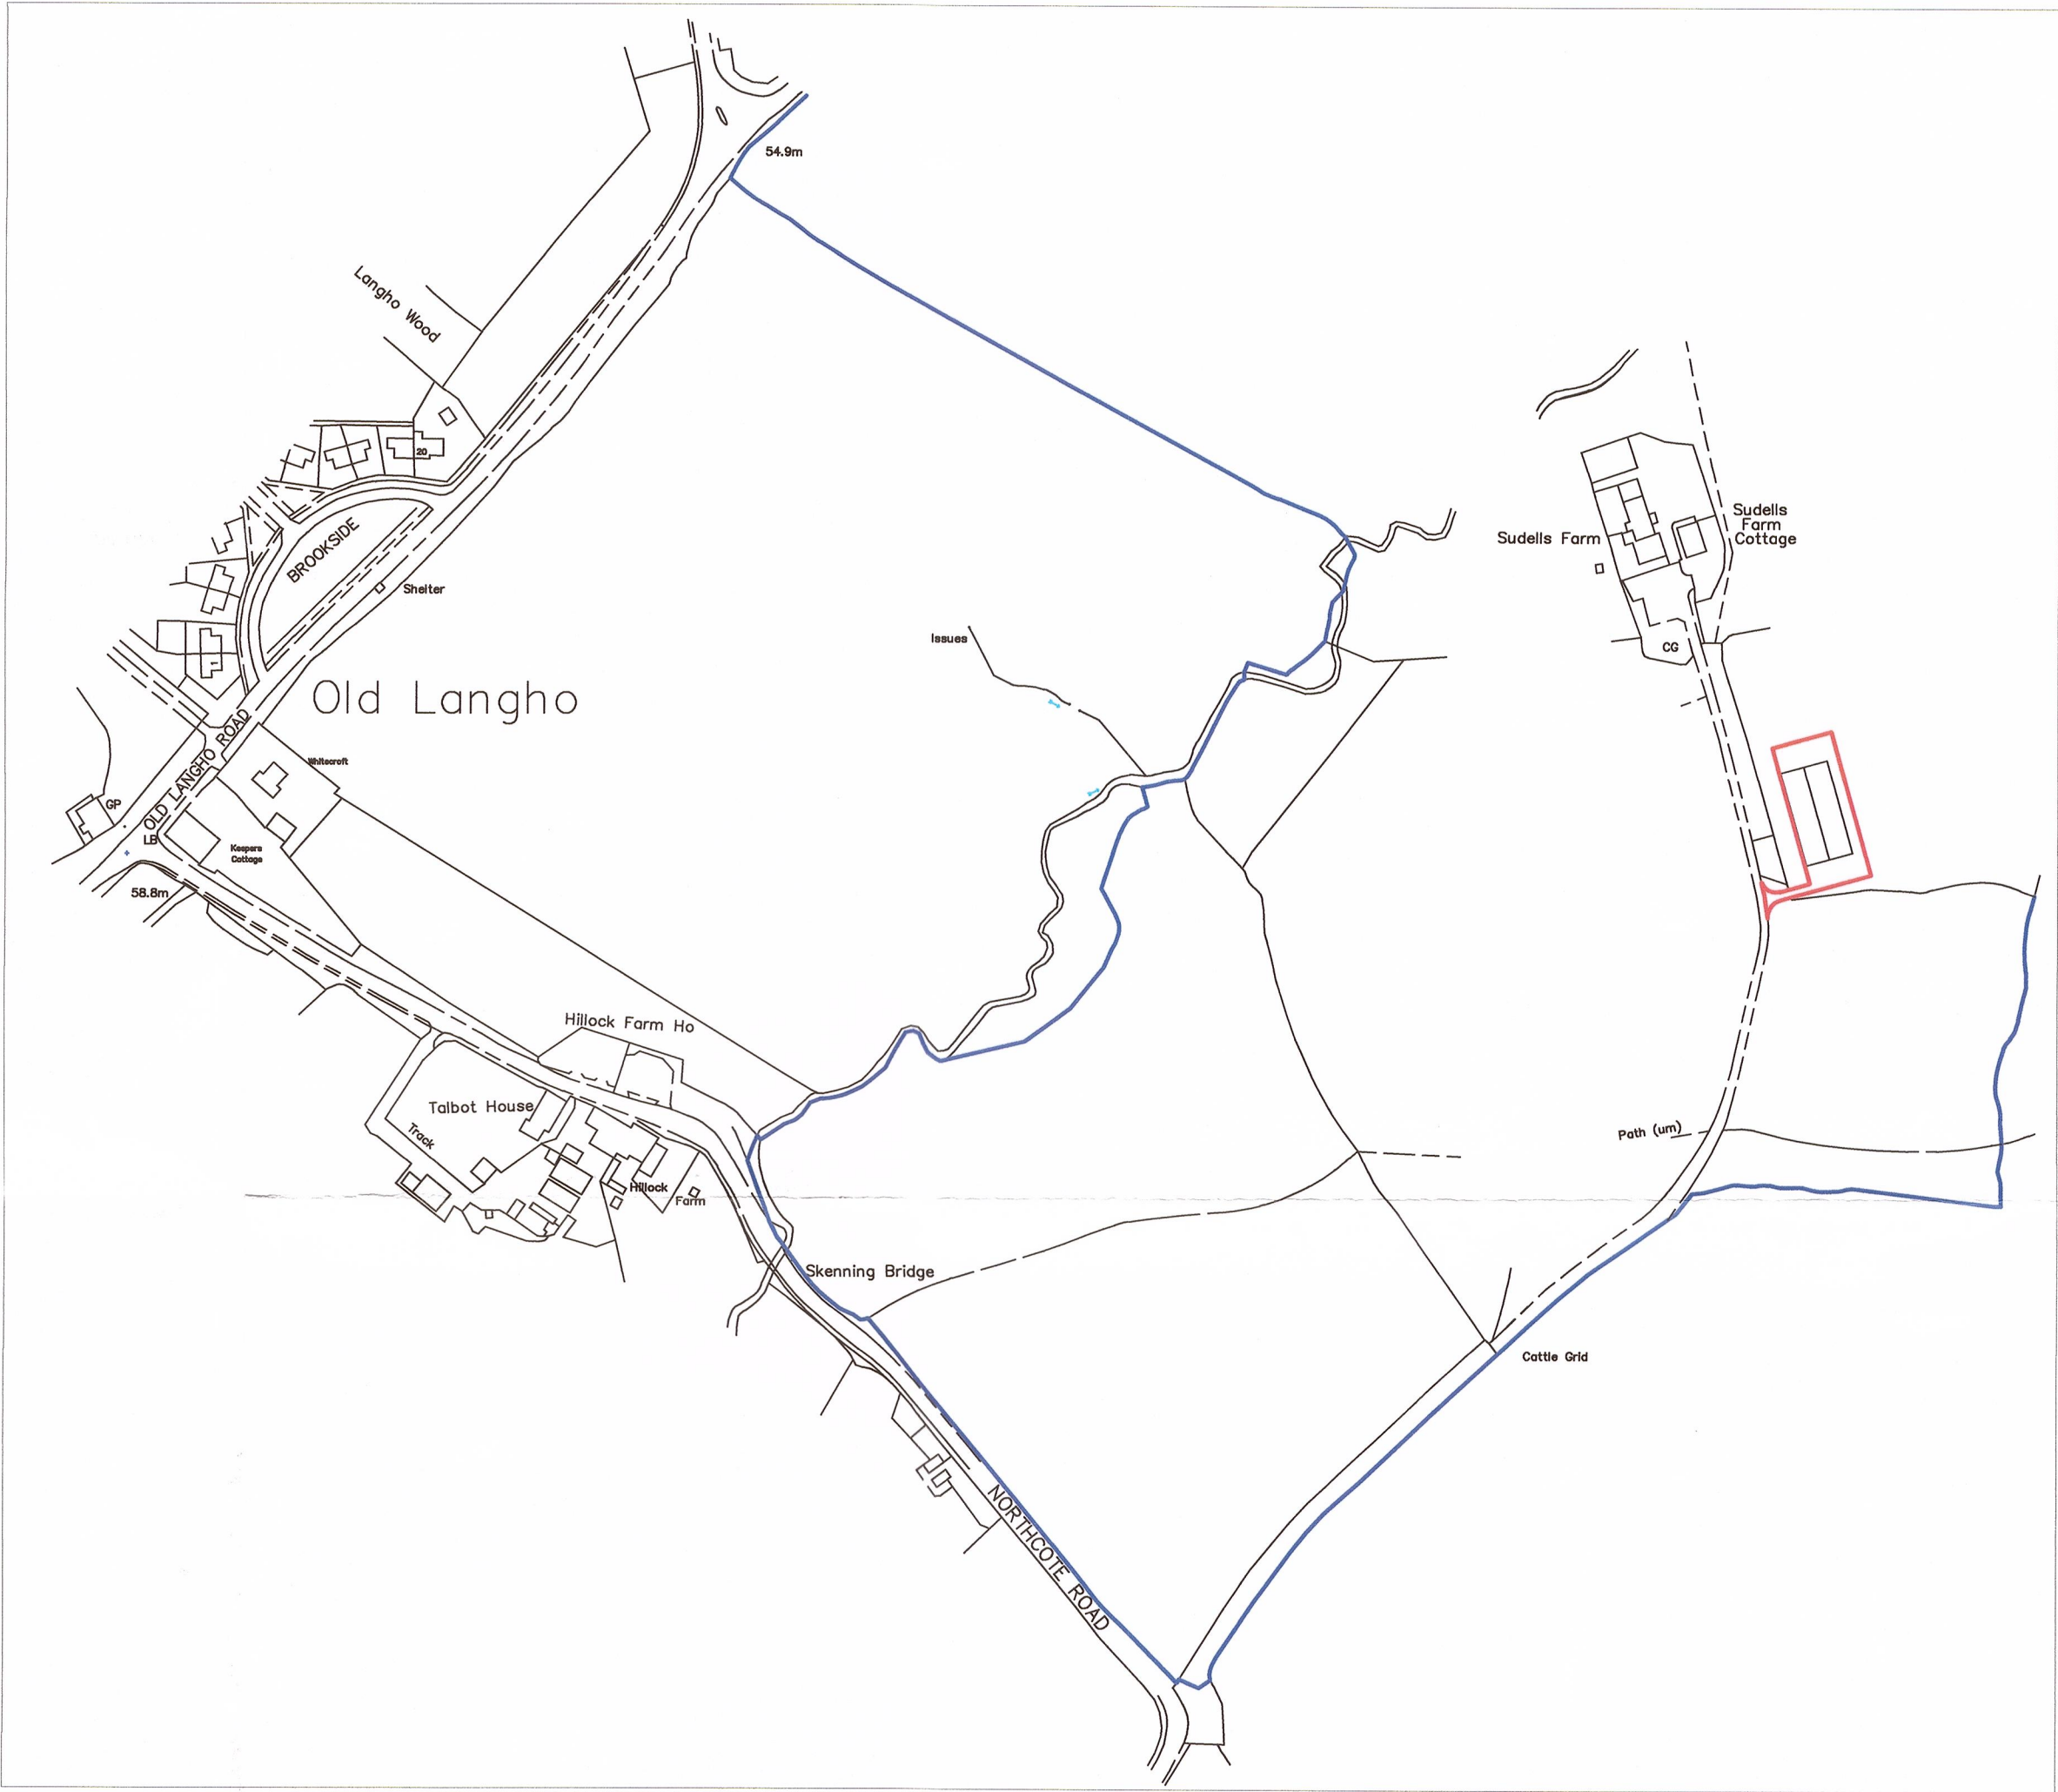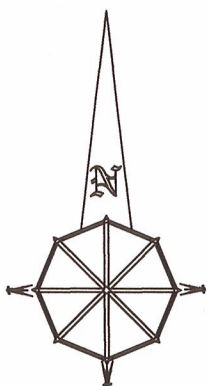

Location Plan - 1:2500

320180821



Notes:
All work is to be carried out to the latest current British standards Codes of Practice and recognised working practices.
All work and materials should comply with Health and Safety legislation.
All dimensions are in millimetres where explicitly shown otherwise.
The contractor should check and certify all dimensions as work proceeds and notify the architect of any discrepancies.
Do not scale off the drawings, if in doubt ask.

Amendment A - 21.09.2018: Building position and access amended

 Gary Hoerty Associates Chartered Surveyors Suite 9 - Grindleton Business Centre The Spinney Grindleton Clitheroe Lancashire BB7 4DH T: 01200 449700 Email: info@ghaonline.co.uk	Project: (No: Win.836.2518)		Title: Site Plan and Location Plan	
	Planning - application for the erection of an agricultural livestock building and associated yard area at		Drawing No: Win/836/2518/01	Drawn: PF
	Sudells Farm, Northcote Road, Langho, BB6 8BD		Client: Mr A Winterbottom	
			Date: 13.09.2018	Scale: 1:500 & 1:1250 @ A2
			Amendments:	A