

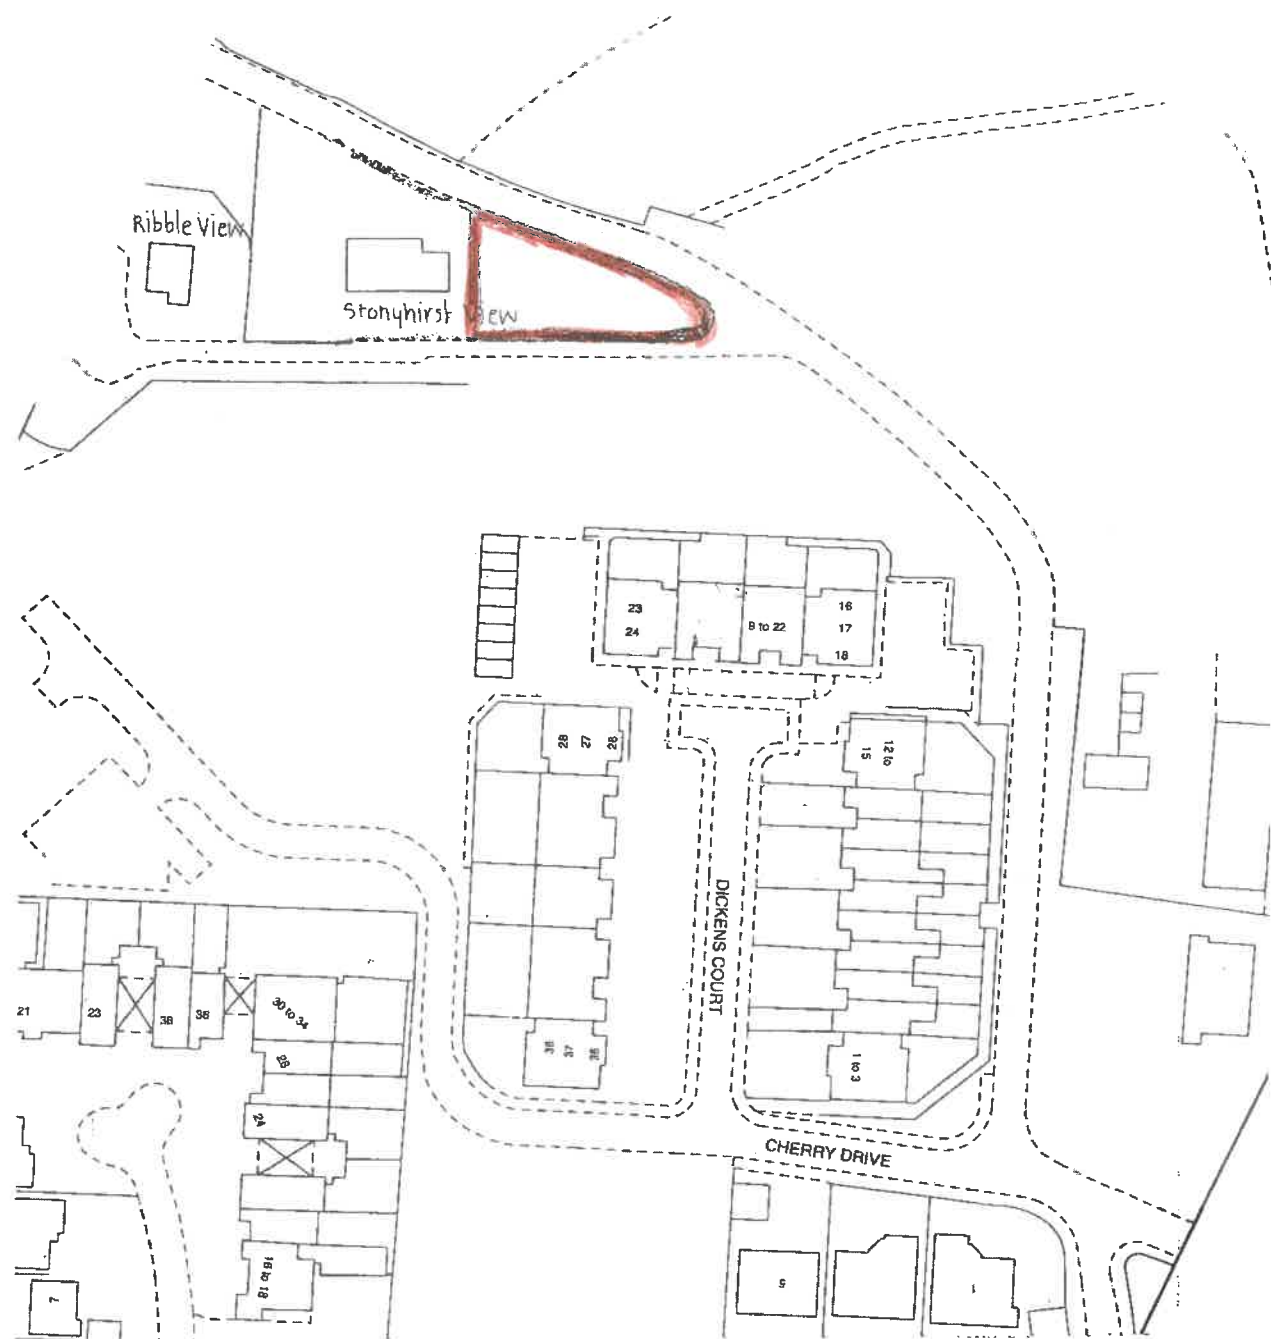


31202010508  
~~320150793P~~

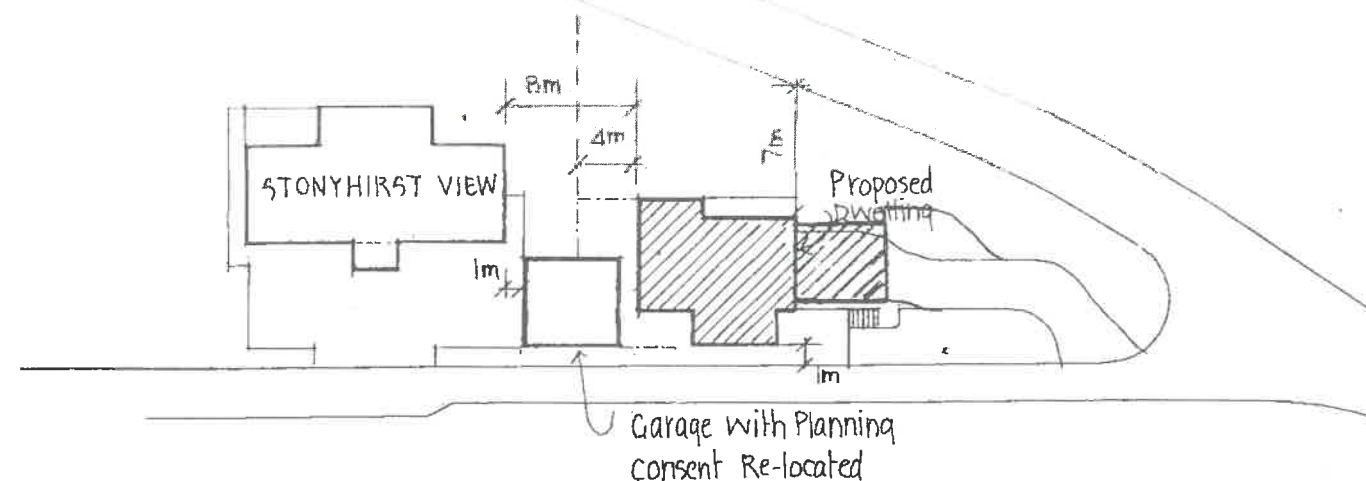


LOCATION PLAN SCALE 1:1250

0 10 20 30 40 50 60m

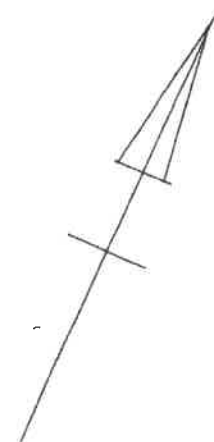

SITE PLAN SCALE 1:500

0 5 10 20 30m

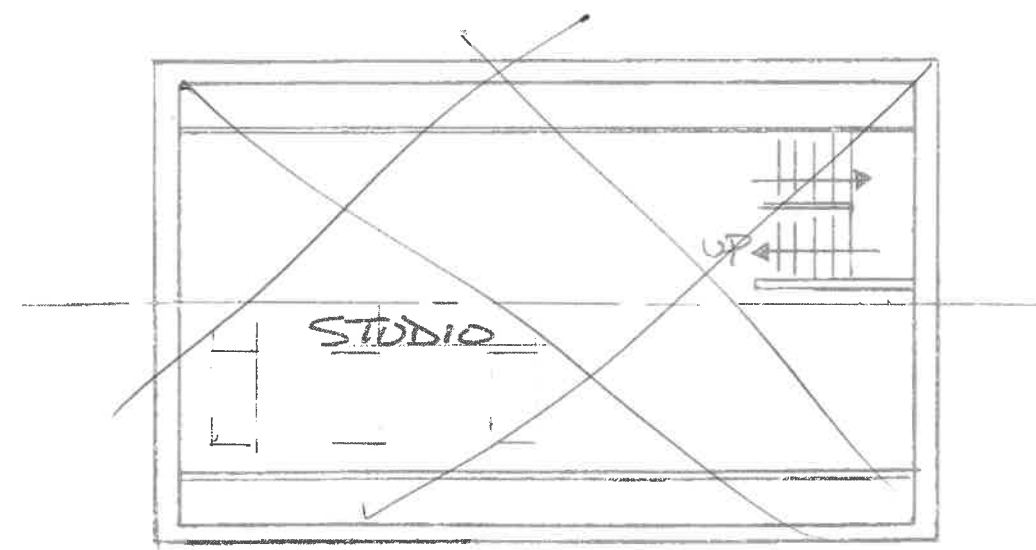

ARCH PLAN

~~PROPOSED DWELLING ADJACENT TO~~  
~~STONYHIRST VIEW BRECKVILL VILLAGE~~  
~~PREVIOUS APPLICATION 3/2012/1107~~

~~Post 22 2/1/15~~

