





Front Elevation (West)
1:50 Scale



Side 1 Elevation (South)
1:50 Scale

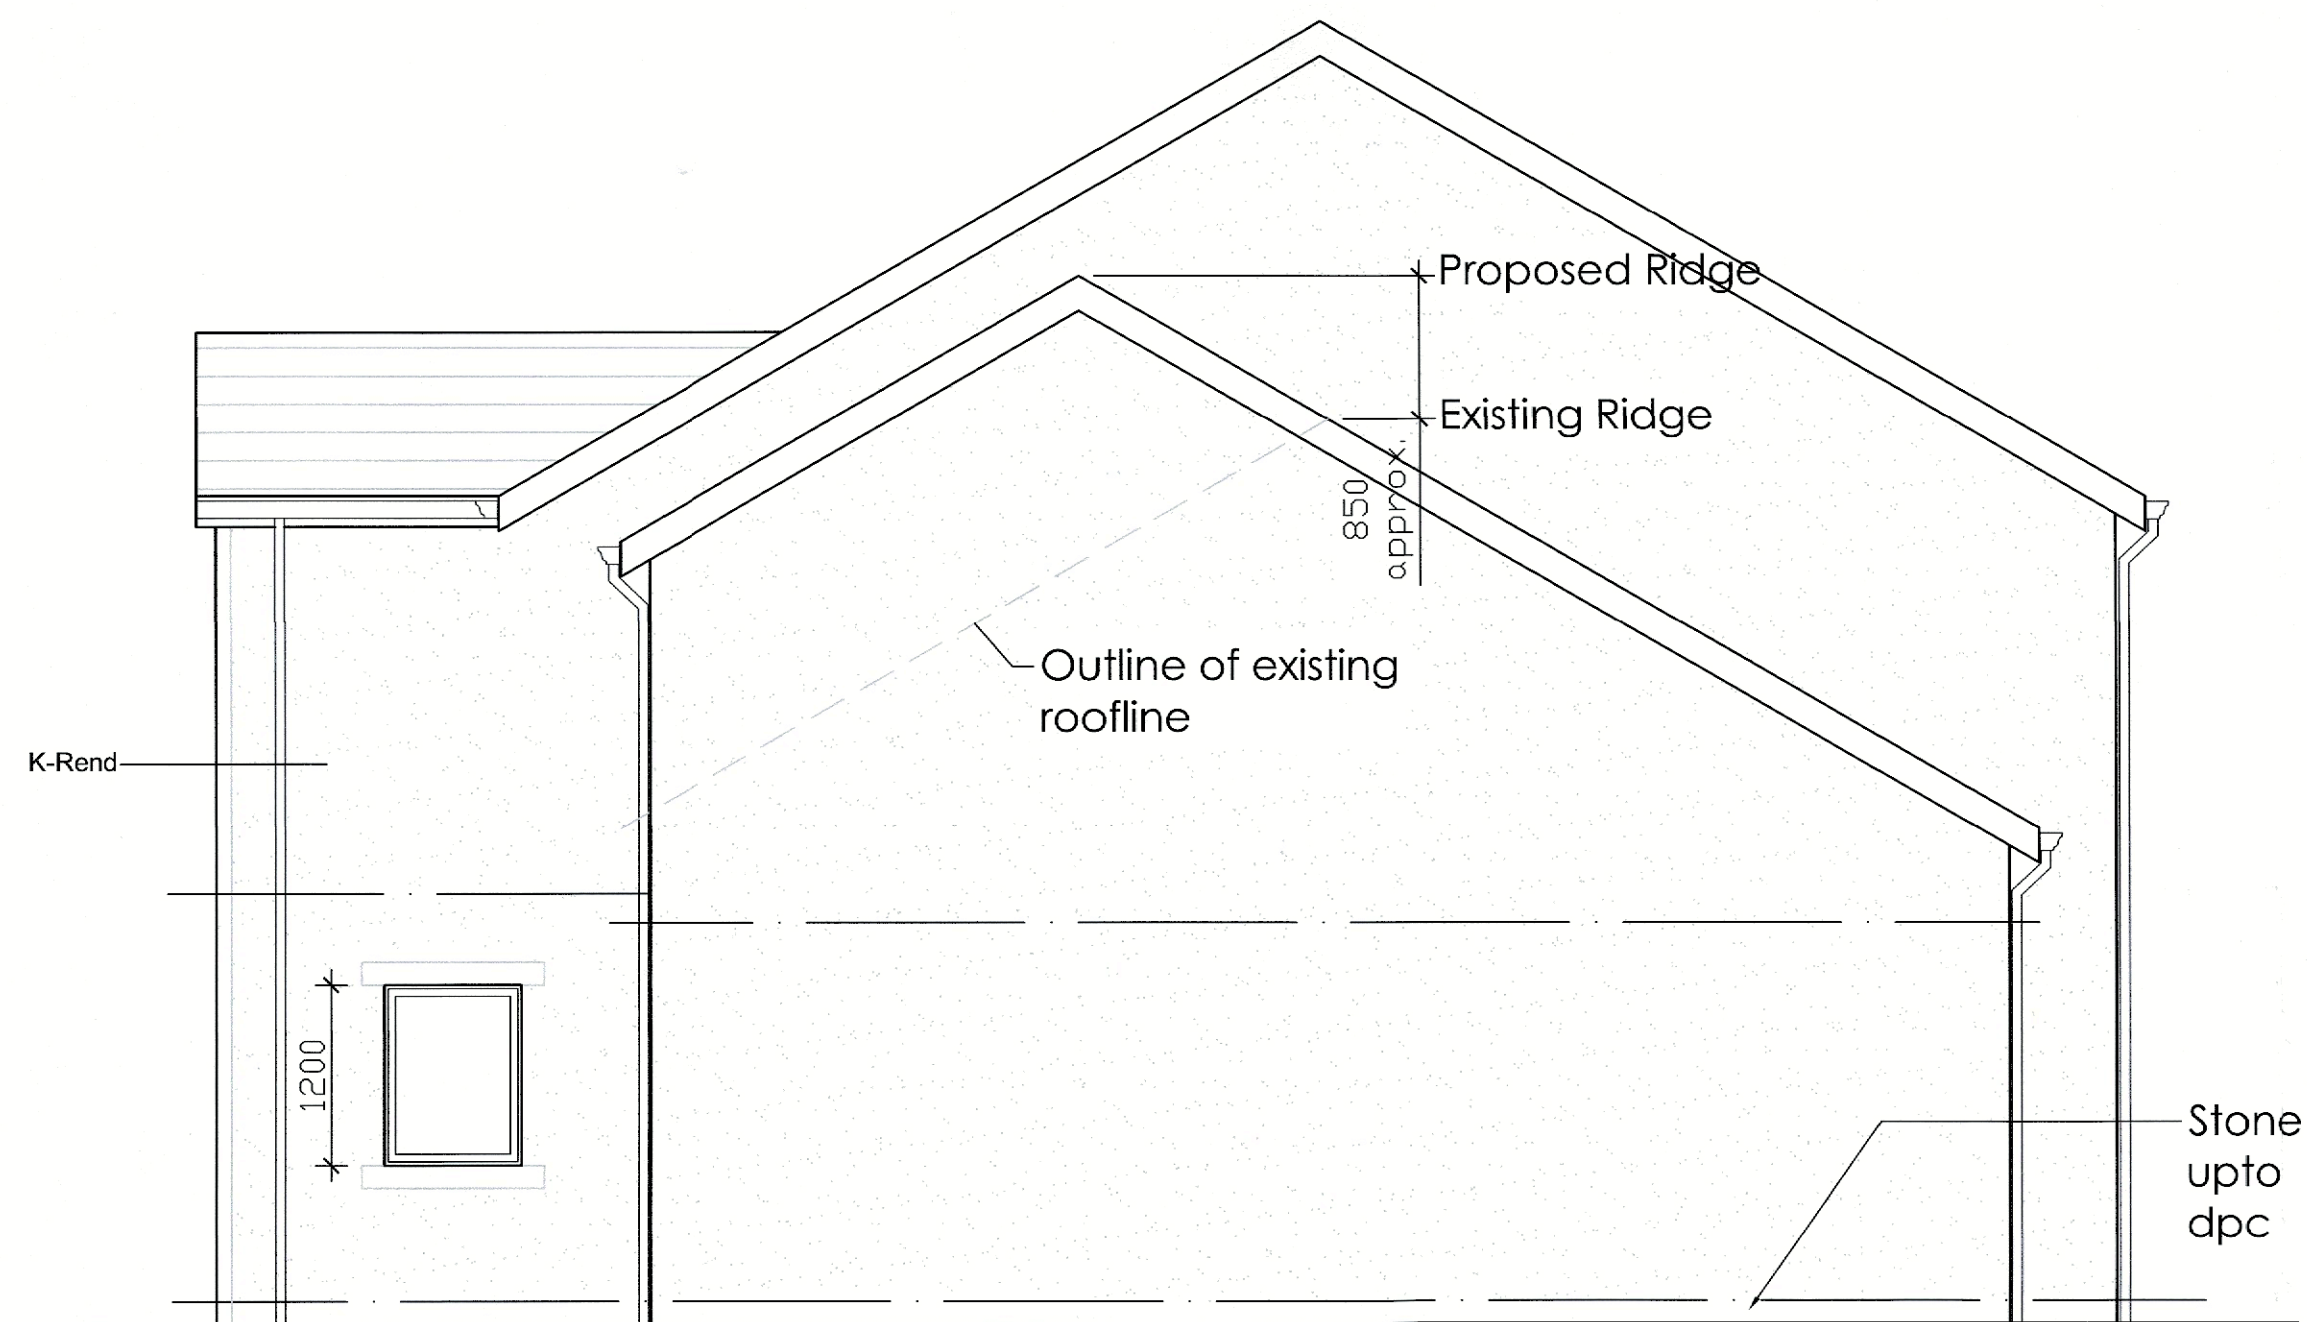

Rear Elevation (East)
1:50 Scale

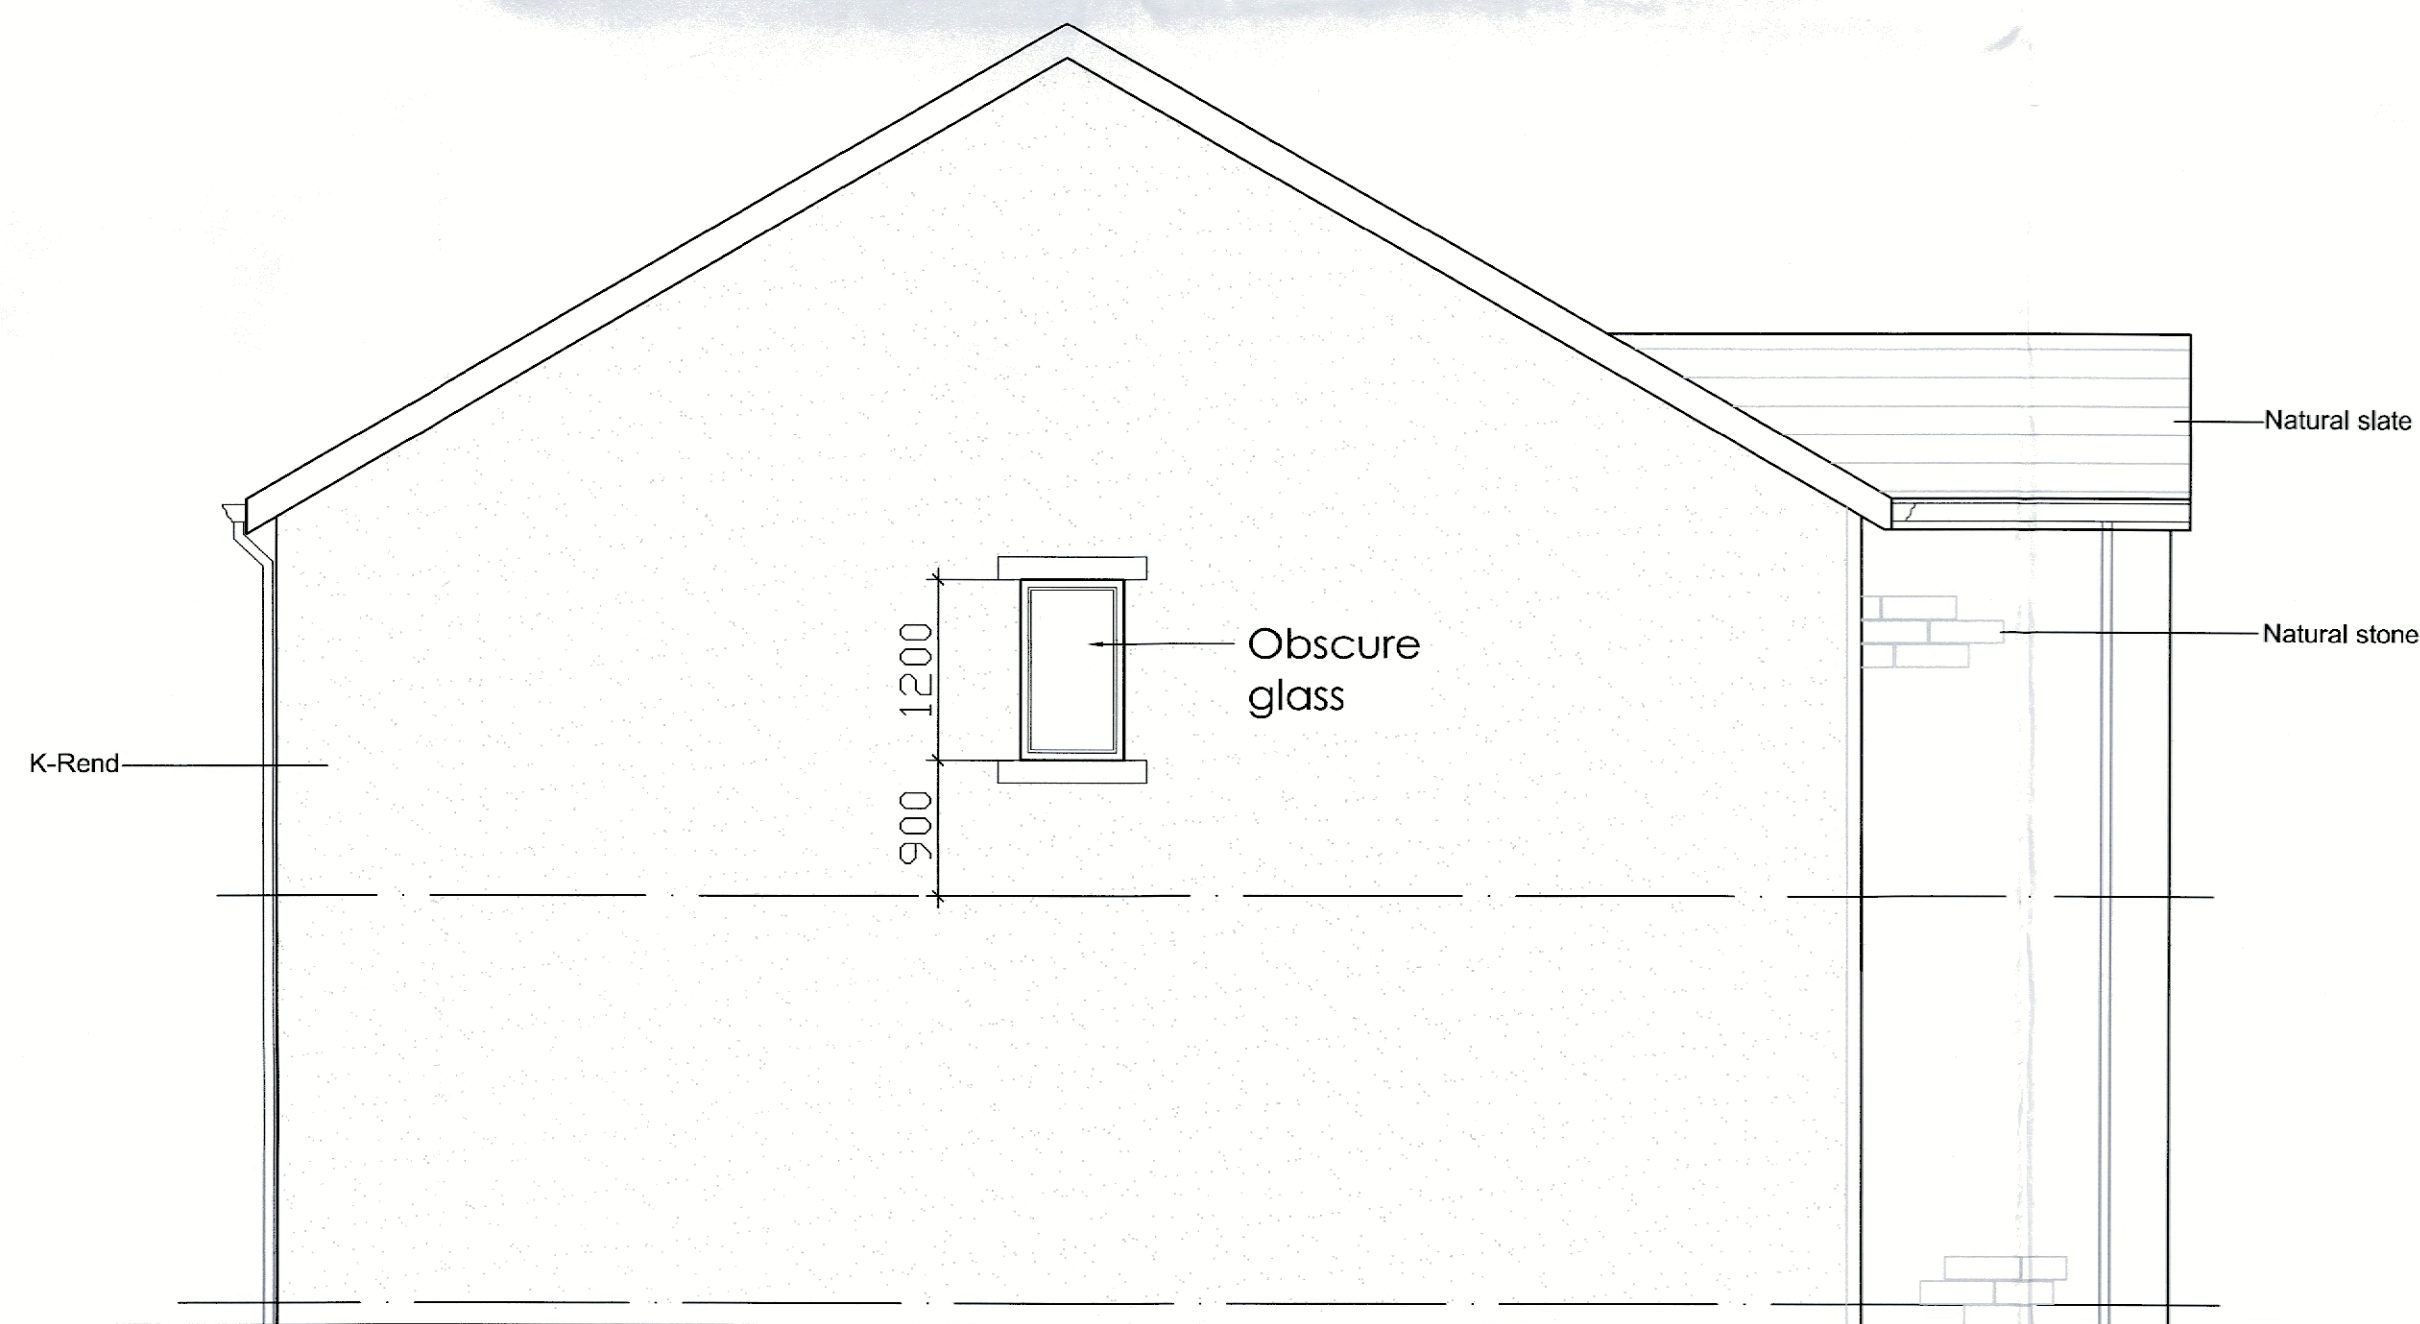

Side 2 Elevation (North)
1:50 Scale



Natural slate

Rev F: First Floor extension proposed over garage - Variation of condition application. 14.05.2021
Rev E: First floor extension omit from over garage, materials changed to stone to front elevation with K-rend to sides and rear. 13.05.2021
Rev C: Client alterations as per marked up sketches. 18.03.2021

Client
MFH Projects (Harrison)

Job Title
Proposed Dwellings
Land at Victoria Terrace
Mellor Brook

Drawing Title
Proposed Elevations
Unit 3

Scale
1:50 @ A1

Date
Dec 2019

Drawn
Craig Harrison

spa
ARCHITECTS

SUNDERLAND PEACOCK & ASSOCIATES LTD.
HAZEL WERE, PIMLICO ROAD, CLITHEROE
LANCASHIRE, BB7 2AG
01200 423176 01200 427328
info@sunderlandpeacock.com

5766 - T06F