

**\*REFER TO ARBORICULTURAL IMPACT ASSESSMENT & PLANS FOR MORE INFORMATION\***

Peter Hitchen  
Architects

Marathon House  
The Sidings Business Park  
Whalley, BB7 9SE

01254 823 885

www.peterhitchenarchitects.co.uk

NOTES:  
Revision : Change to position & orientation of reception building in line with United Utility mains record drawing which shows the indicative route of the 6" AC (Asbestos Cement) pipe running through the proposed development. The easement is 6m, 3m either side of the centerline.

No.	Description	Date

CLIENT:  
**Mr Woodcock**

PROJECT:  
Proposed dog training facility ,  
Land off Slaidburn Road,  
Waddington

SHEET:  
**PROPOSED SITE PLAN  
w/ UU indicative pipe  
position**

Project number PHA/539

Date 25/03/2021


Drawn by JD

Checked by PH

**A101**

Scale 1 : 100

Sheet size A1

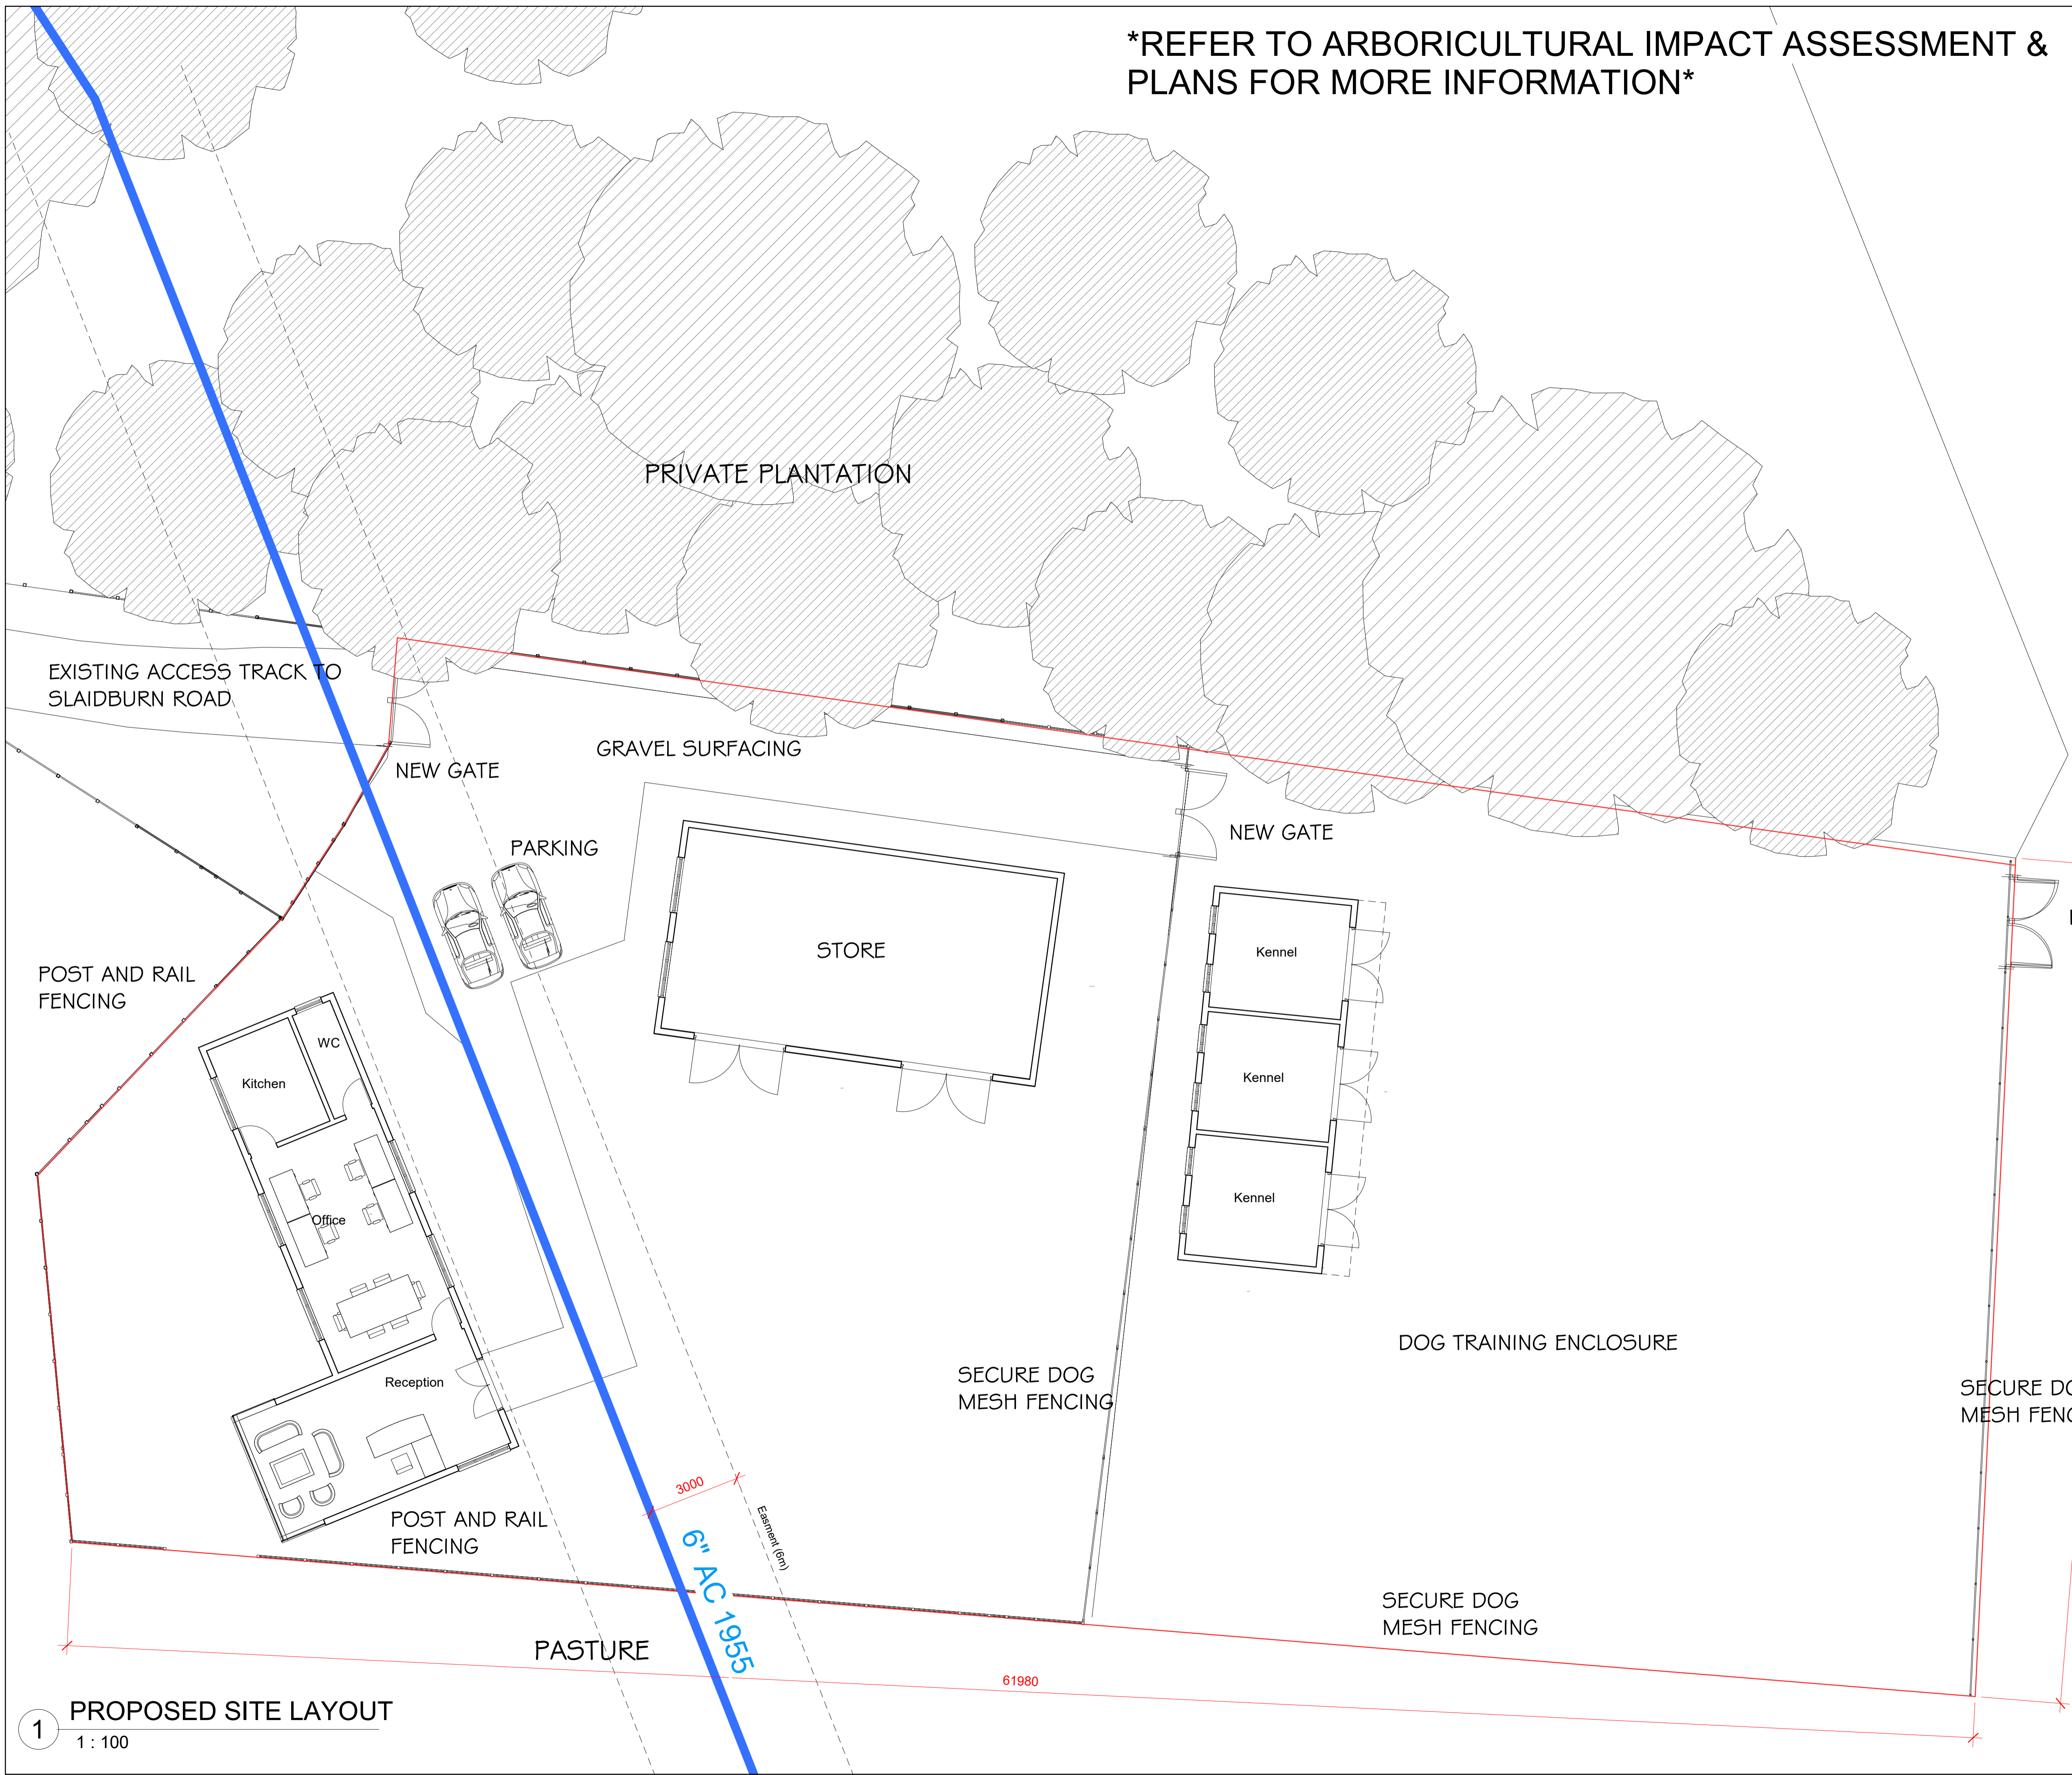

**1 PROPOSED SITE LAYOUT**  
1 : 100