




Side Elevation Existing

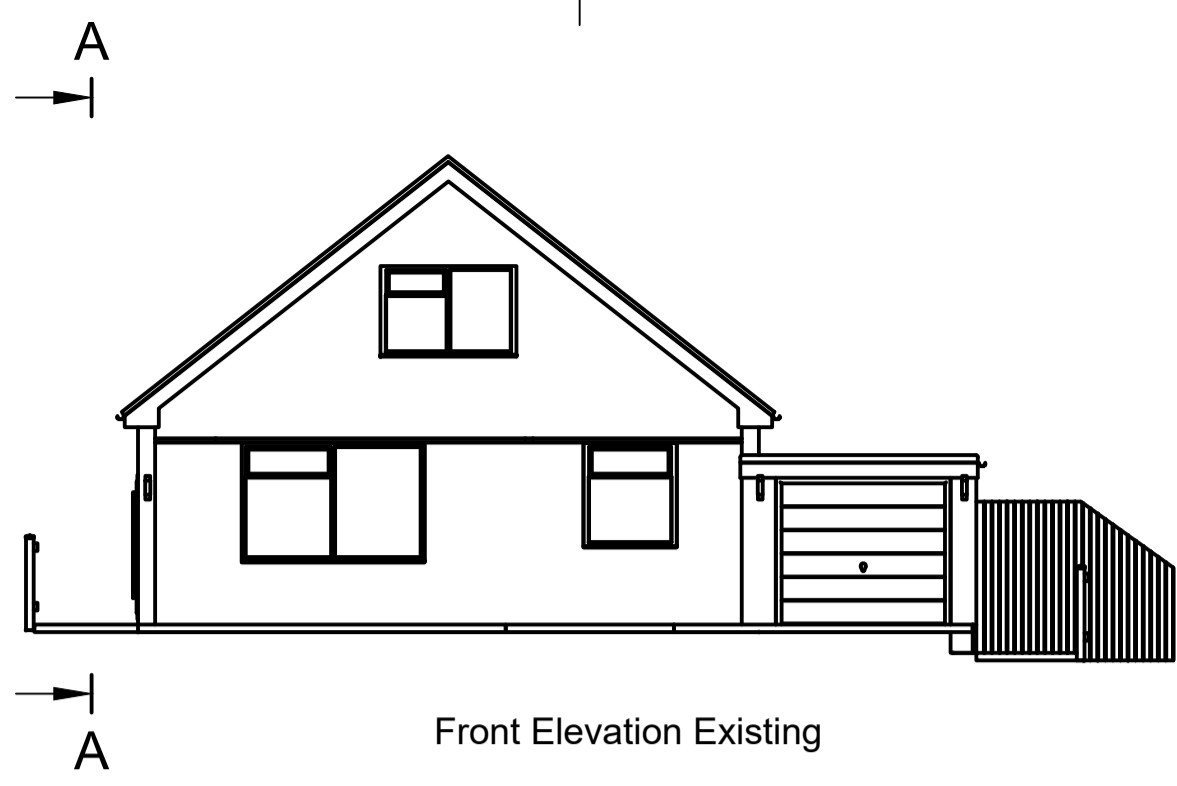


Front Elevation Existing

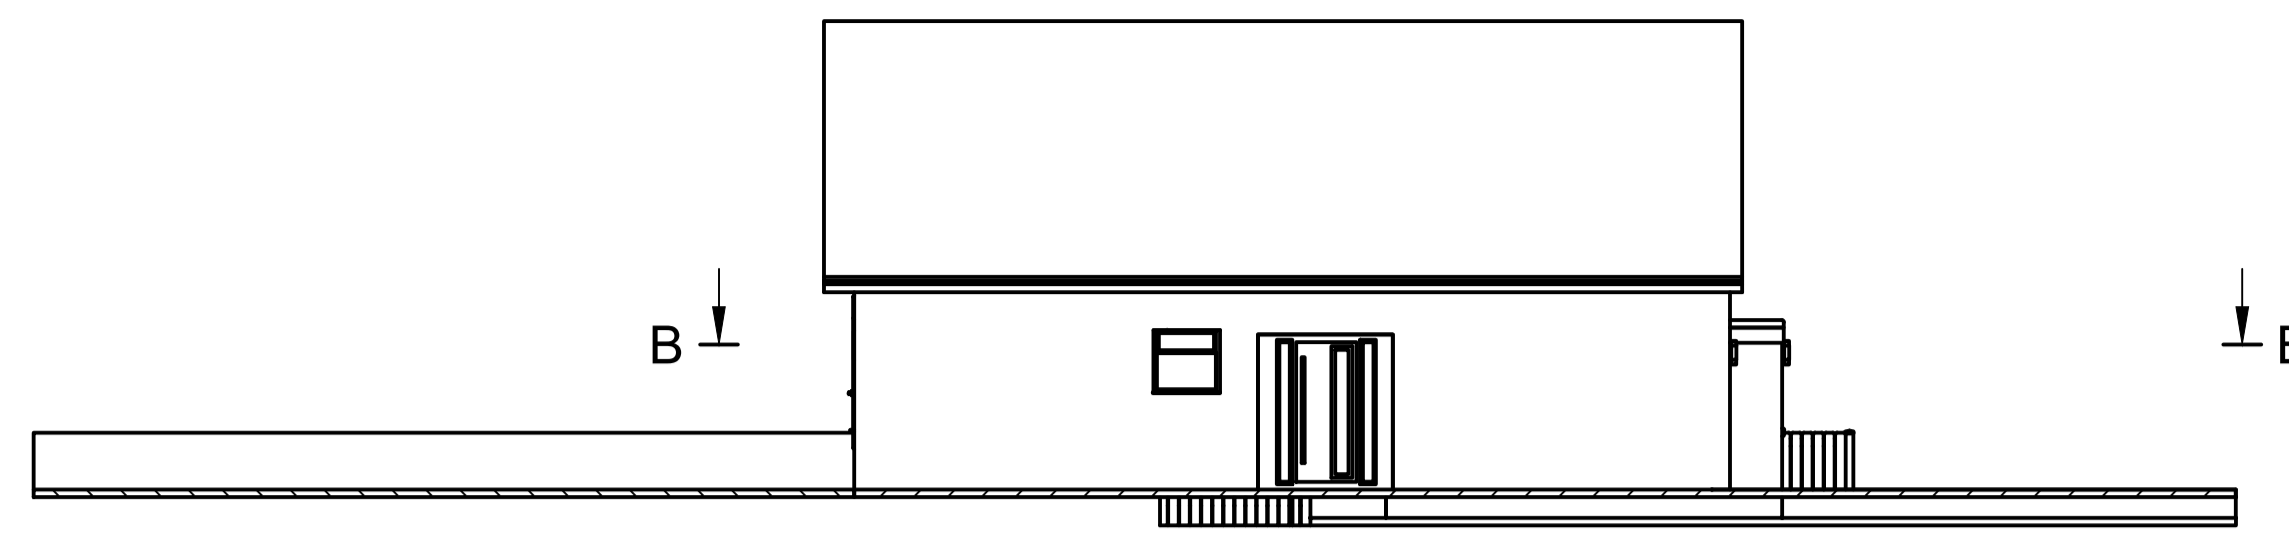



A-A (1:100)

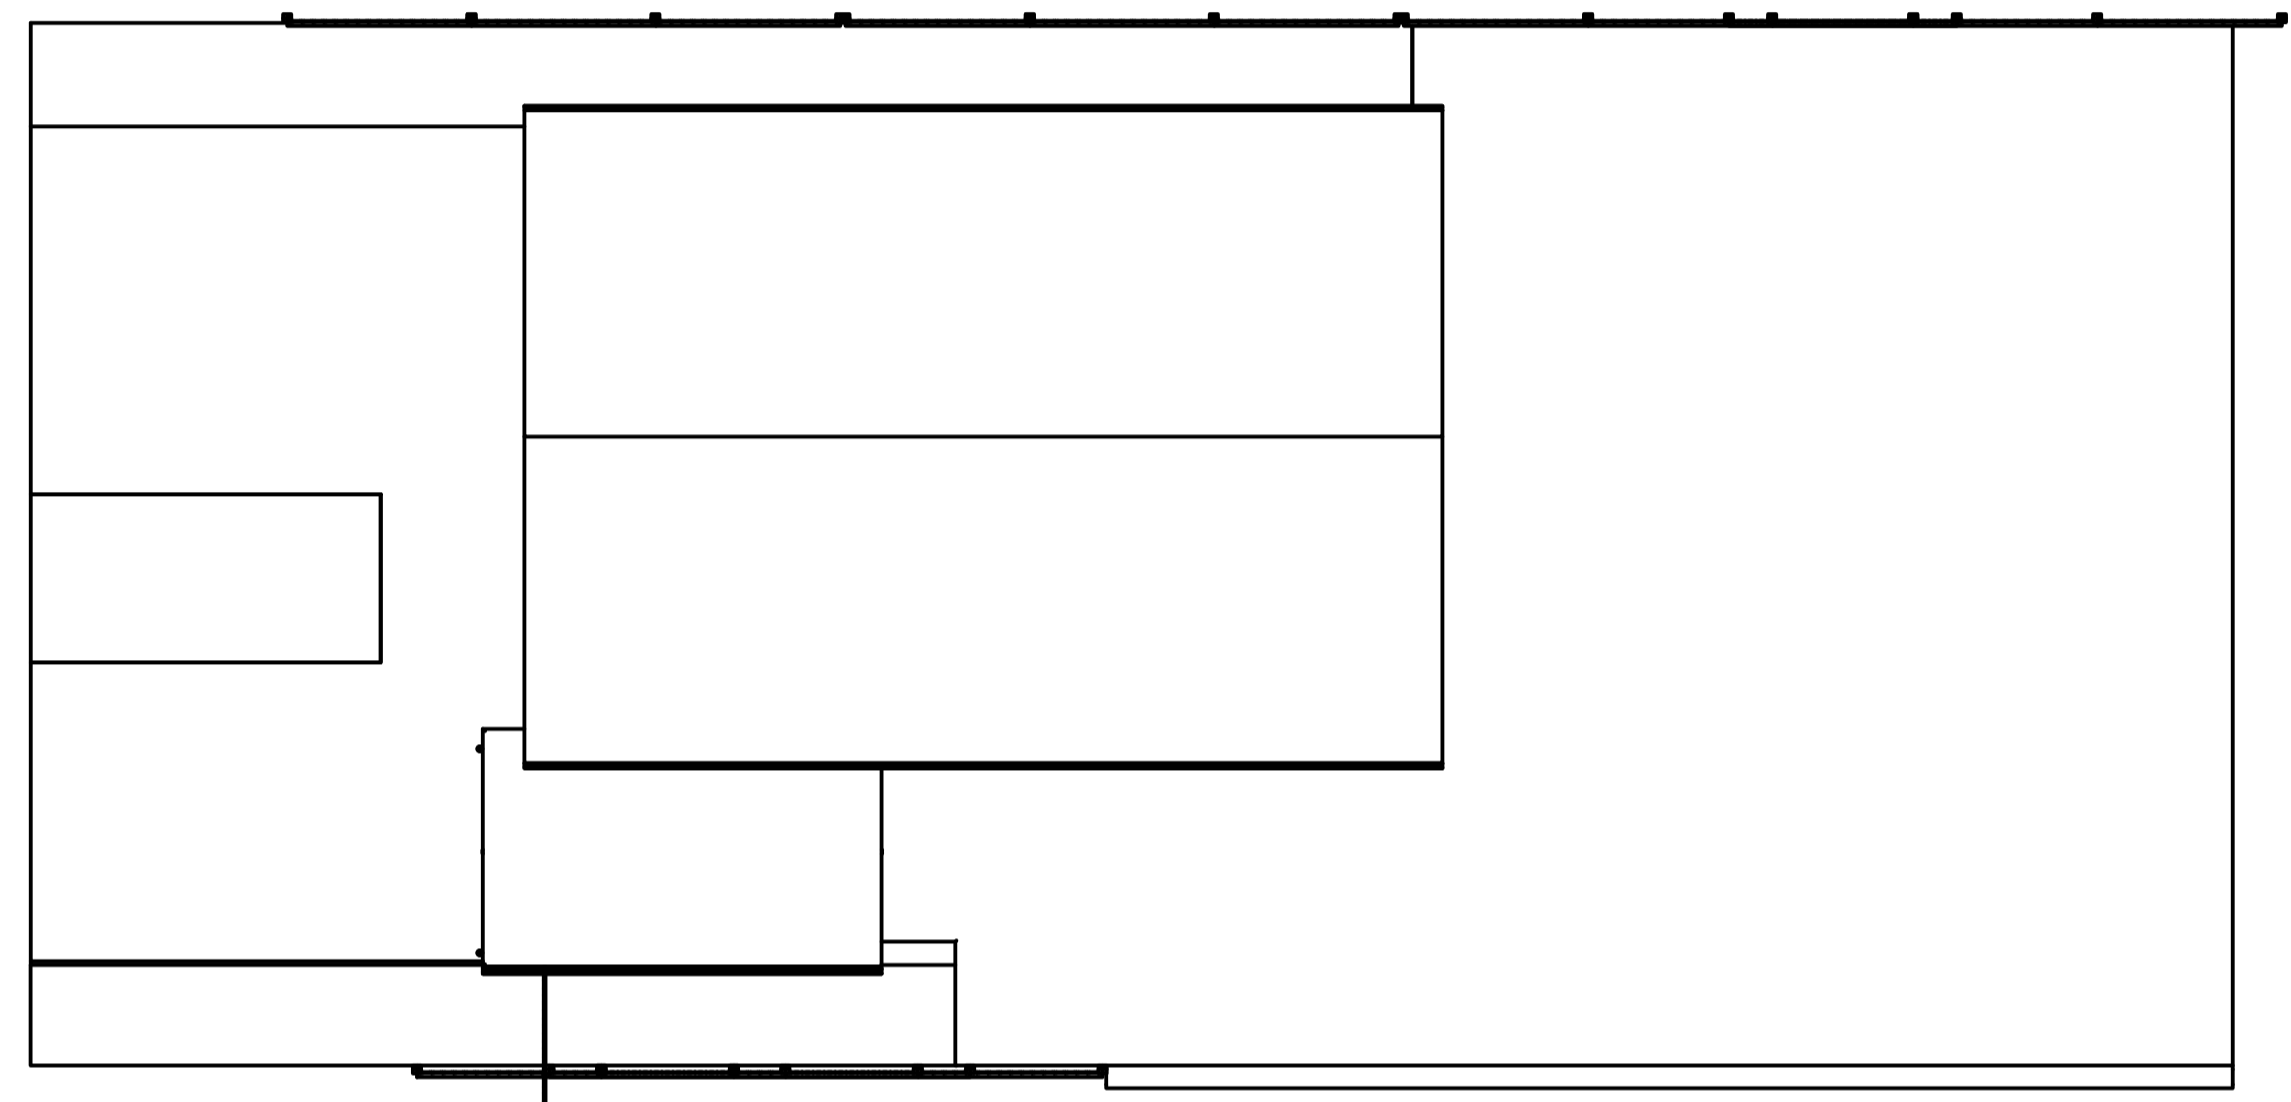

Plan View Existing

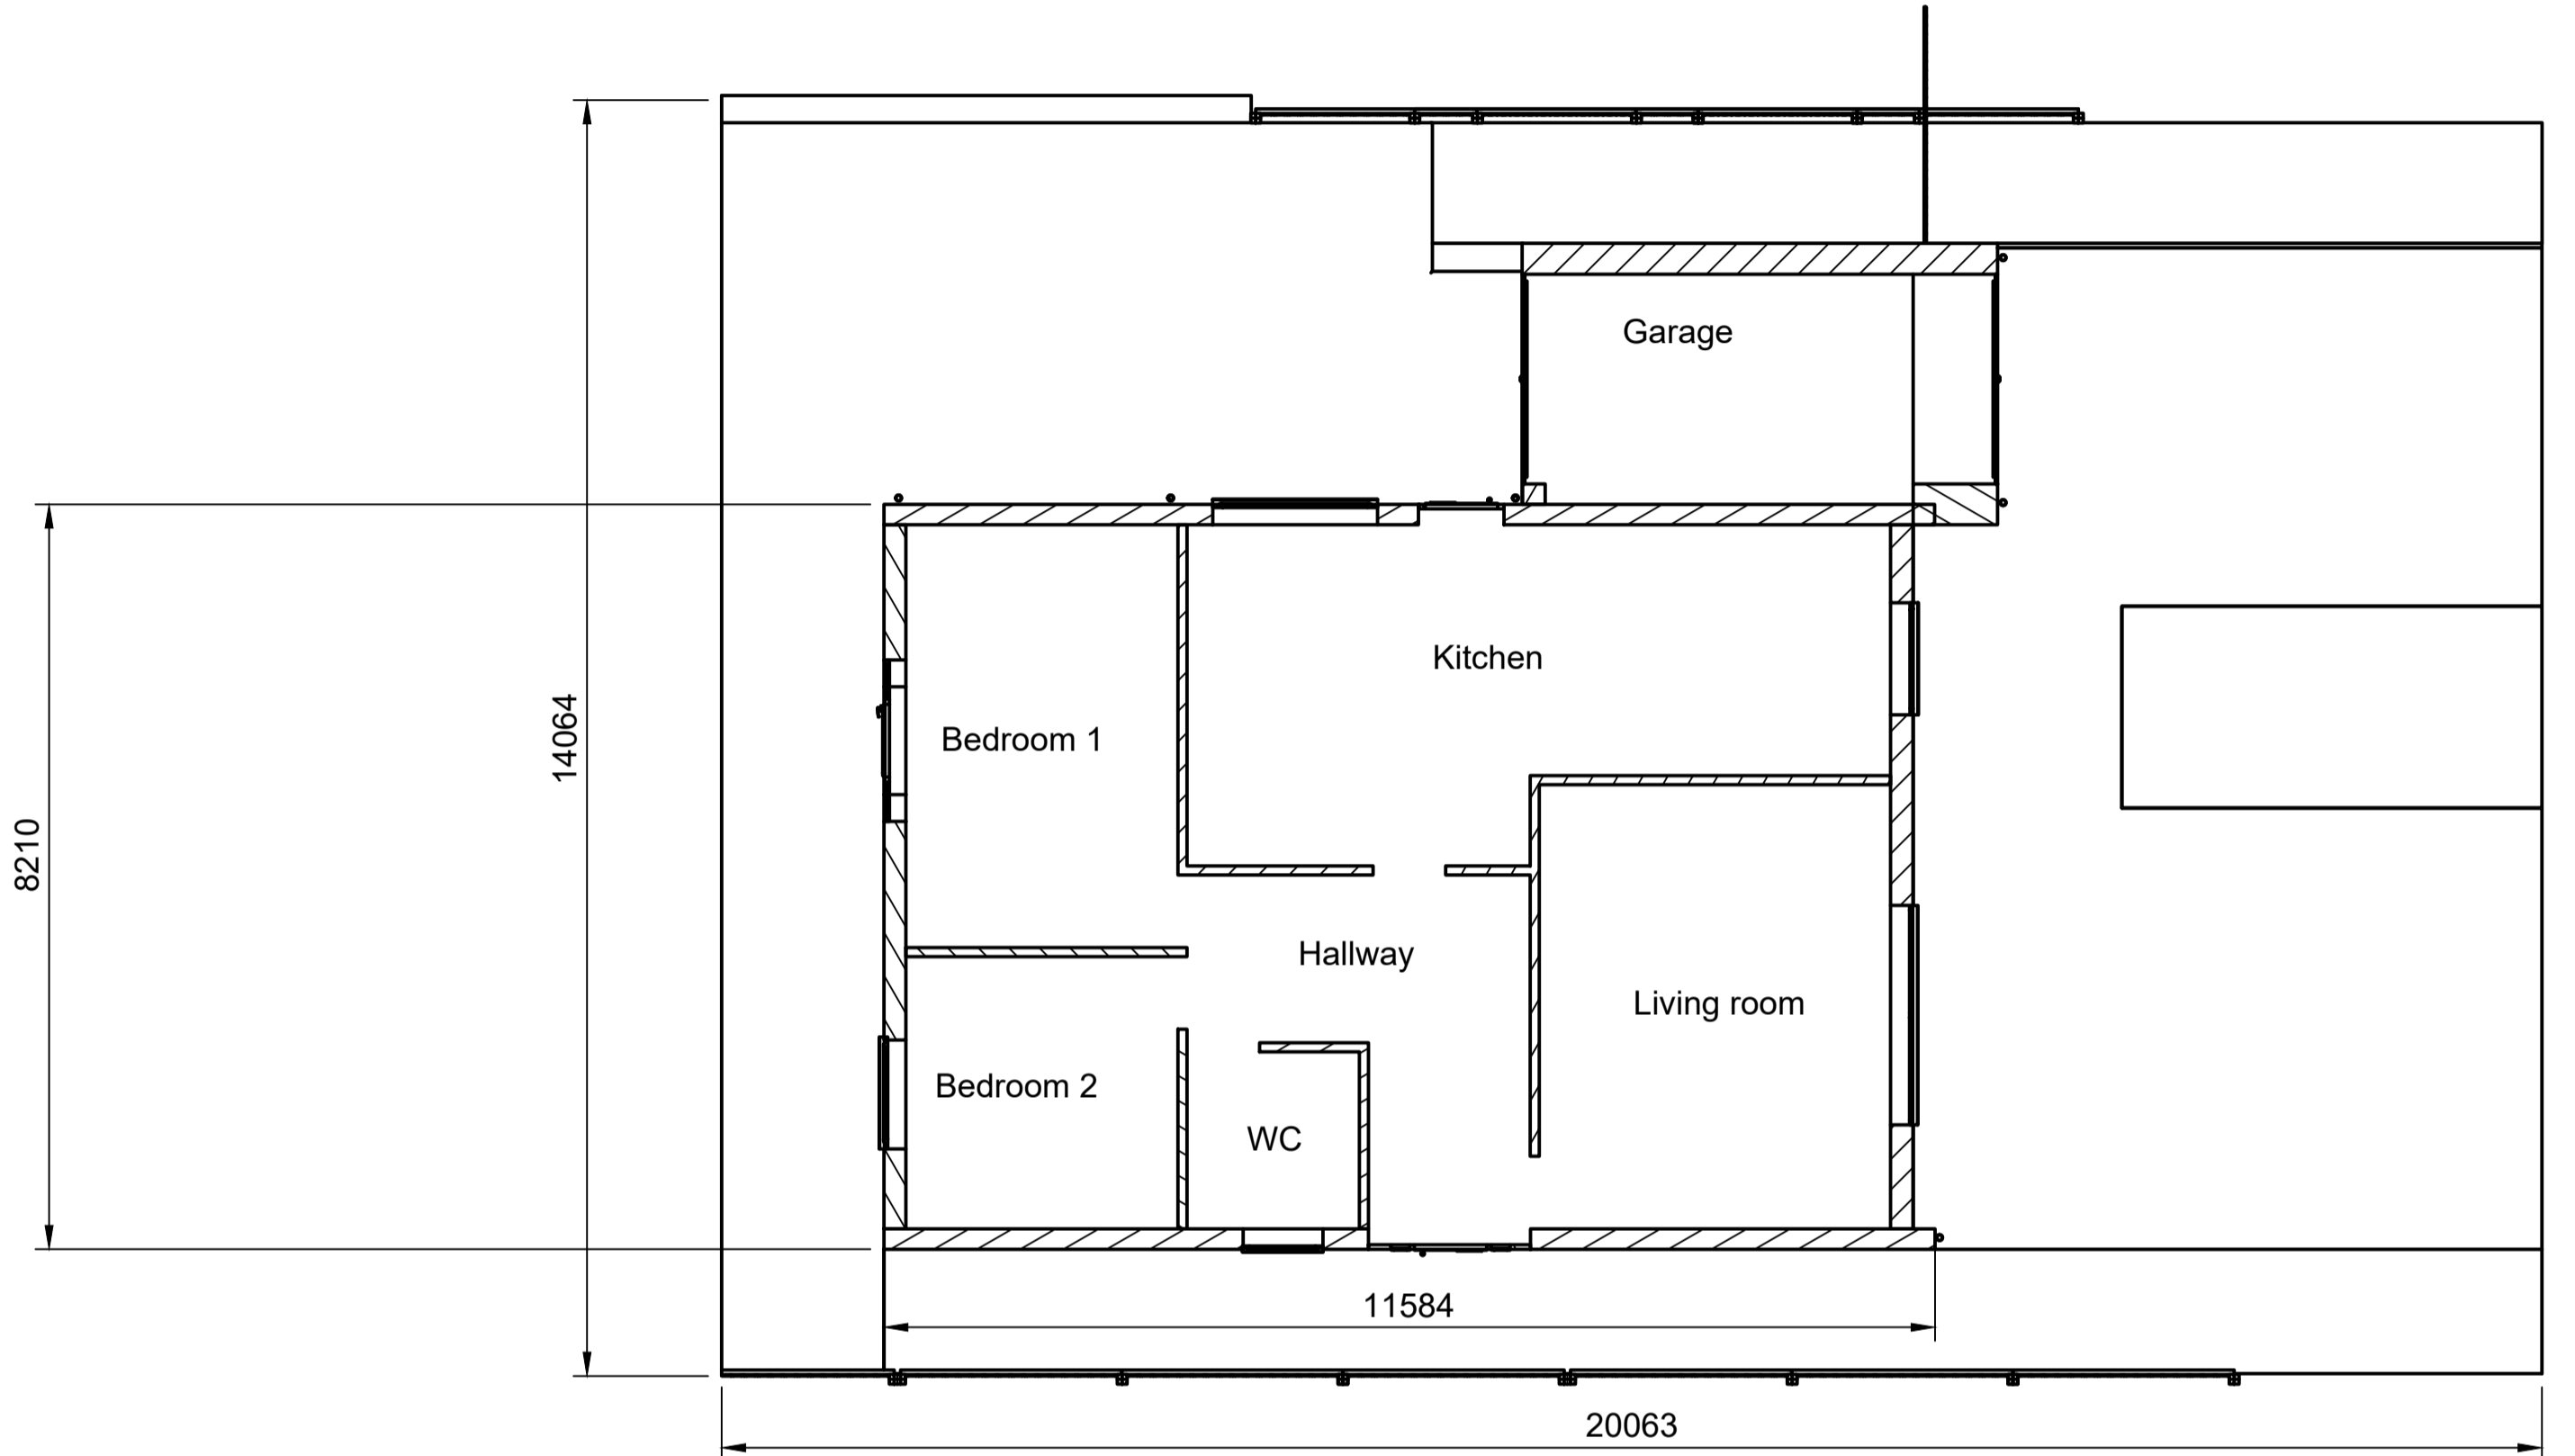

Ground floor plan
B-B (1:75)

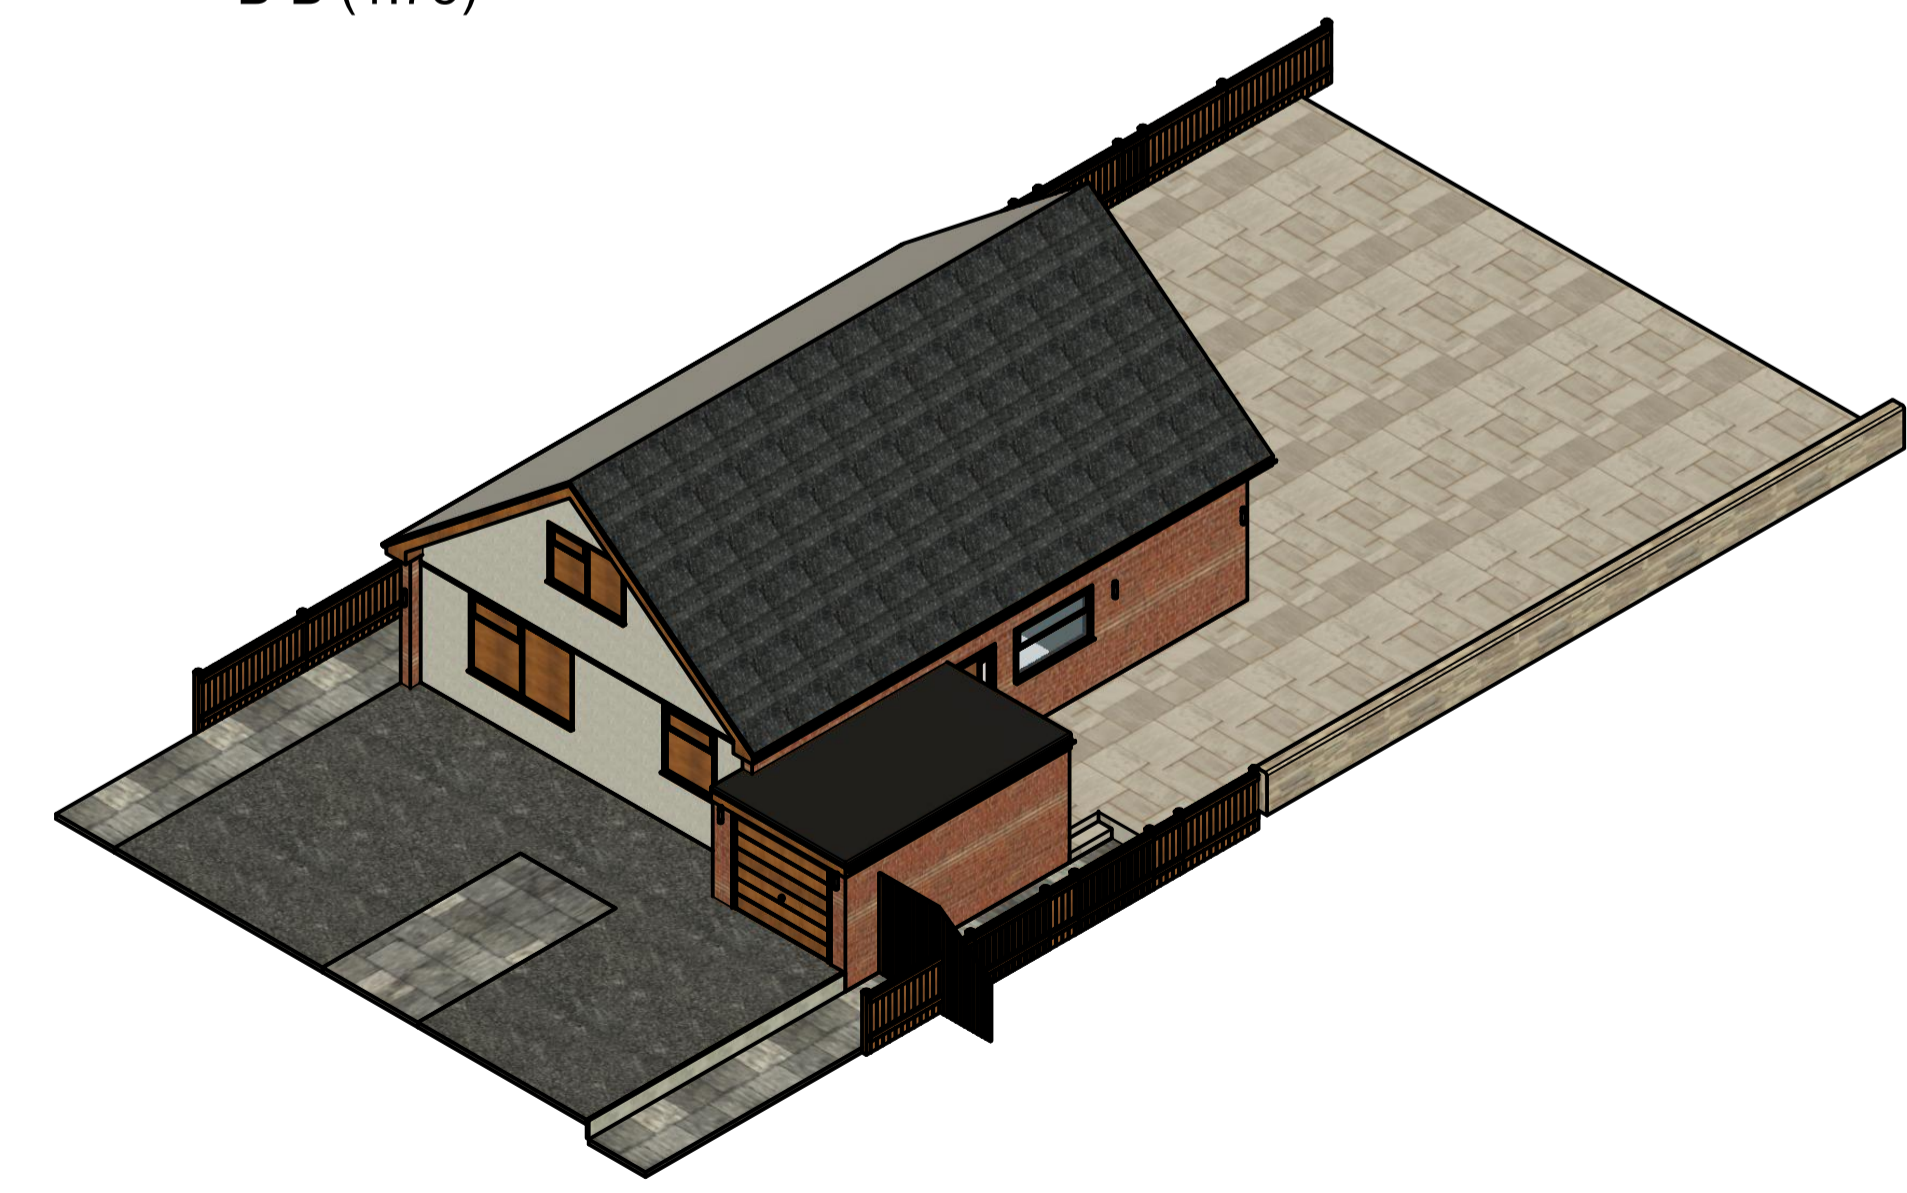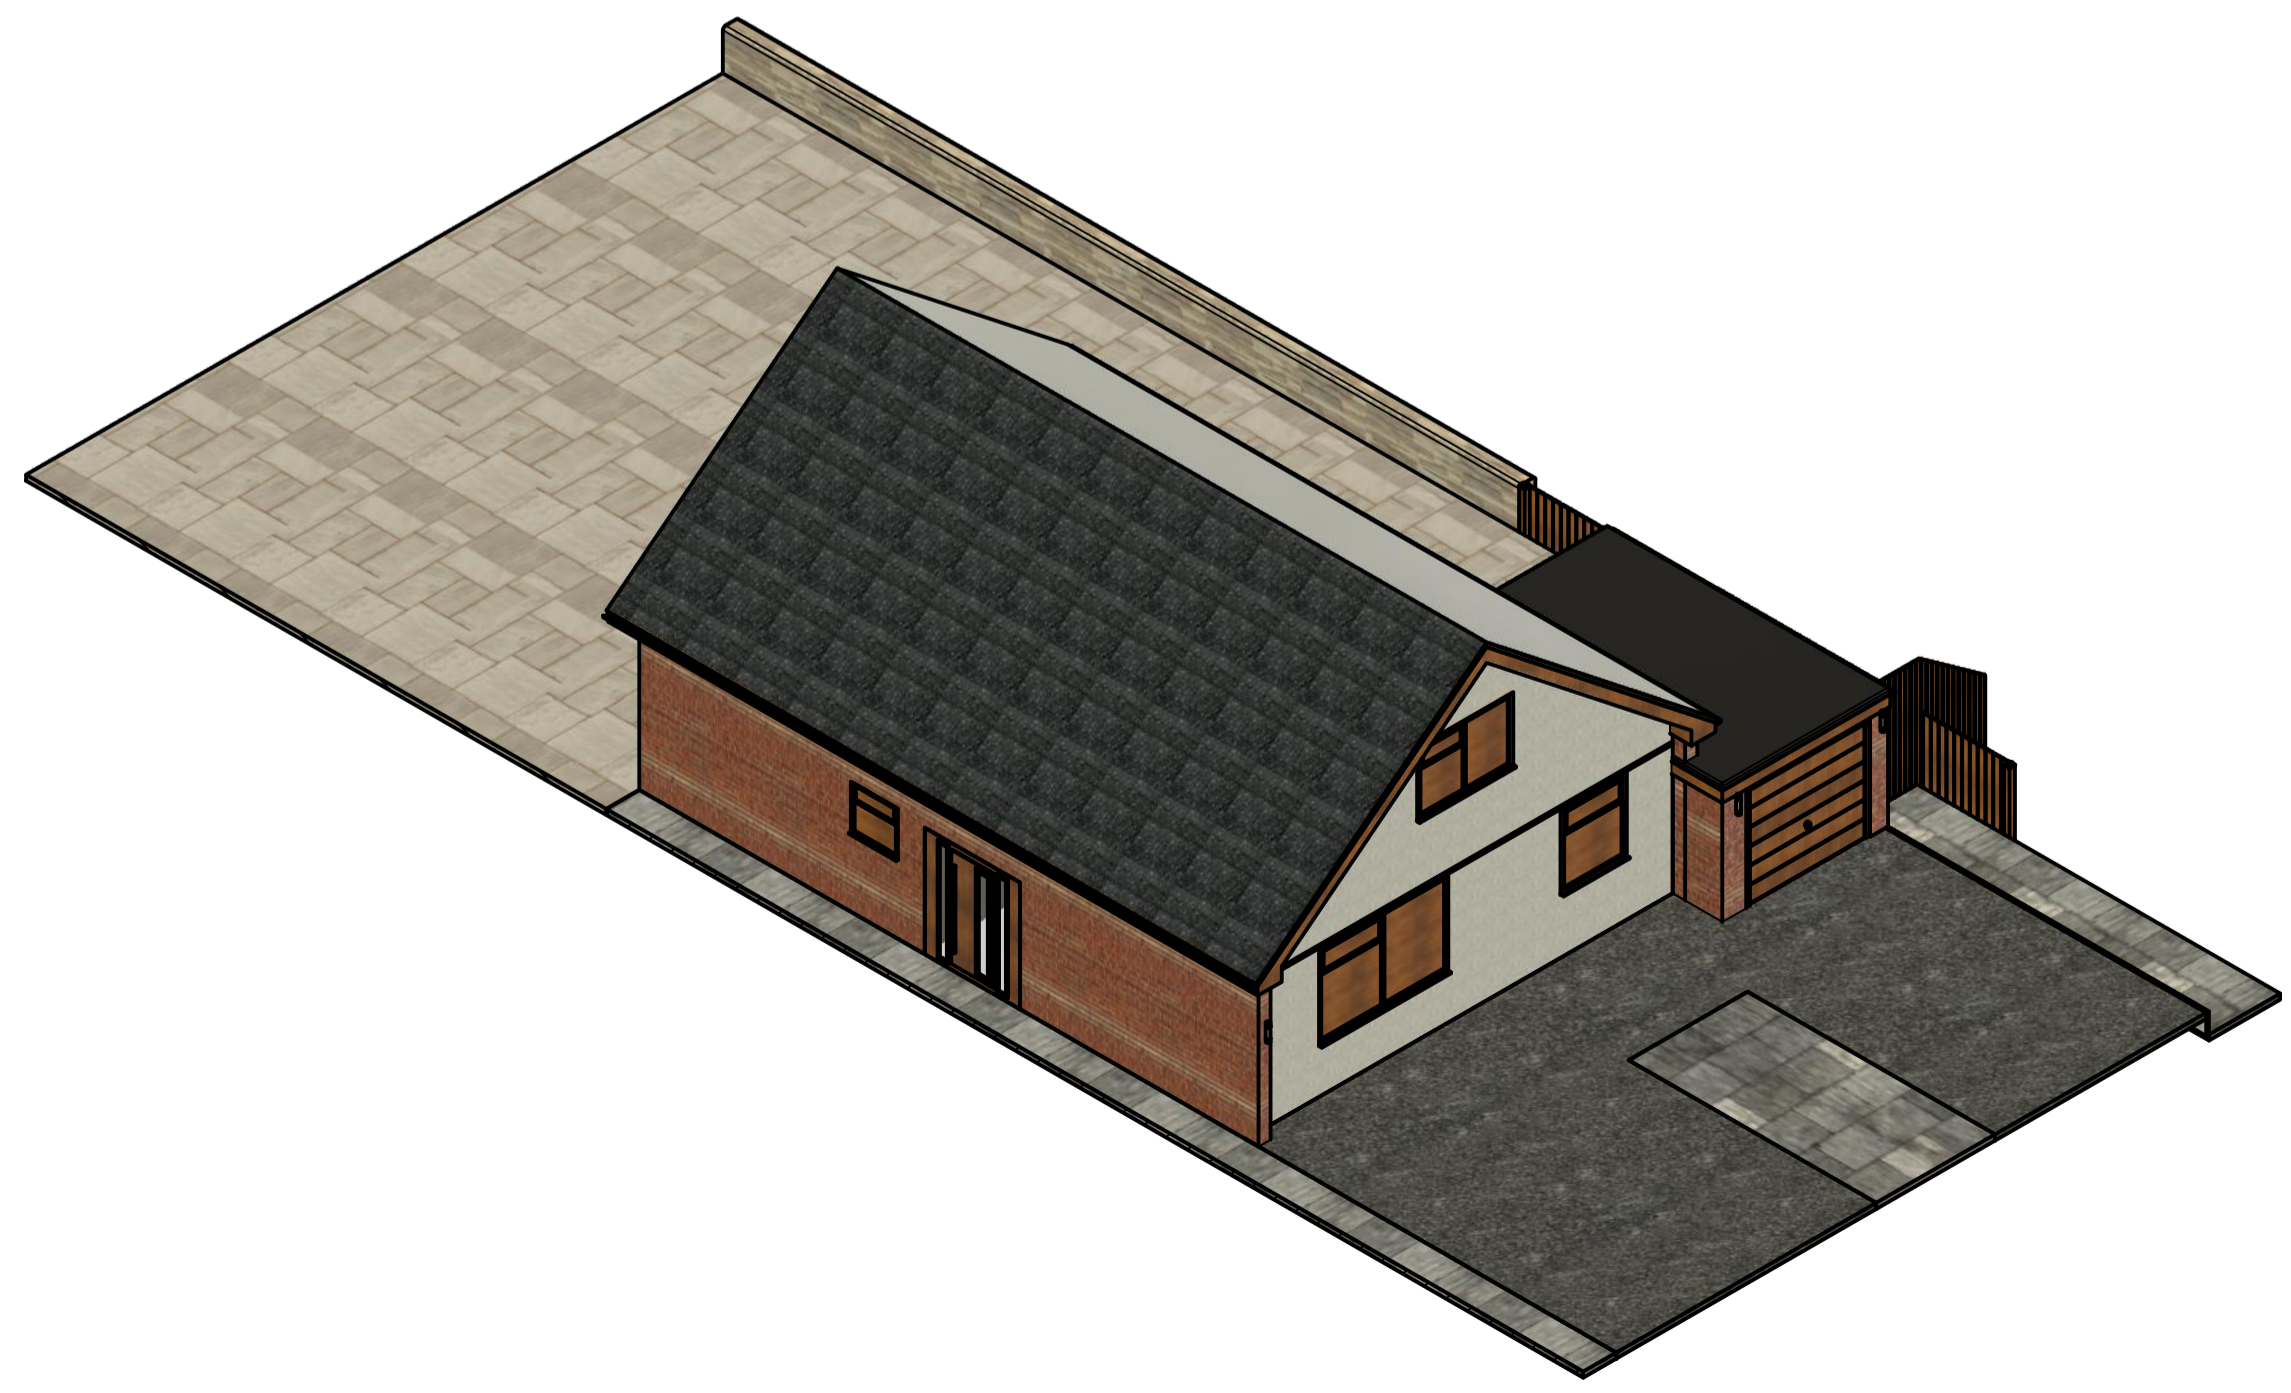

Client Approval			
Date Issued	Print	Sign	Position

Revision	Date	Drawn By	Checked By	Description

Document Status	Material	Quantity	Revision
As Built	As Detailed	N/A	V1

Tolerance	Units
Linear +/- 0.25 - Angle +/-0.5° Unless stated	MM
Break Sharp Corners w/Chamfer, x45° or Radius	Date
	27/02/2021

Created By	Surface Finish	Scale
N. Edmondson	As Detailed	1:100
Approved By	Projection	Format
N/A	First Angle	A1

Simonstone Engineering Ltd 5 Lawrence Ave, Simonstone, Lancashire, United Kingdom, BB1 3AB MOB: 07872166778	SE	Description	Units
		Existing property 5 Lawrence	MM
		Drawing Number	Scale
		SE0646-02-00	1:100
			Format
			A1
			Revision
			V1