

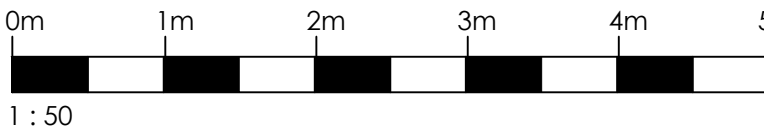


THIS DRAWING TOGETHER WITH THE DESIGN IS
COPYRIGHT OF THE ARCHITECT.
FIGURED DIMENSIONS SHOULD BE FOLLOWED
AND SCALED DIMENSIONS SHOULD BE CHECKED
WITH THE ARCHITECT.
ANY DISCREPANCY MUST BE REPORTED TO THE
ARCHITECT IMMEDIATELY AND PRIOR TO
PROCEEDING.

REVISIONS

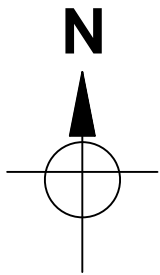

Original Drawn By	Date
TW	April 2021

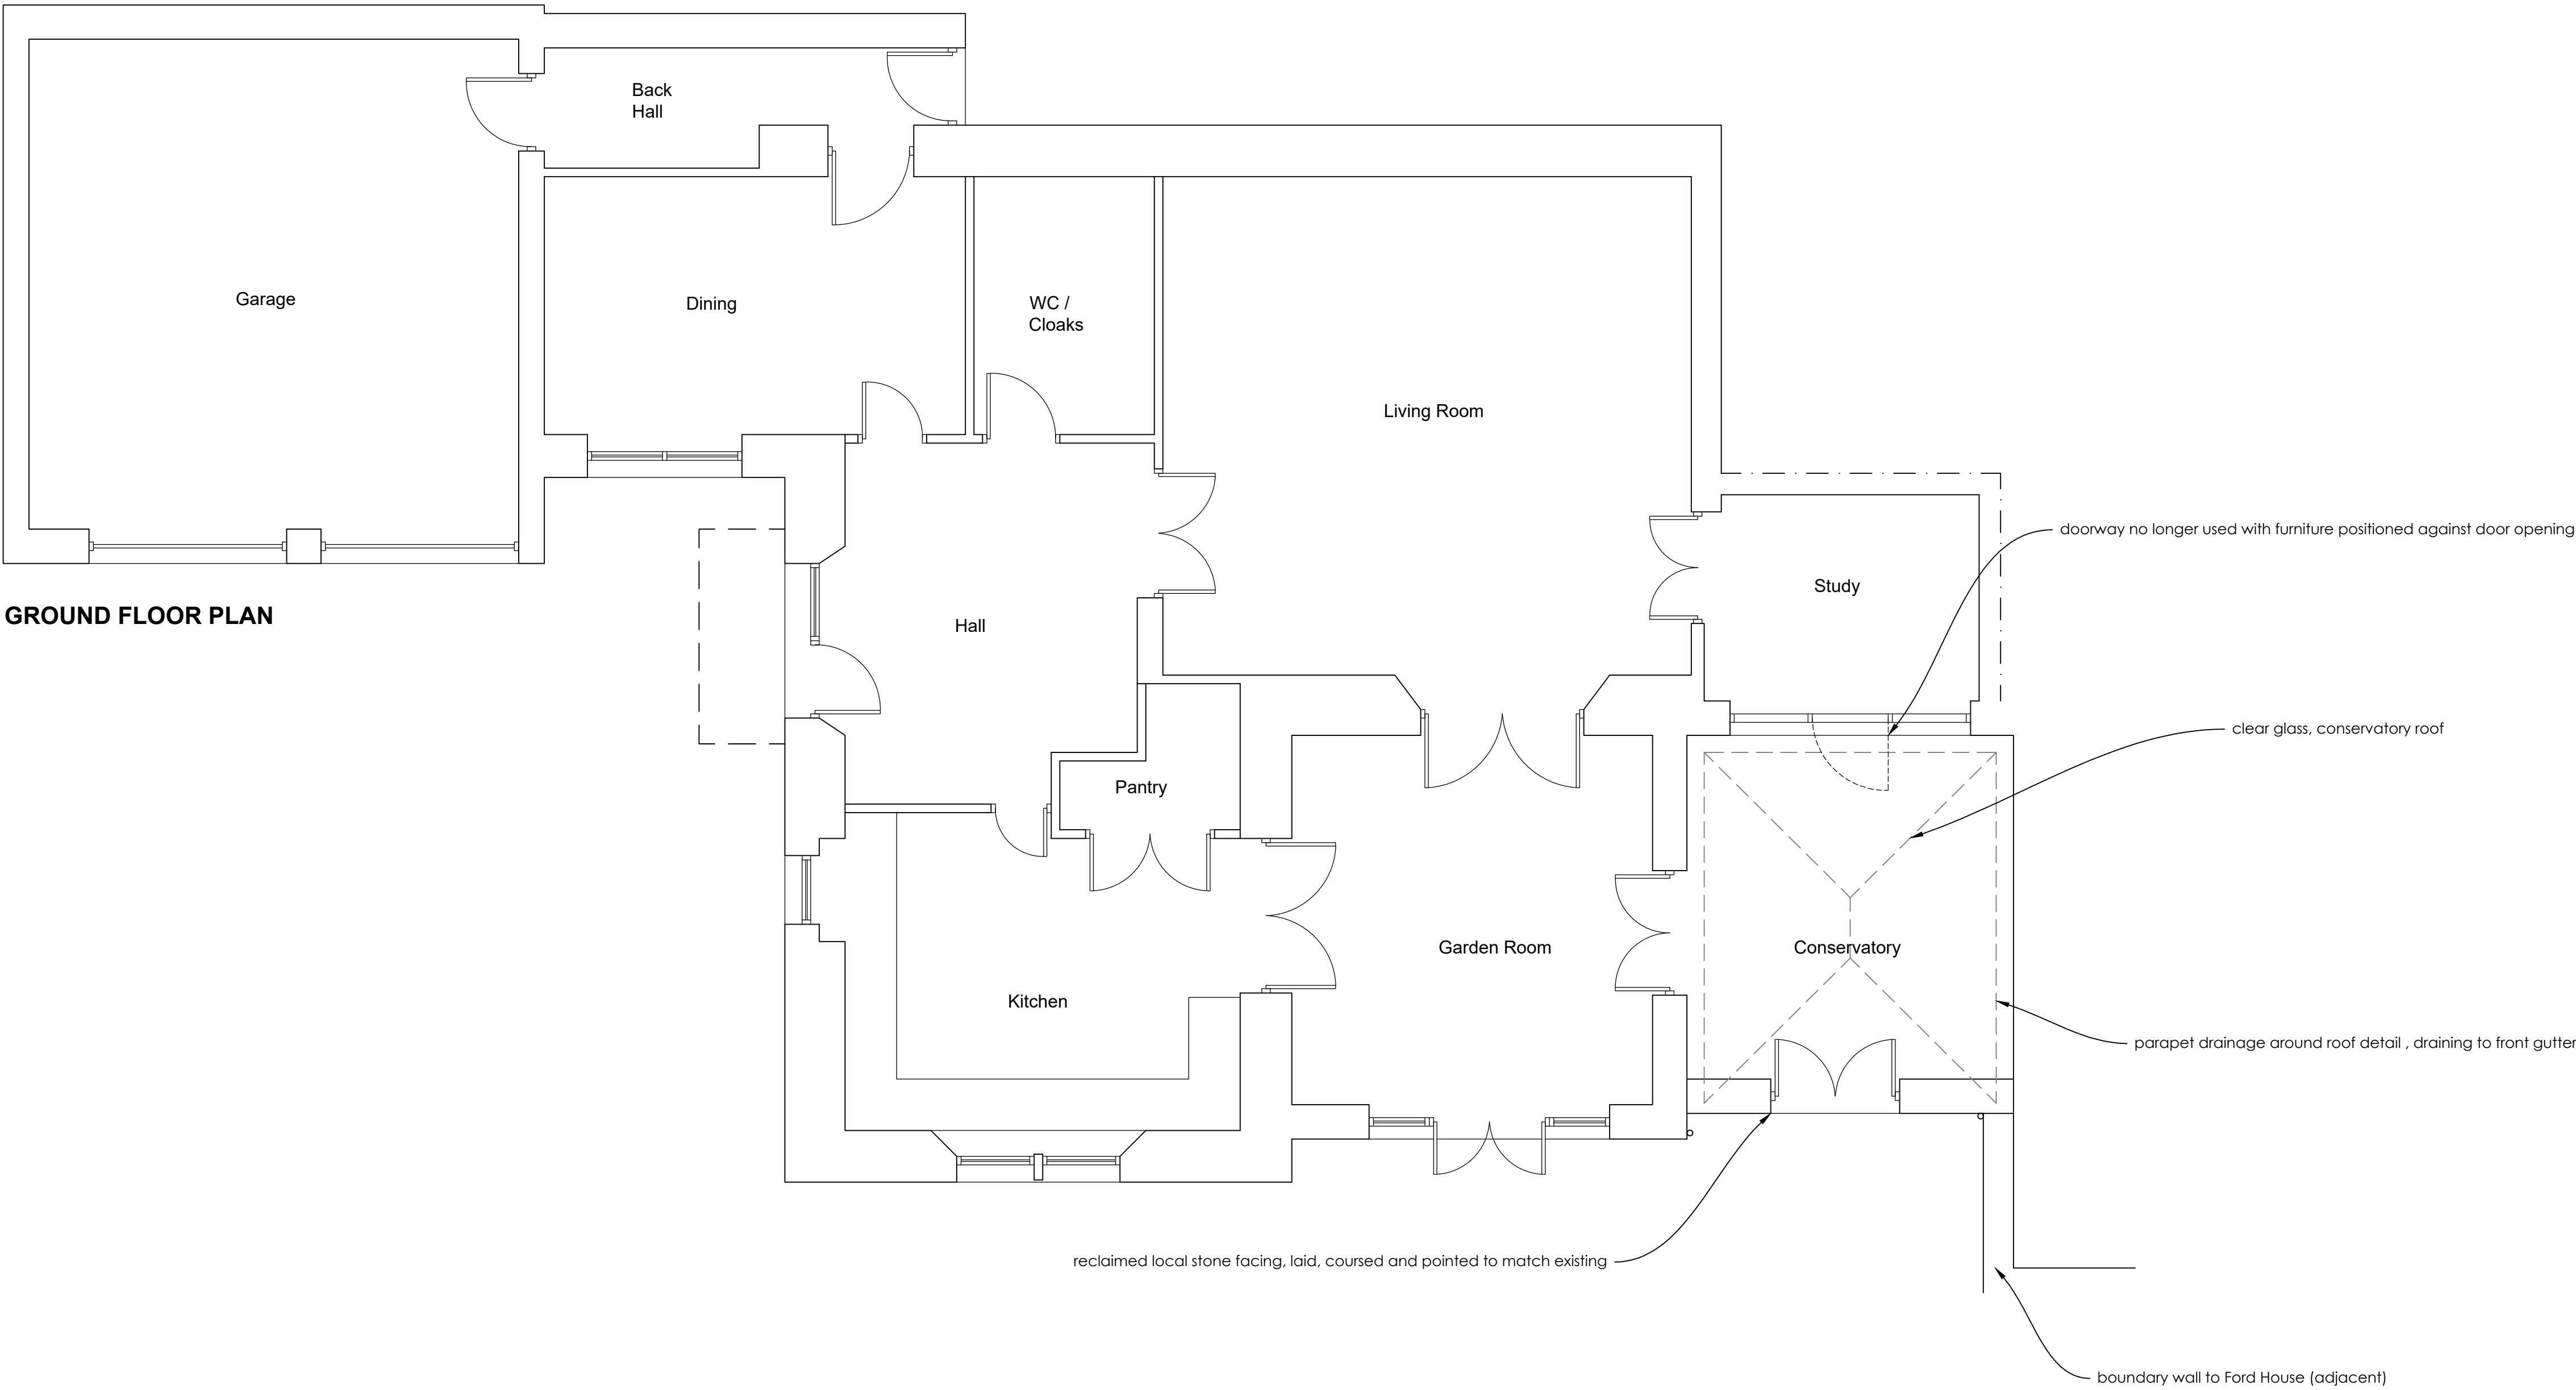

the wright design partnership
15 main street, kirky lonsdale, cumbria LA6 2AQ
tel / 015242 71697 email / mail@wdparchitects.co.uk

Client	Faux		
Contract	Alterations and Extensions to Foxfeild, Alston Lane; Longridge.		
Drawing title	AS BUILT DETAILS		
Scale	Job No.	Drg No.	
1:50 @ A1	KL2904	02	