

PERMITTED DEVELOPMENT RIGHTS FOR HOUSEHOLDERS
Ministry of Housing, Communities and Local Government

Class A - enlargement, improvement or alteration

A1 Development is not permitted by Class A if:-

a. permission to use the dwellinghouse as a dwellinghouse has been granted only by virtue of class M,N,P,PA or Q NOT APPLICABLE

b. as a result of the works, the total area of the ground covered by buildings within the curtilage of the dwellinghouse (other than the original dwellinghouse) would exceed 50% of th total are of the curtilage. COMPLIES

c. the height of the part of the dwellinghouse enlarged, improved or altered would exced the hright of the highest part of the roof of the existing dwellinghouse COMPLIES

d. the height of the eaves of the part of the dwellinghouse enlarged, improved or altered would exceed the height of the eaves of the existing dwellinghouse. COMPLIES

e. the enlarged part of the dwellinghouse would extend beyond a wall which :-
i. forms the principal elevation of the original dwellinghouse; or
ii. fronts a highway and forms a side elevation of the original dwellinghouse COMPLIES

f. the enlarged part of the dwellinghouse would have a single storey and :-
i. extend beyond the rear wall of the original dwelling by more than 4m in the case of a detached dwellinghouse ...
ii. exceed 4m in height SEE ITEM 'g'

g. for a dwellinghouse not on article 2(3) land nor on a site of specific scientific interest, the enlarged part of the dwellinghouse would have a single storey and :-
i. extend beyond the rear wall of the original dwellinghouse by more than 8m in the case of a detached dwellinghouse ...
ii. extend 4m in height (excluding parapets and eaves overhangs as note to item 'd'). COMPLIES

h. the enlarged part of the dwellinghouse would have more than a single storey and :-
i. extend beyond the rear wall of the original dwellinghouse by more than 3m, or
ii. be within 7m of any boundary of the curtilage of the dwellinghouse being enlarged which is opposite the rear wall of the dwellinghouse. COMPLIES

i. the enlarged part of the dwellinghouse would be within 2m of the boundary of the curtilage of the dwellinghouse, and the height of the eaves of the enlarged part would exceed 3m. NOT APPLICABLE

j. the enlarged part of the dwellinghouse would extend beyond a wall forming a side elevation of the original dwellinghouse, and would:-
i. exceed 4m in height,
ii. have more than a single storey, or
have a width greater than half the width of the original dwelinhouse COMPLIES

ja. any total enlargement (being the enlarged part together with any existing enlargement of the original dwellinghouse to which it will be joined) exceeds or would exceed the limits set out in sub-paragraphs e-i. COMPLIES

k. it would consist of or include :-
i. the construction or provision of a verandah, balcony or raised platform
ii. the installation, alteration or replacement of a microwave antenna
iii. the installation, alteration or replacement of a chimney, flue or soil and vent pipe, or
iv. and alteration to any part of the roof of the dwellinghouse COMPLIES

A2 In the case of a dwellinghouse on article 2(3) land, development is not permitted by class A if:- NOT APPLICABLE

a. it would consist of or include the cladding of any part of the exterior of the dwellinghouse with stone, artificial stone, pebble dash, render, timber, plastic or tiles NOT APPLICABLE

b. the enlarged part of the dwellinghouse would extend beyond a wall forming a side elevation of the original dwellinghouse NOT APPLICABLE

c. the enlarged part of the dwellinghouse would have more than a single storey and extend beyond the rear wall of the original dwellinghouse: or NOT APPLICABLE


ca. any total enlargement (being the enlarged part together with any existing enlargement of the original dwellinghouse to which it will be joined) exceeds or would exceed the limits set out in sub-paragraphs b-c. NOT APPLICABLE

A3 Development is permitted by Class A to the following conditions :-


a. materials used in any exterior work (other than materials used in the construction of a conservatory) shall be similar in appearance to those used in the construction of the exterior of the existing dwellinghouse. COMPLIES

b. any upper-floor window located in a wall or roof slope forming a side elevation of the dwellinghouse shall be :-
i. obscure-glazed, and
ii. non-opening unless the parts of the window can be opened are more than 1.7m above the floor of the room in which the window is installed. COMPLIES

red line indicates existing profile

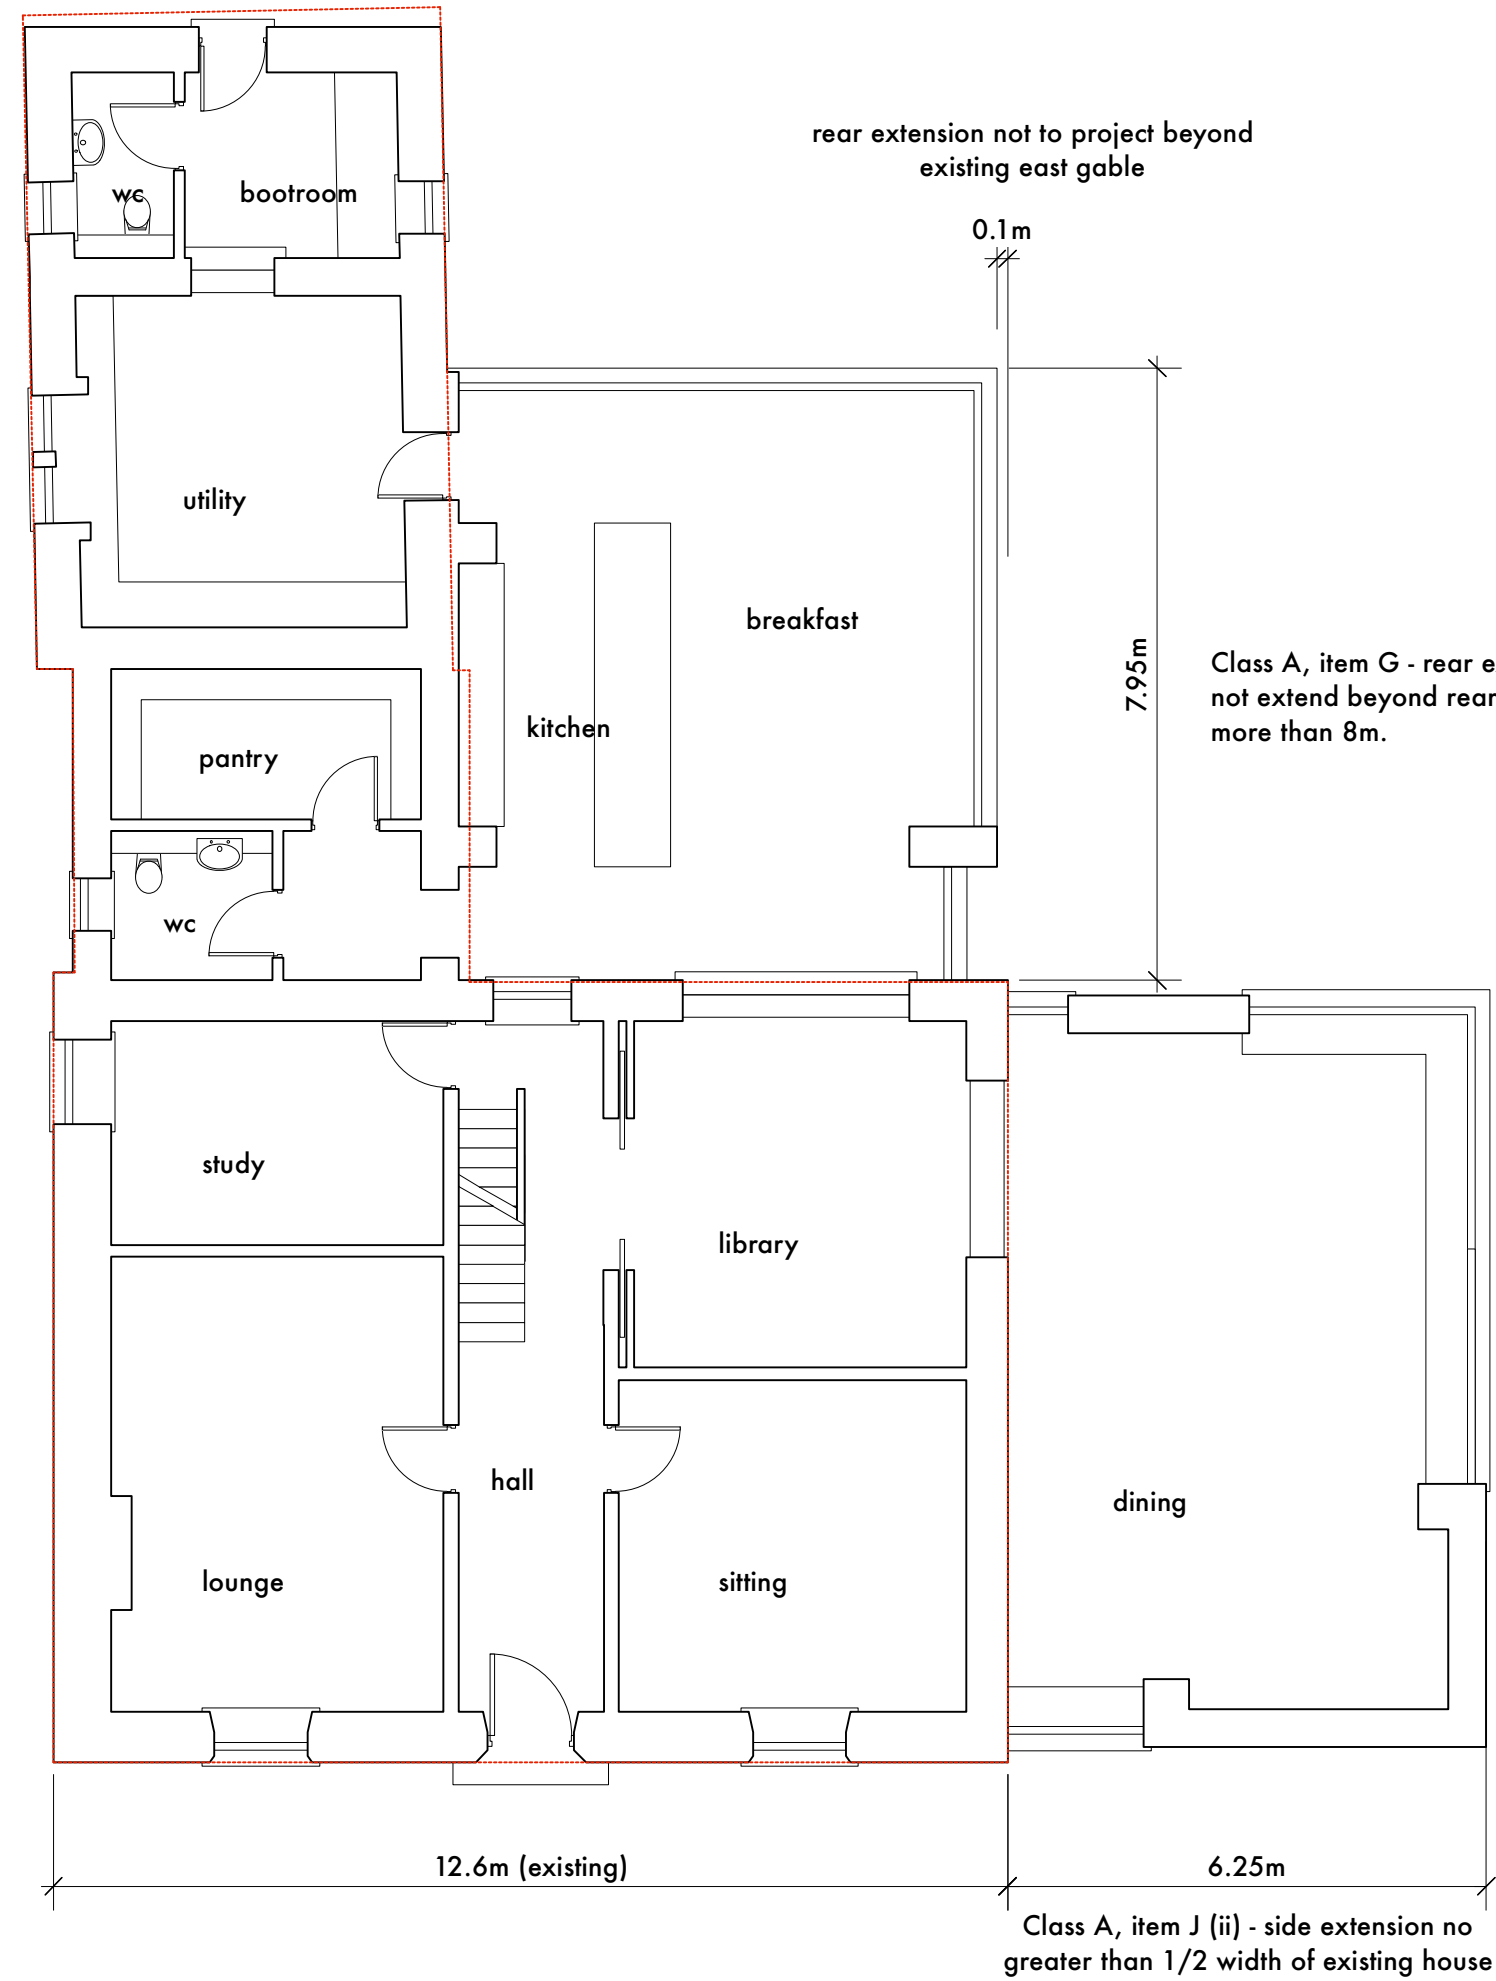

ground floor plan

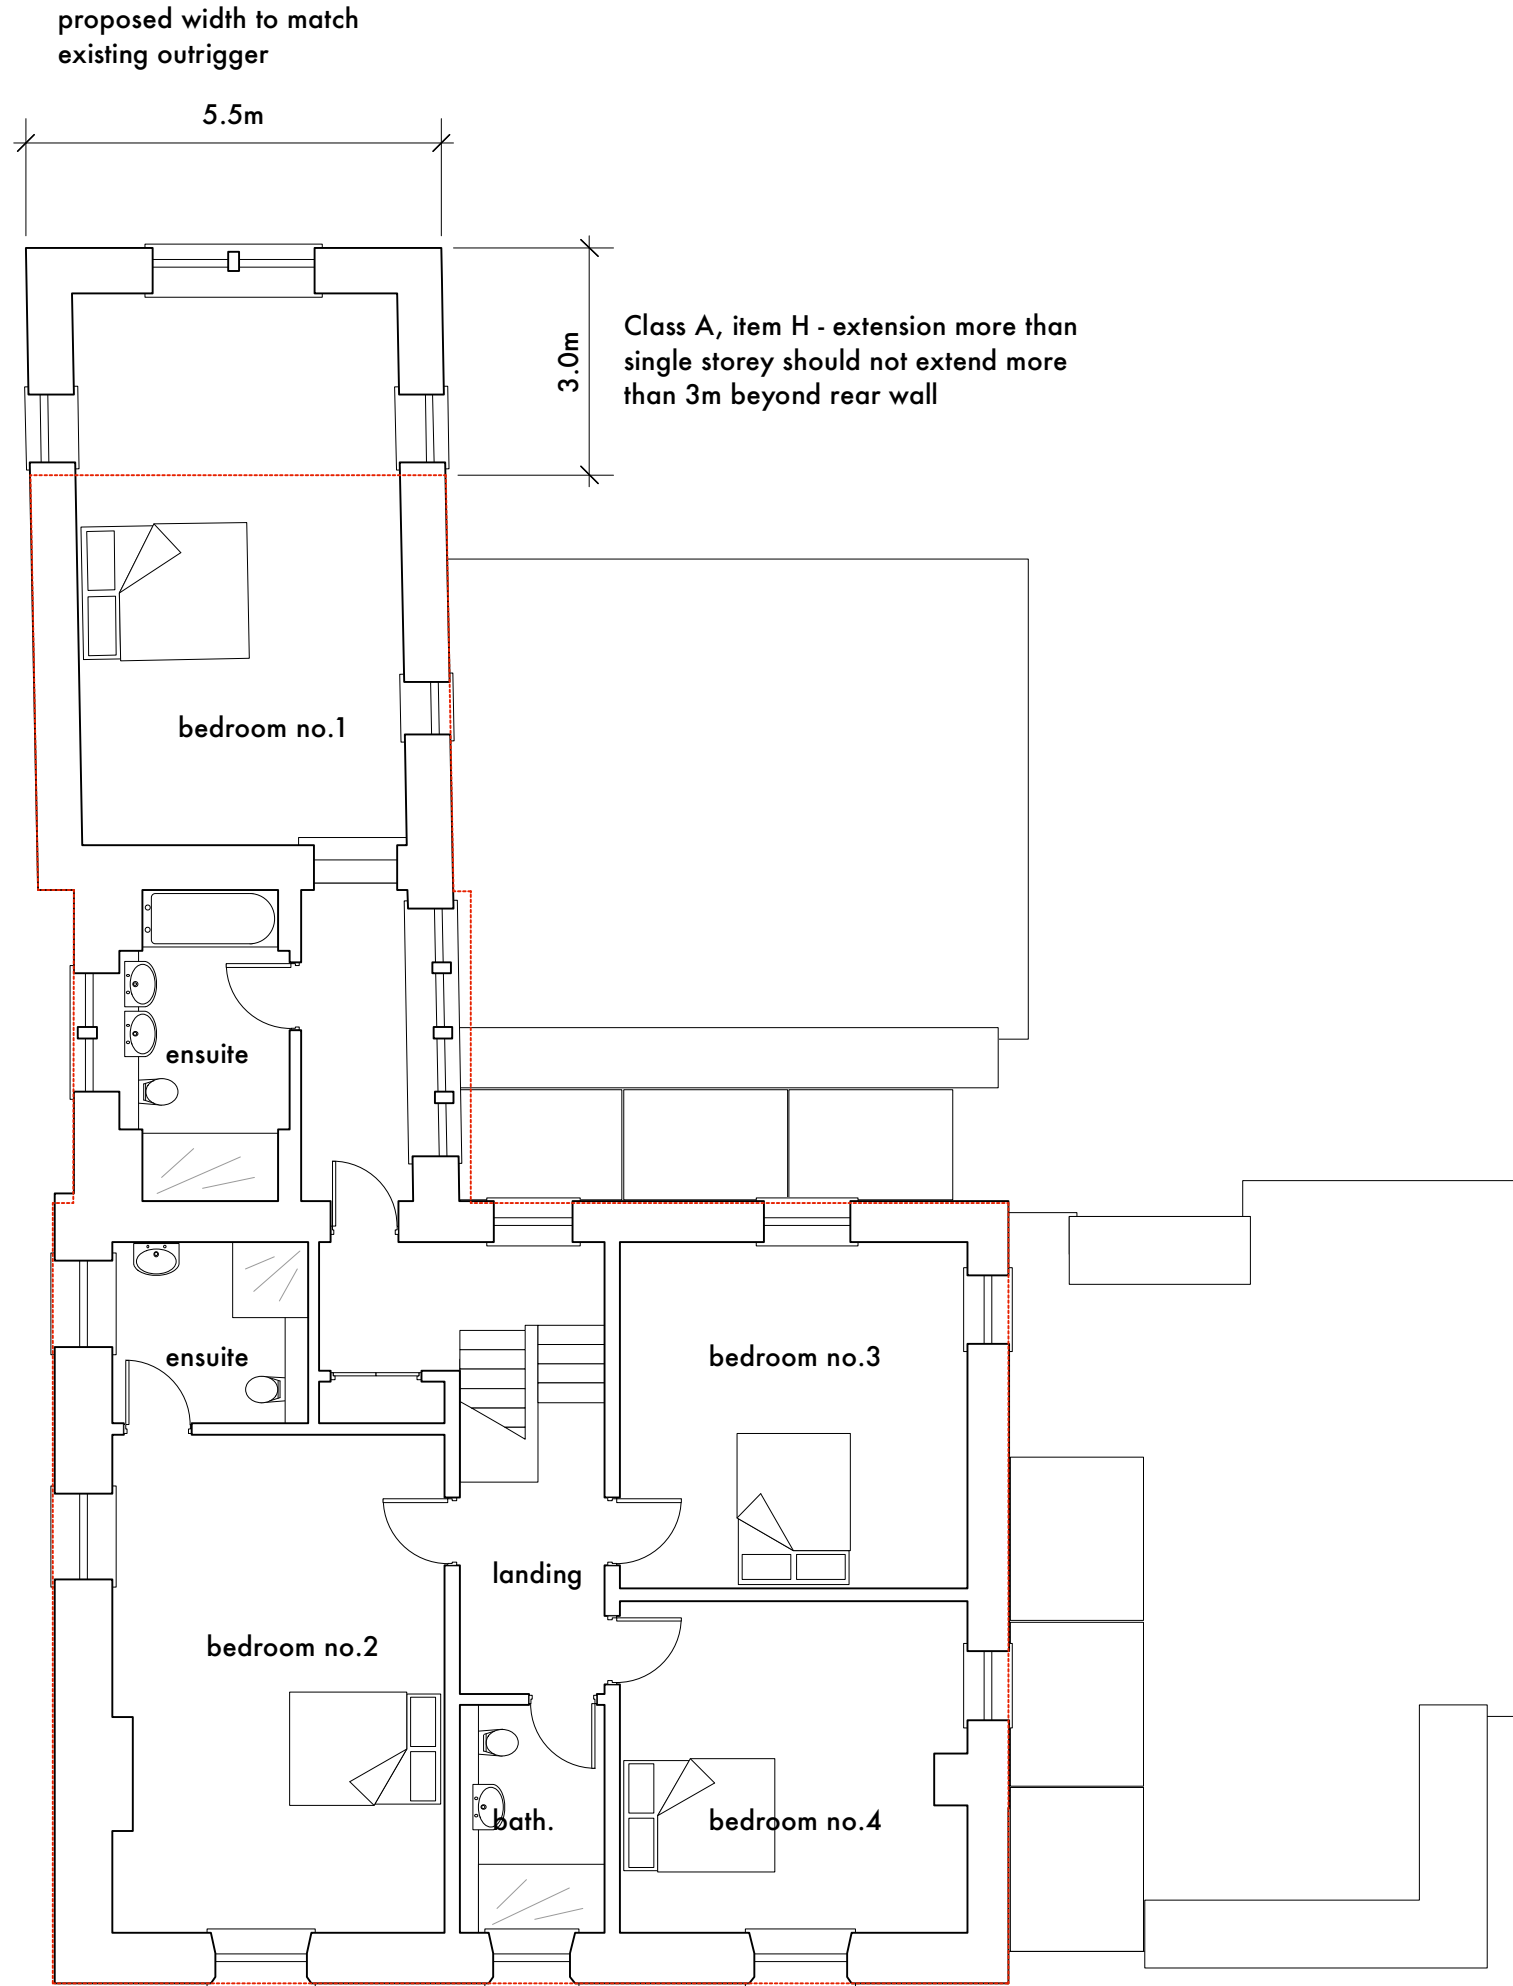

first floor plan

Stanton Andrews do not accept liability for any loss or degradation of information held in the drawing resulting from the translation from the original file format to any other file format or from the recipients reading of it in any other programme or on earlier version of the programme. Stanton Andrews accepts no liability for use of this drawing by parties other than the party for whom it was prepared or for purposes other than those for which it was prepared. Do not scale, use figured dimensions only. All dimensions to be checked on site. This drawing should be printed and read at the original size, as stated in title block. Stanton Andrews accept no responsibility for errors that occur as a result of reviewing this drawing at any other size. Stanton Andrews to be notified of any discrepancies before proceeding. Drawing is to be read in conjunction with all relevant consultants and specialists drawings. 'As existing' drawings based on information provided by others - no measured survey of the property has been undertaken by the architect. This drawing is subject to copyright.

revision	date	note
A	04.05.21	lawful development certificate
B	11.05.21	additional dimensions added (requested by RVBC)

