






Natural slate

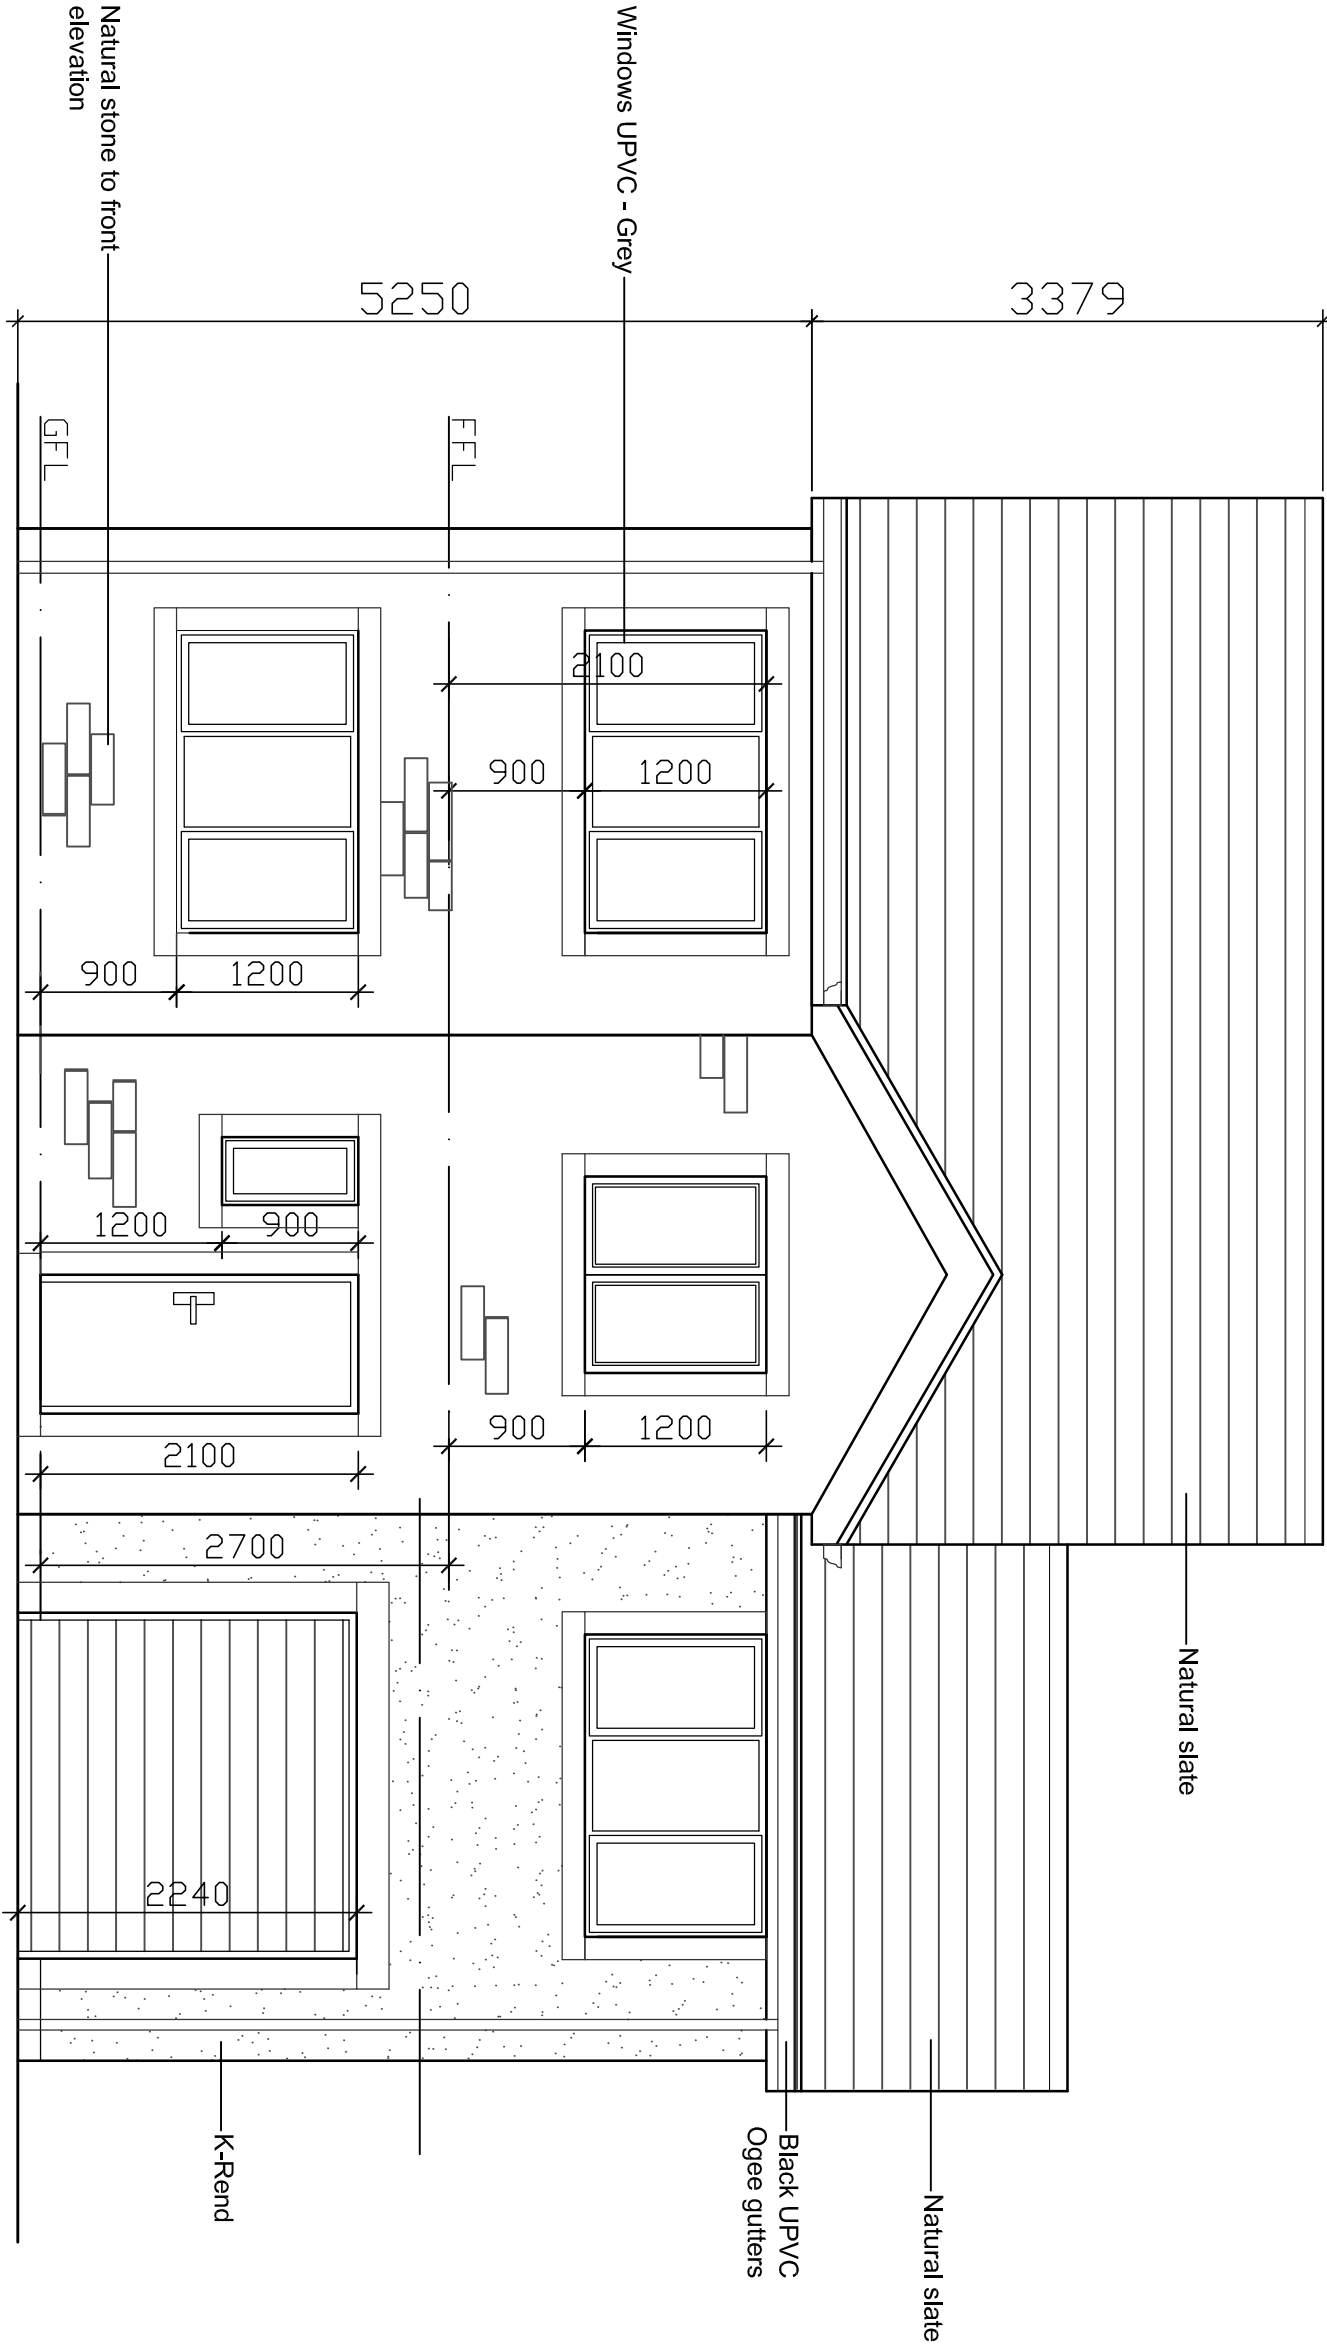


Front Elevation (West)
1:50 Scale

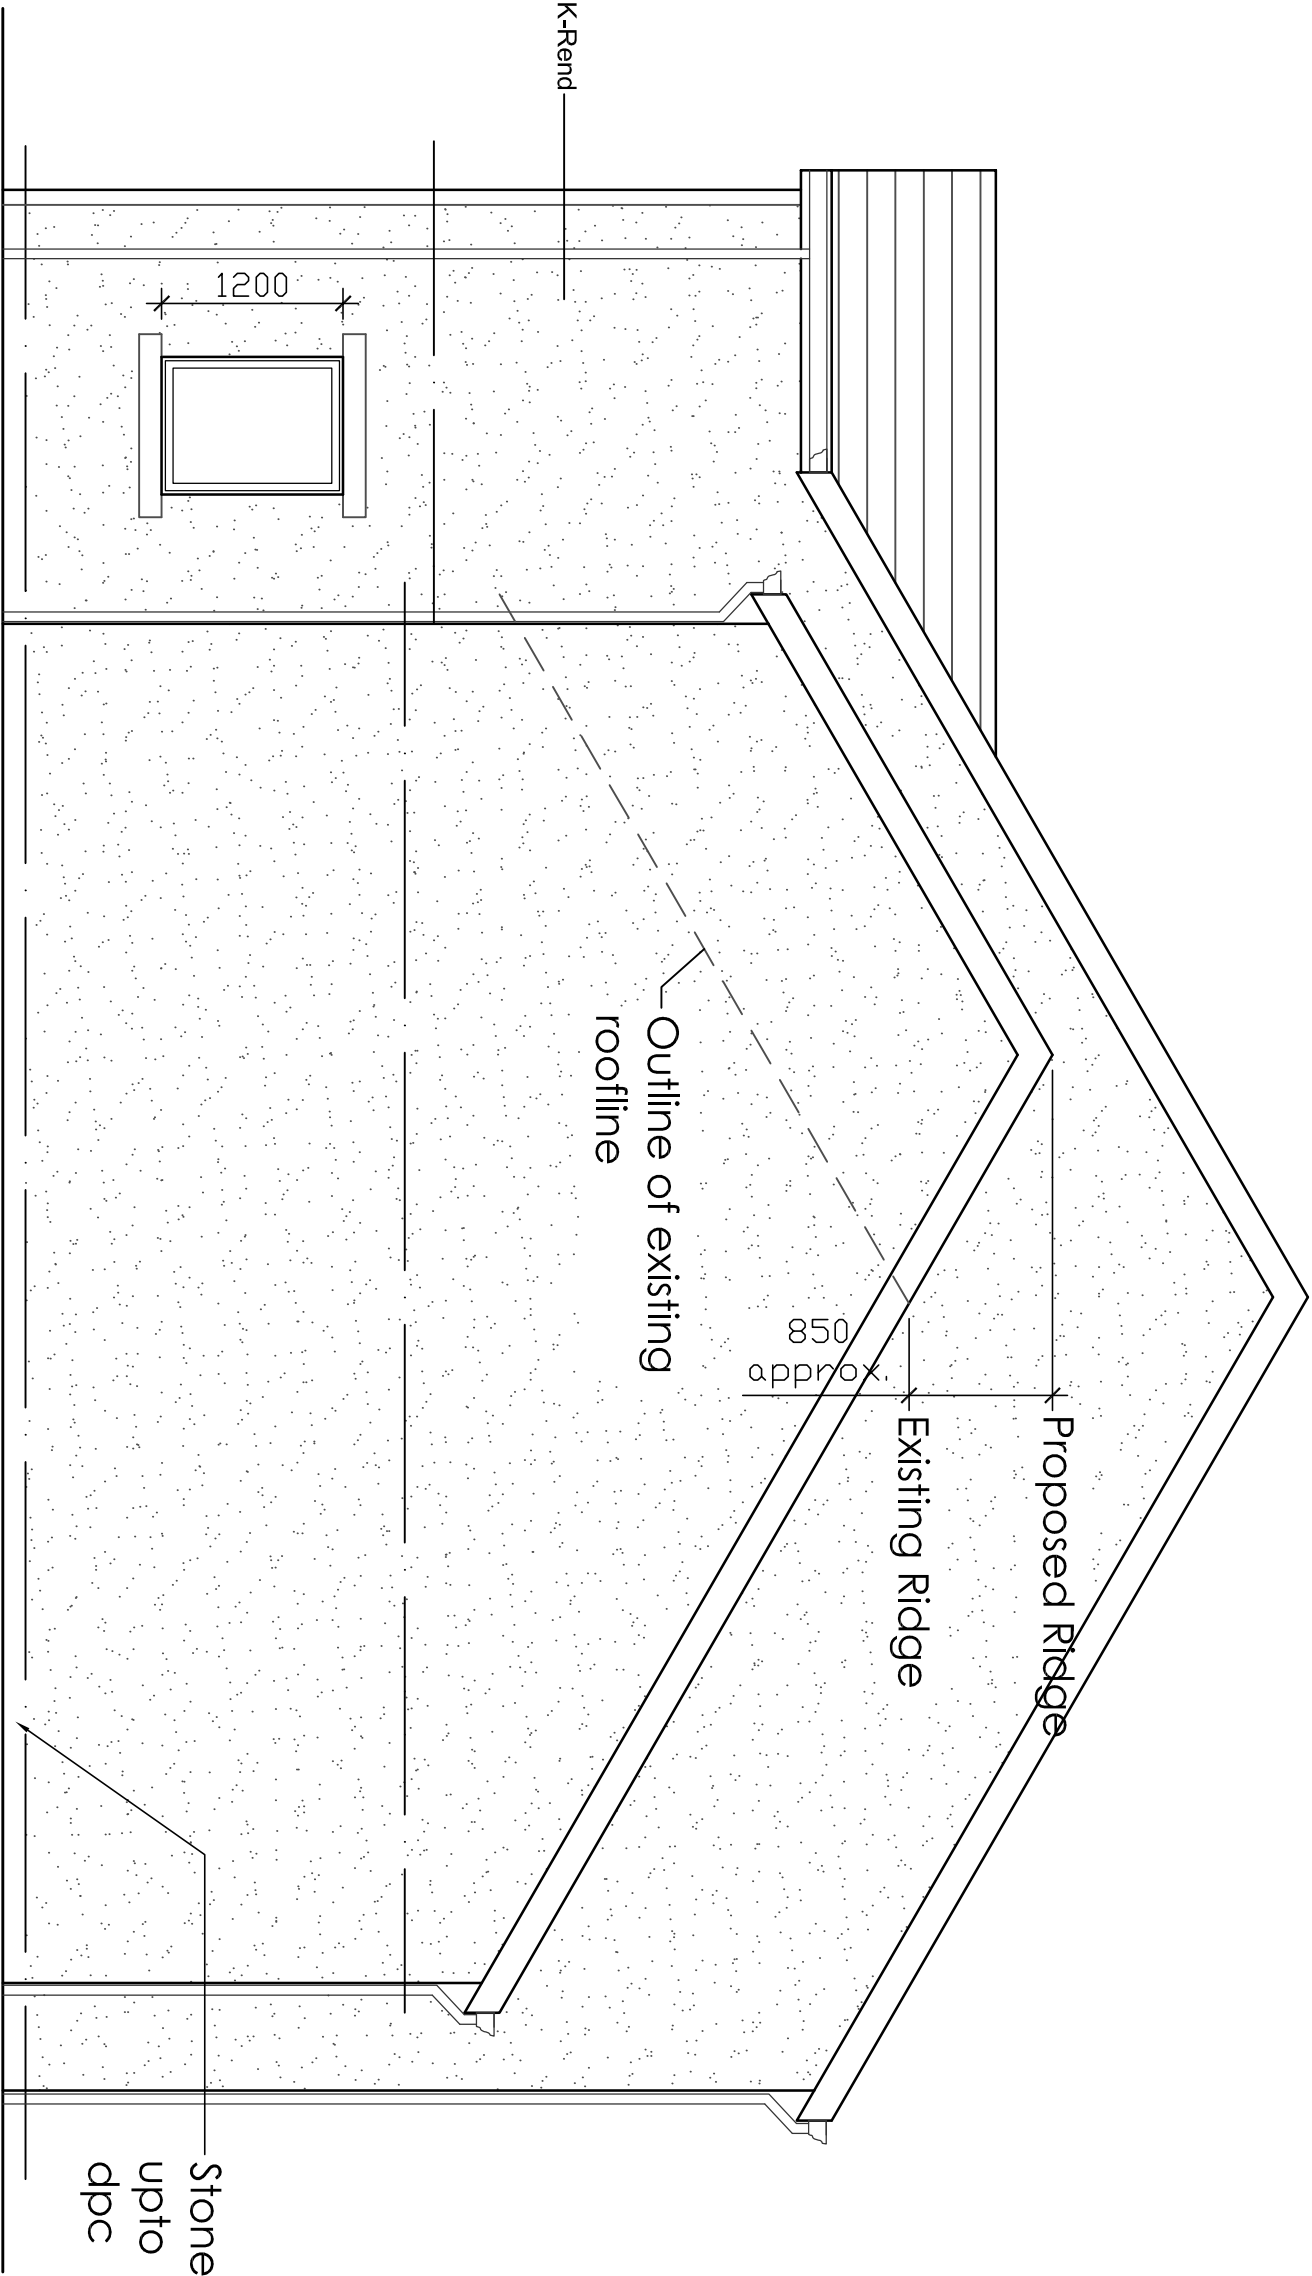

Side 1 Elevation (South)
1:50 Scale

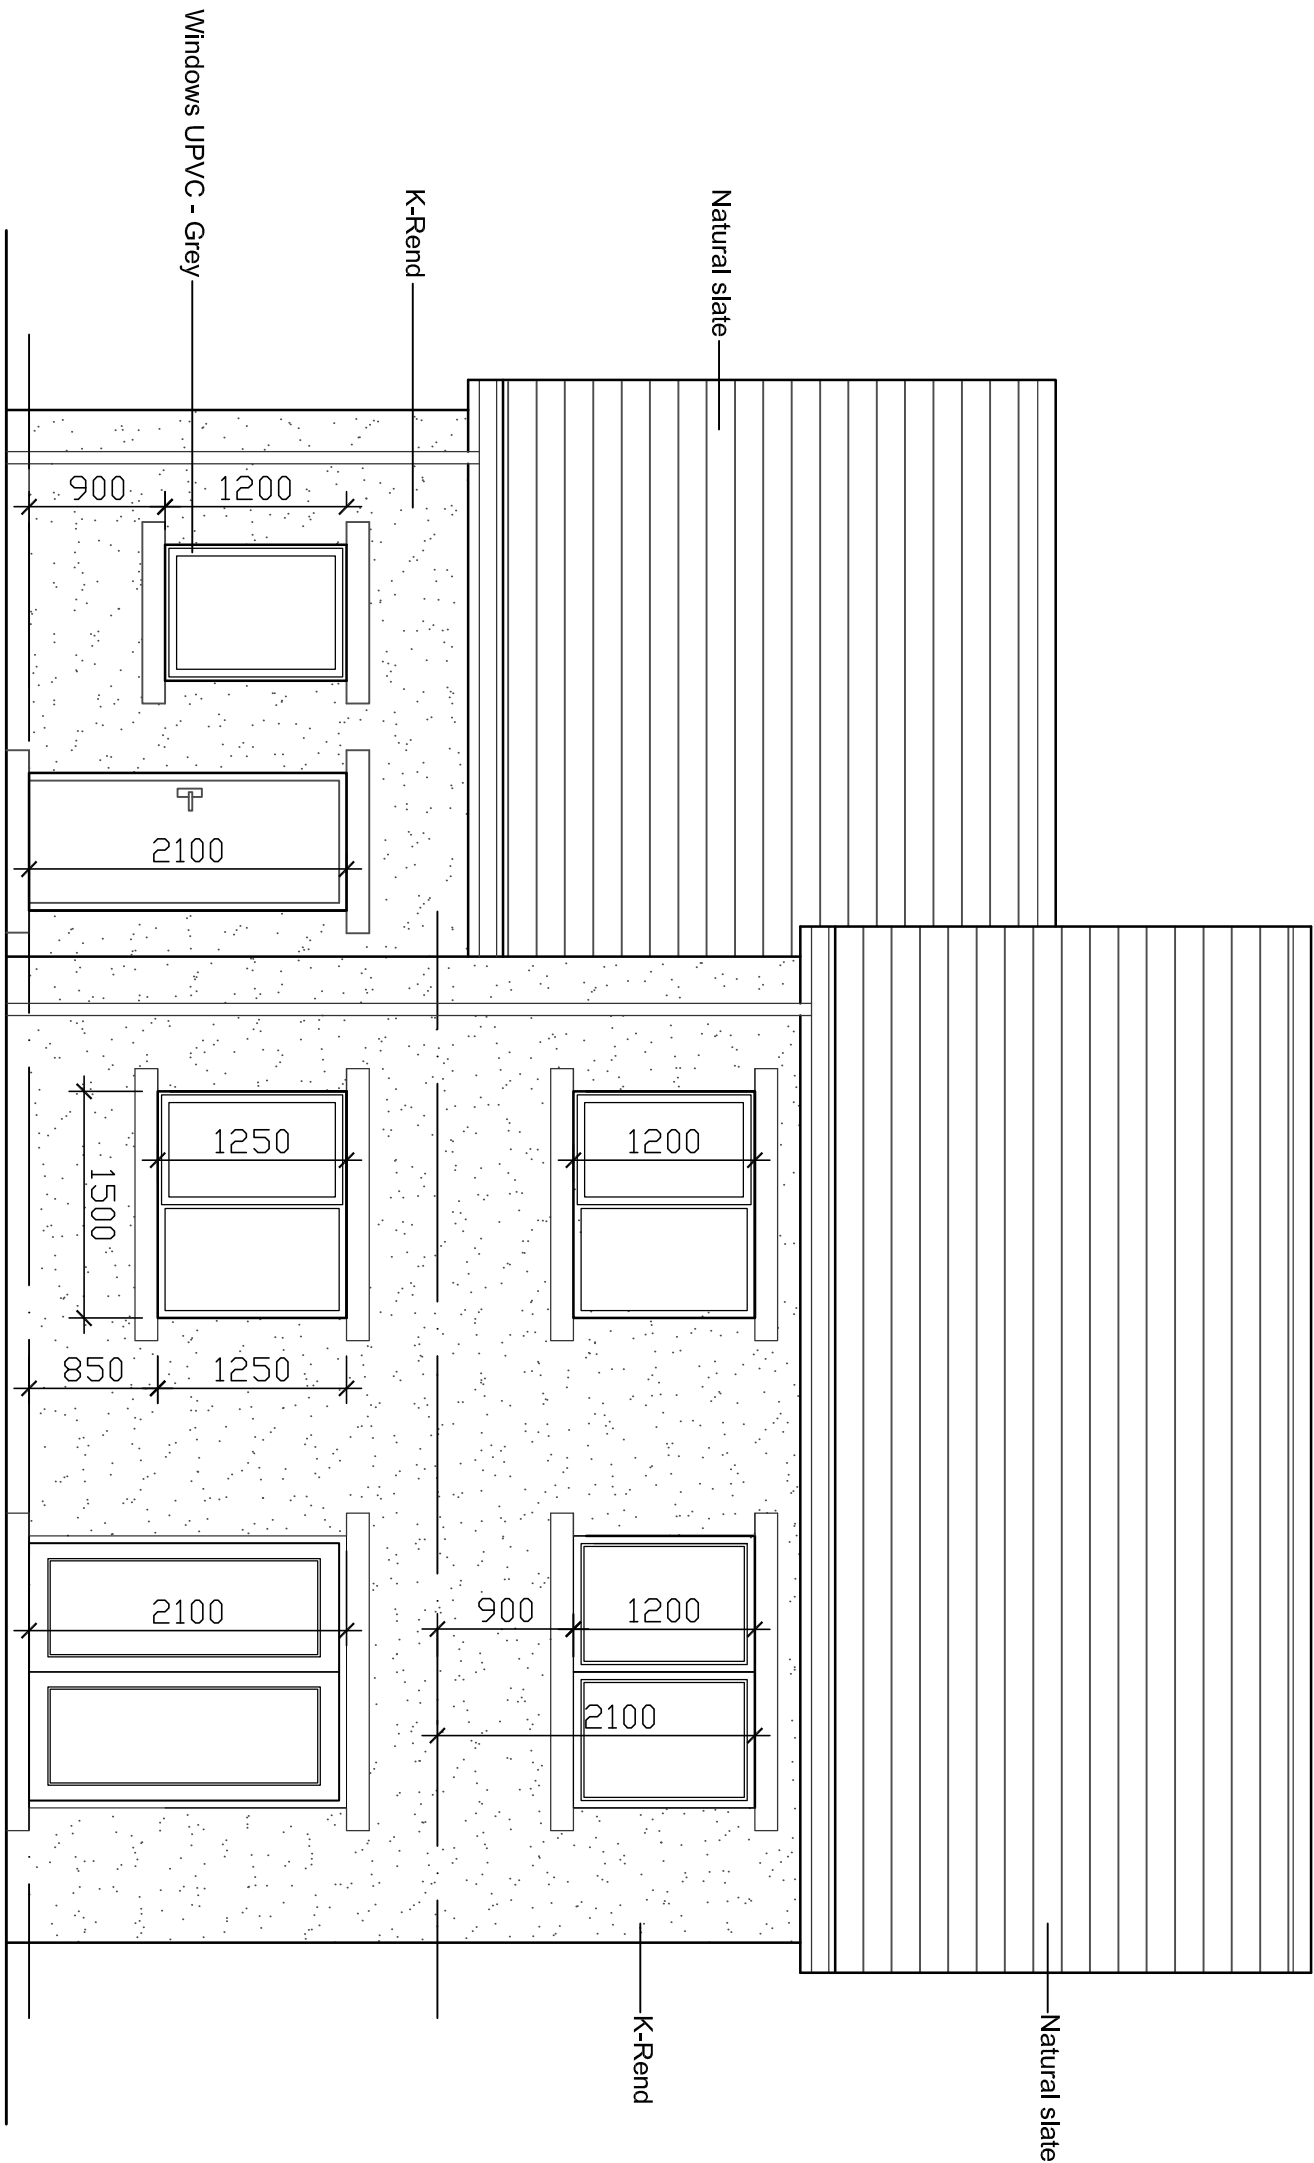

Rear Elevation (East)
1:50 Scale

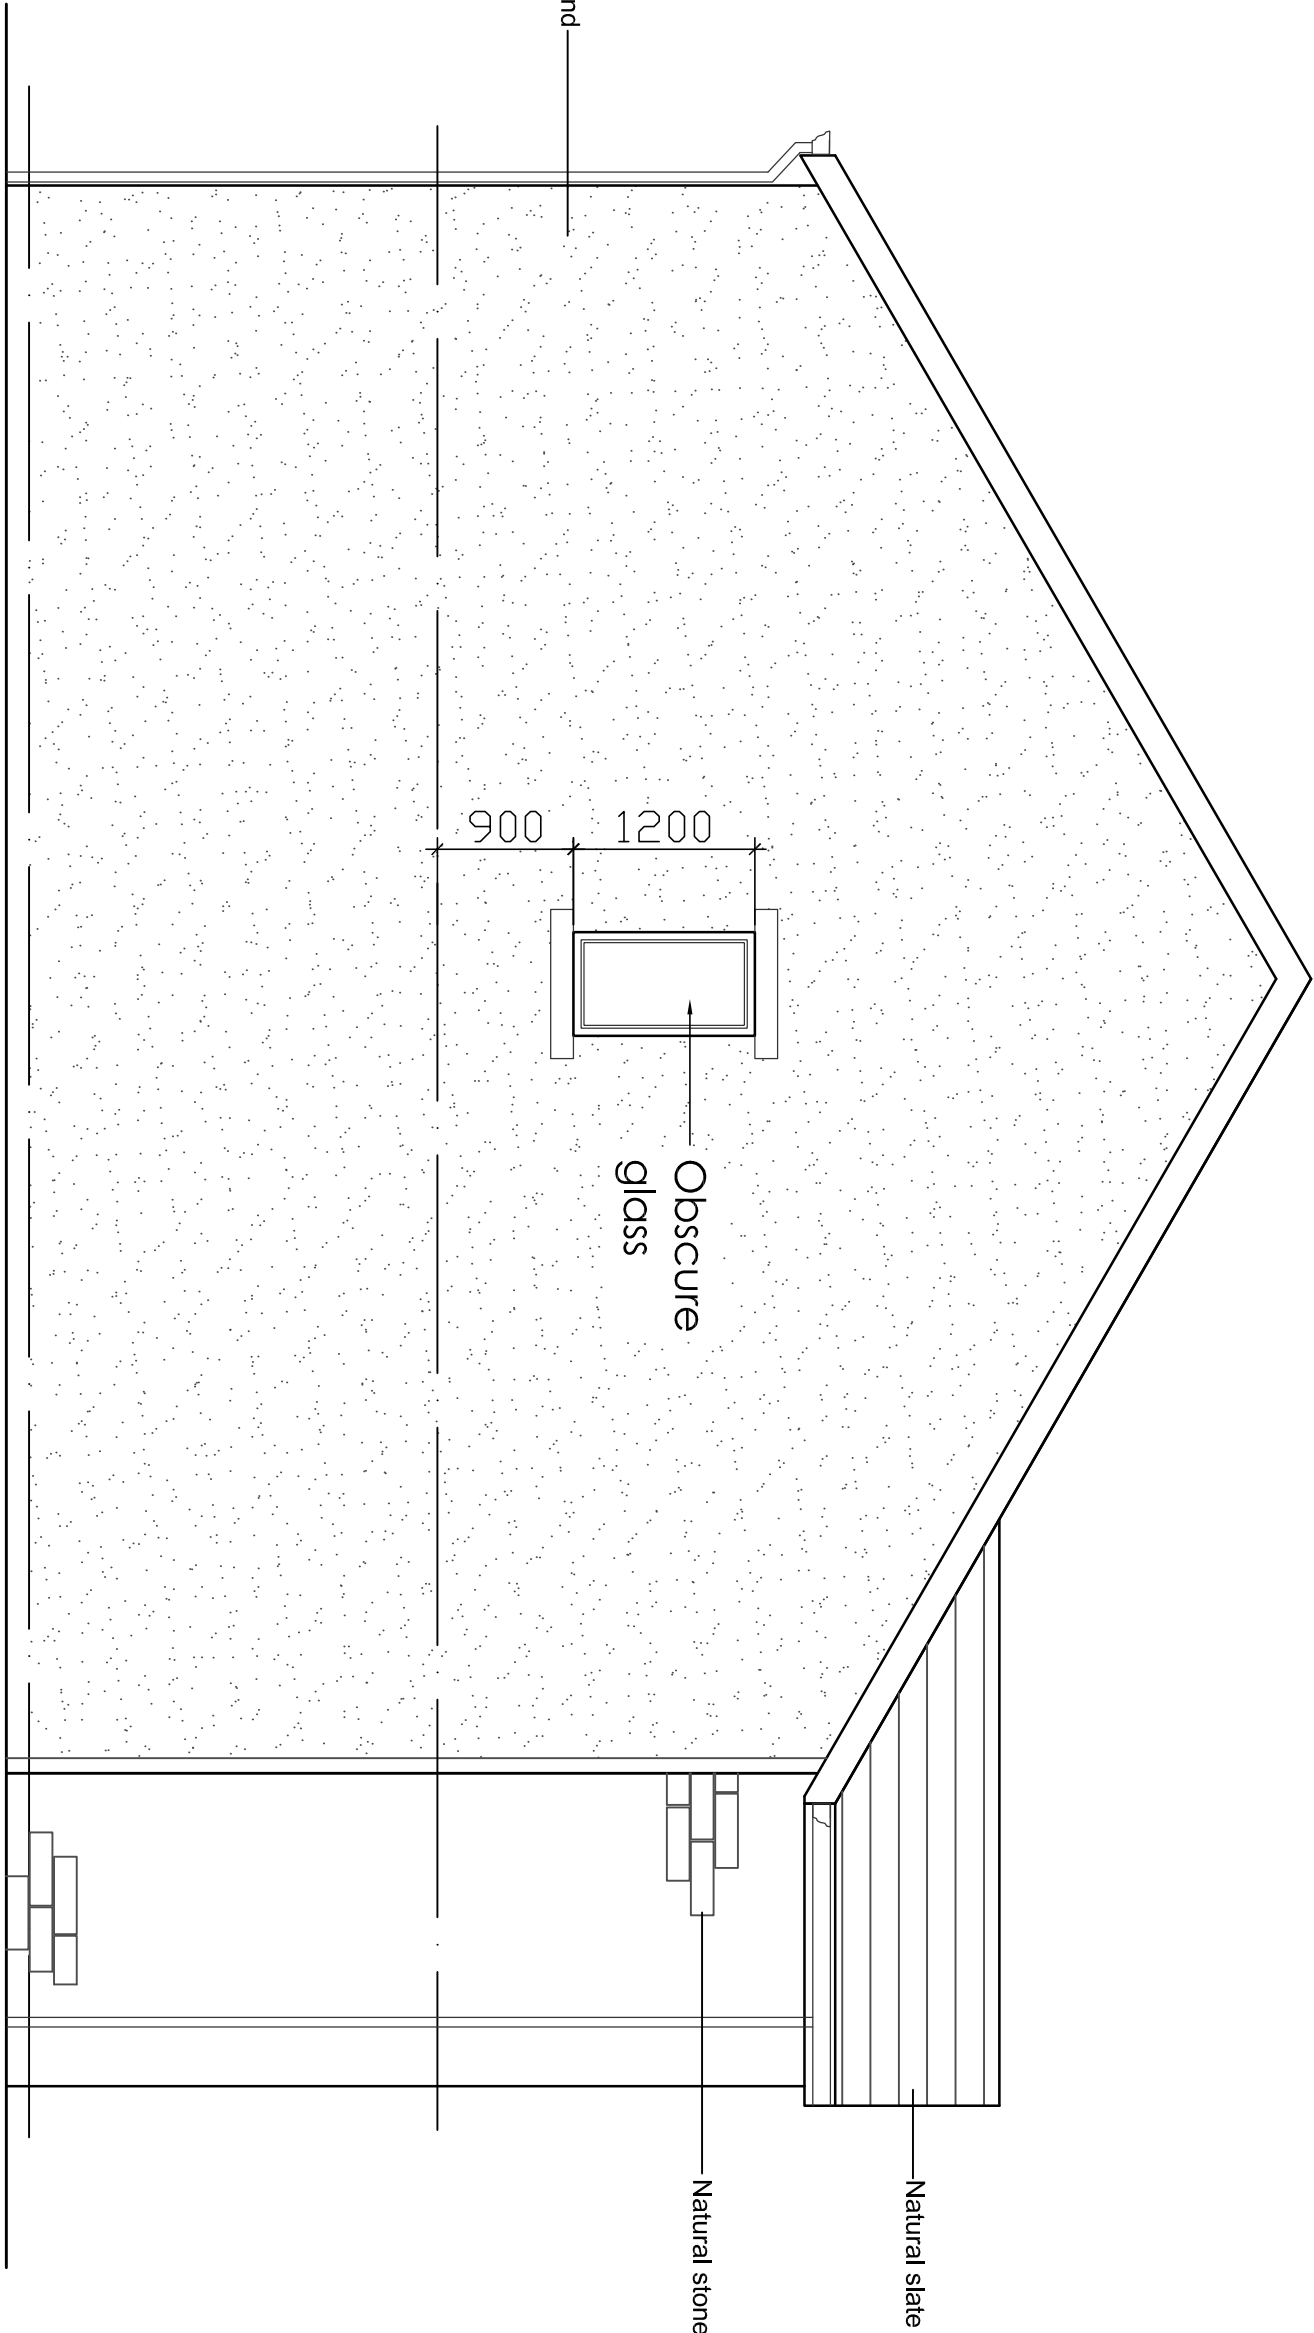

Side 2 Elevation (North)
1:50 Scale

Drawing Title			
Proposed Elevations Unit 3			
Scale:	Date:	Drawn:	Checked:
1:50 @ A1	Dec 2019	Craig Harrison	

SUNDERLAND PEACOCK ARCHITECTS
SUNDERLAND PEACOCK & ASSOCIATES LTD.
LAKESHORE, 88-90 ROAD, CUPERTINE
T 01208 423119 F 01208 427228
www.sunderlandpeacock.com



5766 - T06G

Rev G: Change window over Garage to 3 pane, as requested by RVBC, 29.07.2021
Rev F: First Floor extension proposed over garage - Variation of condition application, 14.05.2021
Rev E: First floor extension omit from over garage, materials changed to stone to front elevation with K-Rend to sides and rear, 13.05.2021
Rev C: Client alterations as per marked up sketches, 18.05.2021

MFH Projects (Harrison)

Proposed Dwellings
Land at Victoria Terrace
Mellor Brook

Job Title