



RVBC DEPOT: PROPOSED FLOOR PLANS & ELEVATIONS


DEVELOPMENT OF LAND OFF DIXON ROAD, LONGRIDGE, PRESTON PR3 3JE

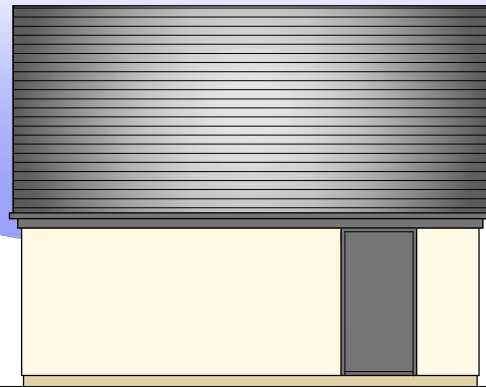


north-west (side) elevation

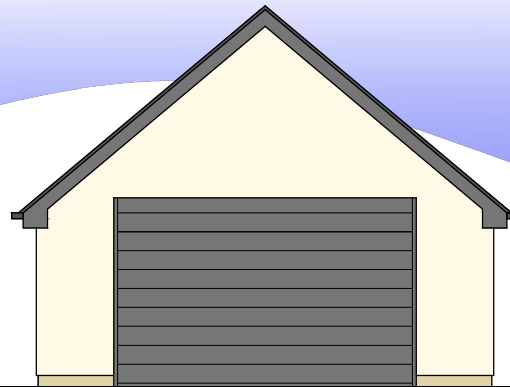


south-west (front) elevation

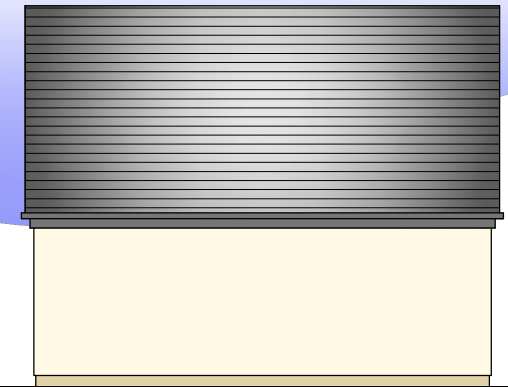



south-east (side) elevation

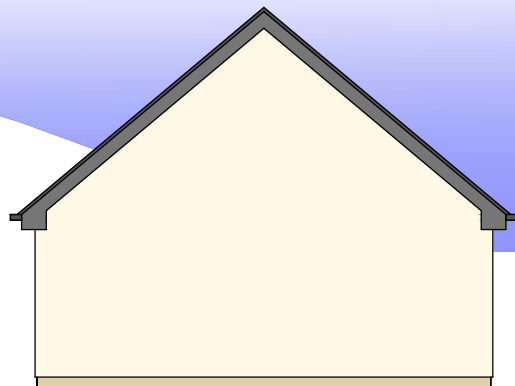

north-east (rear) elevation

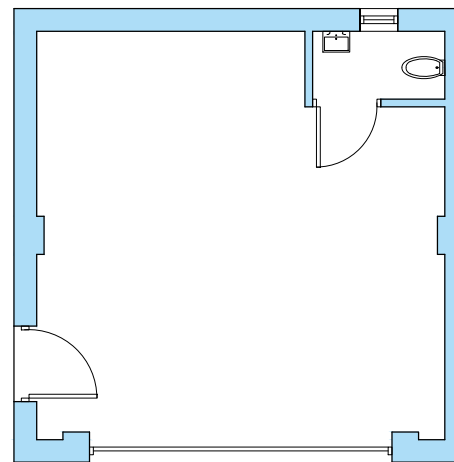

FLOOR PLAN

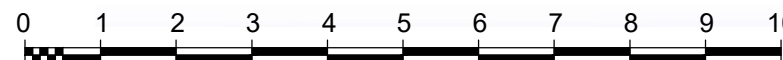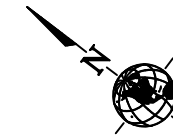

1:100



T: 01995 604514
E: info@GrahamAnthonyAssociates.com
W: www.GrahamAnthonyAssociates.com

2 CROSTON VILLA
HIGH STREET
GARSTANG
PRESTON
PR3 1EA

CLIENT
BRANLEIGH HOMES LTD

DWG STATUS
AS BUILT

DRAWING TITLE / PROJECT
VEHICLE DEPOT PLANS & ELEVATIONS
DEVELOPMENT OF LAND OFF DIXON
ROAD, LONGRIDGE, PRESTON PR3 3JE

DRAWING No. GA3057-002C

SCALE(S)
1:100 (A4)

DATE
JULY '21

ALL DIMENSIONS TO BE CHECKED ON SITE AND ANY DISCREPANCIES TO BE REPORTED TO GRAHAM ANTHONY ASSOCIATES PRIOR TO PROCEEDING WITH ANY WORKS. DO NOT SCALE OFF DRAWING AND REFER TO WRITTEN DIMENSIONS.
THIS DRAWING IS SUBJECT TO COPYRIGHT ©