




Ground Floor Plan

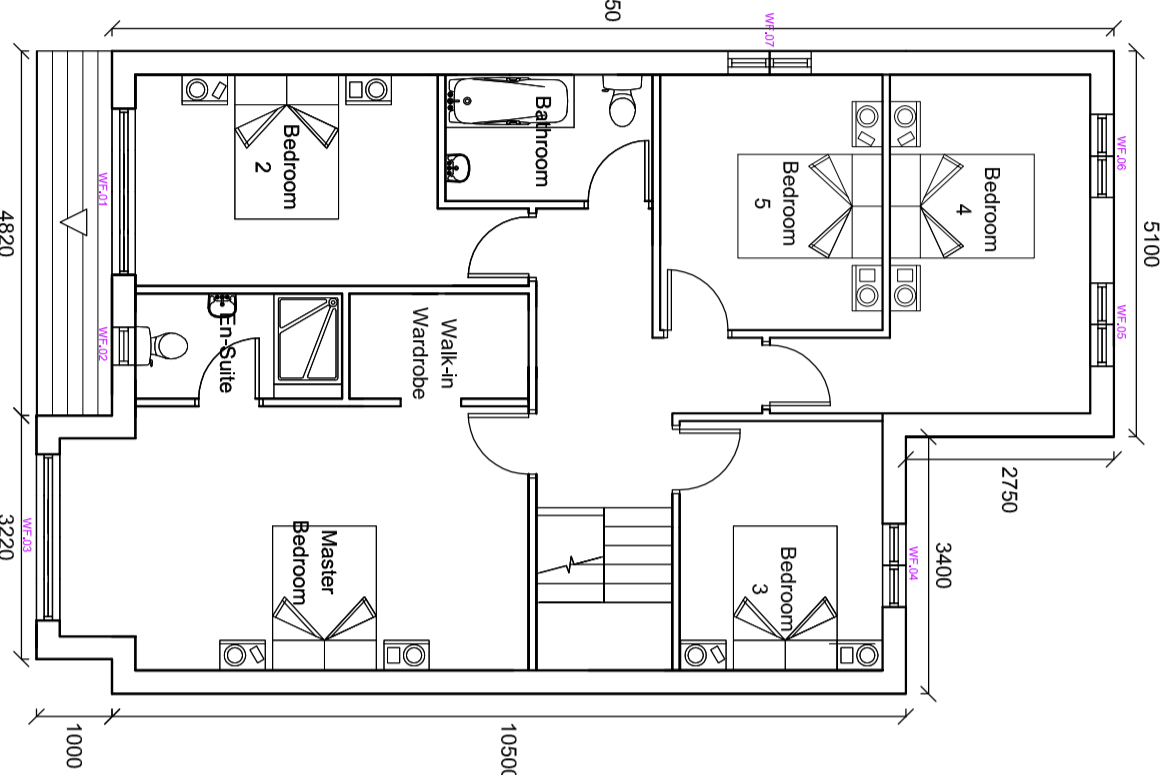


First Floor Plan

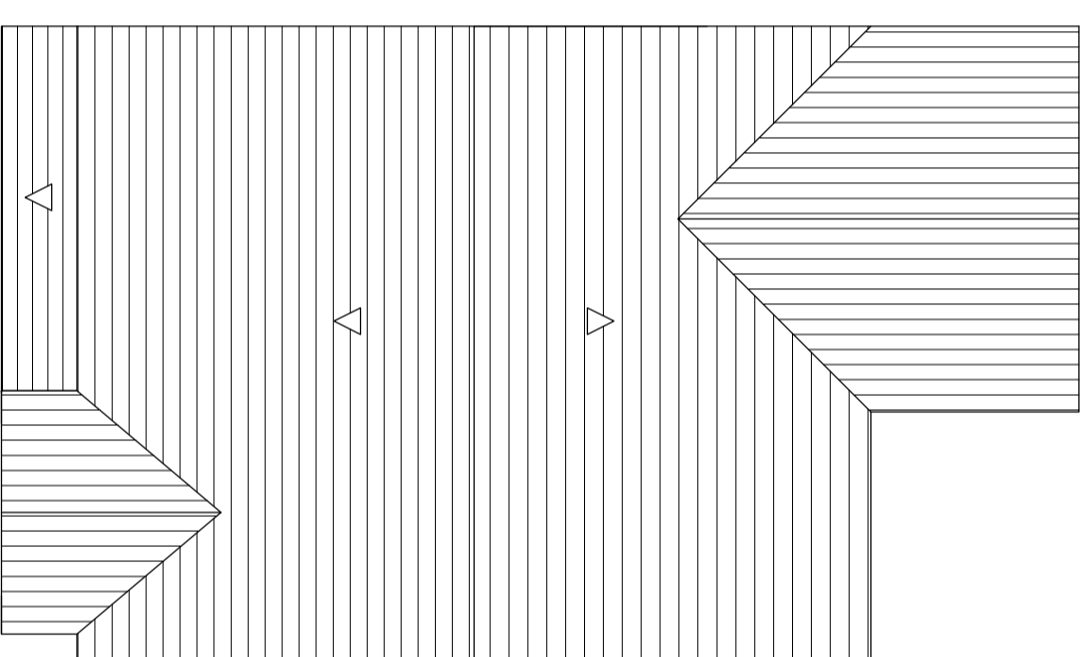


Roof Plan

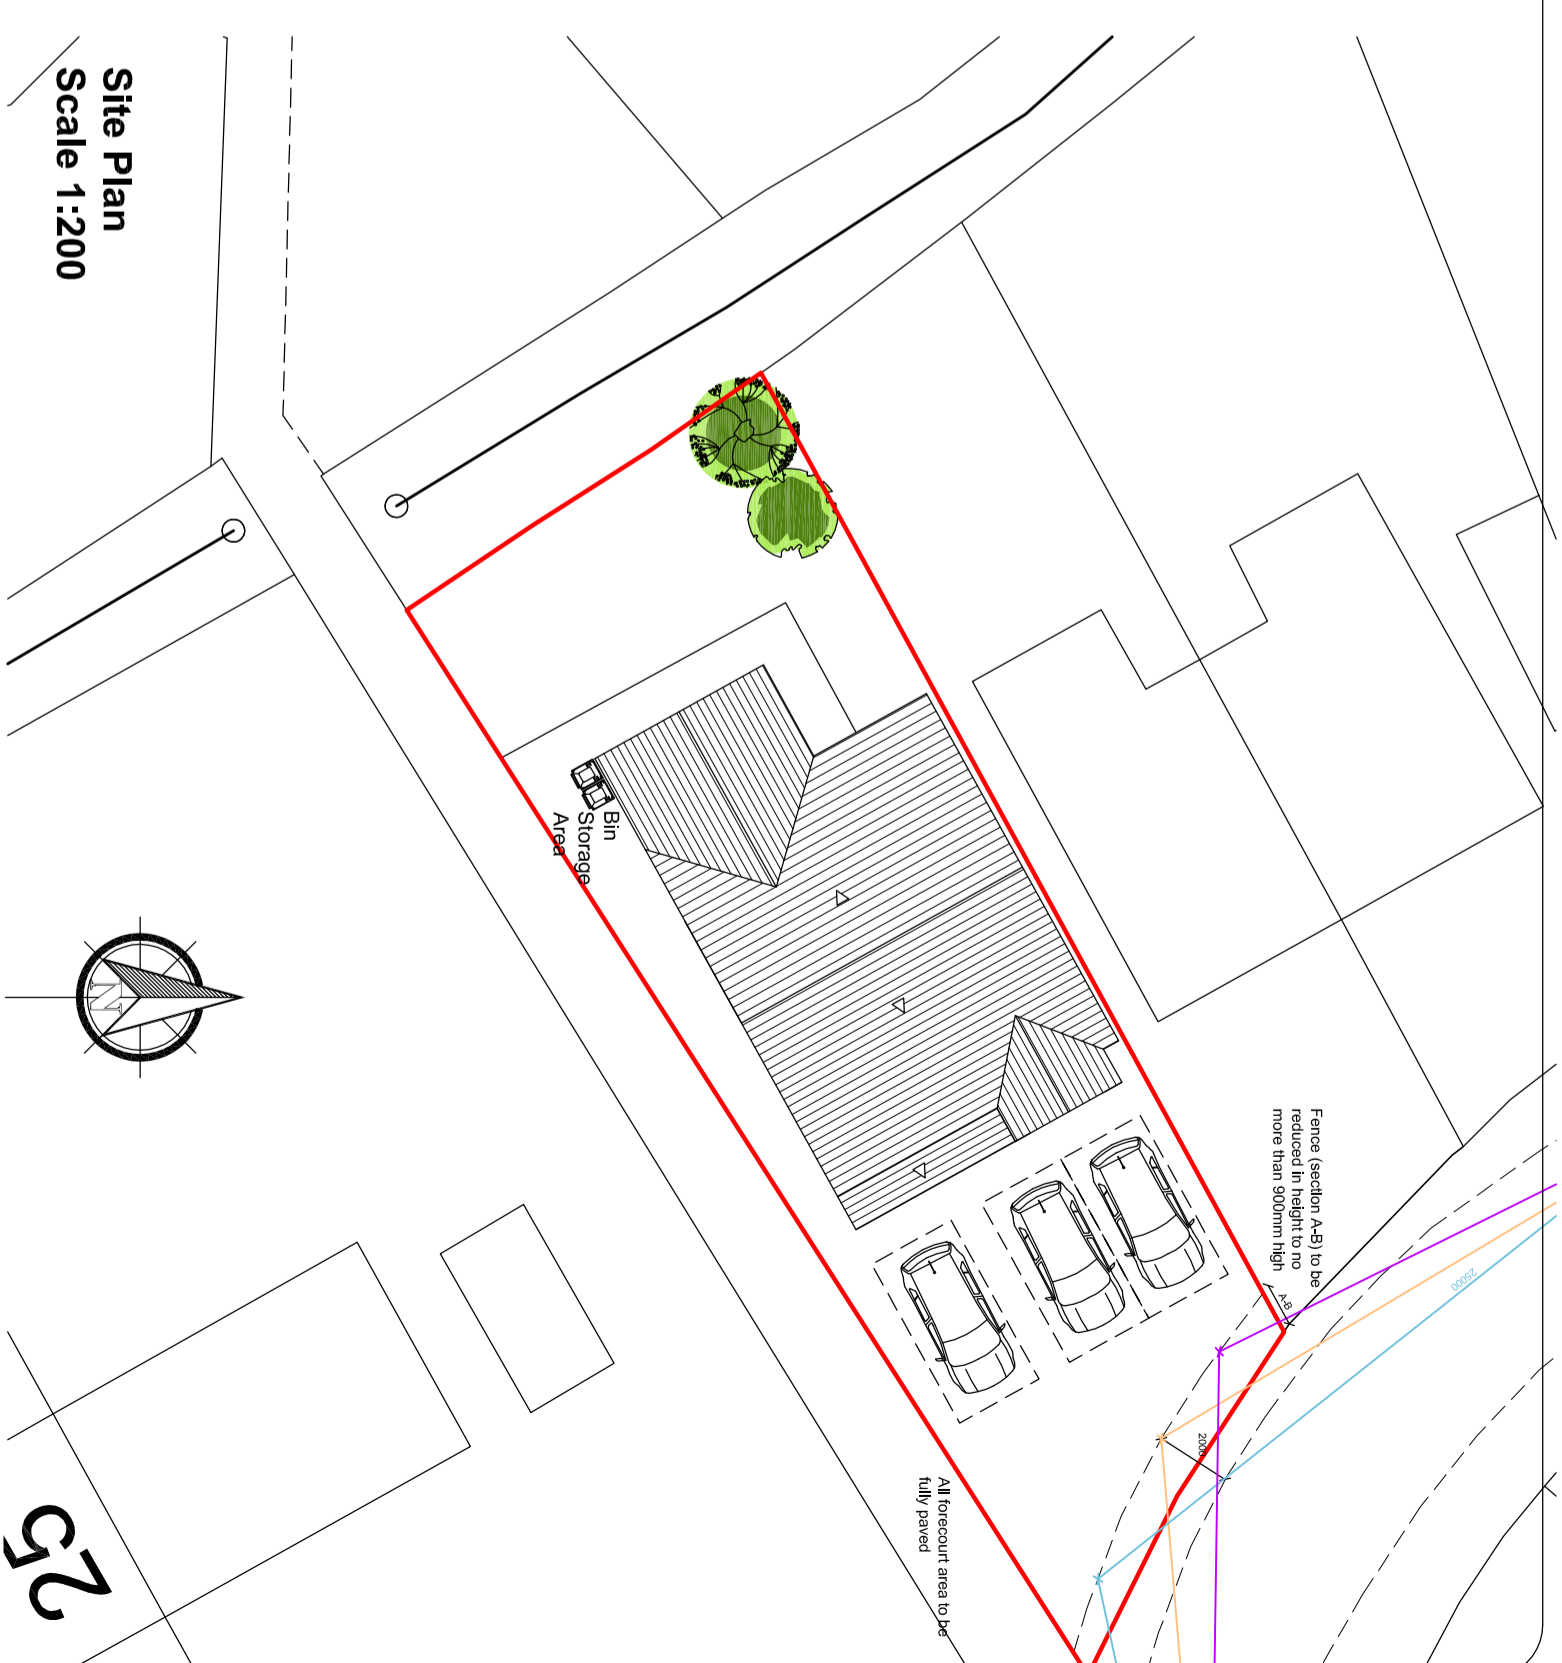


Site Plan Scale 1:200

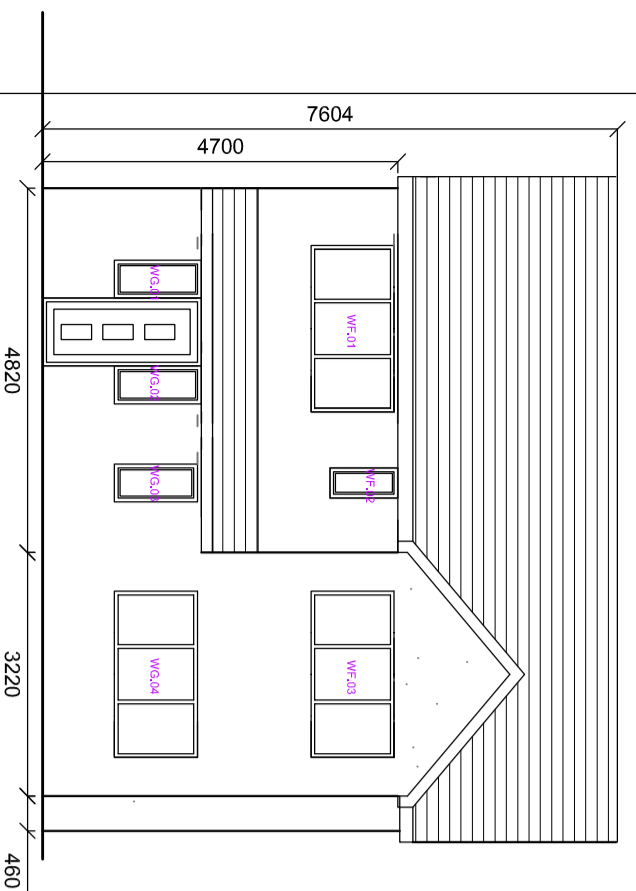


Front (North East) Elevation

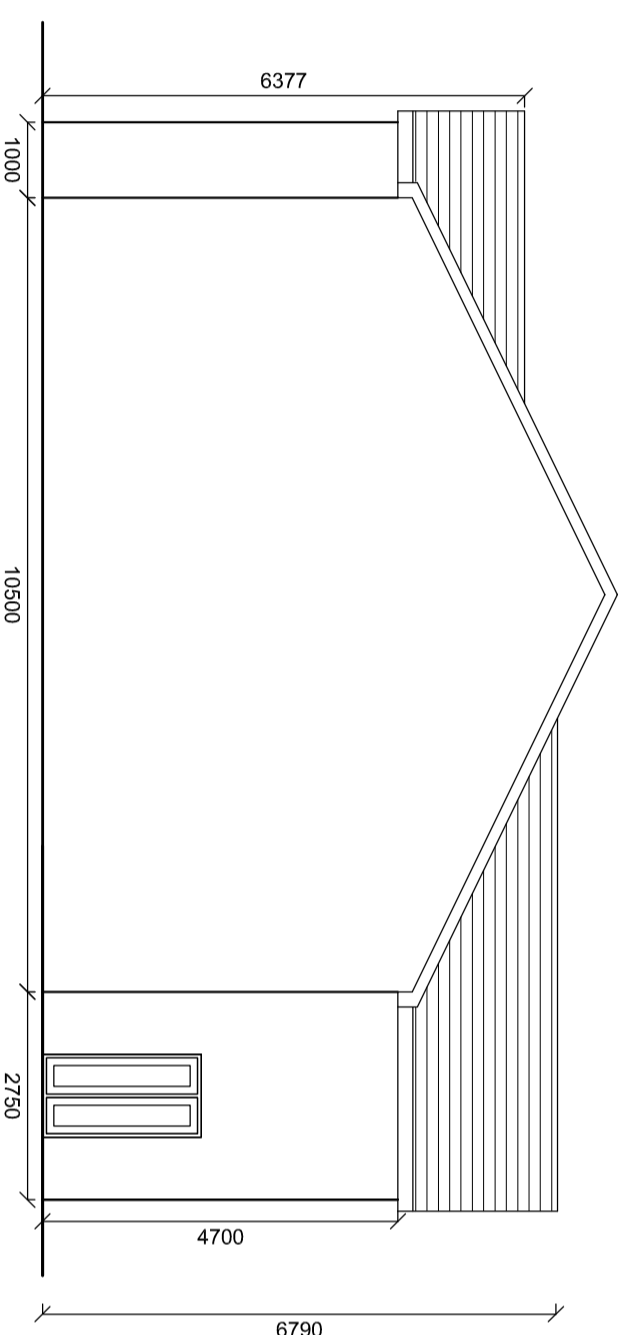

Side (North West) Elevation

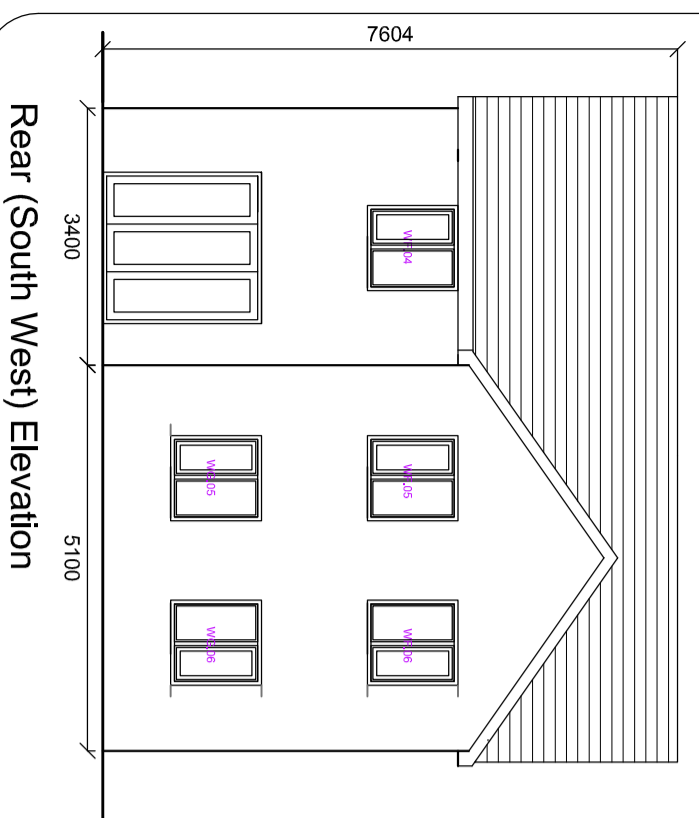

Rear (South West) Elevation

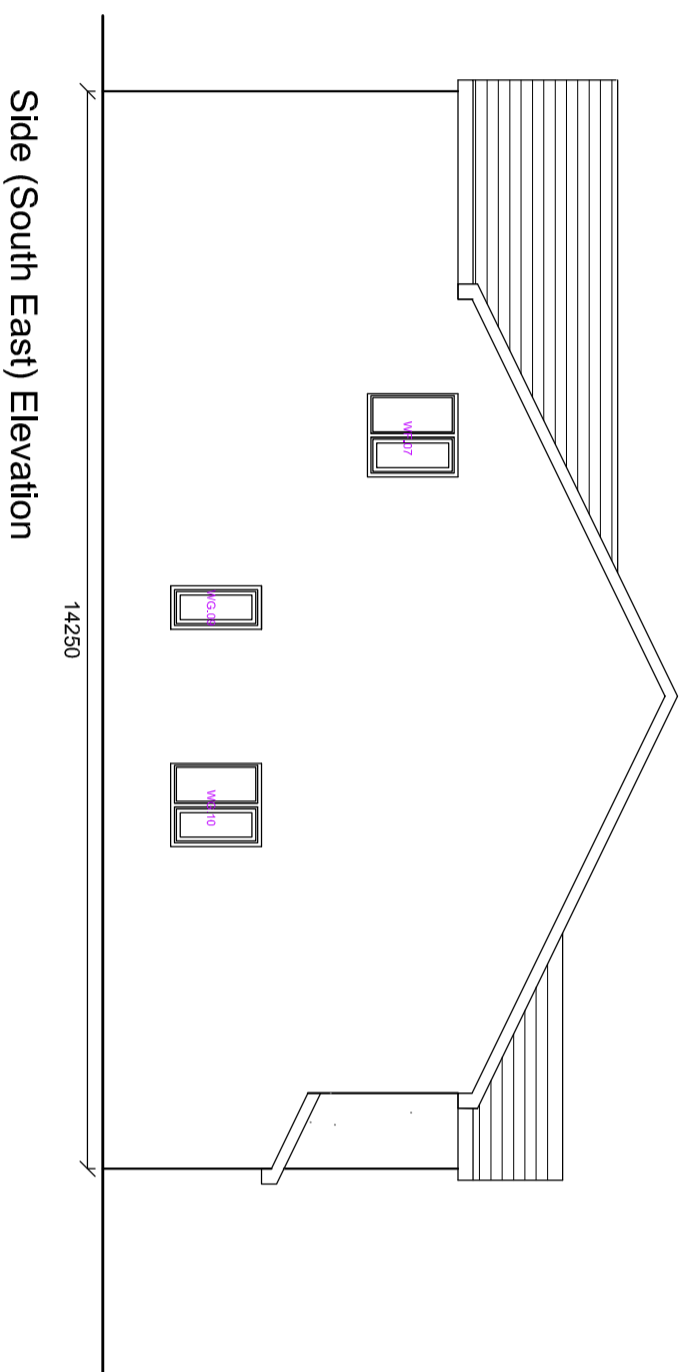

Side (South East) Elevation

Proposed Window Schedule

Window No.	Location	Size (W x H)
W/C11	Porch	600mm x 1100mm
W/C12	W/C	600mm x 1100mm
W/C13	W/C	600mm x 1100mm
W/C14	Lounge	2200mm x 1100mm
W/C15	Bedroom	1200mm x 1100mm
W/C16	Bedroom	1200mm x 1100mm
W/C17	Bedroom	1200mm x 1100mm
W/C100	Bedroom	1200mm x 1100mm

Notes:

All work is to be carried out to the latest current British standards Codes of Practice and recognised working practices.

All work and materials should comply with Health and Safety legislation and to be approved by the Local Authority Planning / Building Control Officer.

All dimensions are in millimetres unless where explicitly shown otherwise.

The contractor should check and clarify all dimensions as work proceeds and notify the design team of any discrepancies.

Do not scale off the drawings, if in doubt ask.

Avalon Chartered Town Planning are not liable for work undertaken prior to Full Planning Consent and/or Building Regulations Approval

PROPOSED PLANS AND ELEVATIONS

Site: 29 Calder Avenue
Billington
BB7 9ND

Client: Stuart Tydesley - Fiona Tydesley

Date: 22.02.22 Scale: 1:100 @ A2

Project No.: TY/02 Dwg 03C Drawn: DS

Amendments: A B C D E

Town Planning - Architectural Design - Building Regulations - Surveying

2 Reedley Buildings Centre, Redburn Road, Burley, Lancashire, BB10 2TV

Avalon RTPI
Chartered Town Planning

Phone: 01282 834834
Email: sales@avalontownplanning.co.uk
www.avalontownplanning.co.uk

Amendment C: 22.02.22 General Amendments to As Built

Amendment B: 19.04.17 General Amendments to Planning Officers Comments

Amendment A: 28.03.17 General Amendments to Planning Officers Comments

32