

Proposed South Elevation


Proposed North Elevation

Existing Ground Floor Plan

1:100

1:100

1:100

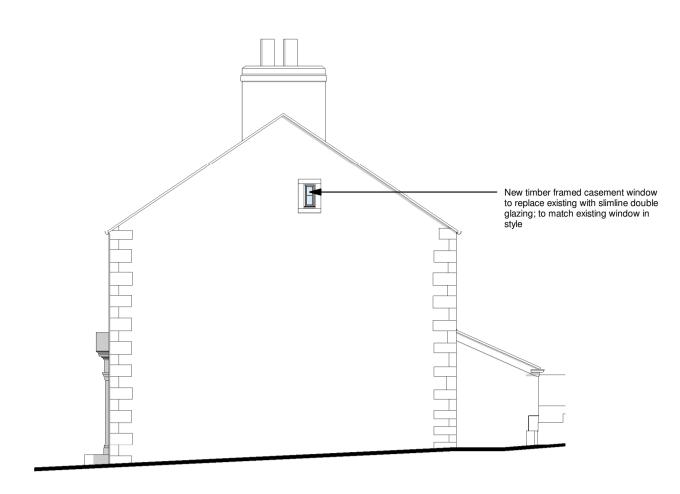

Proposed East Elevation

Proposed West Elevation

1:100


Existing First Floor Plan

1:100


All existing fasais boards and plastic rainwater goods (indicated in red) to north elevation to be replaced with new timber fasais backs alminium guters and downpipes.

All rear windows (indicated in blue) to be replaced with member framed casement windows with almine double glazing, to match existing windows in syle.

Existing timber door to be replaced with member framed coor with similine double glazing, to match existing windows in syle.

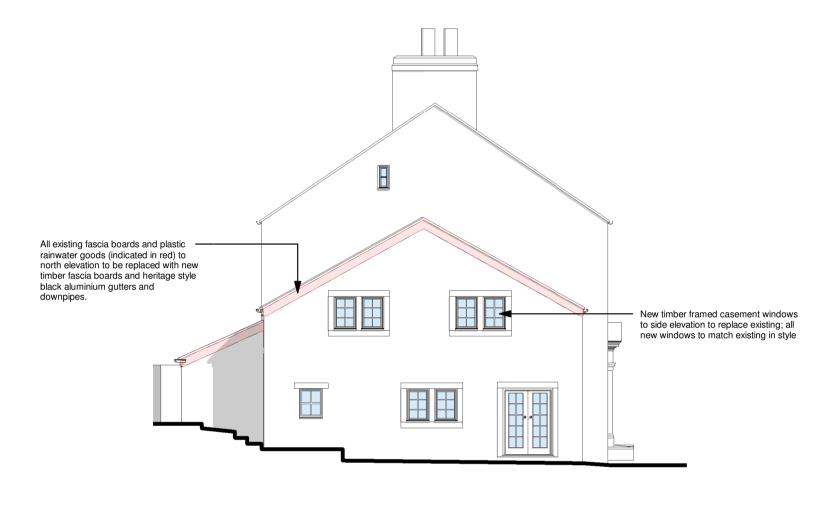

Store Snug Dining All internal doors to be repaired, rehung and redecorated. Kitchen/Dining Lounge Hall Living Living Living Living Living

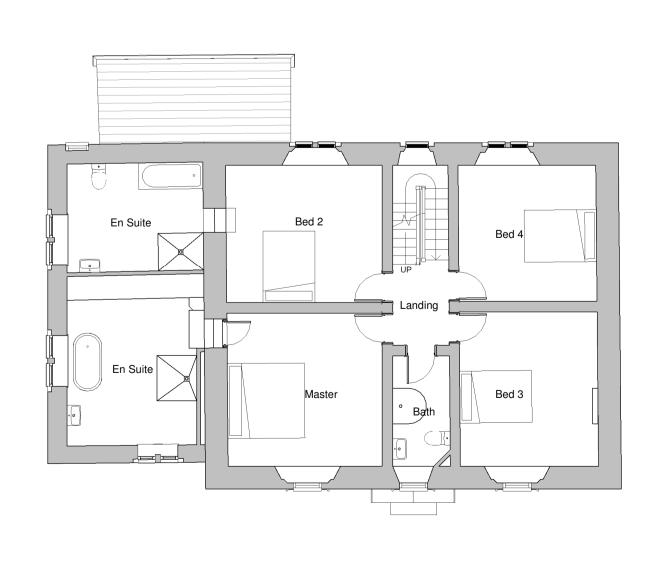

Existing Second Floor Plan
1:100

Attic room
Attic room

REV	DESCRIPTION	DATE	ву	СНК
P01	Minor amendmentts following client	02/02/22	RT	CD
-01	comments	02/02/22		
202	For consultation	11/02/22	RT	CD
03	Planning Issue	18/02/22	RT	CD

NOTES

DO NOT SCALE, USE FIGURED DIMENSIONS ONLY.

ALL DIMENSIONS TO BE VERIFIED ON SITE PRIOR TO THE COMMENCEMENT OF ANY WORK OR THE PRODUCTION OF ANY SHOP DRAWING. ALL DISCREPANCIES TO BE REPORTED TO THE ARCHITECT.

THIS DRAWING IS TO BE READ IN CONJUNCTION WITH ALL RELATED ARCHITECT'S AND ENGINEER'S DRAWINGS AND ANY OTHER RELEVANT INFORMATION.

THIS DRAWING IS COPYRIGHT © OF DWA ARCHITECTS (LONDON) LTD.



dwa

DWA Architects (London) Ltd
Cyclops House
Link Business Park
York
United Kingdom
YO10 3JB
01904 544 400
dwa@dwa-architects.co.uk
www.dwa-architects.co.uk

Mr Damian Hodkinson

Higher Chipping House

DRAWING TITLE

Proposed Plans and Elevations

DRAWING STATUS

PLANNING				
SCALE	DATE			
1 : 100 @ A1	02/01/22			
DRAWN BY	CHECKED BY			
Author	Checker			
JOB NO.	DWG NO.	REV		
SW0142	SK(00)05	P0		