

materials schedule
samples of proposed materials to be provided on request

- walls

roof

windows
- natural stone and timber cladding

slate roof tiles, to match existing

polyester powder coated aluminium

Stanton Andrews do not accept liability for any loss or degradation of information held in the drawing resulting from the translation from the original file format to any other file format or from the recipient reading of it in any other programme or an earlier version of the programme. Stanton Andrews accepts no liability for use of this drawing by parties other than the party for whom it was prepared or for purposes other than those for which it was prepared.

DWG issues - when this drawing is issued in DWG format it is an uncontrolled version and is provided to enable the recipient to prepare its own documents/drawings for which it is solely responsible. It is based on background information current at the time of issue. Stanton Andrews accepts no liability for any alterations, additions to or discrepancies arising out of changes to such background information which occur after it has been issued by Stanton Andrews.


This drawing must be printed in colour, if this text is not RED the drawing must be reprinted.

Do not scale, use figured dimensions only. All dimensions to be checked on site. This drawing should be printed and read at the original size, as stated in title block. Stanton Andrews accept no responsibility for errors that occur as a result of reviewing this drawing at any other size. Stanton Andrews to be notified of any discrepancies before proceeding.

Drawing is to be read in conjunction with all relevant consultants and specialists drawings. 'As existing' drawings based on information provided by others - no measured survey of the property has been undertaken by the architect. This drawing is subject to copyright.


revision	date	note
A	13.05.21	planning application
B	18.03.22	planning application
C	05.05.2022	planning application

north elevation

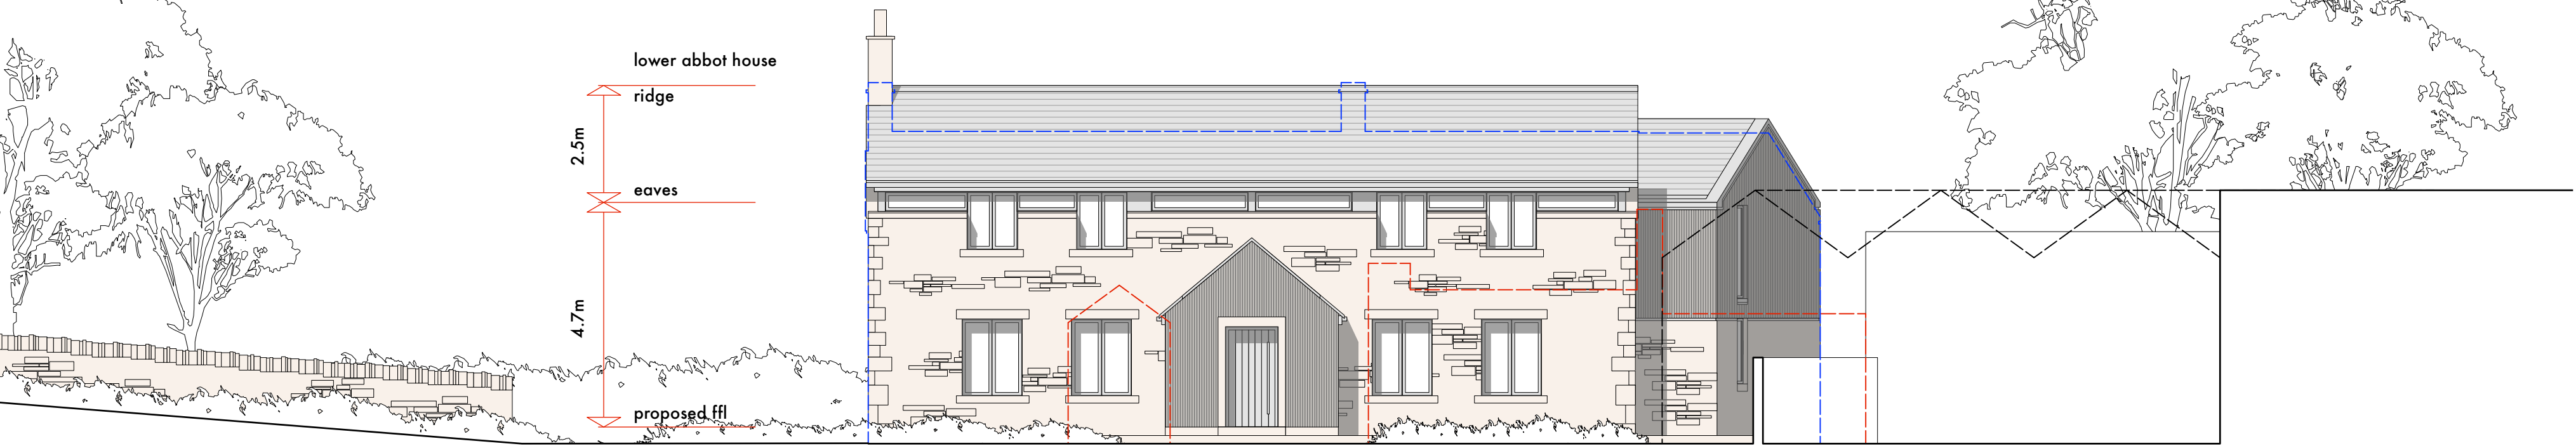


broken red line indicates profile of existing porch - to be replaced
broken blue line indicates profile of previously approved scheme

south elevation

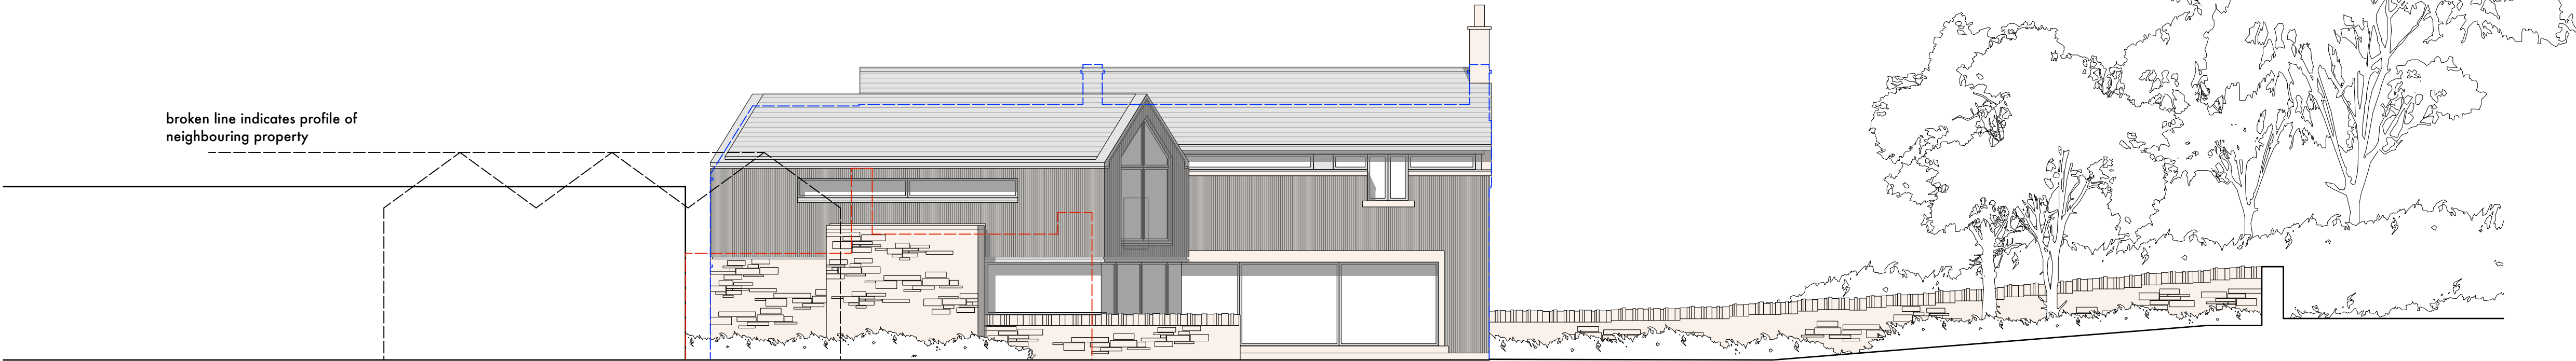


broken red line indicates profile of existing outbuildings - to be removed

east elevation

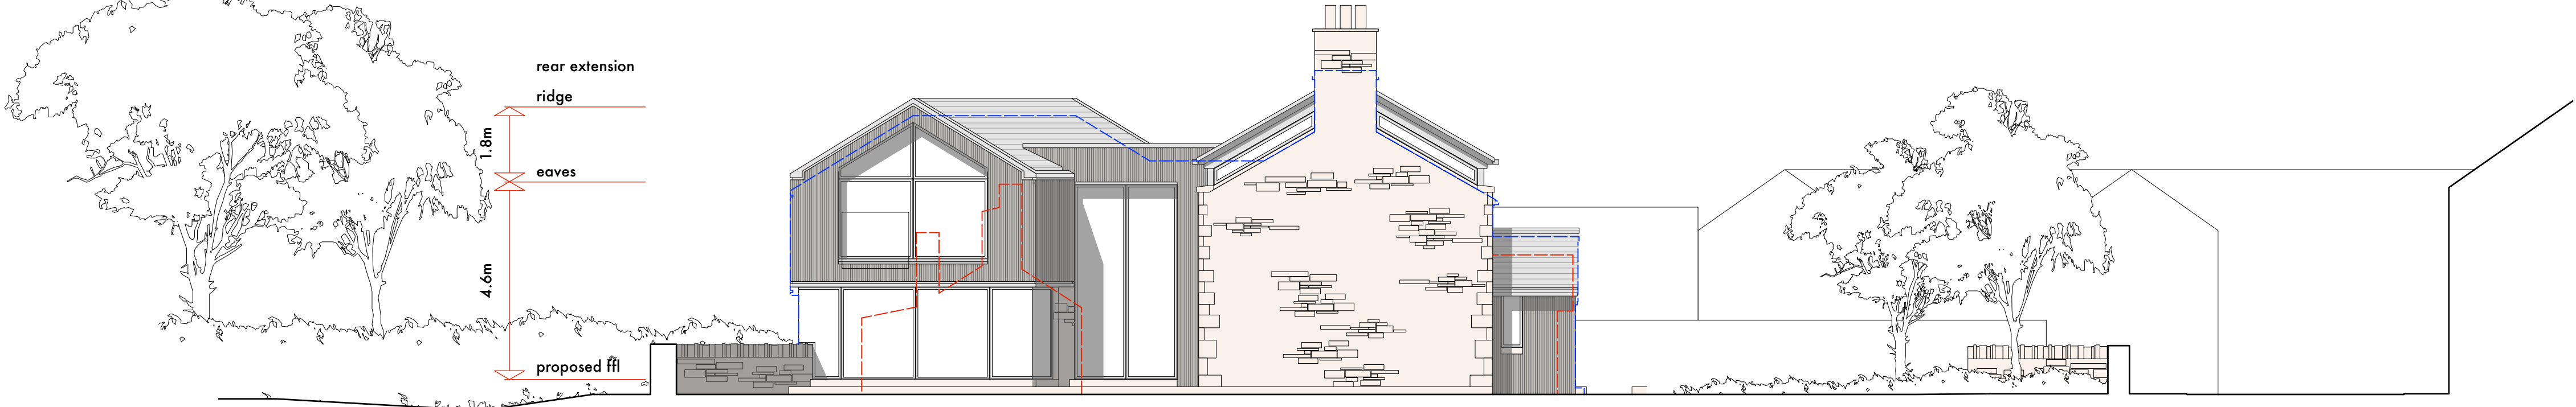

rear extension
ridge
eaves
proposed ffl

west elevation

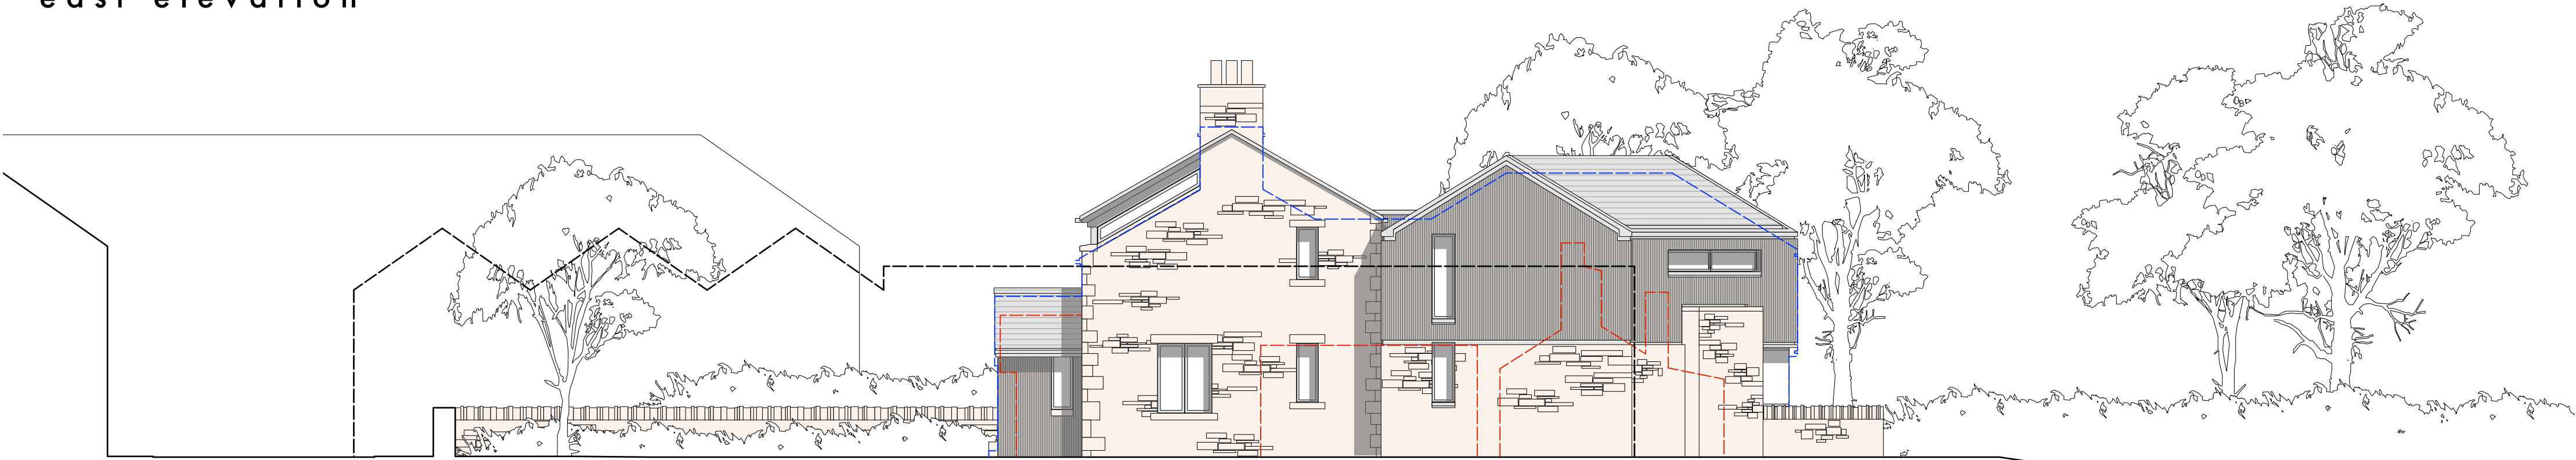

windows to west elevation to be fitted with obscure glazing

0m 10m scale

SA

stanton andrews architects

44 york street clitheroe BB7 2DL

t. 01200 444490 e. mail@stantonandrews.co.uk w. stantonandrews.co.uk

project

lower abbott house

project number

20.80

name

proposed elevations

scale

1 to 100 @ A1

date

may 2021

status

planning

revision

C

Chartered Practice

PL.11

drawing number