


West Elevation
1:50 Scale
Replacement Timber Store - As Built

South Elevation
1:50 Scale

East Elevation
1:50 Scale

North Elevation
1:50 Scale

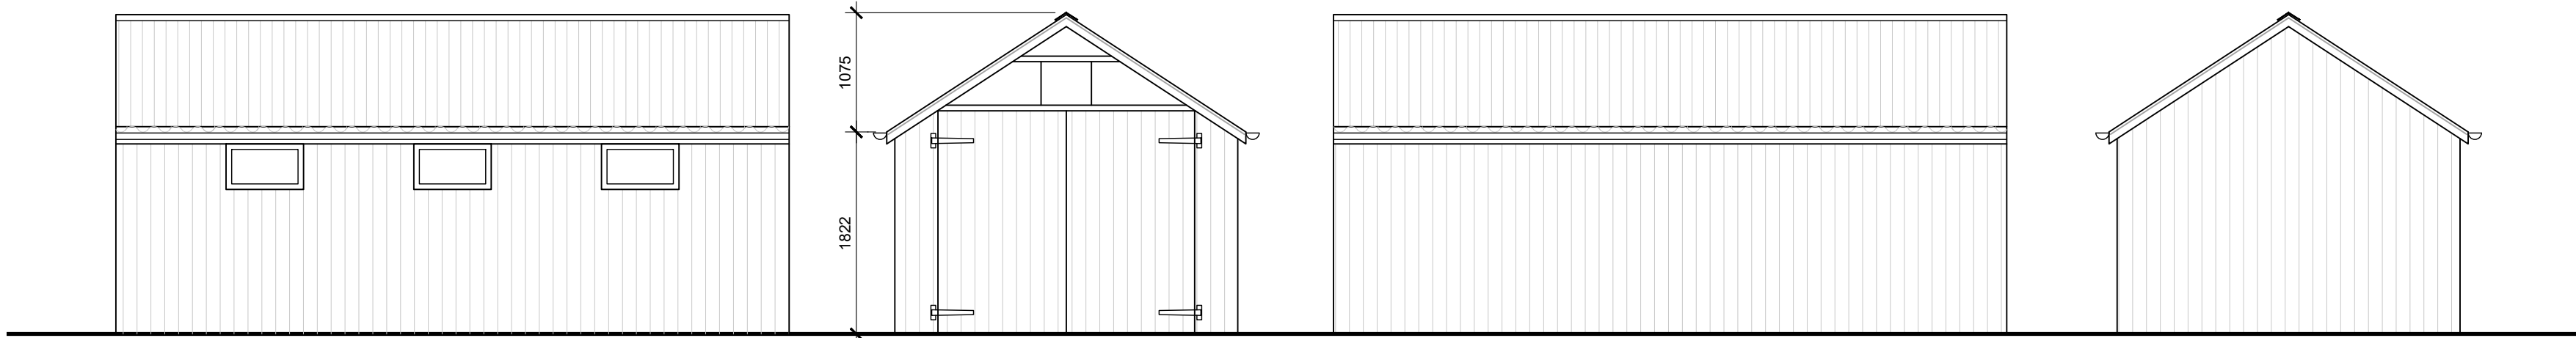


West Elevation
1:50 Scale
Existing Timber Store - To Remain

South Elevation
1:50 Scale

East Elevation
1:50 Scale

North Elevation
1:50 Scale

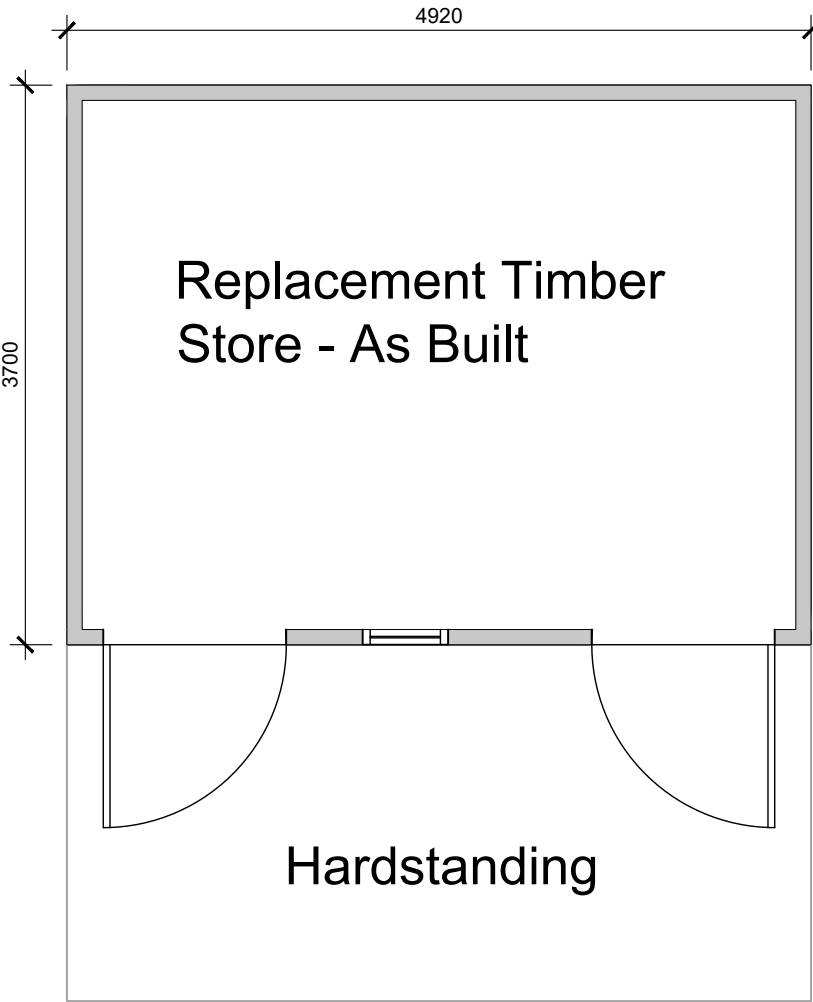

Ground Floor Plans
1:50 Scale



0 2 4 6 8 10 12m
1:200 Scale

Site Plan
1:200 Scale

rev	date/mtis	description	
project			
Retrospective Application for Replacement Timber Store (Replacing Previous Store)			
drawing title			
Mr and Mrs David Smalley Orchard House Orchard Close Grindleton BB7 4RZ			
dwg purpose			
As Built Elevations, Plans and Site Plan			
Harrison Architecture LTD 38 Salthill Road Clitheroe Lancashire BB7 1NU Email: Craig_leigh_harrison@yahoo.co.uk Mobile: 07539 302831			
scale	1:50 and 1:200	001	
© sheet size	A1	drawing number	revision