


THE MANOR HOUSE, CLITHEROE


RevNo	Revision note	Date	Signature	Checked
A	- Design of Dormers amended for planners	23.05.23		
B	- Further amendments for planners	19.06.23		
C	- Red line amended to suit reduced scheme	14.07.23		



IDENTIFICATION OF PROPOSED ALTERATIONS
FIRST FLOOR 1:100

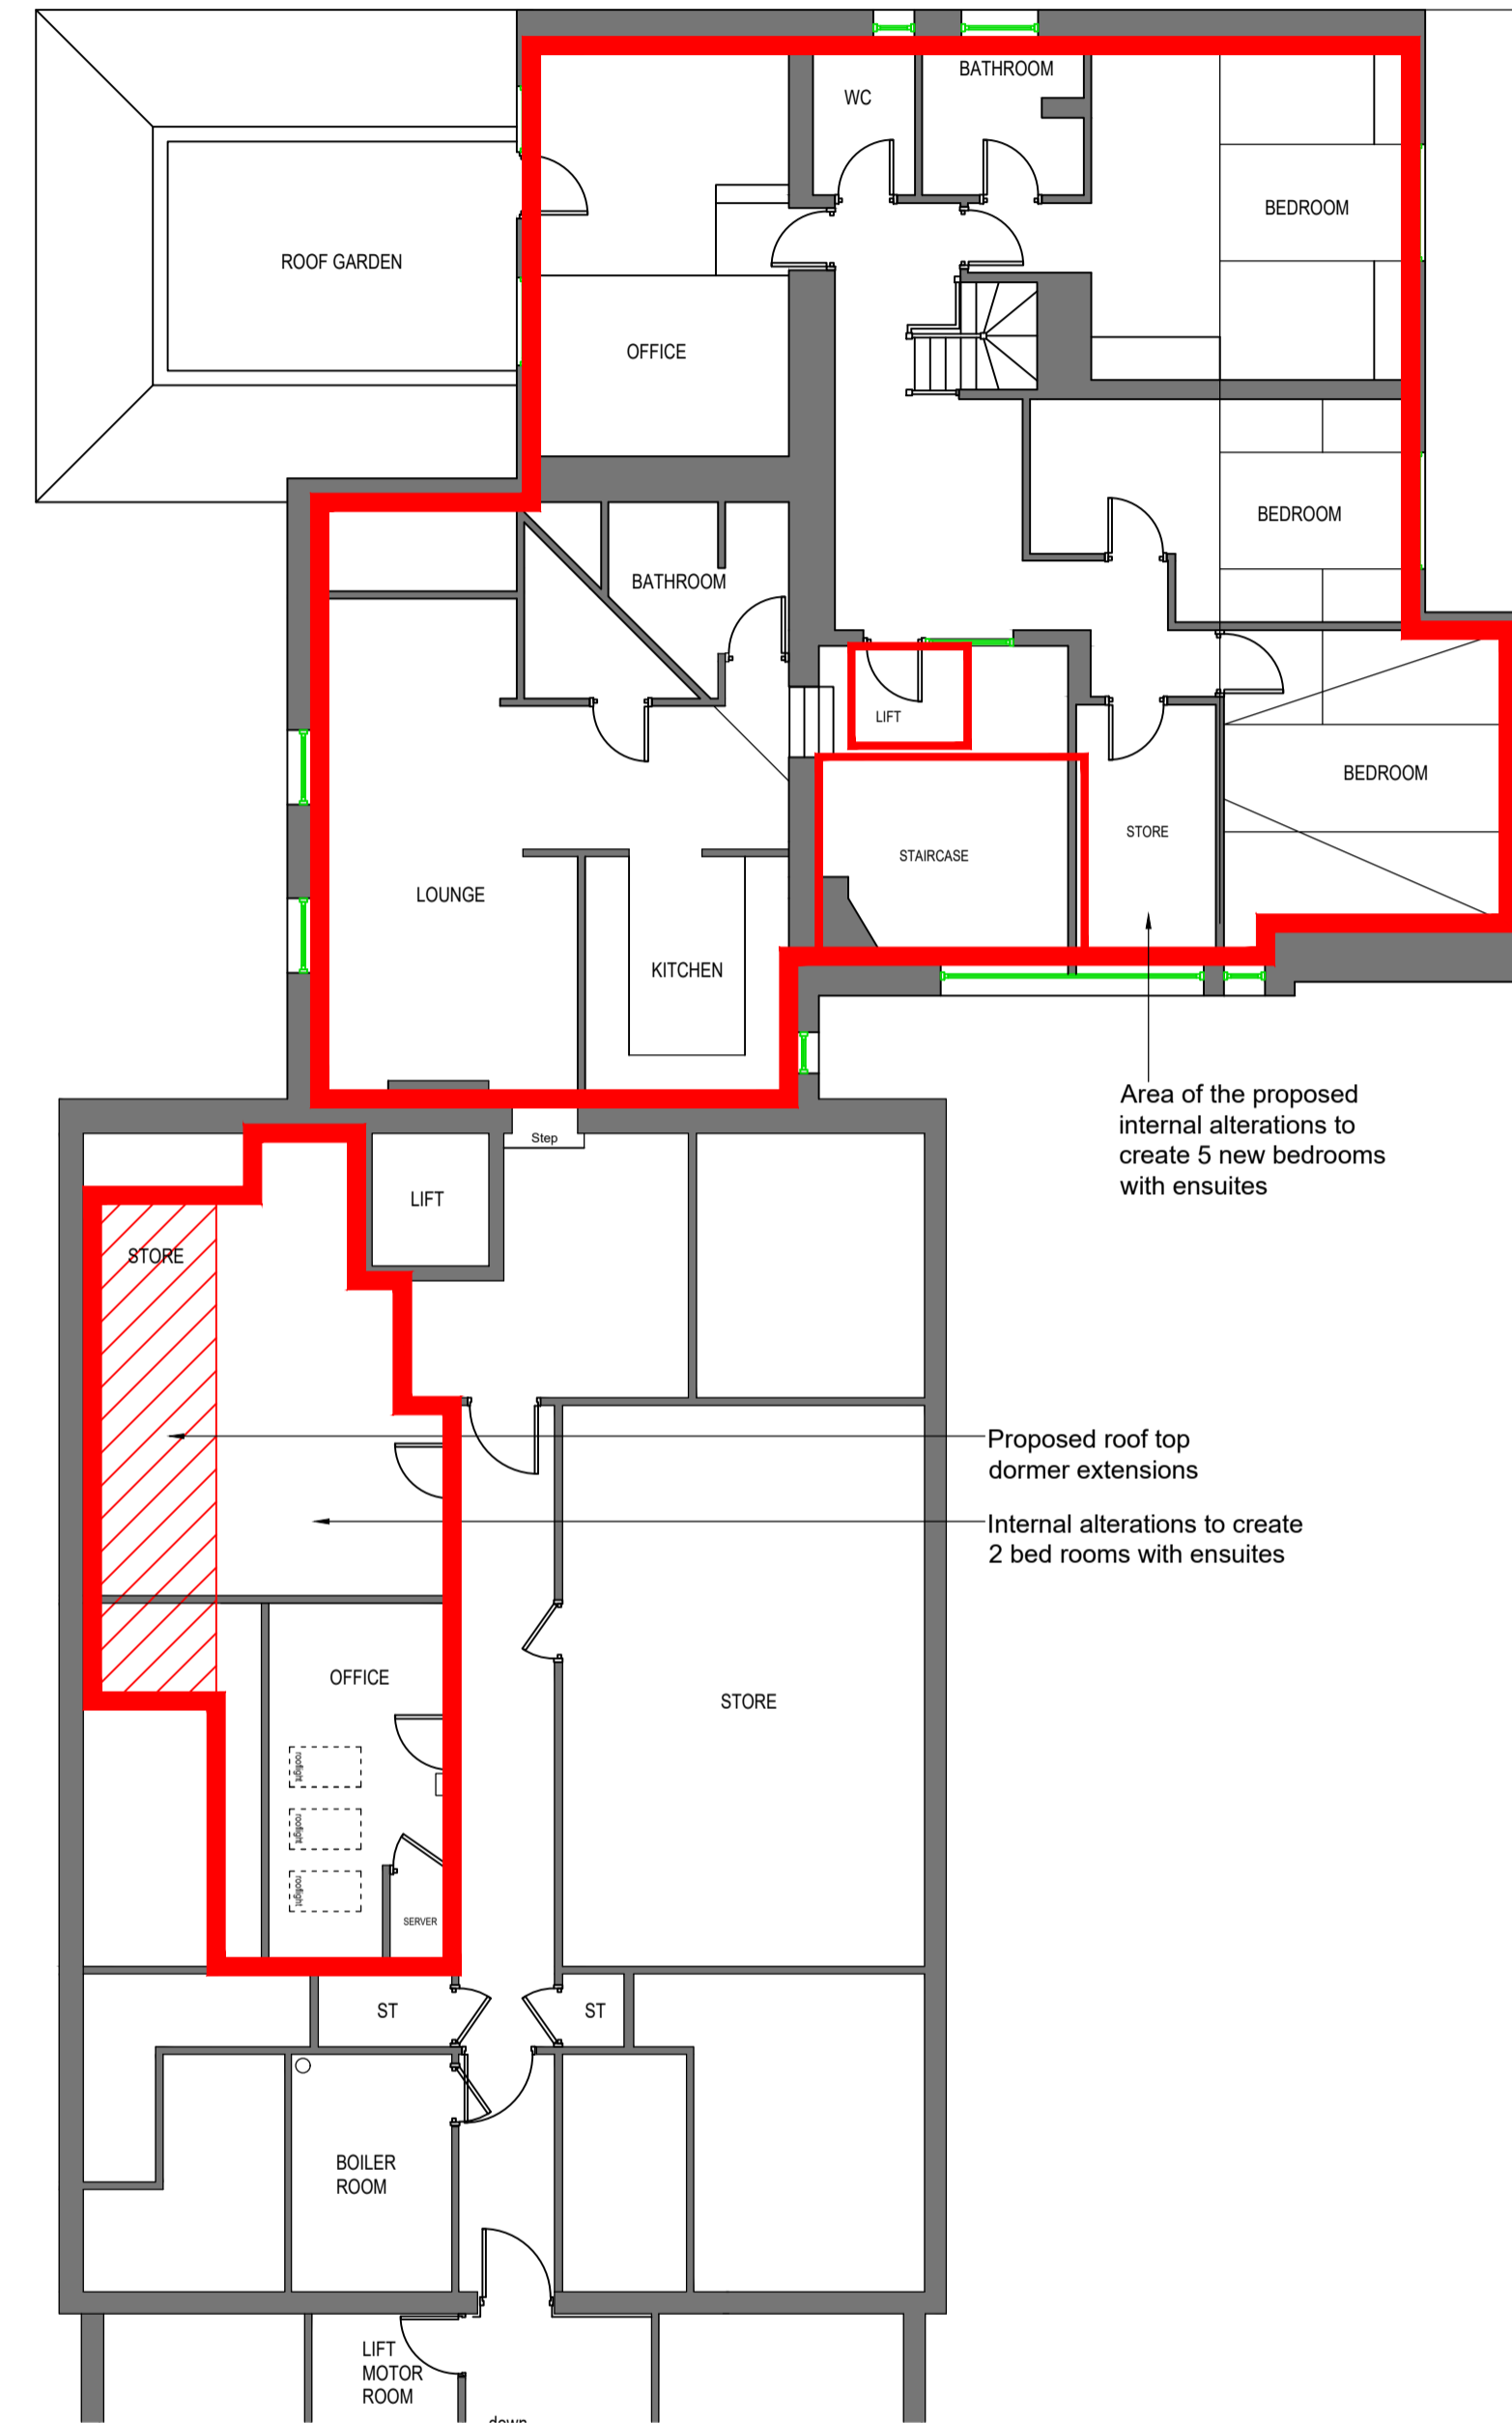

IDENTIFICATION OF PROPOSED ALTERATIONS
SECOND FLOOR 1:100

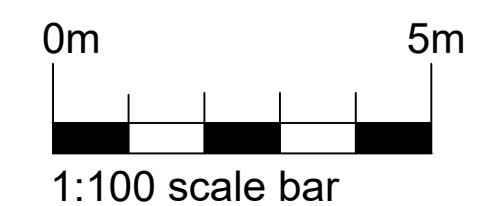

PROJECT:	THE MANOR HOUSE ALTERATIONS THE MANOR HOUSE CARE HOME BRIDGE ROAD CHA TIBURN, CLITHEROE BST 44N	PROJECT NO:	2224-06-105
CLIENT:	BLUE OCEAN CARE LTD	DATE:	SEP 2022
Drawing Title:	LOCATION OF PROPOSED EXTENSION & ALTERATIONS	SCALE:	1:100 @ A1
		REVISION:	C
		DISCIPLINE:	PLANNING

Ranbuzance Studio, No 1 Derry St, Leigh, Lancashire WN7 4PF
Telephone: 01942 423420 Fax: 01942 422244
Email: info@pabarchitects.co.uk www.pabarchitects.co.uk