



SITE LAYOUT PLAN - scale 1:200

Code	Stationing	Height	Number	Notes
NH1	38852.207	441.003	252	
NH2	38856.445	441.003	252	
NH3	38862.513	441.003	251	


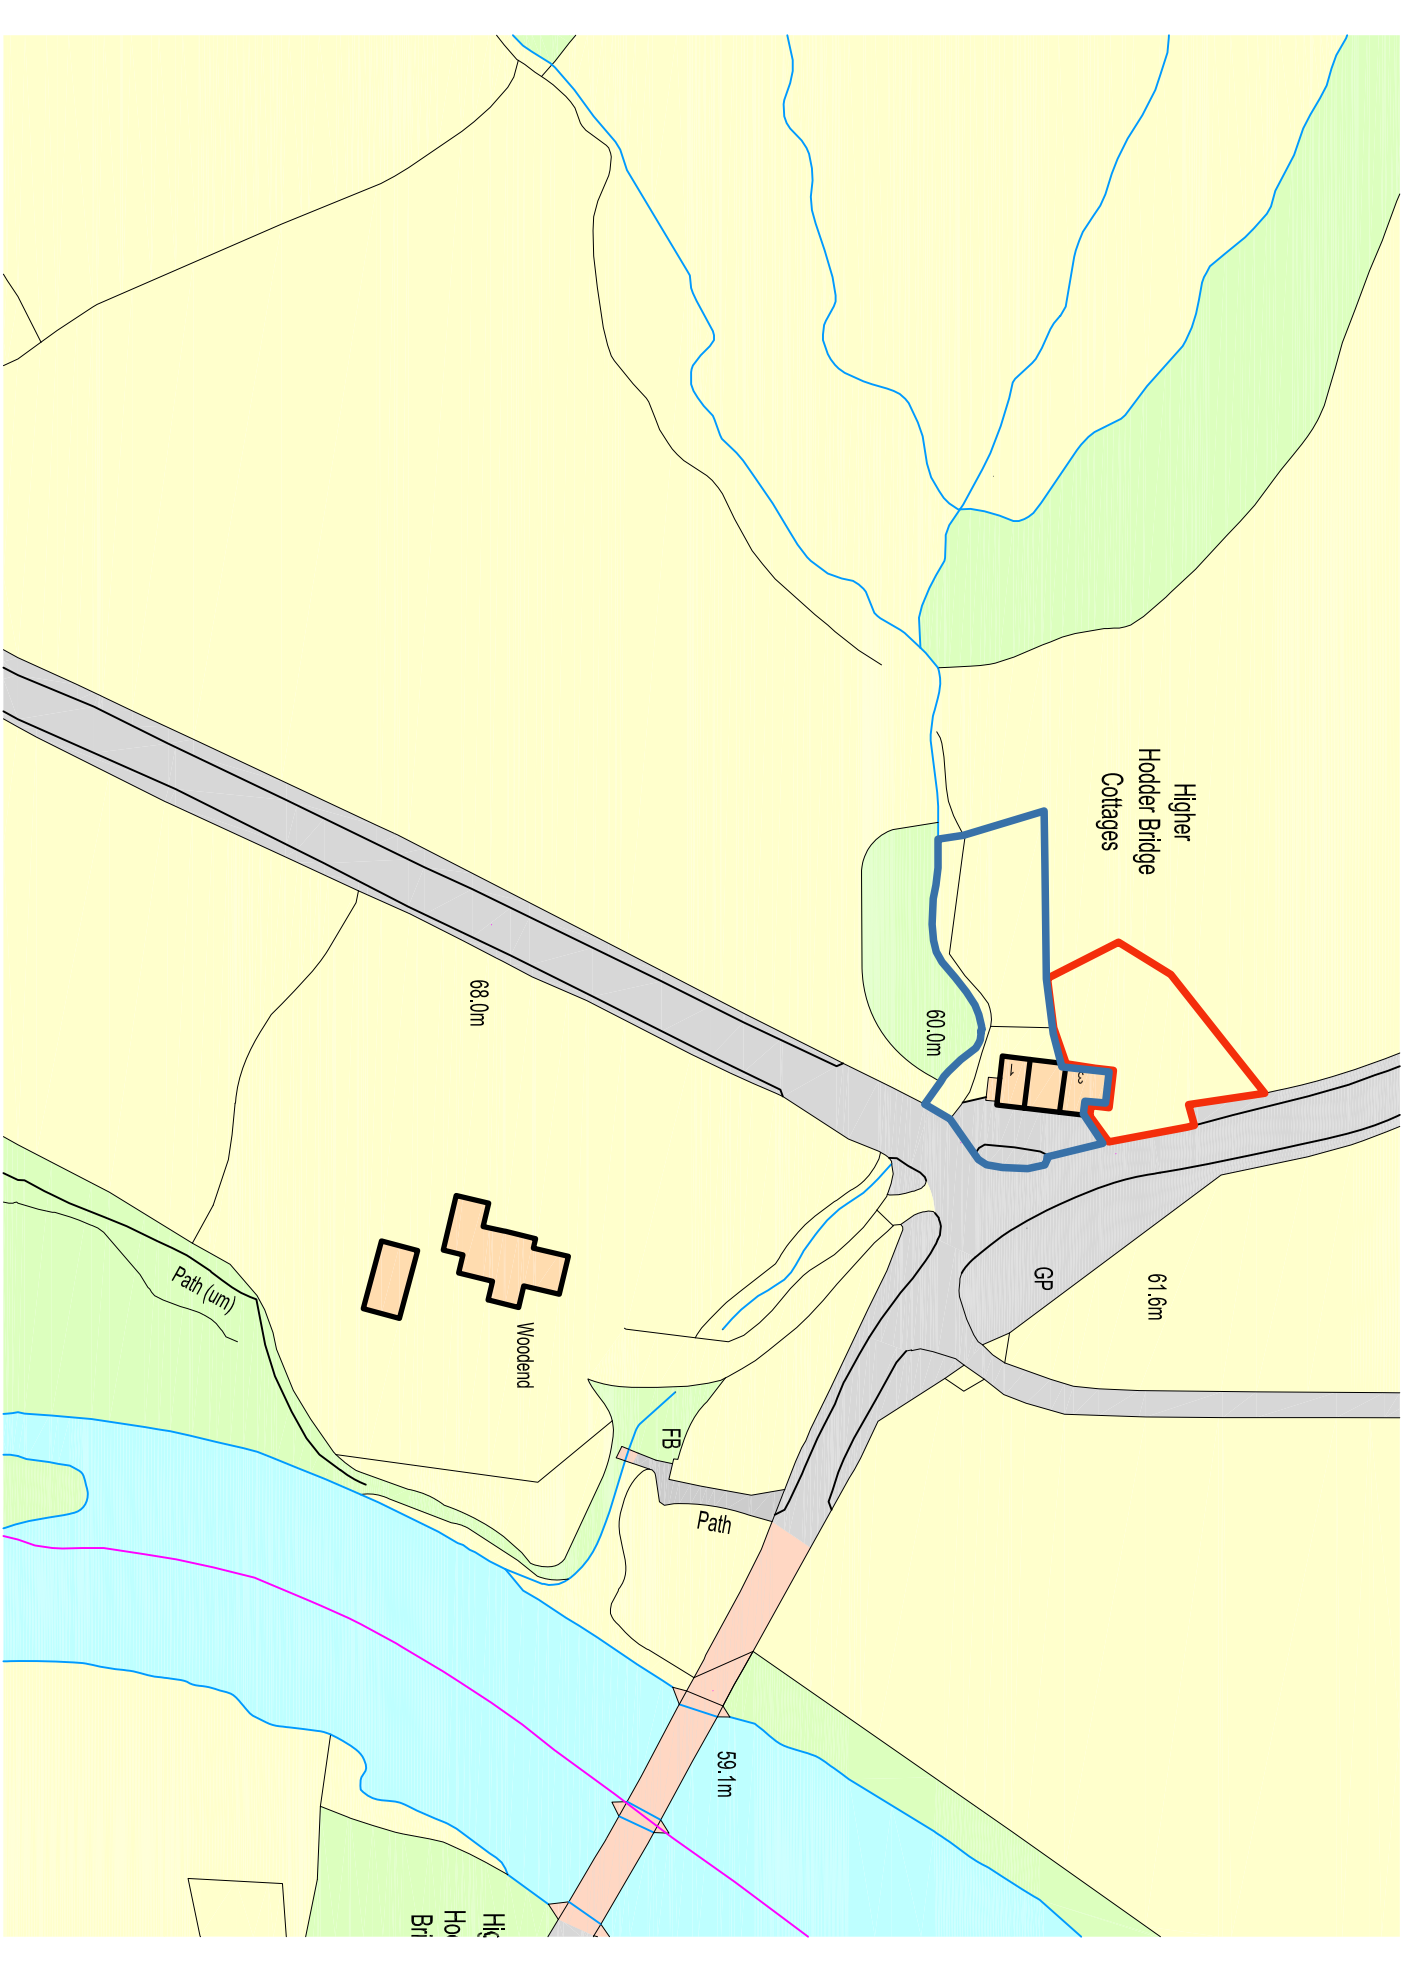


SITE LOCATION PLAN - scale 1:1250

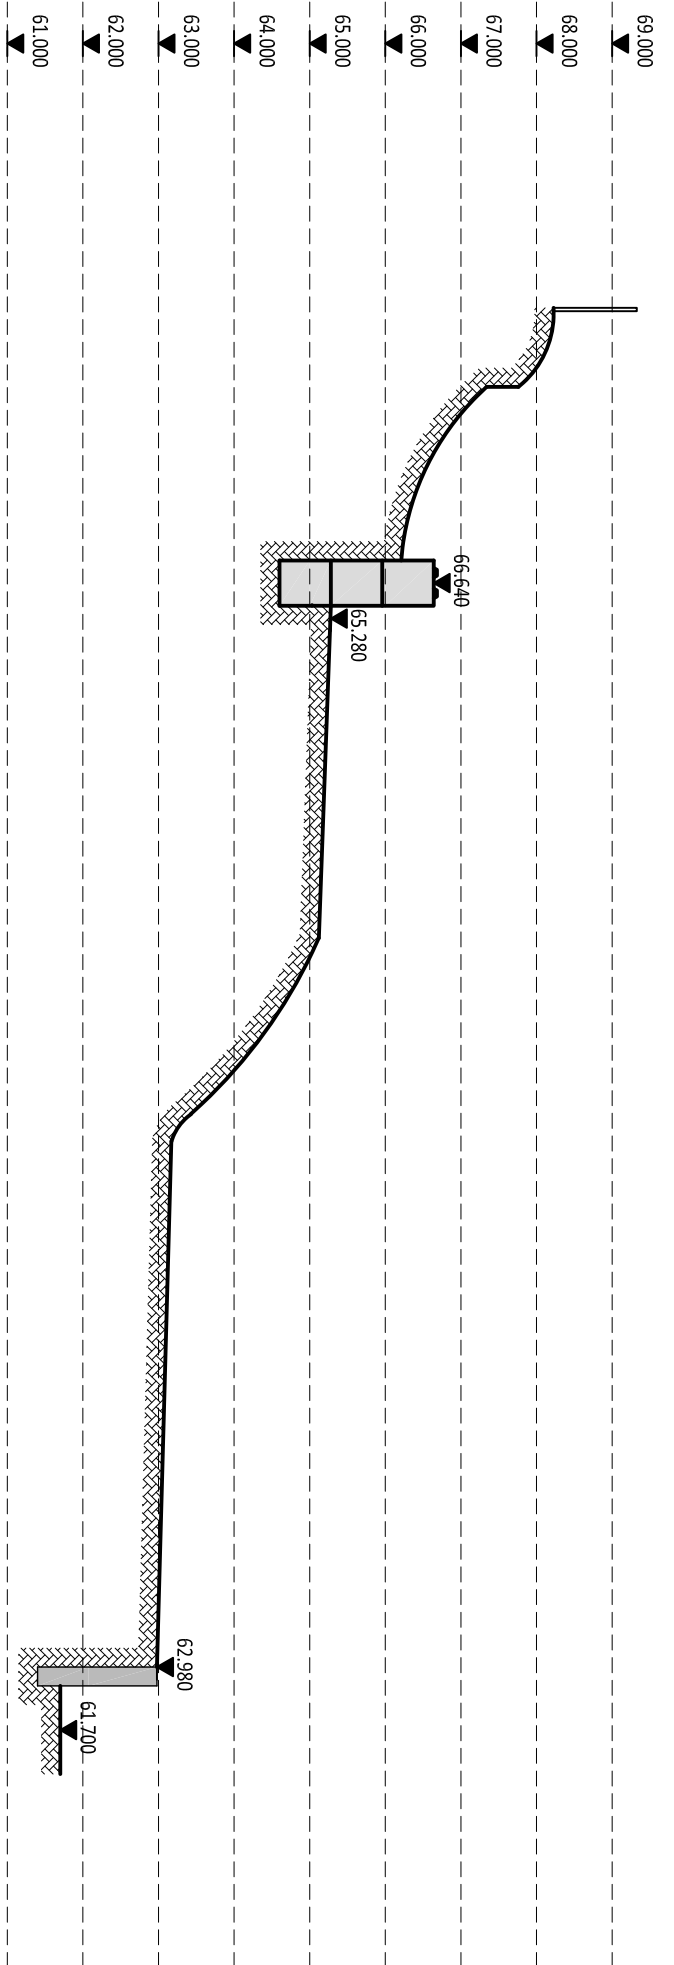


SECTION 200 - as installed

SCALE 1:100

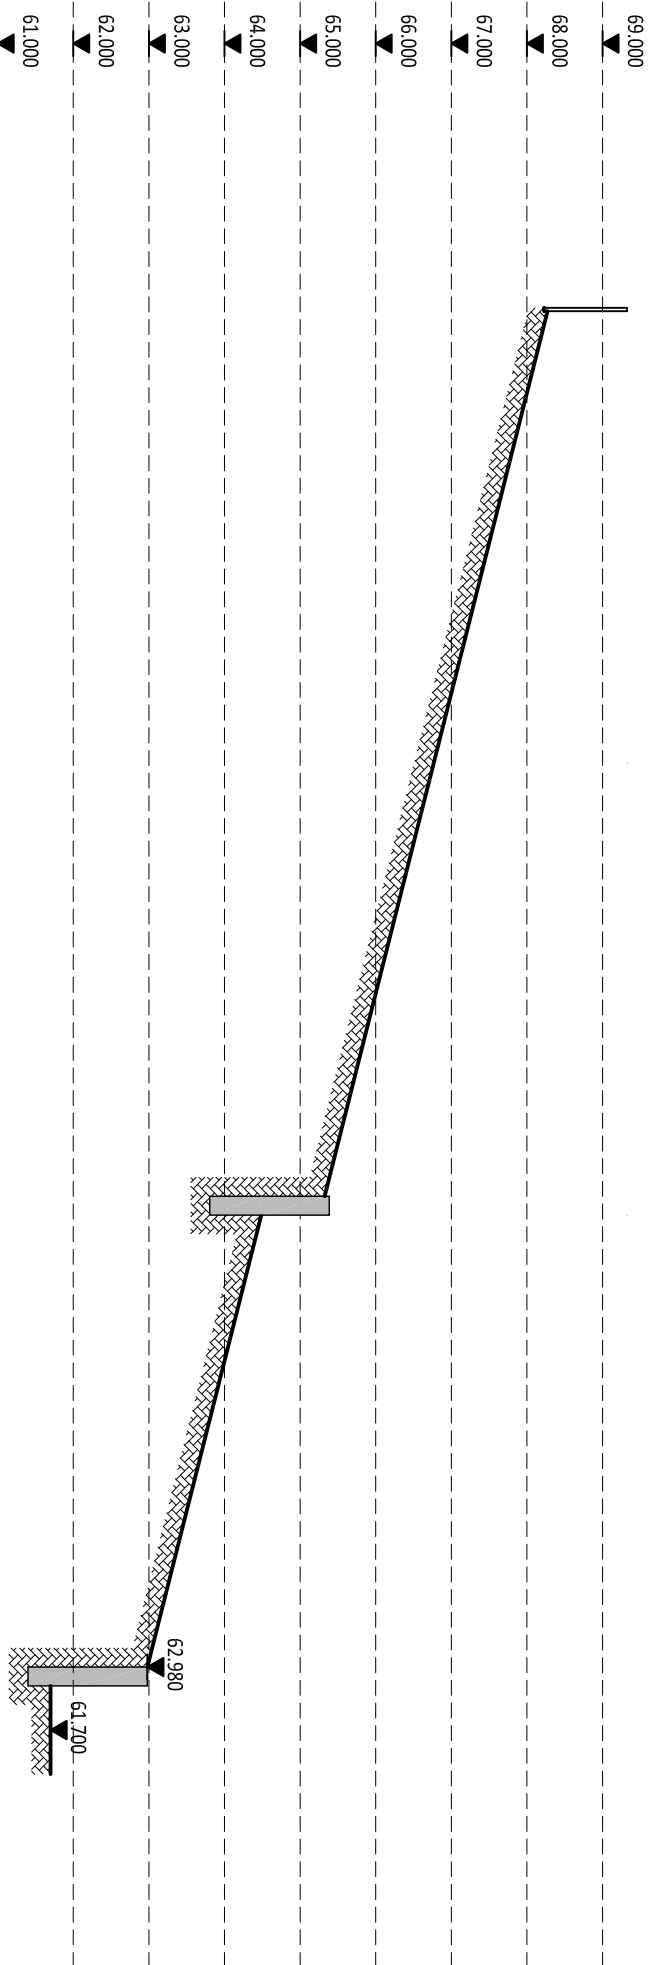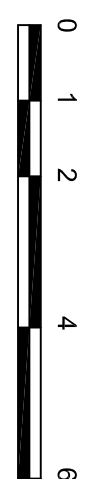



SECTION 200 - previous

SCALE 1:100

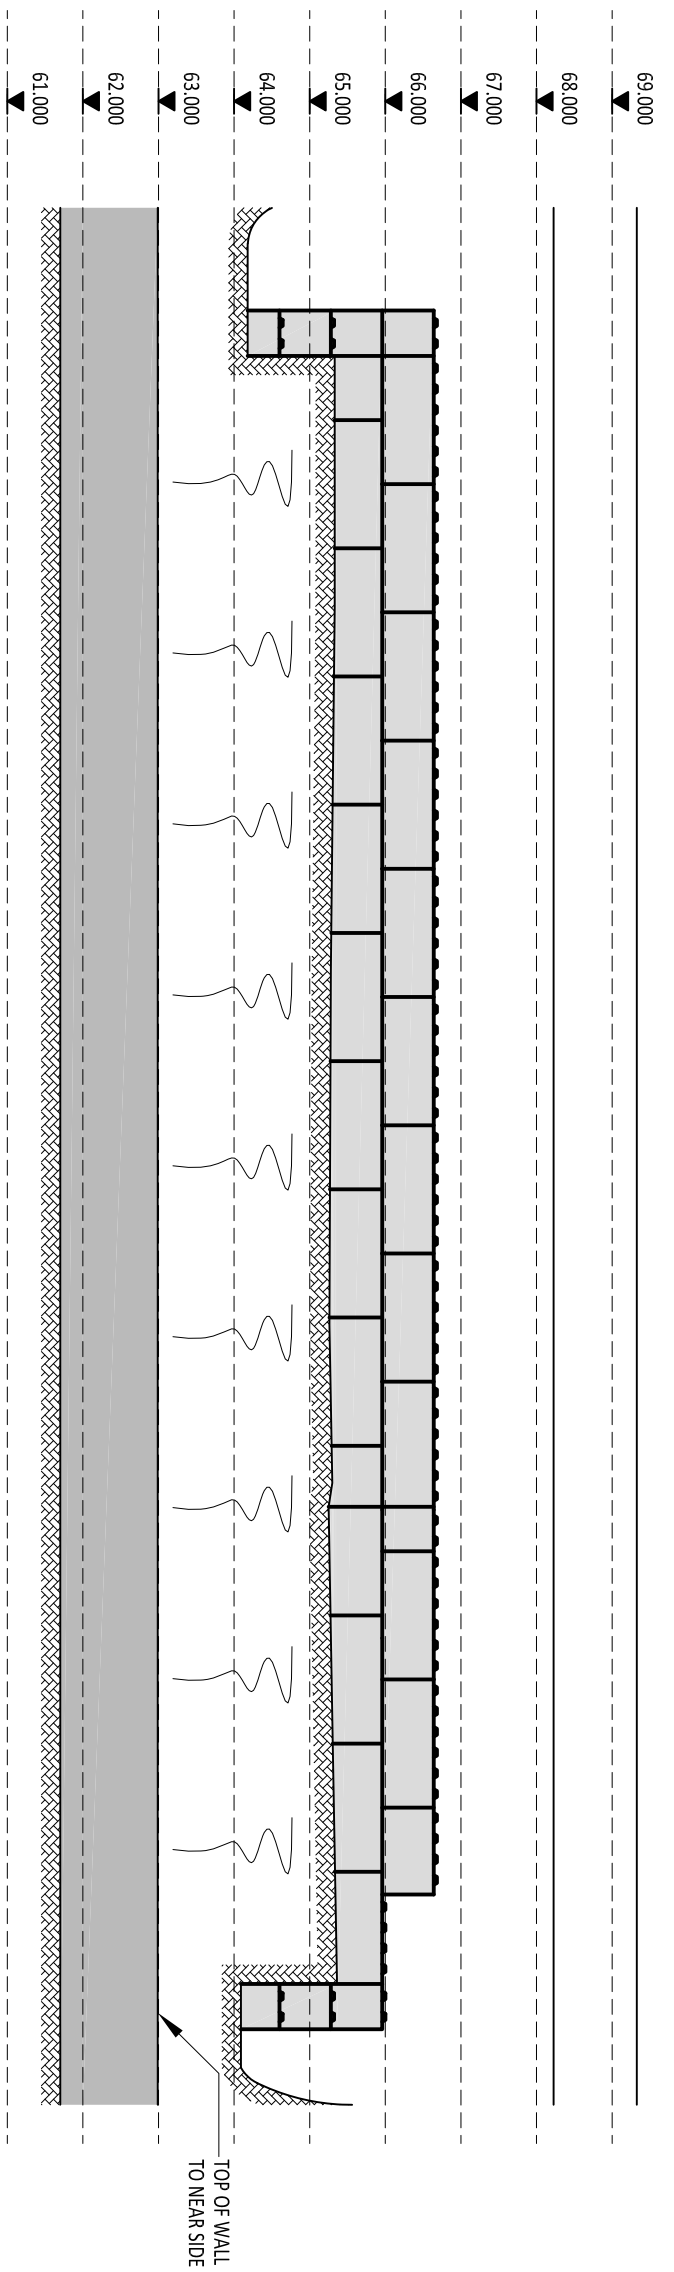


ELEVATION 201 - as installed

SCALE 1:100

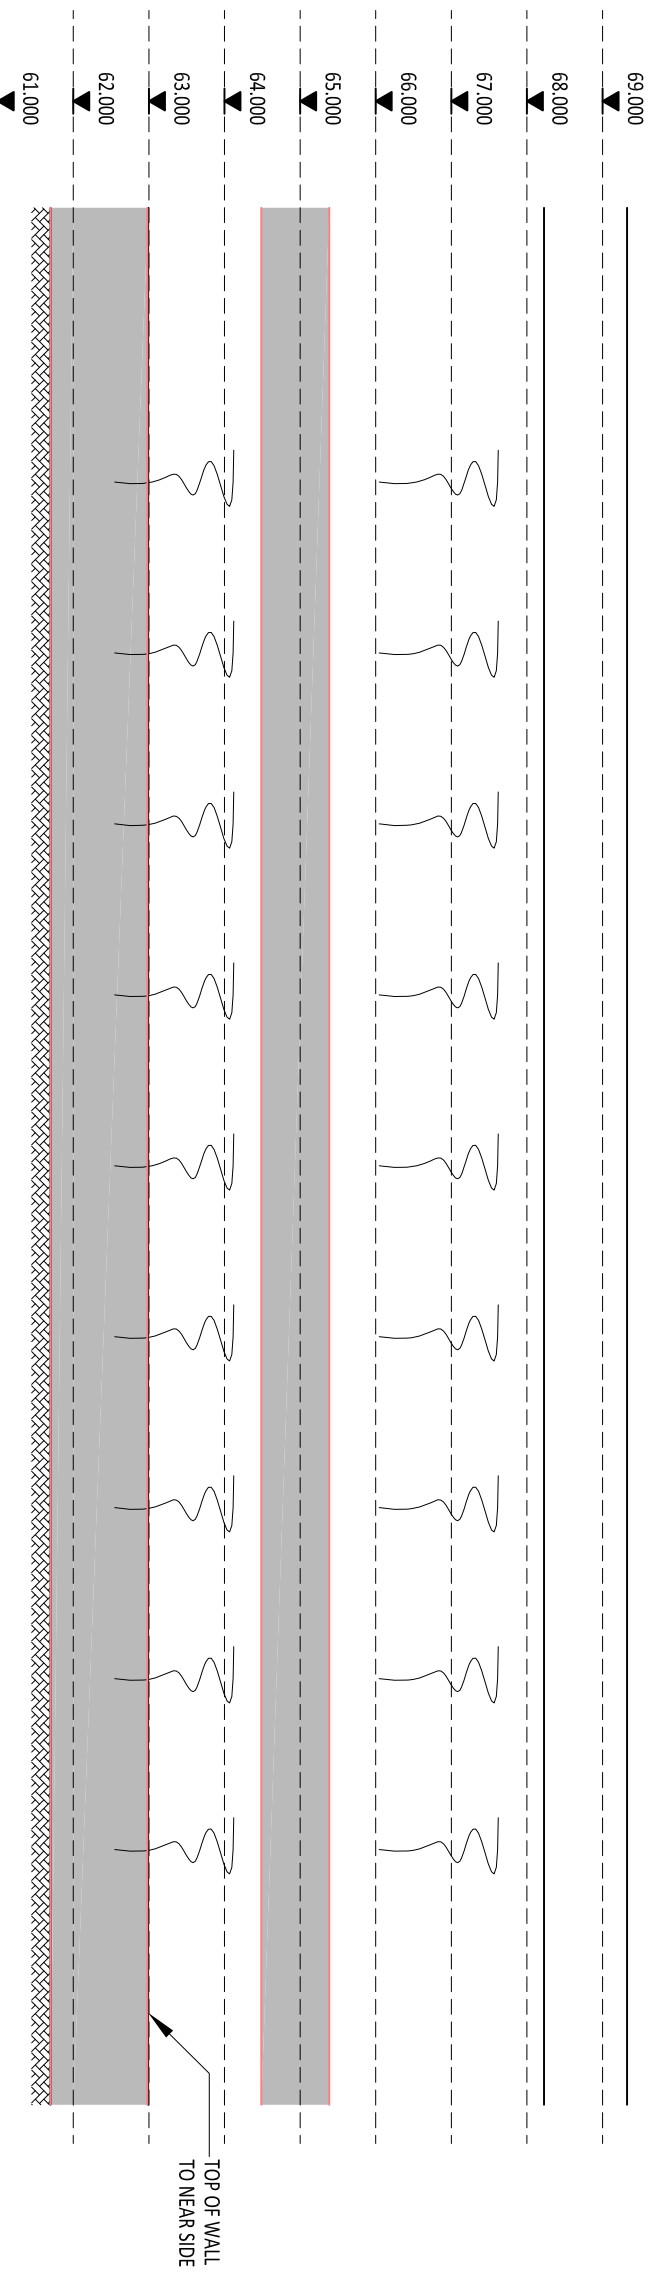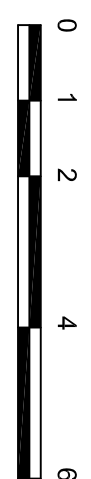

ELEVATION 201 - previous

SCALE 1:100

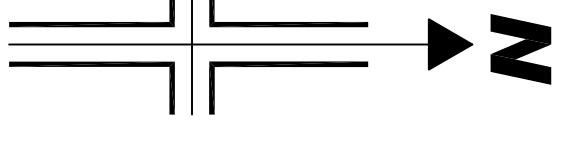

Mr & Mrs Stansfield

3 Higher Hodder Cottages  
Rear Garden Plan and Sections



PSA Design Ltd  
The Old Bank House, 6 Berry Lane,  
Loughborough LE17 2JG  
www.psa-design.co.uk  
mail@psadesign.co.uk

Drawn	Checked	Approved
HP	DME	DME

Date  
September 2022

Sheet Size  
A1

Rev.  
A3919-PL01  
As Shown