





○ Proposed Noth West Elevation  
Scale: Actual Size

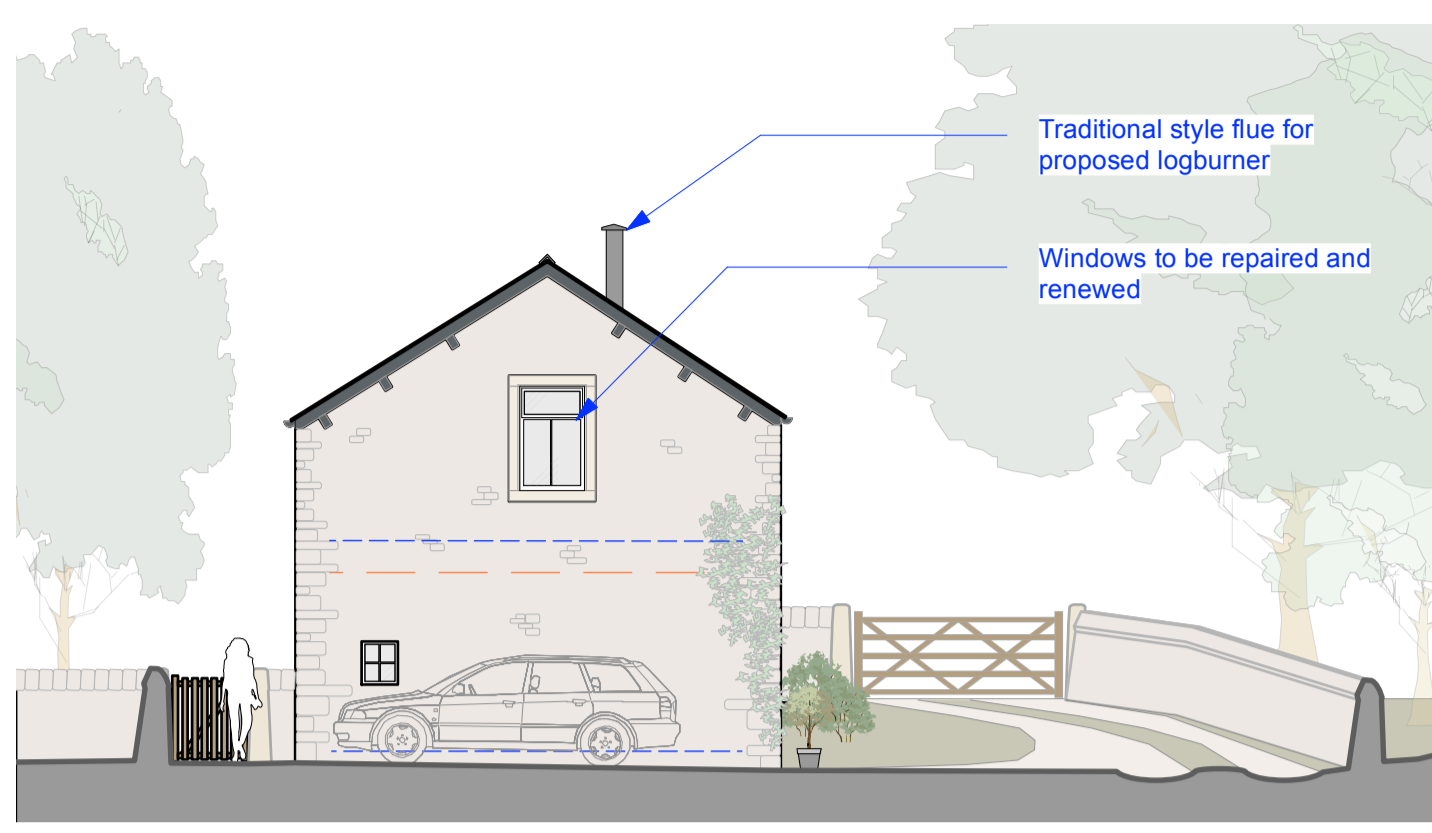

○ Proposed North East Elevation  
Scale: 1:100

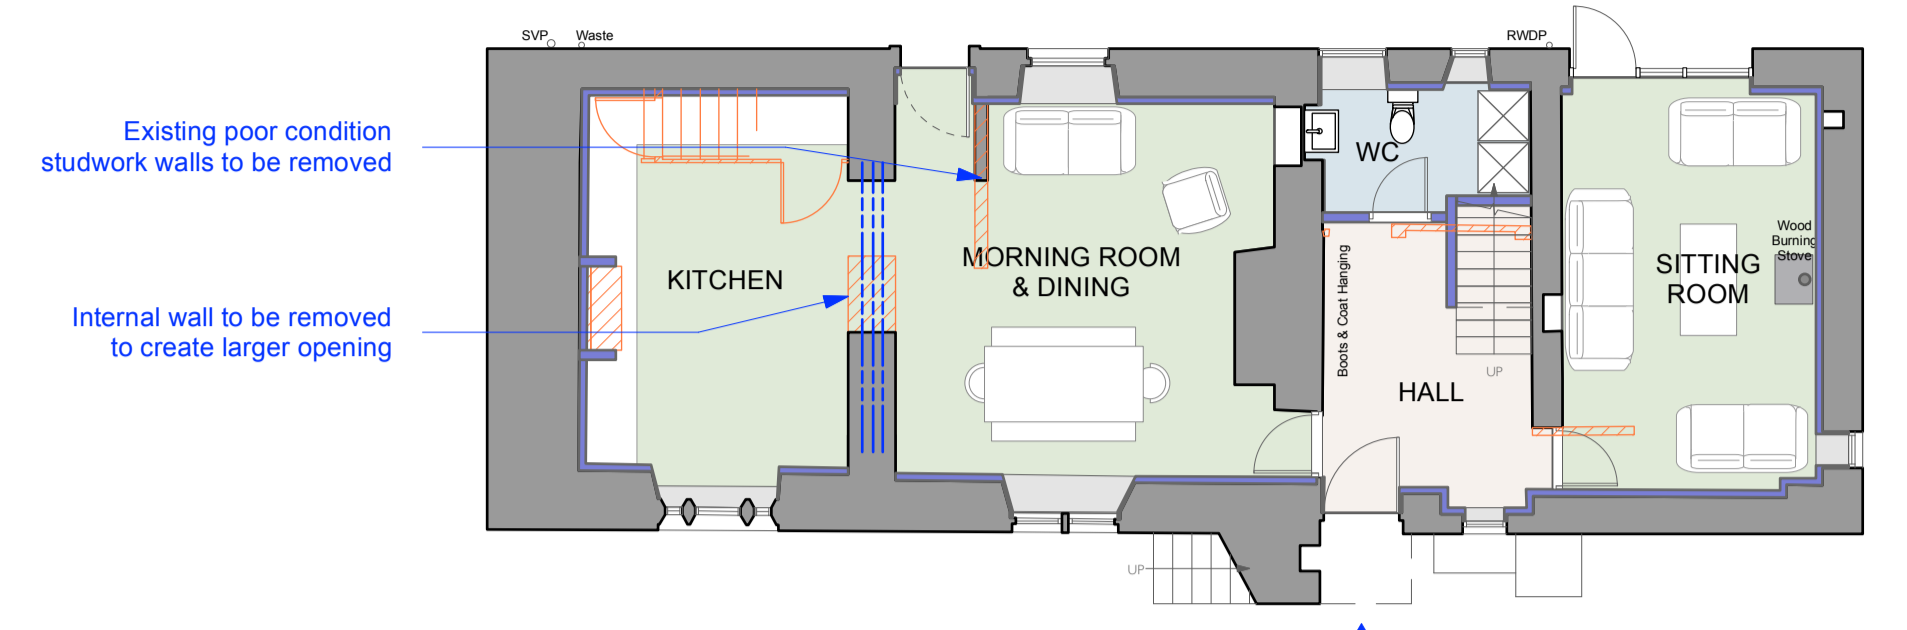


○ Proposed Ground Floor Plan  
Scale: 1:100


▲ Existing External Stair Landing utilised to form covered entrance



○ Proposed South East Elevation  
Scale: 1:100

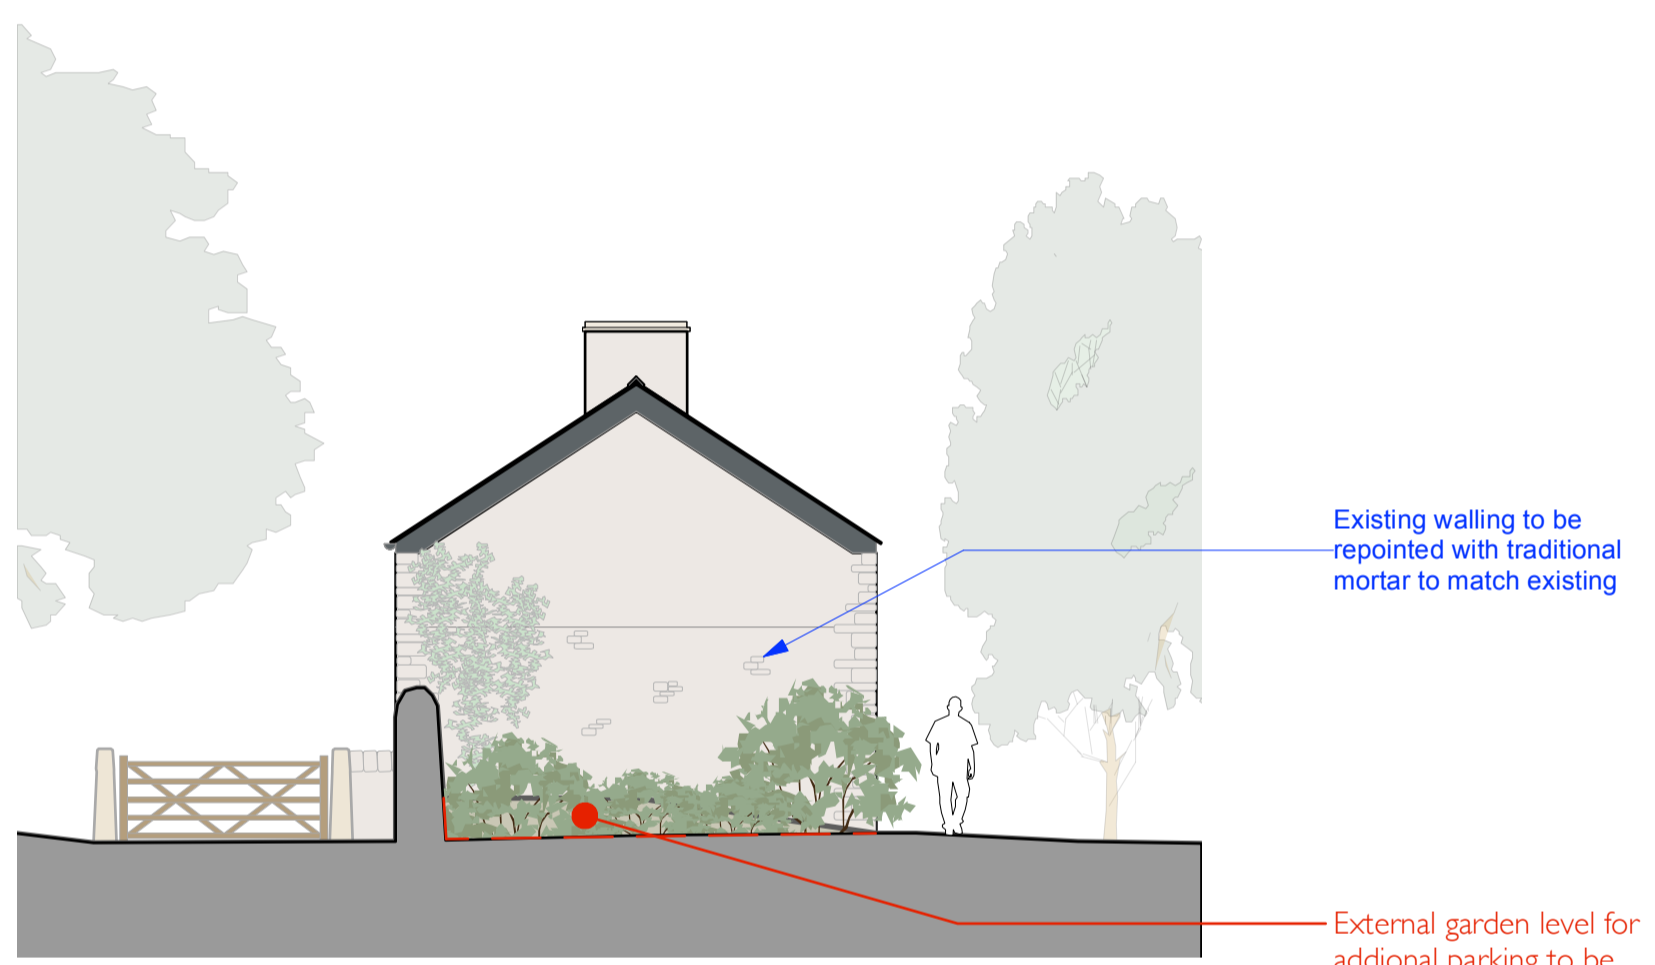

○ Proposed South West Elevation  
Scale: 1:100

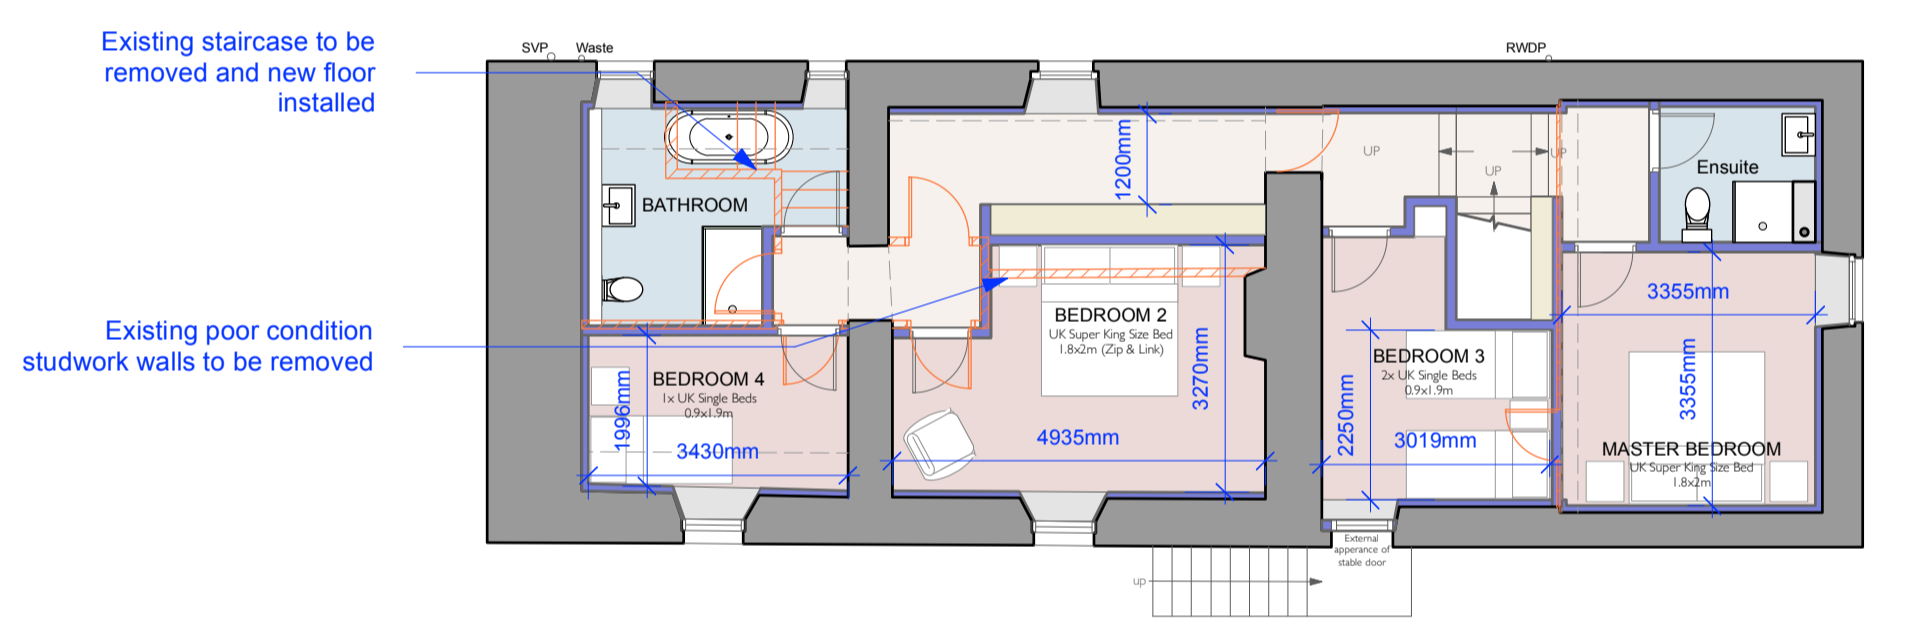

○ Proposed First Floor Plan  
Scale: 1:100



○ Proposed Full Lenght Noth West Elevation  
Scale: Actual Size

CWG 12/05/2023 Updated notes  
 BWG 01/03/2023 Removed additional parking and gates, and handrailing  
 AWG 01/02/2023 Removal of SVP pipe on NorthWest elevation

Rev.	Initial	Date	Note
------	---------	------	------

**PLANNING**

project <b>Knotts Gate Farmhouse</b>			
drawing title <b>Farmhouse</b>			
drawing title <b>Plans and Elevations</b>			
dwg. no. <b>5923/c/b/02</b>	date <b>Oct-20</b>	rev <b>C</b>	
scale <b>1:100 @ A1L</b>	drawn by <b>SM</b>	checked by	

**MASON GILLIBRAND**  
 ARCHITECTS  
 16 WILLOW MILL | FELL VIEW | CATON | LANCASTER | LA2 9RA  
 T: (01524) 771 377 | F: (01524) 771 330 | www.masongillibrand.com

Drawings are based on survey data and may not accurately represent what is physically present. Do not scale from this drawing. All dimensions are to be verified on site before proceeding with works. All annotations are in red unless stated otherwise. Mason Gillibrand Architects are to be notified in writing of any discrepancies immediately. © MASON GILLIBRAND ARCHITECTS