

A WG 01/03/2023 Removed additional parking and gates

Rev.	Initial	Date	Note

PLANNING

project **Knotts Gate Farmhouse**

Site Plan - Removed Car Parking


drawing title **Topography**

dwg. no. 5923/c/b/01	date Oct-20	rev A
----------------------	-------------	-------

scale 1:100	@ A1L	drawn by SM	checked by
-------------	-------	-------------	------------

MASON GILLIBRAND
 ARCHITECTS
 16 WILLOW MILL | FELL VIEW | CATON | LANCASTER | LA2 9RA
 T: (01524) 771 377 | F: (01524) 771 330 | www.masongillibrand.com

Drawings are based on survey data and may not accurately represent what is physically present. Do not scale from this drawing. All dimensions are to be verified on site before proceeding with works. All annotations are in red unless stated otherwise. Mason Gillibrand Architects are to be notified in writing of any discrepancies immediately. © MASON GILLIBRAND ARCHITECTS

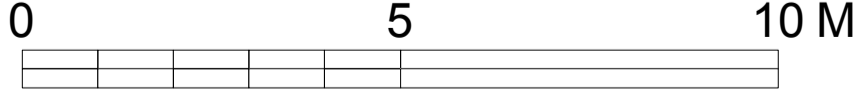

Site Plan
 Scale: 1:100

