

N


0m2.8m5.6m8.4m11.2m

VISUAL SCALE 1:200

COPYRIGHT:

The copyright of this drawing is held by AST* - Assorted Skills + Talents Limited and no reproduction is allowed without prior permission. This drawing must be checked and verified by the contractor prior to work commencing on site. Liability shall not be taken for any defects in this drawing unless, prior to commencing, this drawing and all its dimensions have been so checked and verified. All drawings issued prior to being checked to be treated as draft.

DO NOT SCALE.

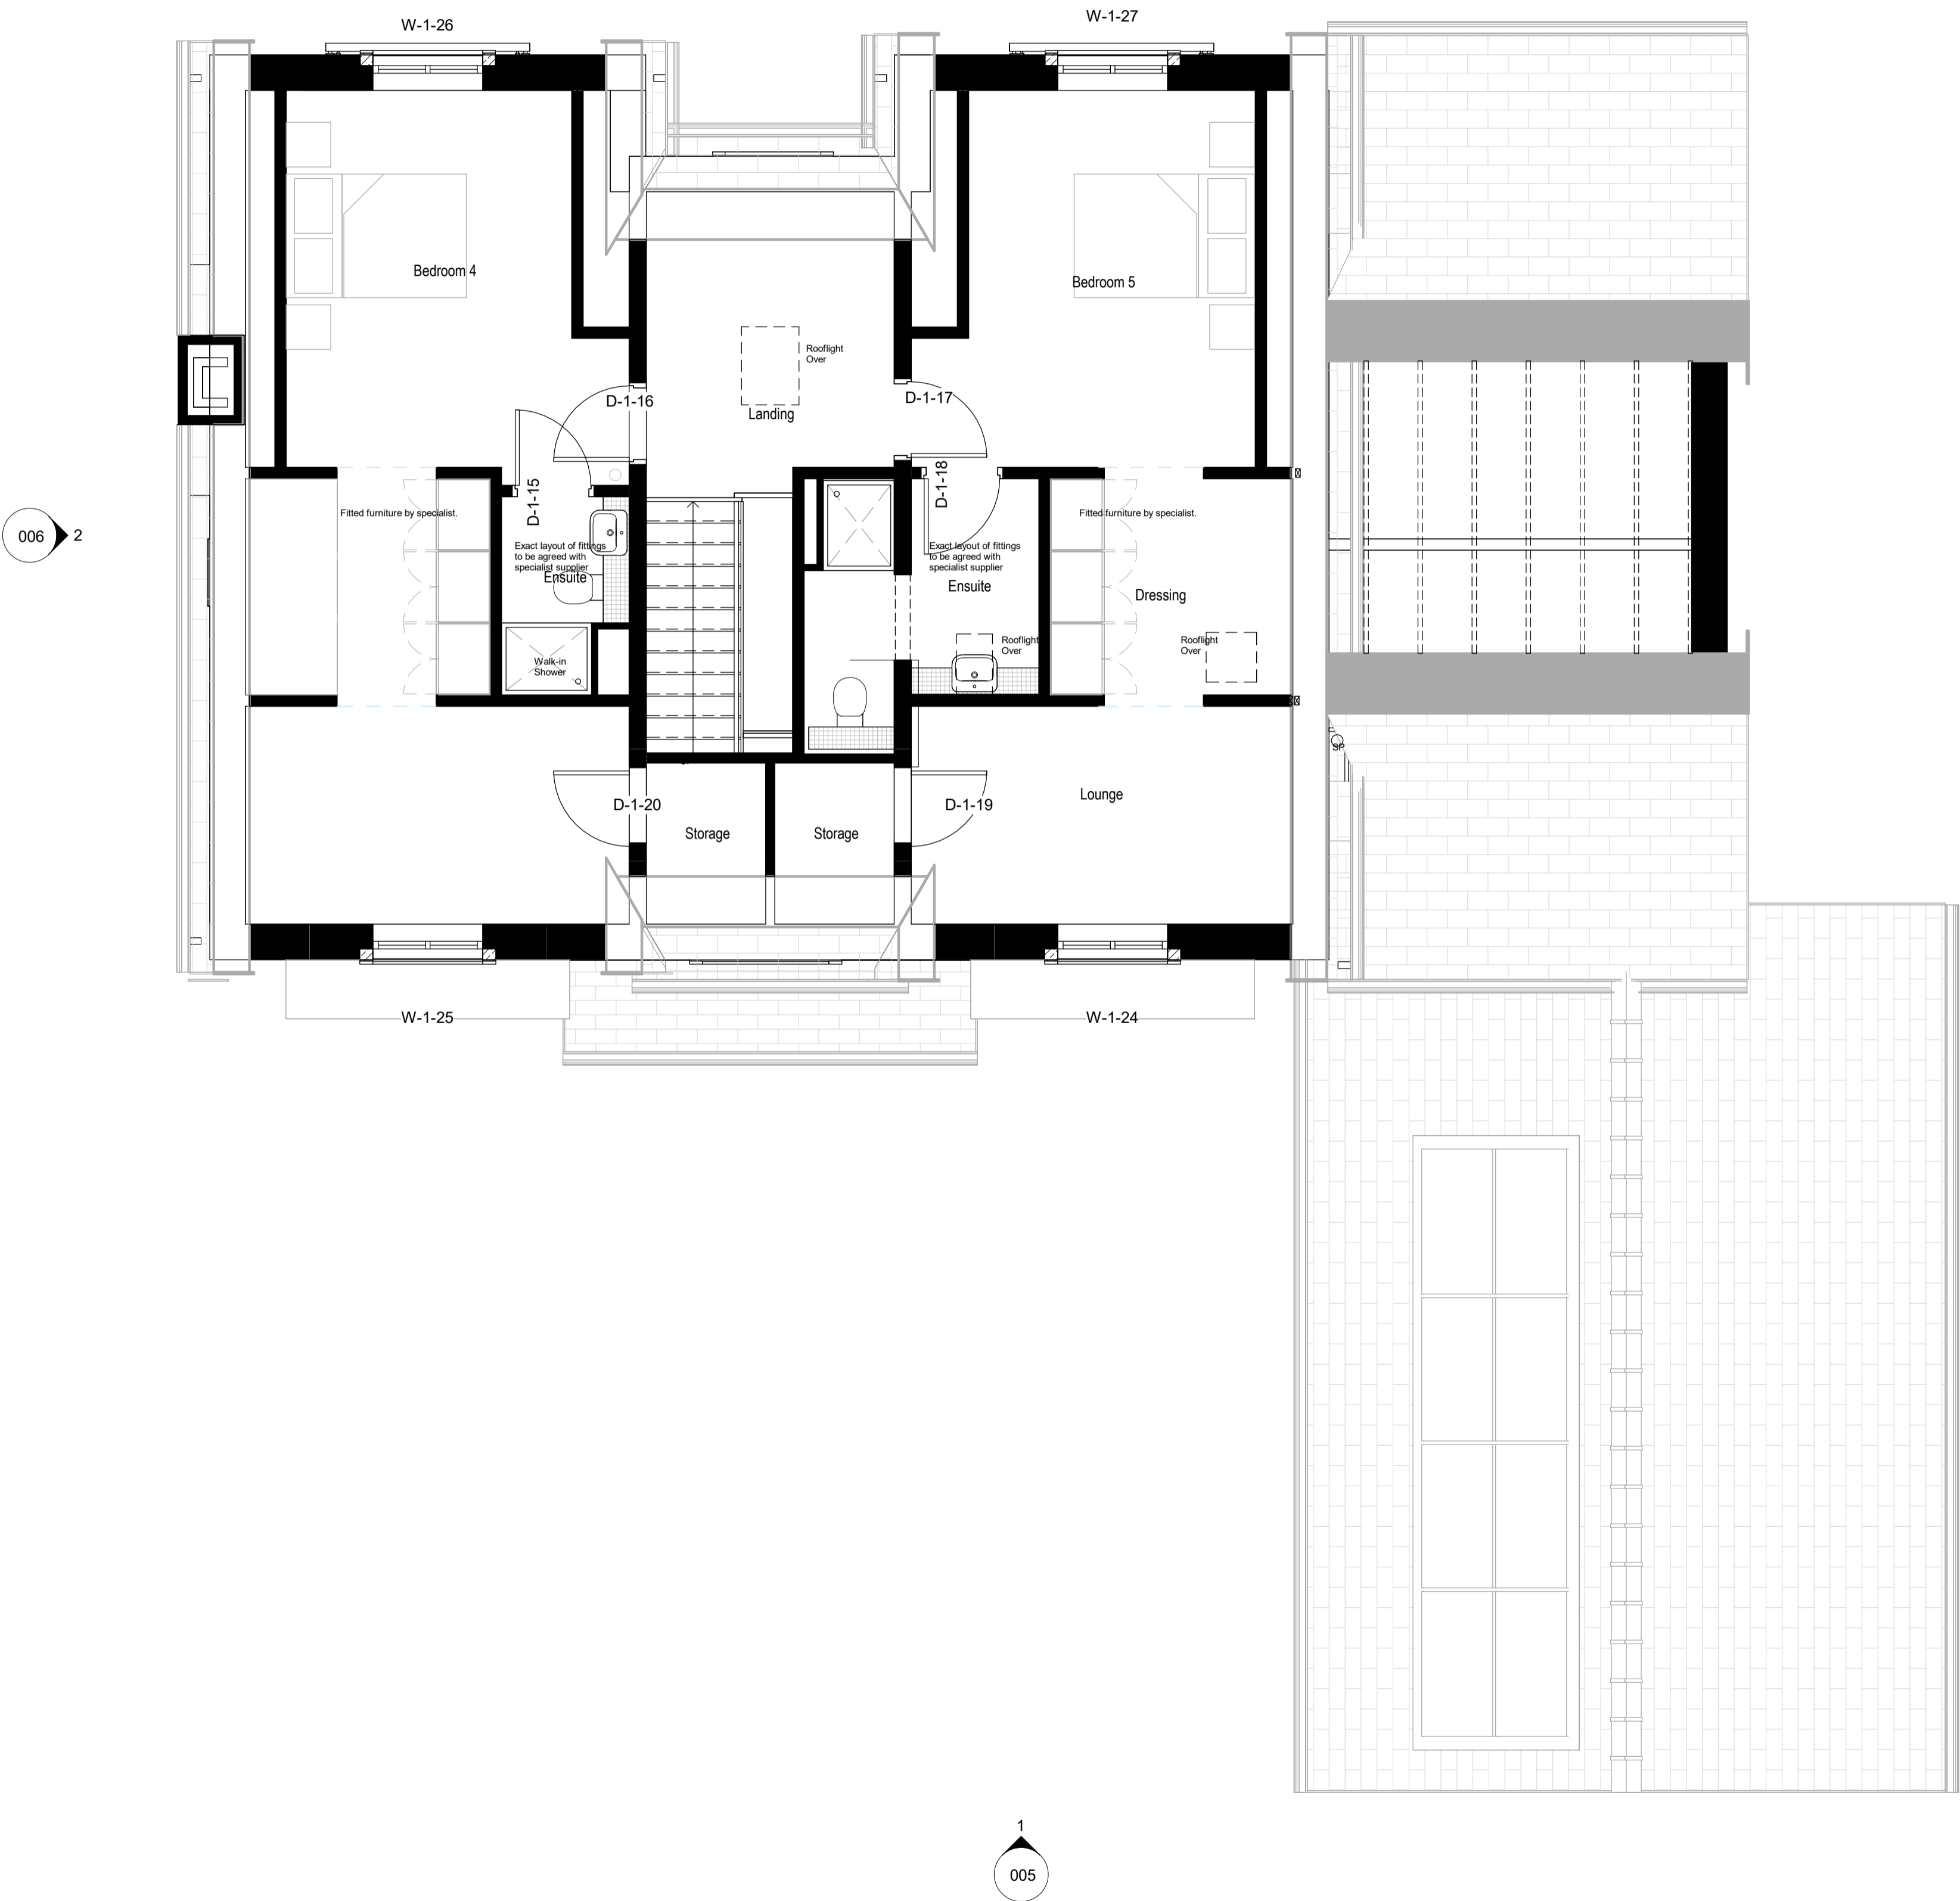

rev	description	date	drawn	check
Revision Schedule				
<div><div><div>Assorted Skills + Talents*</div><div>North Studio 3 Cobourg Street, Manchester, M1 3GY. Studio South 48 Charlotte Street, London, W1T 2NS. www.assortedskillstalents.com</div><div>★ ASSORTED SKILLS + TALENTS</div></div></div>				
client: Mrs Dawn Lenehan				
project: Proposed External Garage and Internal Alterations Plot 1, (Number 8) The Oaks, Whalley, Lancashire				
drawing: Second Floor - As-built Layout				
drawing no: AST_23_3-004		project - originator - volume - level - type - role - drawing number P1		drawn: 21/10/20
original by: DFH	issue status: PLANNING		scale: 1 : 50	@A1
checked by: DKC				