



This drawing must not be copied or reproduced by any third party without the written consent of Flanagan Design Associates Limited

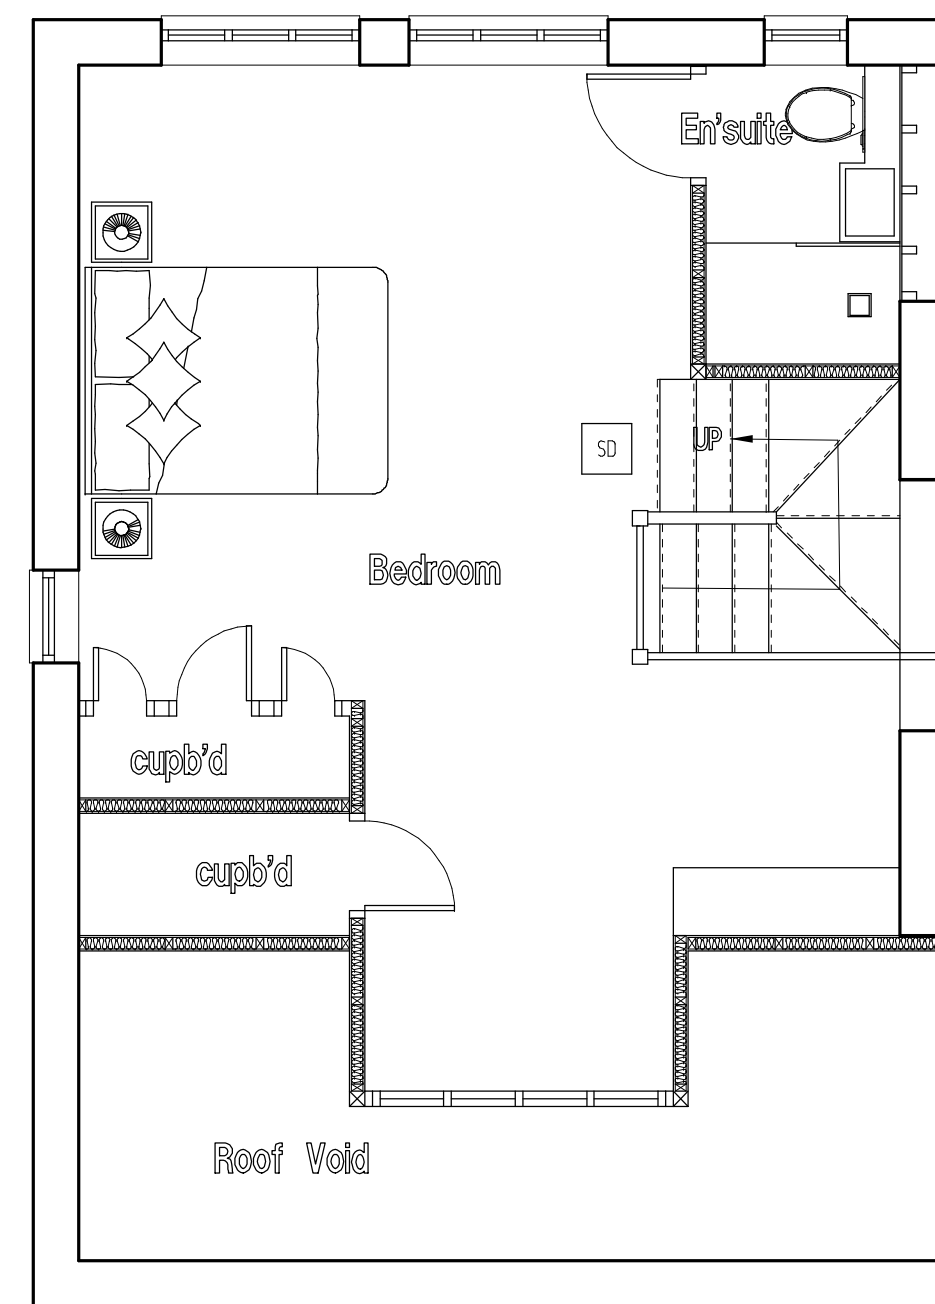

Dormer Bedroom Plan 1 : 50

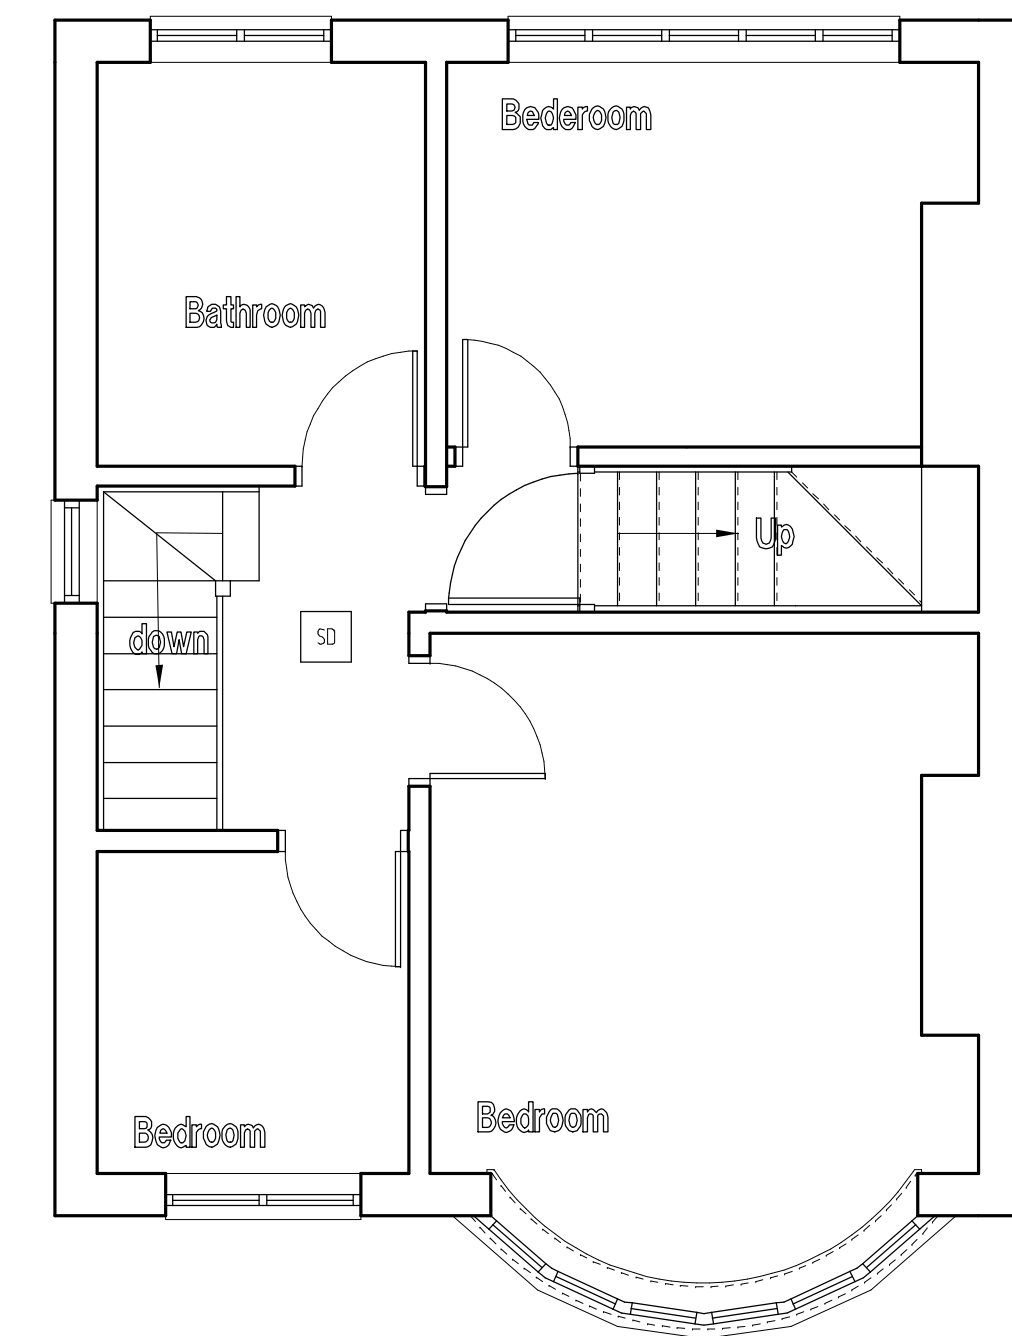

First Floor Plan 1 : 50




Rear Elevation 1 : 100



Side Elevation 1 : 100



Front Elevation 1 : 100

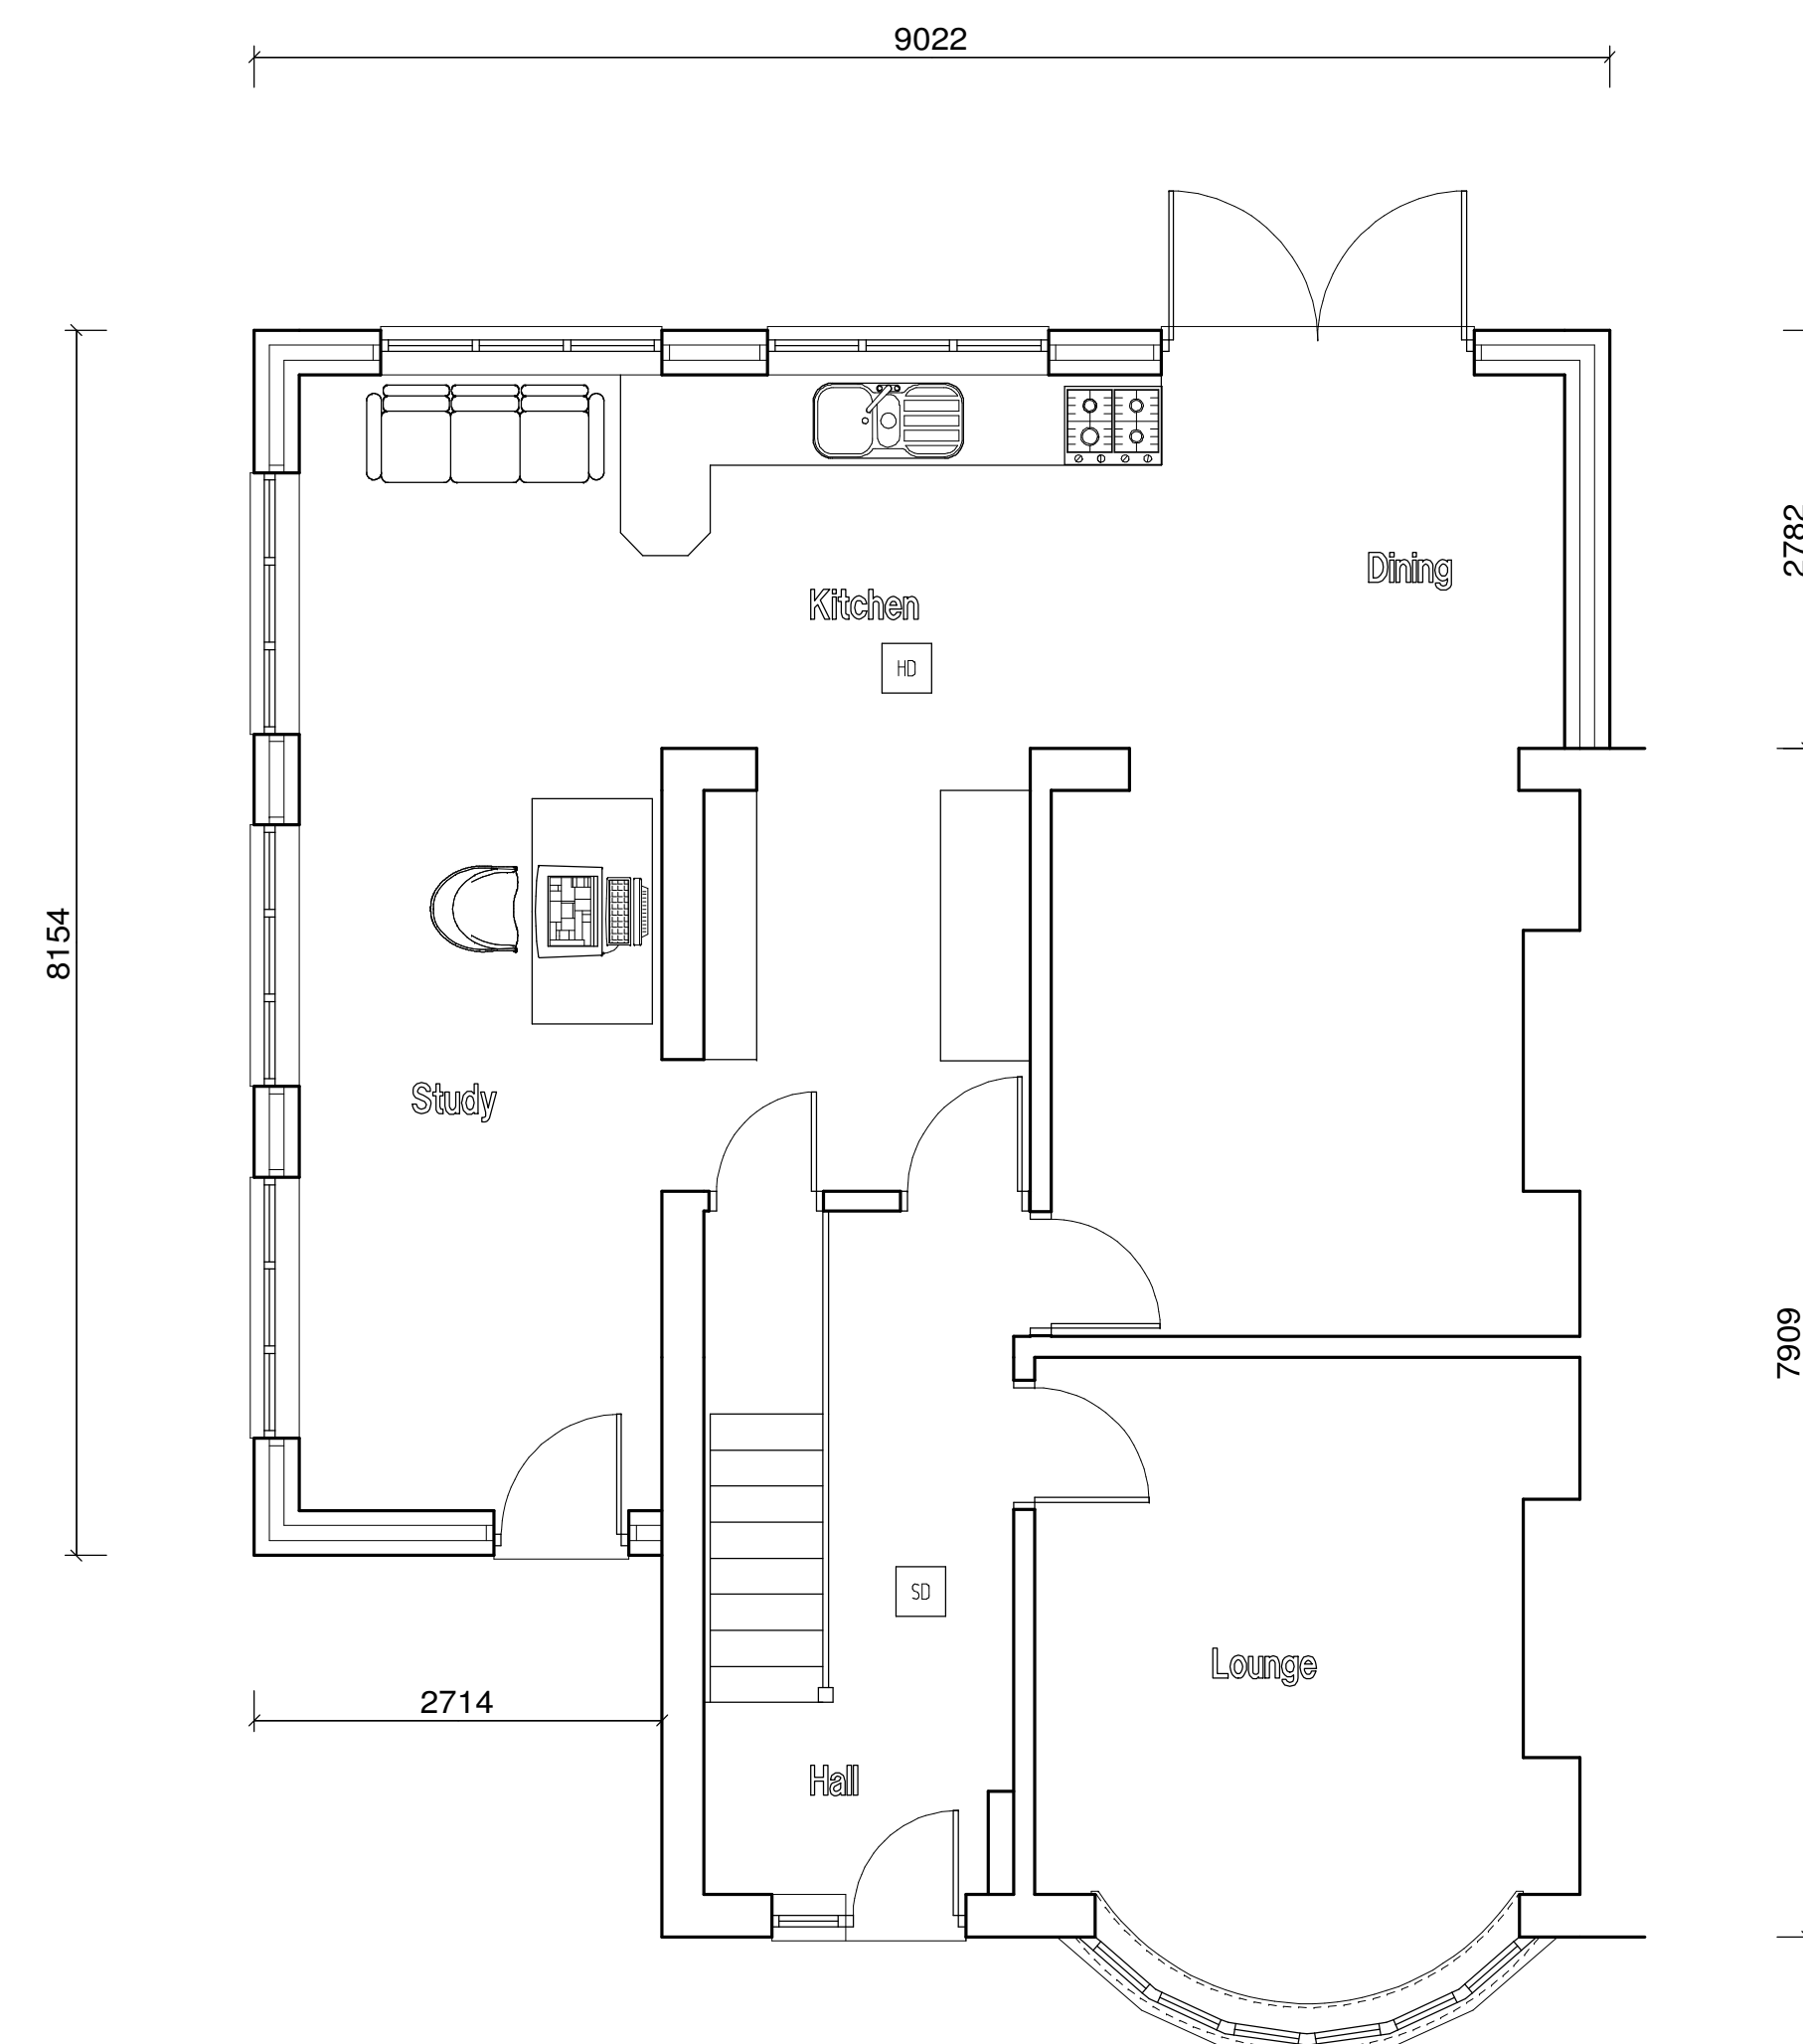

Ground Floor Plan 1 : 50

[illegible]