



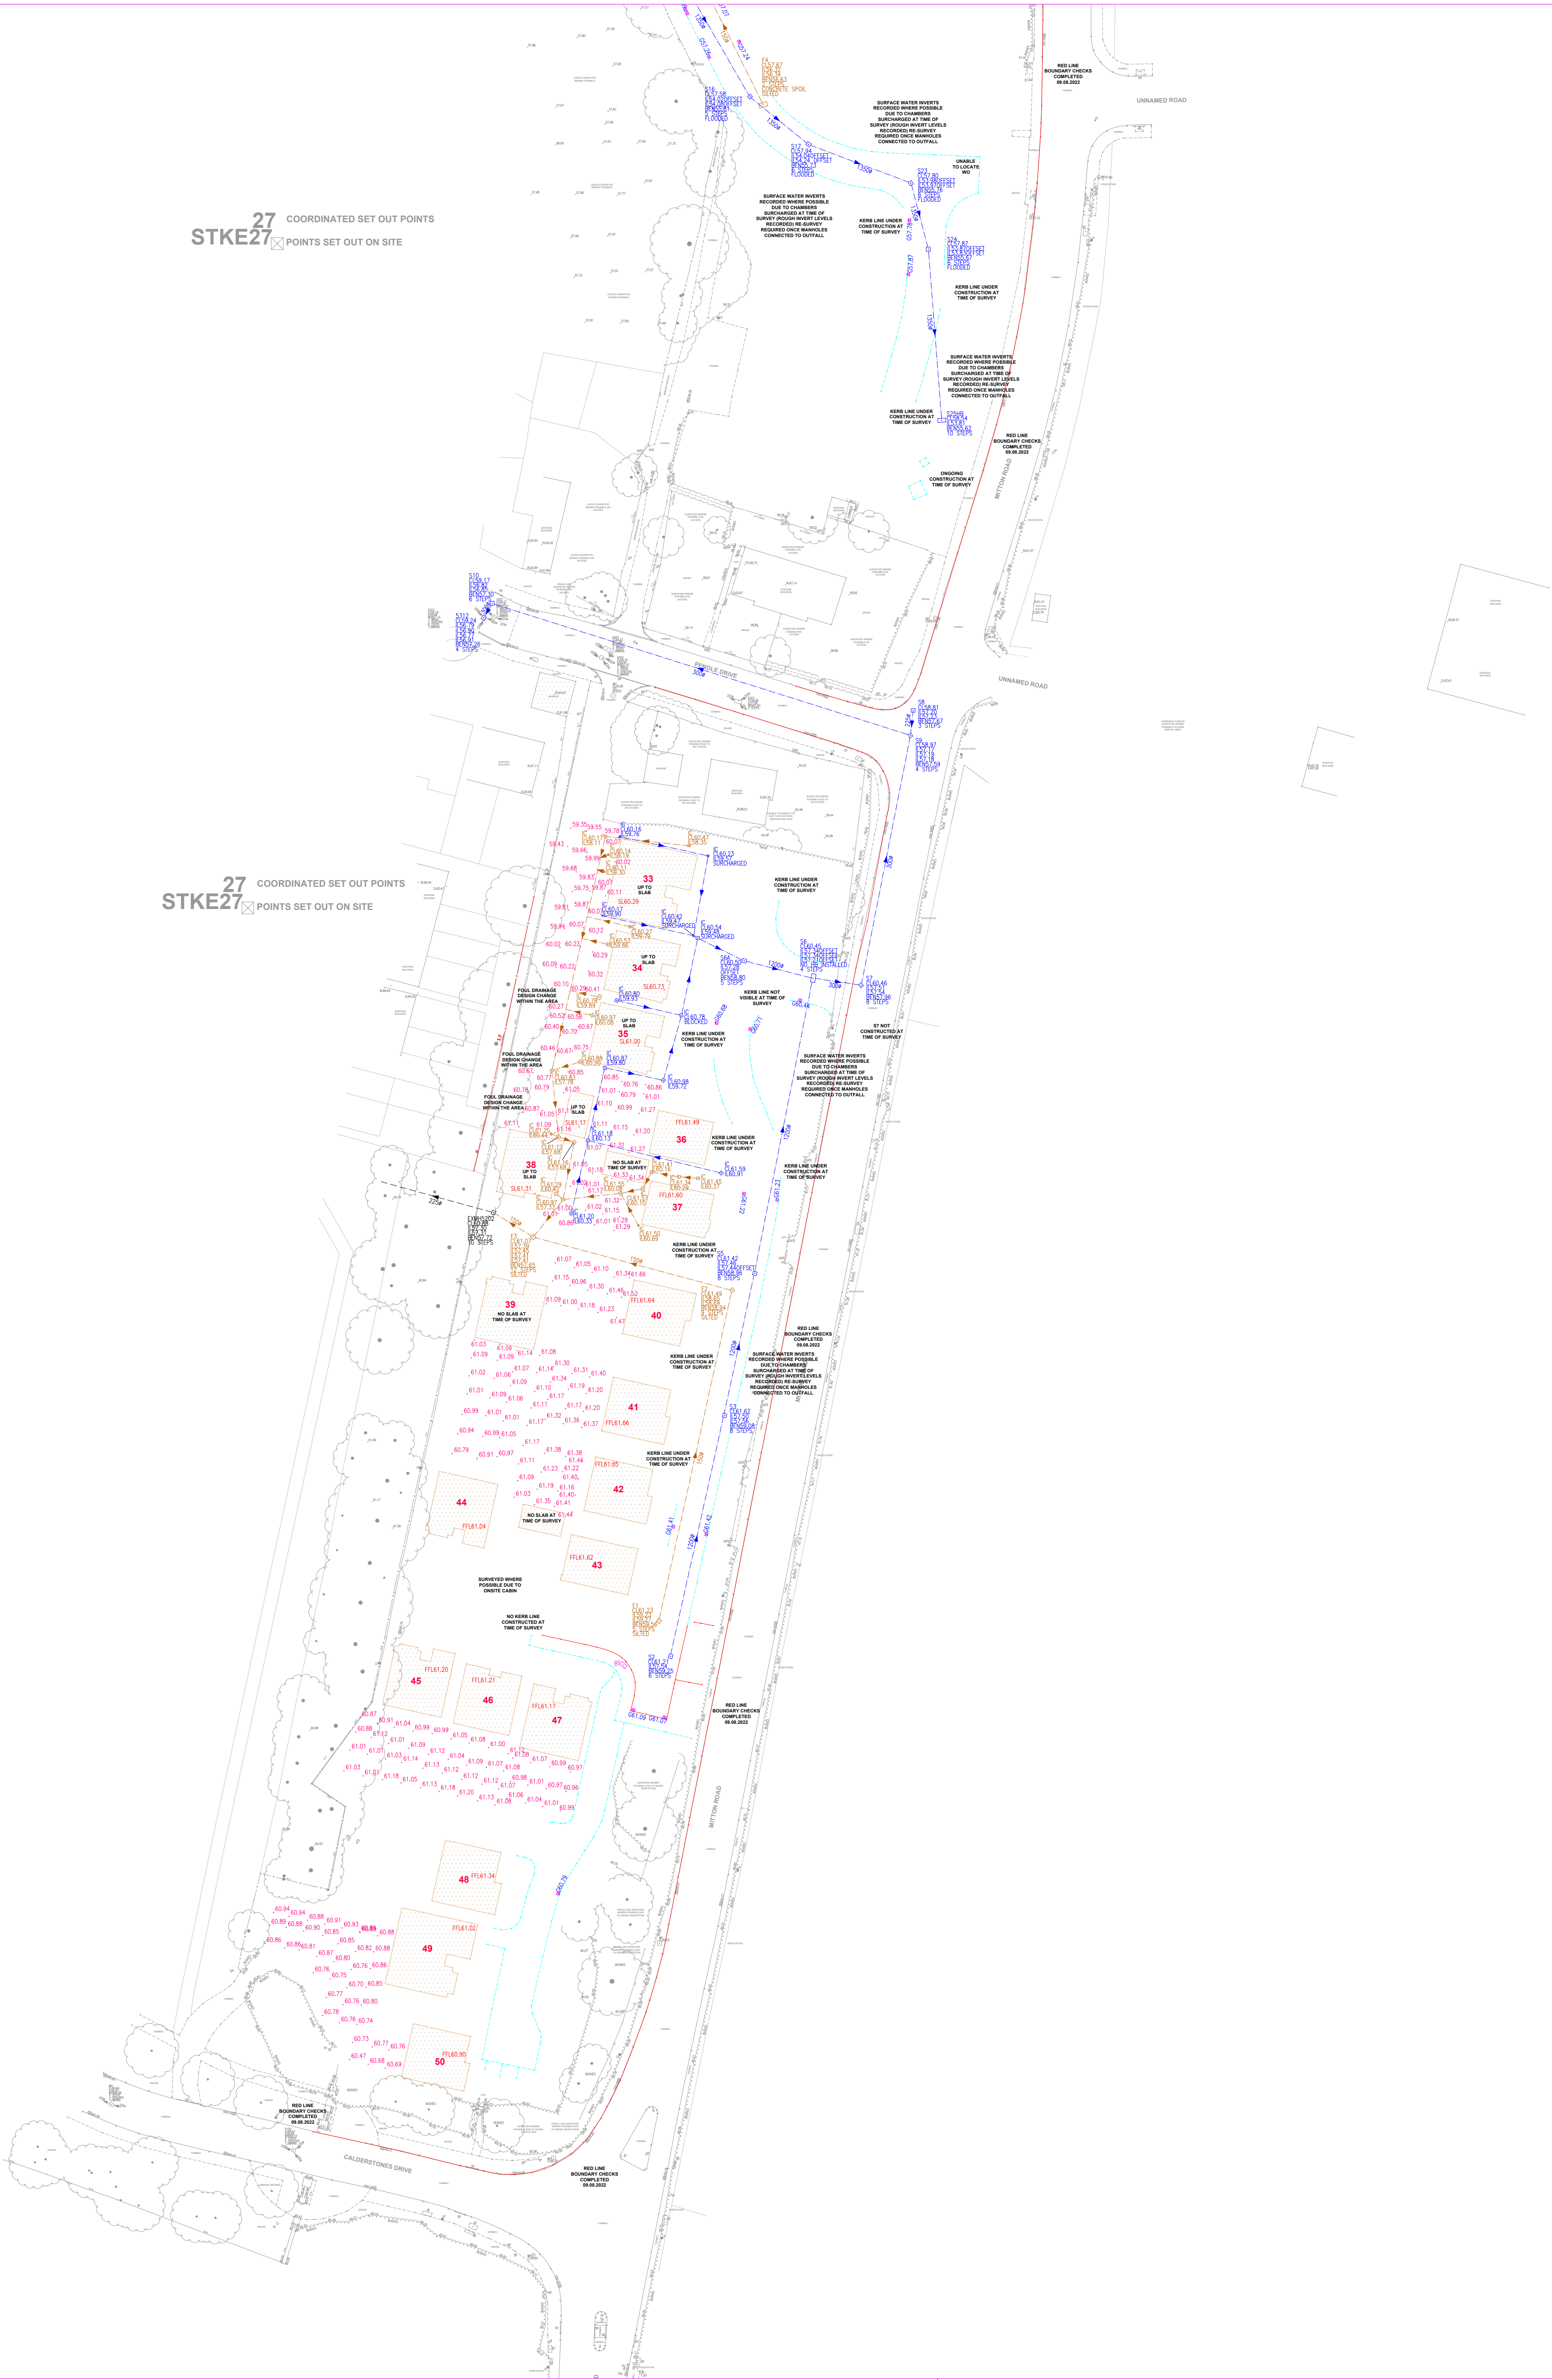

27 COORDINATED SET OUT POINTS
STKE27 POINTS SET OUT ON SITE

27 COORDINATED SET OUT POINTS
STKE27 POINTS SET OUT ON SITE

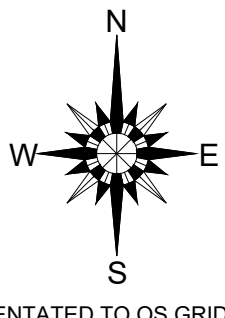

SURVEY NOTES

ALL LEVELS ARE RELATED TO O.S DATUM (OSGB36-15)
ESTABLISHED AT SE1 USING THE LEICA SMARTNET GPS NETWORK

SURVEY LEGEND

FEATURES	BOUNDARY ANNOTATIONS
TOP OF BANK	BARB WIRE FENCE
BOTTOM OF BANK	CHAIN LINK FENCE
SURVEY STATION	CONC POST AND PANEL
TREE	CONC POST TIMB PANEL
HEDGE	ELECTRIC FENCE
TREE CANOPY	HERAS FENCE
BUSHES	IRON RAIL FENCE
VEGETATION	MISCELLANEOUS FENCE
	POST AND WIRE FENCE
	RANCH STYLE FENCE

LEVEL PREFIX ANNOTATIONS
ASL ARCH SPRING LEVEL
BL BED LEVEL
BD BACK DROP
CL COVER LEVEL
DH TOP OF DOOR
DTL DEPTH TO CROWN
FTL FINISHED FLOOR LEVEL
IL INVERT LEVEL
RL PARAPET LEVEL
SL ROOF/RIDGE LEVEL
STL SOFFIT LEVEL
THR TREE HEIGHT
THR THRESHOLD LEVEL
WL WATER LEVEL
WS WINDOW SILL
WSF WINDOW SOFFIT
TOW TOP OF WALL

GEOTECHNICAL INFORMATION
TRIAL HOLE / PIT
BORE HOLE
WINDOW SAMPLE
MONITORING POINT

SURVEY ANNOTATIONS

AV AIR VALVE	OHC OVERHEAD CABLES
B BOLLARD	PD POST BOX
BS BUS STOP	PM PARKING METER
BT BRITISH TELECOM IC	PS POST
CPS CONCRETE-PAVING SLABS	PYL ELECTRICITY PYLON
CP CATCH PIT	RE RODDING EYE
DR DRAIN	RS ROAD SIGN
EB ELECTRIC CONTROL BOX	RWP RAIN WATER PIPE
EL ELECTRICAL IC	ST STOP TAP
EP ELECTRICITY POLE	SM SERVICE MARKER
ER EARTH ROD	SP SIGN POST
FH FIRE HYDRANT	SV STOP VALVE / SLUICE VALVE
FP FLAG POLE	SVP SOIL VENT PIPE
G GULLY	TB TELEPHONE BOX
GH GREENHOUSE	TL TRAFFIC LIGHTS
GP GATE POST	TM TELEPHONE MAST
GV GAS VALVE	TP TELEGRAPH POLE
IC INSPECTION COVER	TPS TACTILE PAVING SLABS
JB JUNCTION BOX	VP VENT PIPE
JW JAPANESE KNOT WEED	WM WATER METER
KO KERB OUTLET	UTL UNABLE TO LIFT
LH LAMP HOLE	UTS UNABLE TO SURVEY
LP LAMP POST/LIGHT COLUMN	
MH MANHOLE	
MP MONITOR POINT	
NP NAME PLATE	

CLIENT
PROSPECT GB

PROJECT TITLE
MITTON ROAD, WHALLEY

DRAWING DETAIL
AS BUILT SURVEY
SHEET 2 OF 2

DRAWING NUMBER
PRO.AB.14

PROJECT ENGINEER CT
DRAWN DH
DATE 18.07.2023
SCALE 1:500@A1

DESCRIPTION	REV	DATE	DRWN	APPR
MANHOLE SURVEY ADDED	A	28.09.23	DH	-

SurveyEng Ltd
Land Surveyors & Engineers

14 GREEN MILL
WESTHOUGHTON
BOLTON
LANCS
BL5 3GE
TEL/FAX: 0800 772 3040
MOB: 07850069993
info@surveyeng.co.uk