




PROPOSED SECTION B - B

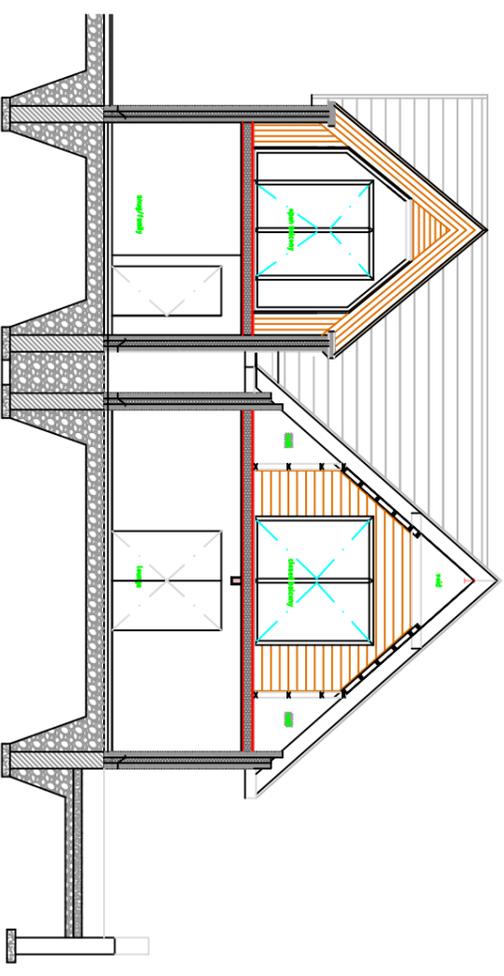

PROPOSED SECTION C - C

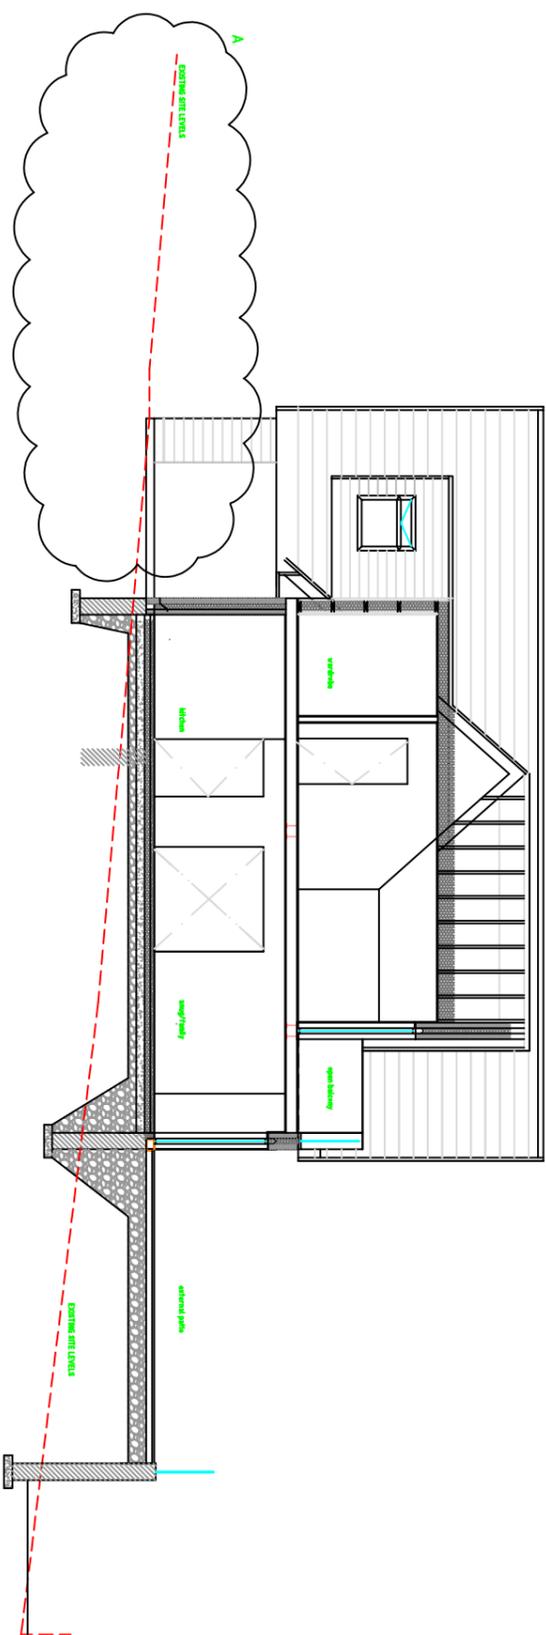

PROPOSED SECTION A - A

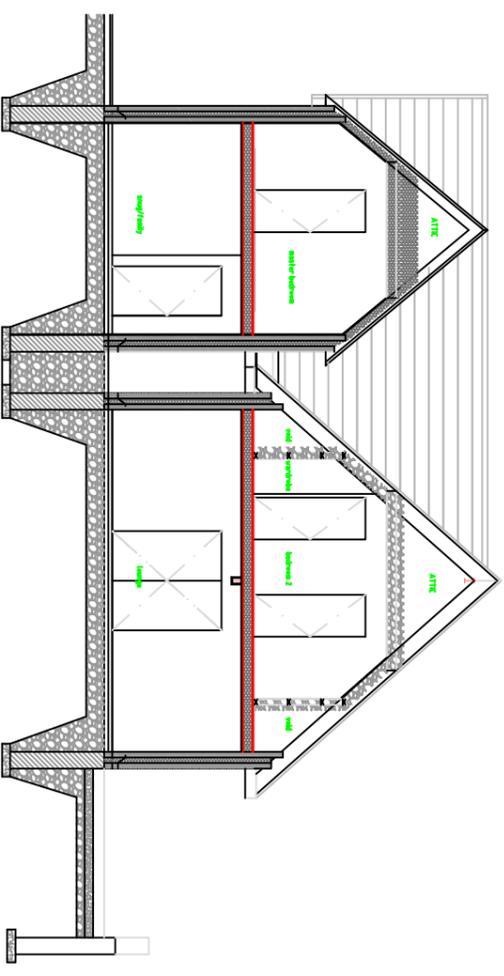

PROPOSED SECTION D - D

REFERENCE DRAWINGS

REV.	DATE	DESCRIPTION	DRN.	APP.
A	02/10/2023	EXISTING LAND LEVELS SHOWN IN RED HATCH AND PAVED LEVEL SHOWN INDICATIVELY	PH	GH
B				
C				
D				
E				
F				

THIS DRAWING IS CONFIDENTIAL AND THE PROPERTY OF ABOUT TERNEN HOME. THIS DRAWING IS ISSUED ON THE CONDITION THAT IT IS NOT USED, COPIED OR EXHIBITED PRIOR TO WRITTEN CONSENT FROM ABOUT YOUR HOME. ANY WORK OR ACTIVITY MUST NOT BE CARRIED OUT OR USED FOR ANY OTHER PURPOSE OTHER THAN THAT FOR WHICH THE DESIGNER HAS BEEN ENGAGED. THE DESIGN OF ANY SYSTEM MANUFACTURED IN ACCORDANCE WITH THIS DRAWING

PROJECT REFERENCE	A.I.	006
CLIENT	6 Tintern Avenue	
CLIENT	HODGSDON FAMILY	

DRAWN	DATE	PMH
CHECKED	24.10.2023	
APPROVED		
SCALE	1:100	
PLOT SIZE	A2	
DIMENSIONS		MILLIMETERS

DRAWING TITLE	PROPOSED ELEVATIONS	PLANT REF.
ASH & BEECH DEVELOPMENTS LTD		
48 HAMBLETON VIEW HIGHAMREAD, SIMONSTONE BURNLEY, LANCOS BB12 7PD		
DRG. No.:	006-001-02	SHT. 2 OF 2 Rev. A
Tel : +44 (0) 776 175 0251 Fax : +44 (0) 1282 XXXXXX E-Mail : meil@ABYH.com		