
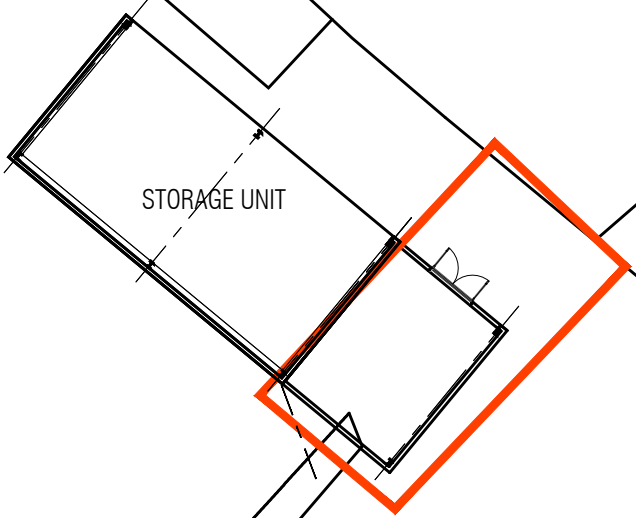


**NOTES**  
 THIS DRAWING IS TO BE READ IN CONJUNCTION WITH ALL OTHER DRAWINGS FOR THIS PROJECT. ALL LEVELS AND DIMENSIONS ARE TO BE CHECKED ON SITE BY THE CONTRACTOR, PRIOR TO PLACING ORDERS OR COMMENCING ANY OF THE RELEVANT WORKS. ALL DIMENSIONS ARE IN MILLIMETRES UNLESS STATED OTHERWISE. ANY DISCREPANCIES BETWEEN THE INFORMATION SHOWN ON THE PLAN AND THAT FOUND ON SITE ARE TO BE REPORTED TO THE DESIGNER IMMEDIATELY.

Fields Farm Barn

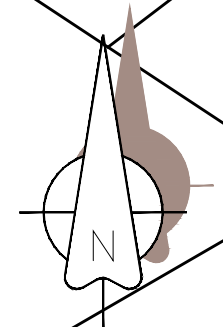

| Rev. | Date | Description |
|------|------|-------------|
|------|------|-------------|

**A.L.H. Design Services**  
 Barley Cottage, Brewery Street, Longridge, Lancs  
 PR3 3NB, Tel & Fax : (01772) 785719

**Client**  
 Mr D. Balchin,  
 Fields Barn,  
 Back Lane  
 Chipping,  
 Lancs PR3 2QA

**Job/Scheme Title**  
 NEW AGRICULTURAL BUILDING

**Drawing Title**  
 PROPOSED SITE PLAN

| Job/Scheme Number |         | Drawing Number |         |
|-------------------|---------|----------------|---------|
| 0706/93           |         | Drawing No 08  |         |
| Scale             | Date    | Drawn          | Checked |
| 1 / 250           | July 23 | a.t.l-h.       |         |