


1 PROPOSED NORTH
1 : 50

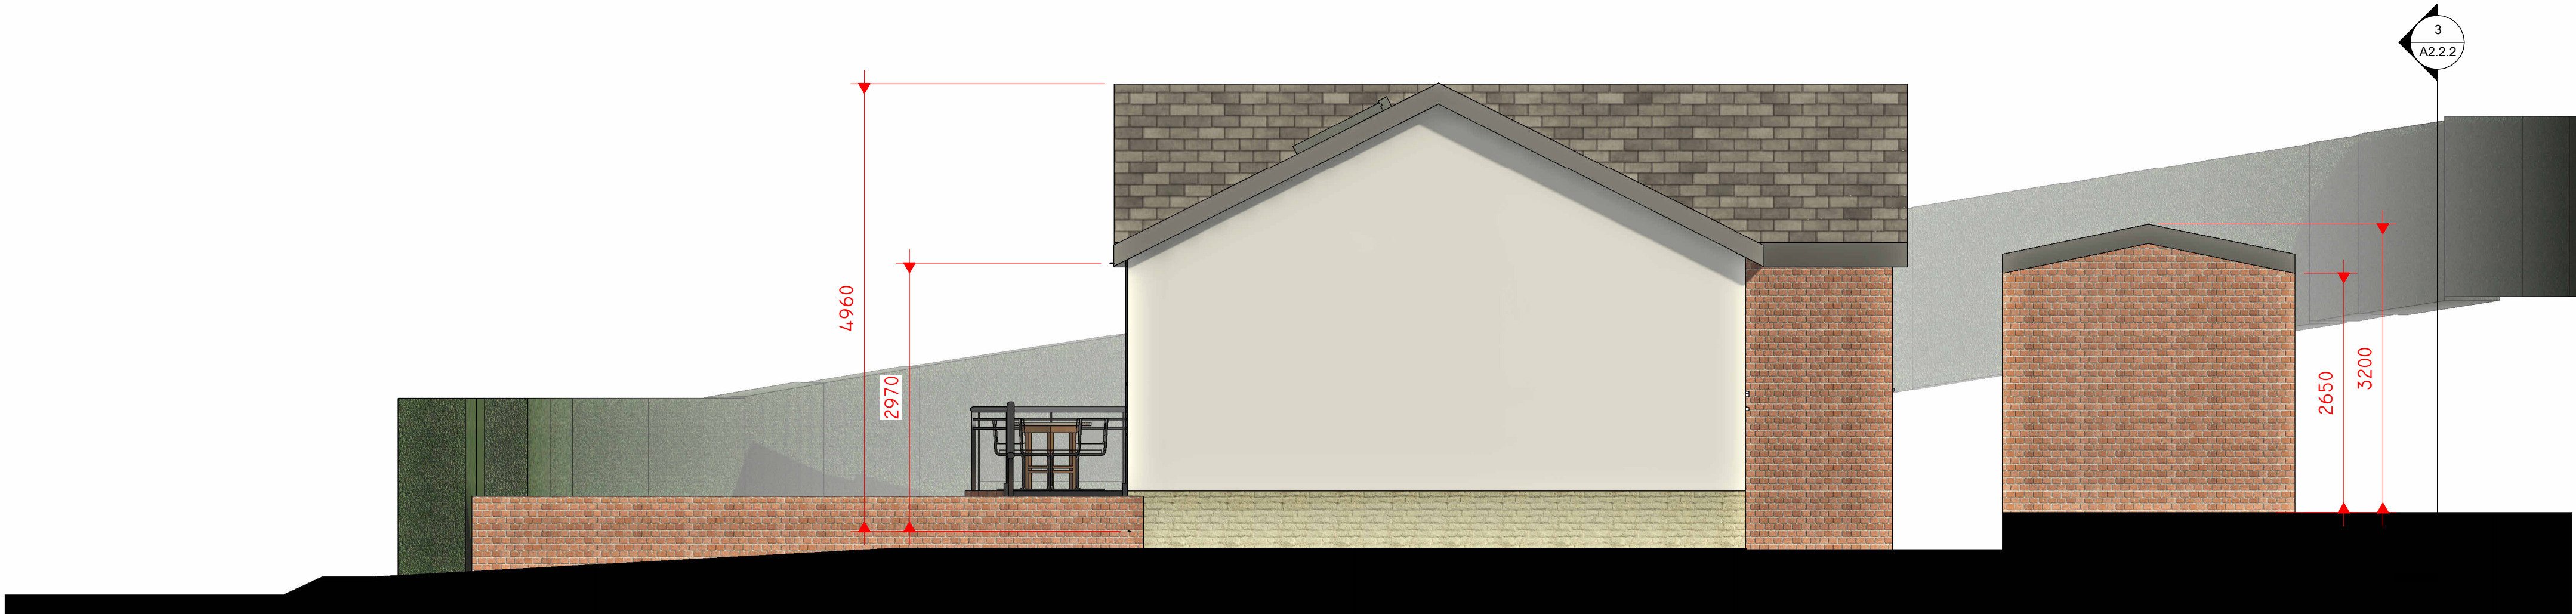

2 PROPOSED EAST
1 : 50

Peter Hitchen
Architects

Marathon House
The Sidings Business Park
Whalley, BB7 9SE

01254 823 885

www.peterhitchenarchitects.co.uk

NOTES:

No.	Description	Date
A	RE-SUBMISSION: REVISED TO REFLECT THE WORKS AS BUILT ON SITE	27/10/23

CLIENT: Mr and Mrs Fleetwood
45 Abbeyfields
Whalley
Lancashire
BB7 9RS

PROJECT:
PROPOSED SIDE EXTENSION
AND OTHER ALTERATIONS

SHEET:
PROPOSED ELEVATIONS 1

Project number PHA/757

Date 07/11/2023

Drawn by LW

Checked by PH

A3.3

Scale 1 : 50

Sheet size A1