




1 0 PROPOSED STORE FLOOR PLAN
1 : 25

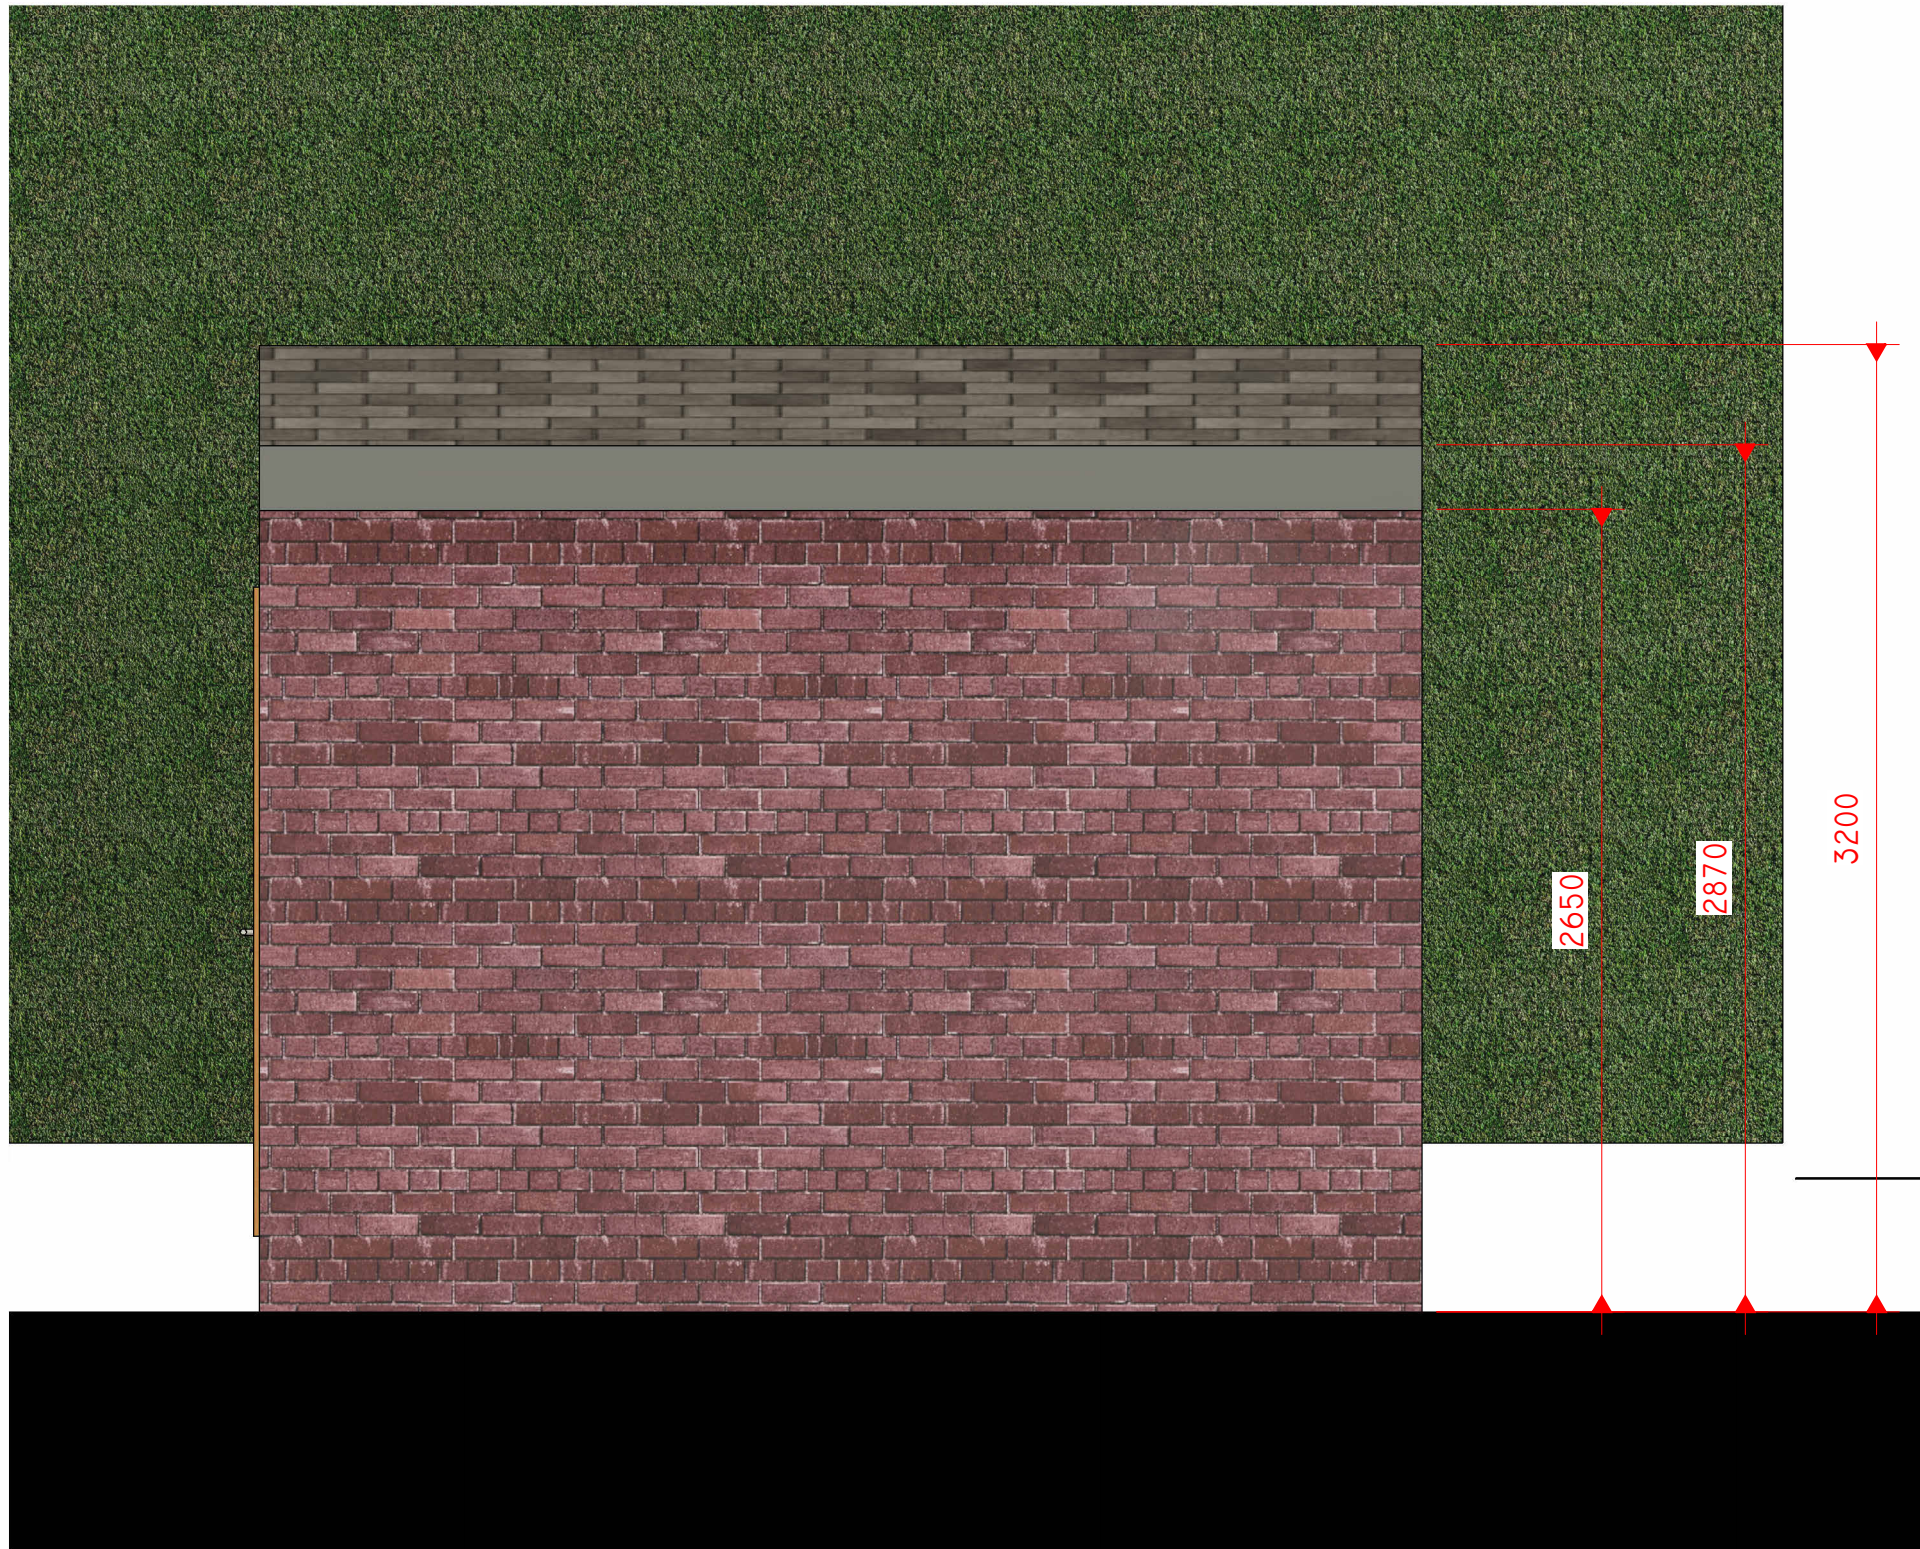


2 GARDEN STORE SOUTH ELEVATION
1 : 25

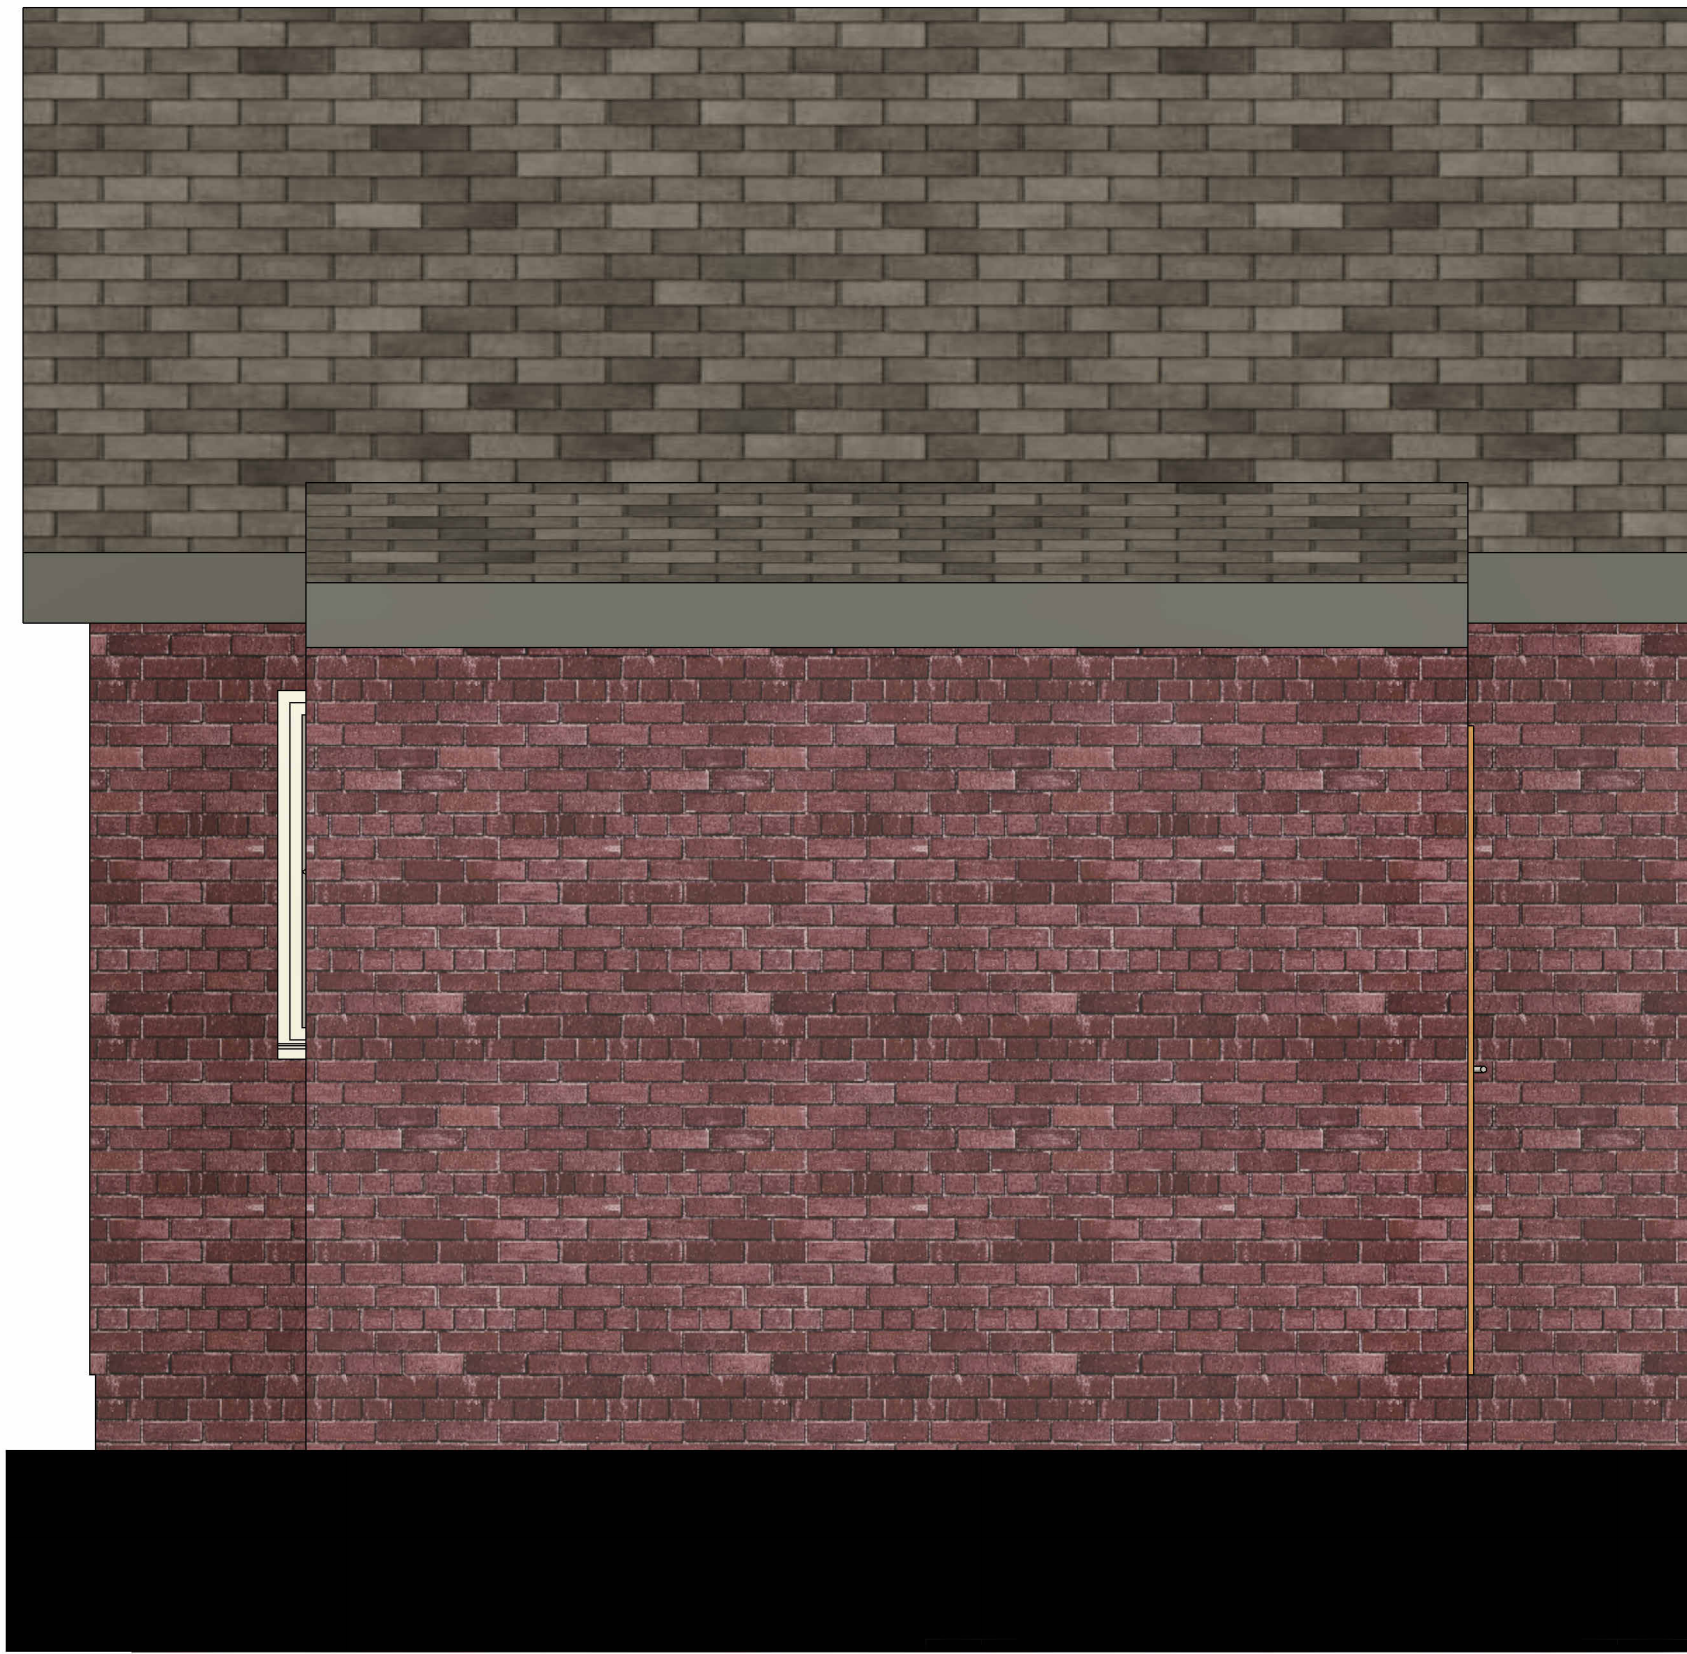

3 GARDEN STORE NORTH ELEVATION
1 : 25

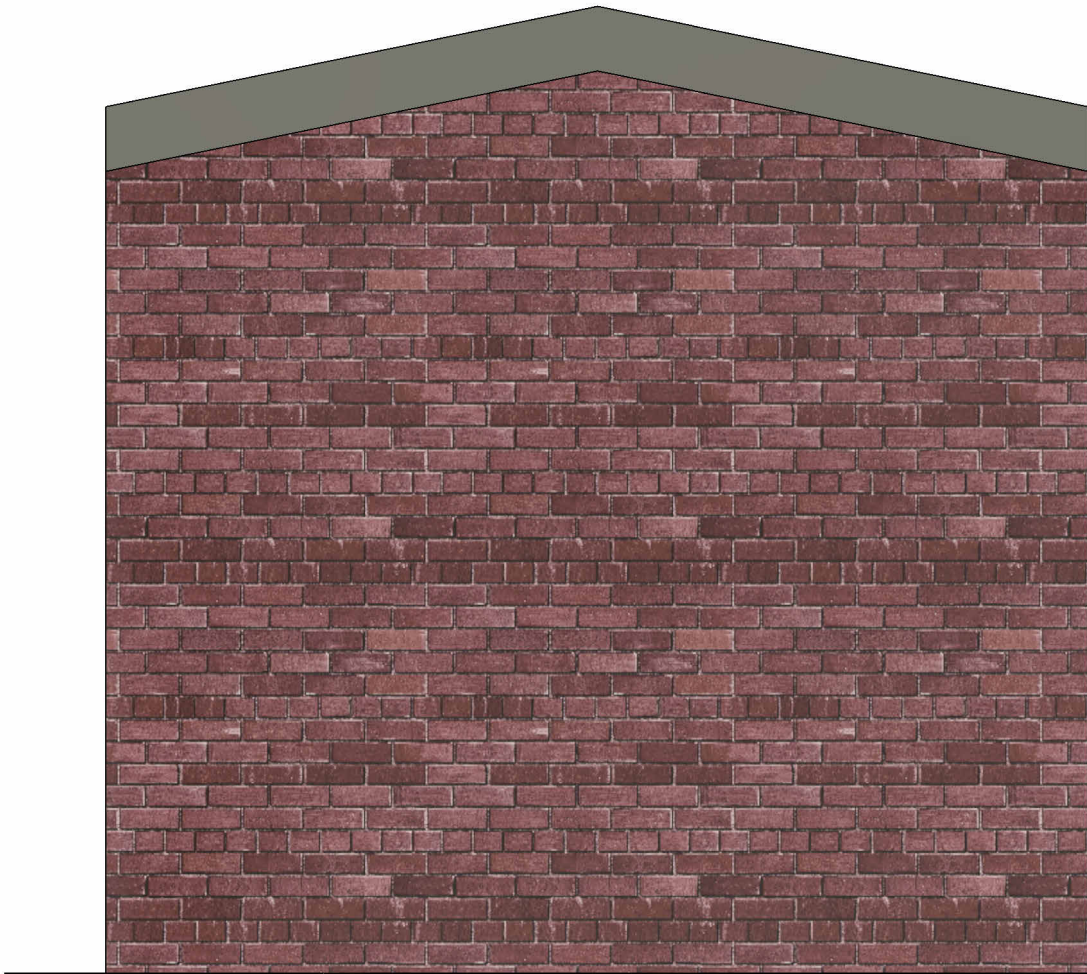

4 GARDEN STORE EAST ELEVATION
1 : 25

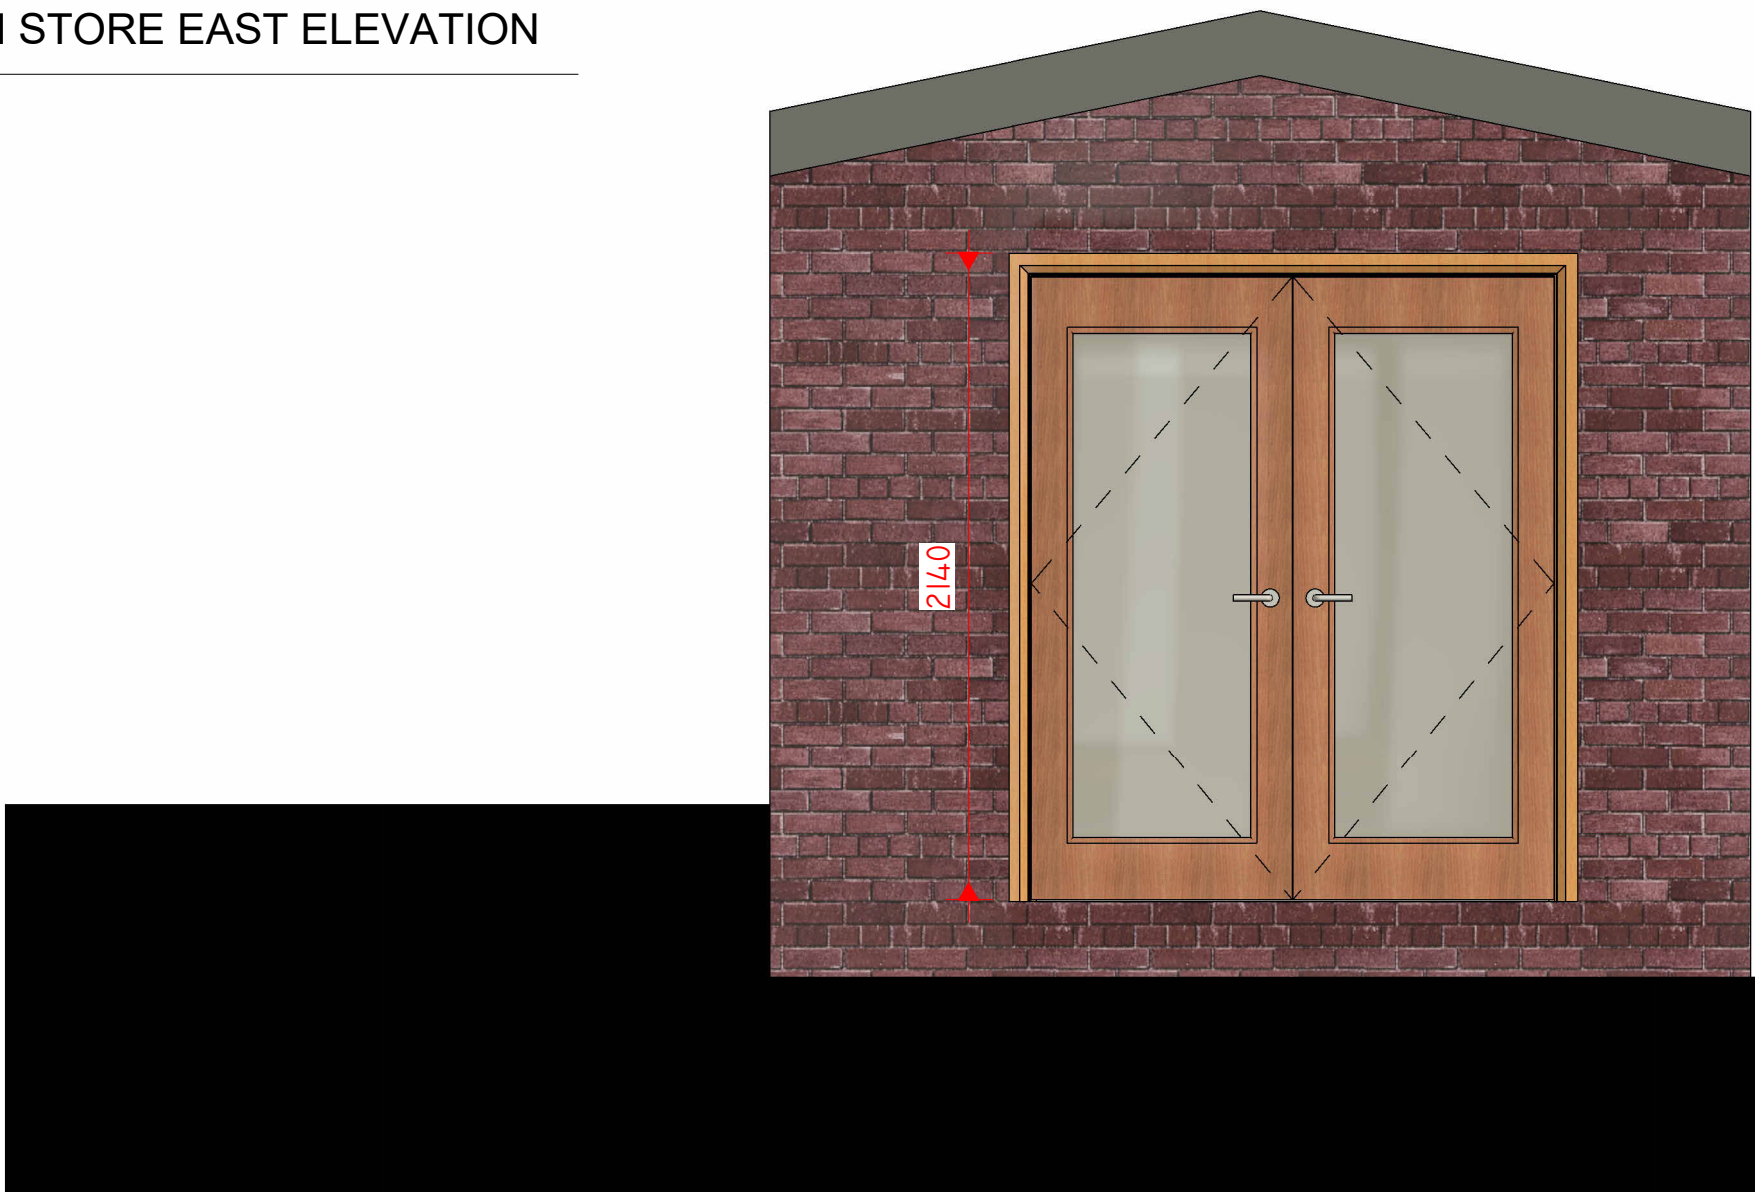

5 GARDEN STORE WEST ELEVATION
1 : 25

Peter Hitchen
Architects

Marathon House
The Sidings Business Park
Whalley, BB7 9SE

01254 823 885

www.peterhitchenarchitects.co.uk

NOTES:

No.	Description	Date
A	RE-SUBMISSION: REVISED TO REFLECT THE WORKS AS BUILT ON SITE	27/10/23

CLIENT: Mr and Mrs Fleetwood
45 Abbeyfields
Whalley
Lancashire
BB7 9RS

PROJECT:
PROPOSED SIDE EXTENSION
AND OTHER ALTERATIONS

SHEET:
PROPOSED PLANS GARDEN
STORE

Project number PHA/757

Date 31/10/2023

Drawn by LW

Checked by PH

A2.2.2

Scale 1 : 25

Sheet size A1