

NOTES:-

Retrospective boundary treatment:

Concrete post 100mm by 135mm infilled with pressure treated timber close boarded arch fence panels 1600mm high by 1800mm wide, sat on 300mm concrete base boards with rock face finish (9nr bays) along Whalley Road.

Concrete post 100mm by 135mm infilled with pressure treated timber close boarded arch fence panels 1600mm high by 1800mm wide, sat on 300mm concrete base boards with rock face finish (3nr stepped bays) along Sunnyside Avenue.

REV	DESCRIPTION	DRAWN	CHK	APP	DATE
-----	-------------	-------	-----	-----	------

wmaconsulting

construction consultants

Chartered Quantity Surveyors
Chartered Building Surveyors
Project Managers
Principal Designers

info@wmaconsulting.co.uk
T: 01254 603310
M: 07894400616

status

PLANNING

client

Mr Javed Hingaliya
2 Sunnyside Avenue, Wilpshire
Blackburn, BB1 9LW

project title

Proposed Boundary Treatement

drawing title


Proposed Retrospective Front and Side Elevation Boundary Treatment

scale @ A2 on drwg	designed by WM	drawn by WM	checked by WM	approved by
-----------------------	-------------------	----------------	------------------	-------------


project no.

drawing no.	revision
SK 003	0

Do Not Scale From This Drawing

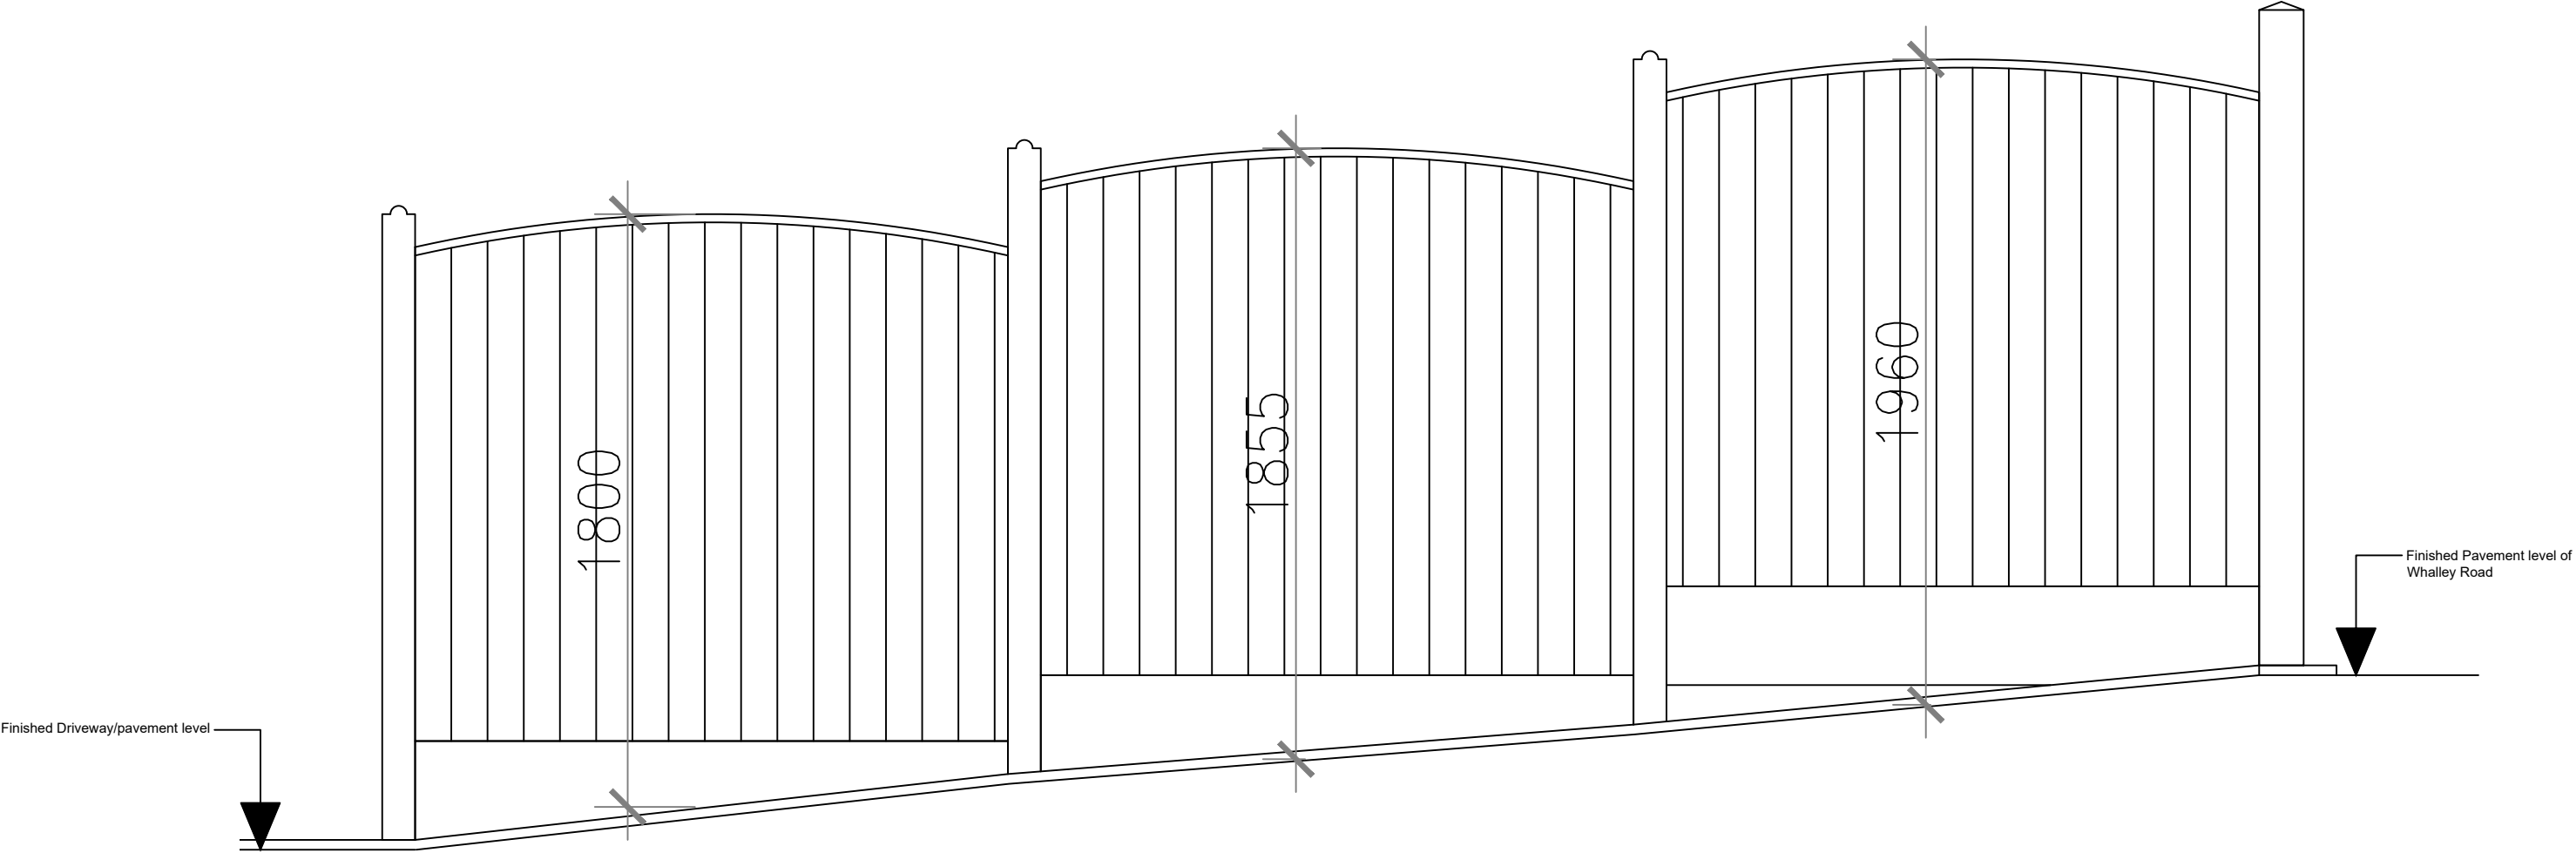

Proposed Retrospective Front Elevation Boundary (Sunnyside Ave)
Scale: 1:20

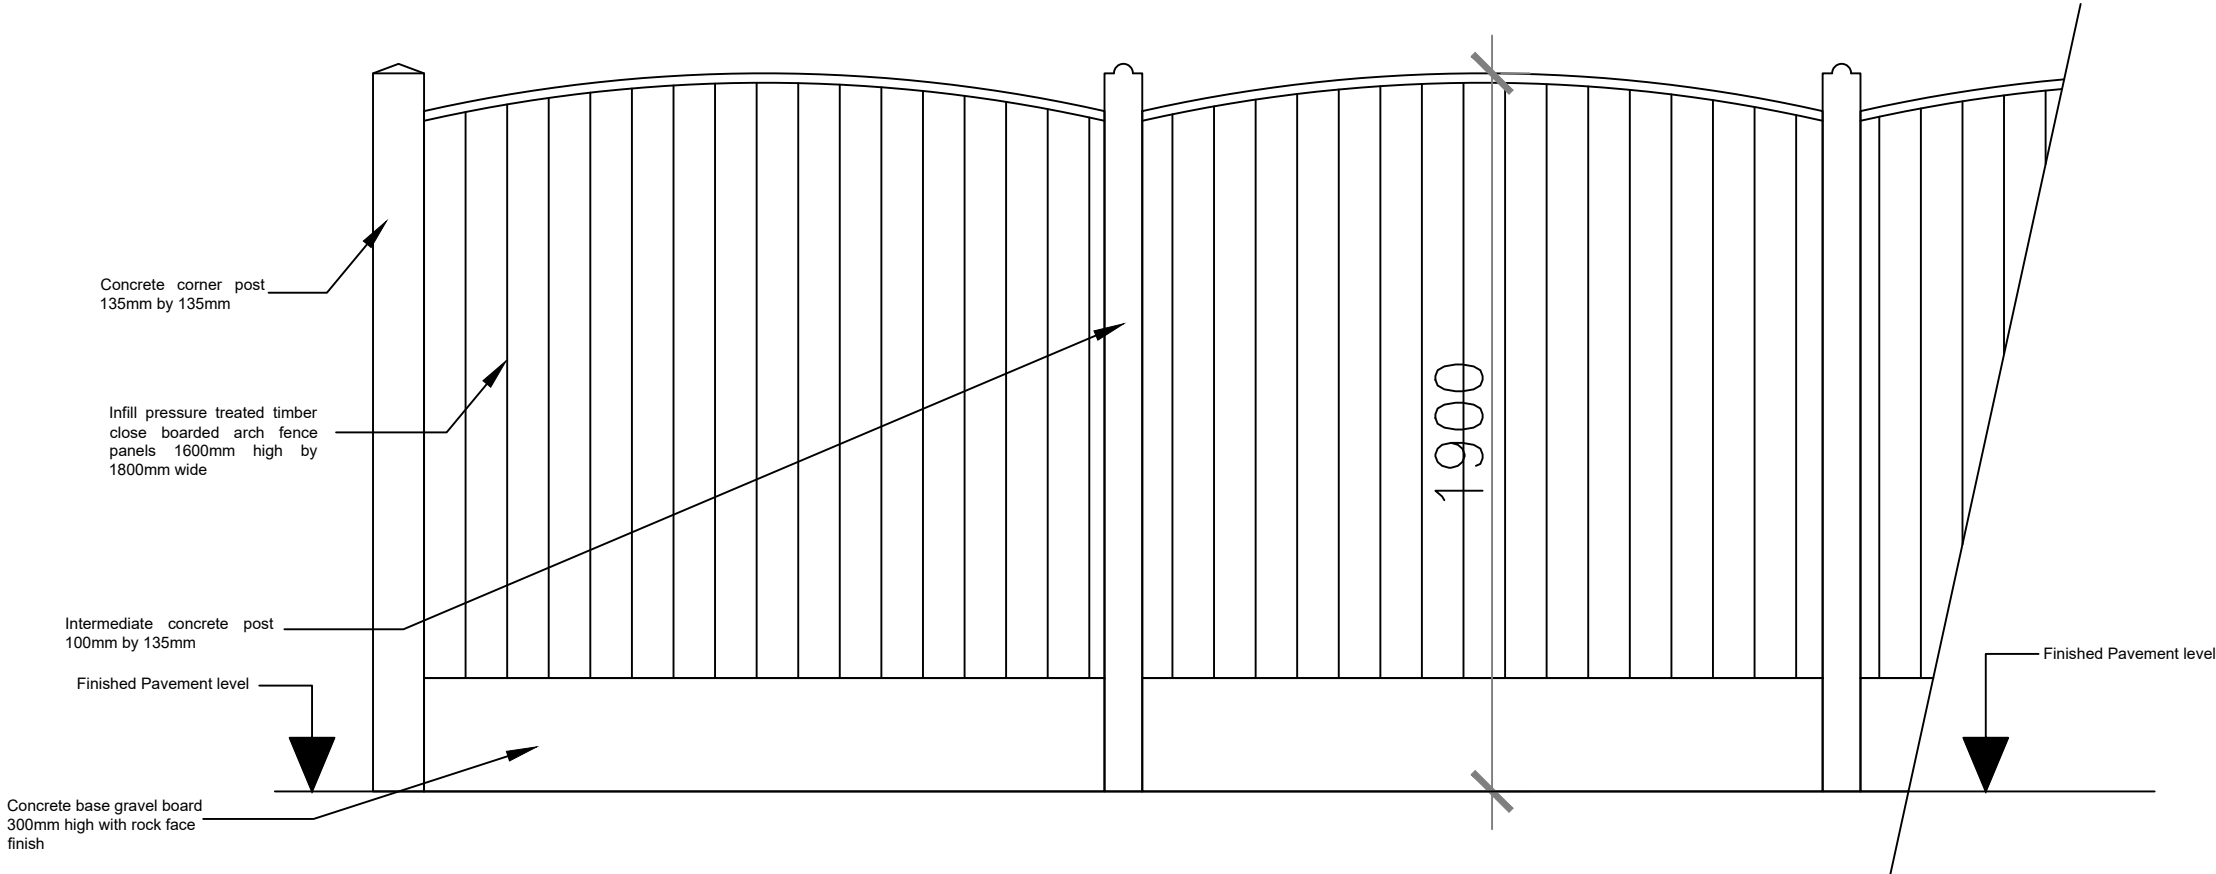

Proposed Retrospective Side Elevation Boundary Treatment (Whalley Road)
Scale: 1:20