


# THE BROOKS, BARROW AS-BUILT FLOOR LEVELS

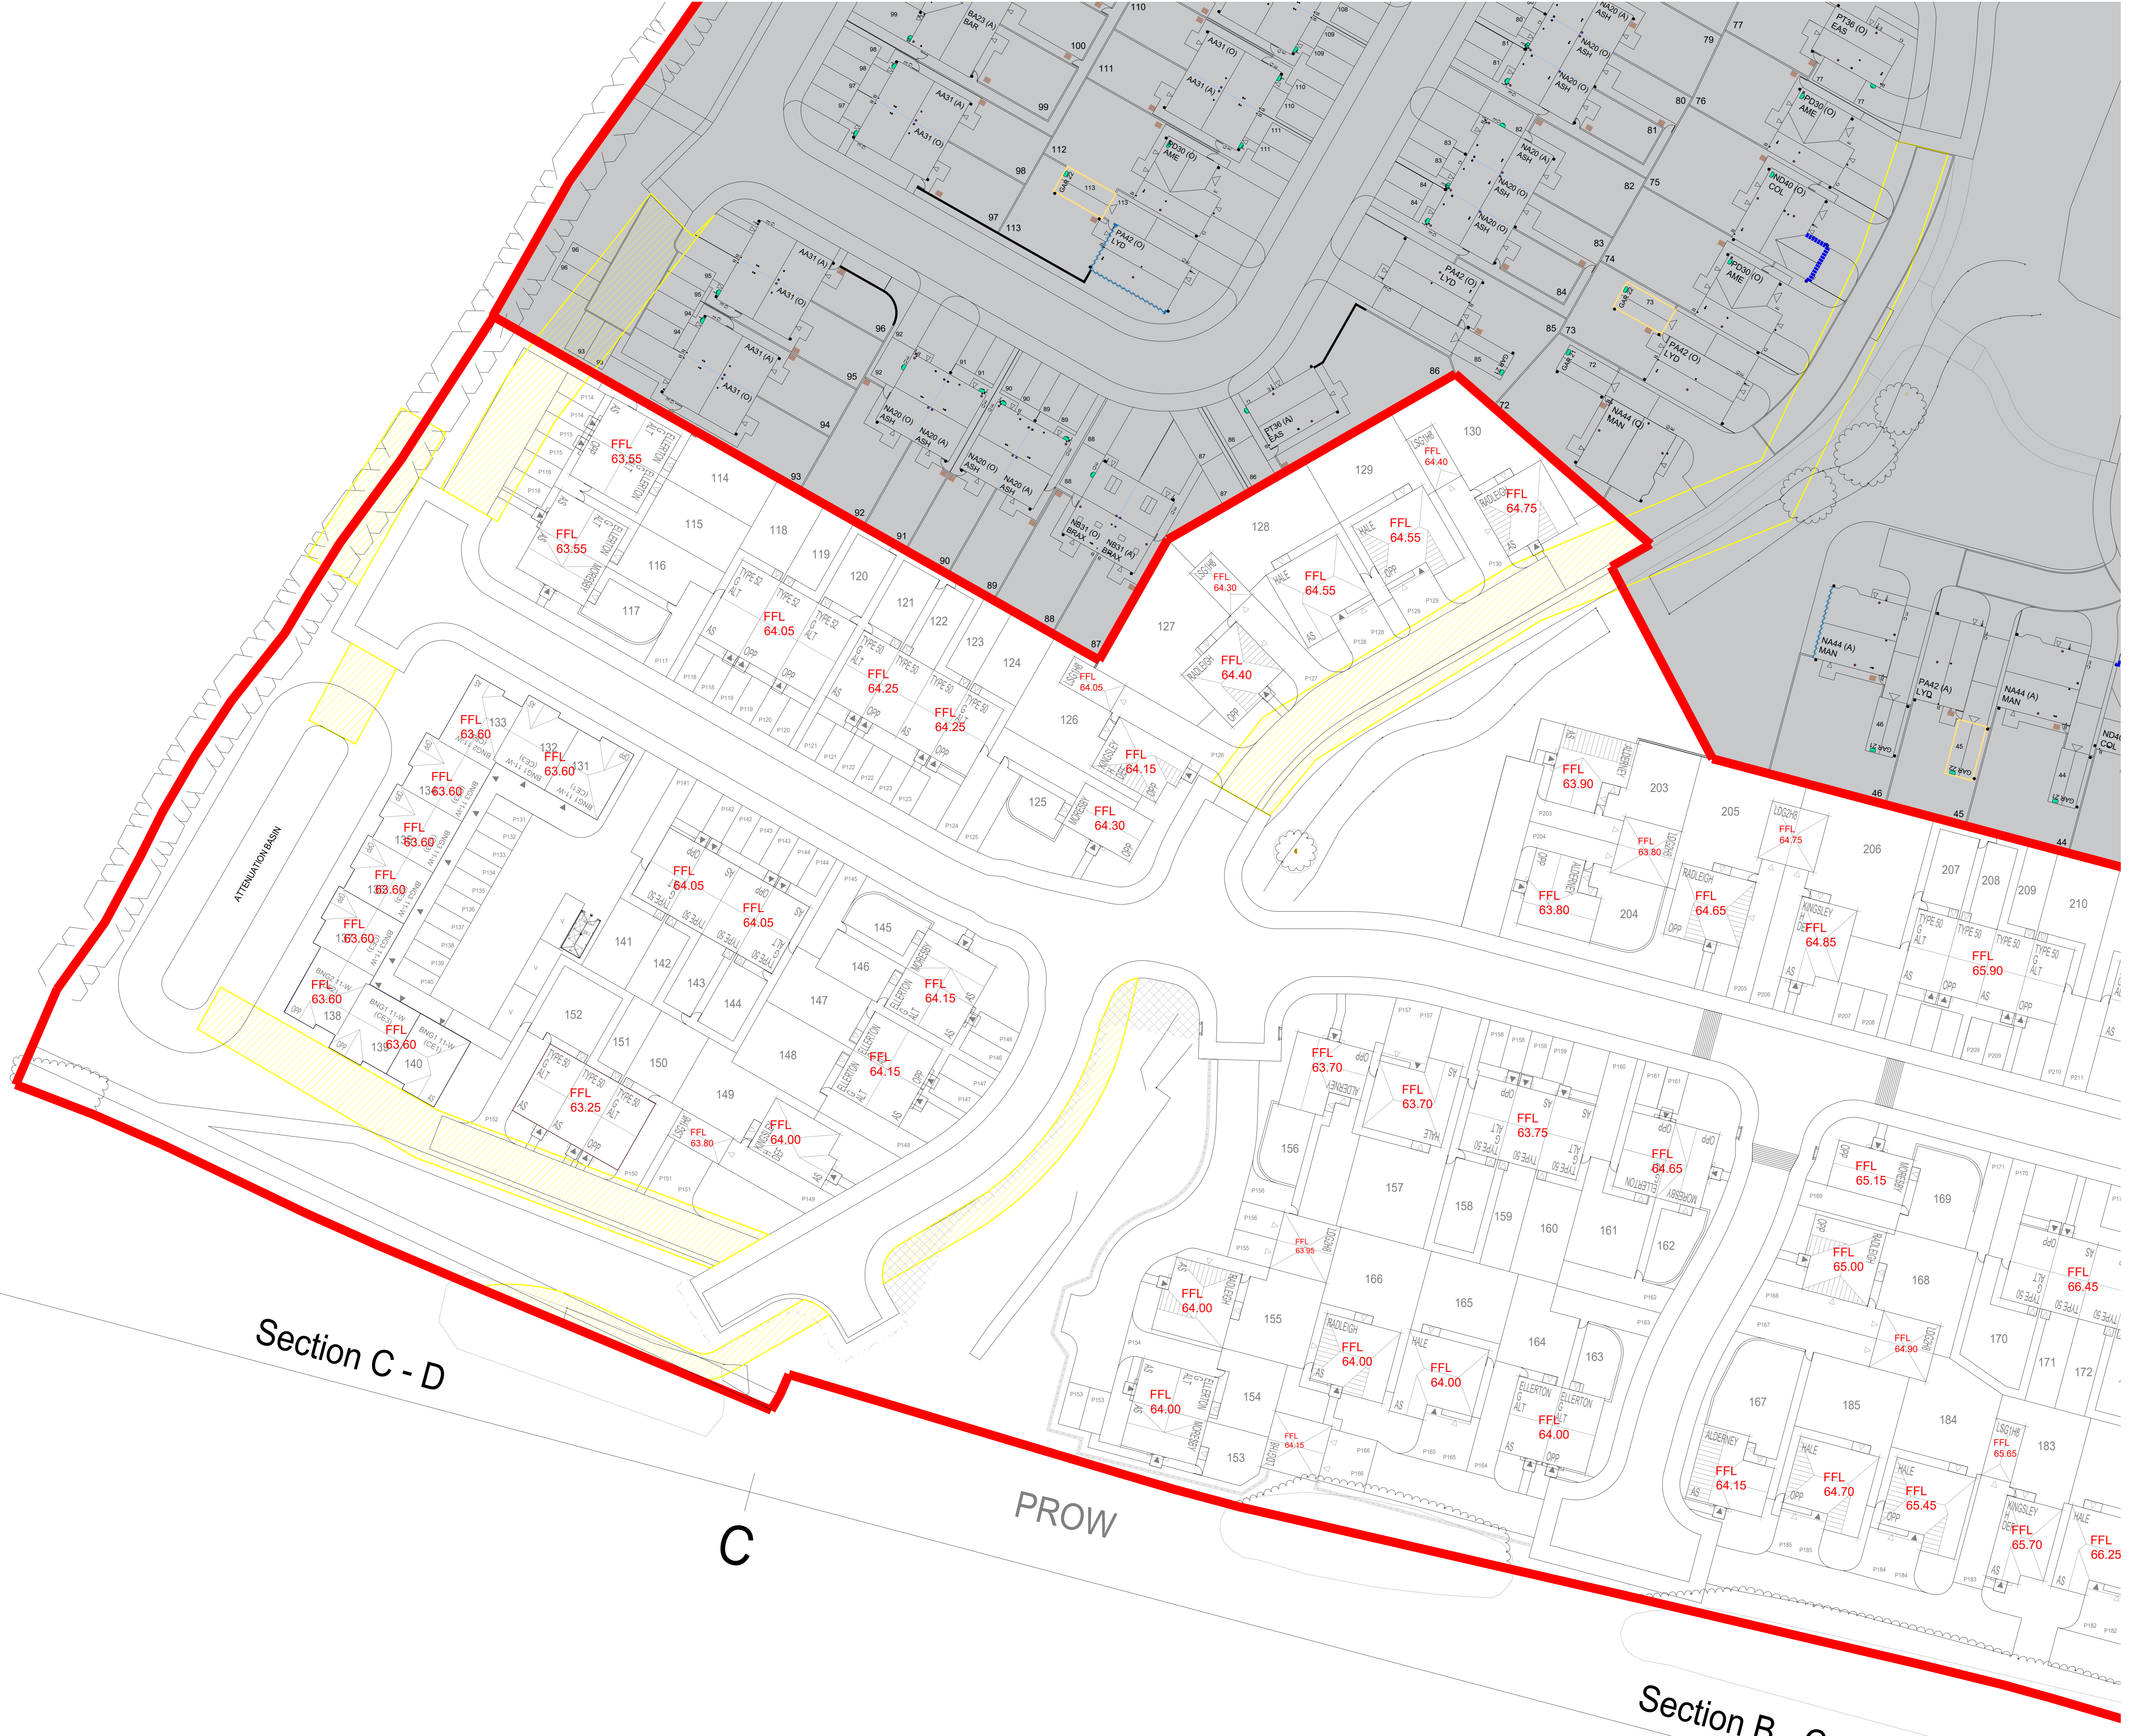

Section C - D

C

PROW

Section B - C

Key:

Rev	Amendment	Drawn/Date

**BARRATT HOMES**  
Barratt David Wilson Homes  
North West  
303 Bridgewater Place  
2nd Floor  
Warrington  
Cheshire  
WA3 6AF  
TEL: 01925 846600

**DAVID WILSON HOMES**  
WHERE QUALITY LIVES

Project  
**The Brooks  
Barrow**

Drawing Title  
**As-built floor levels  
Sheet 2**

Status  
**For Issue**

Scale  
1:500 @ A0

Date  
30.08.23

Drawn By  
JM

Drawing Ref  
**H7863-FL2**

Revision  
-

