




	Description	By	Date
P01	Initial Issue	LM	15.05.24
P02	Roof Changes	LM	16.05.24
P03	Drawing Name Change	LM	16.07.24

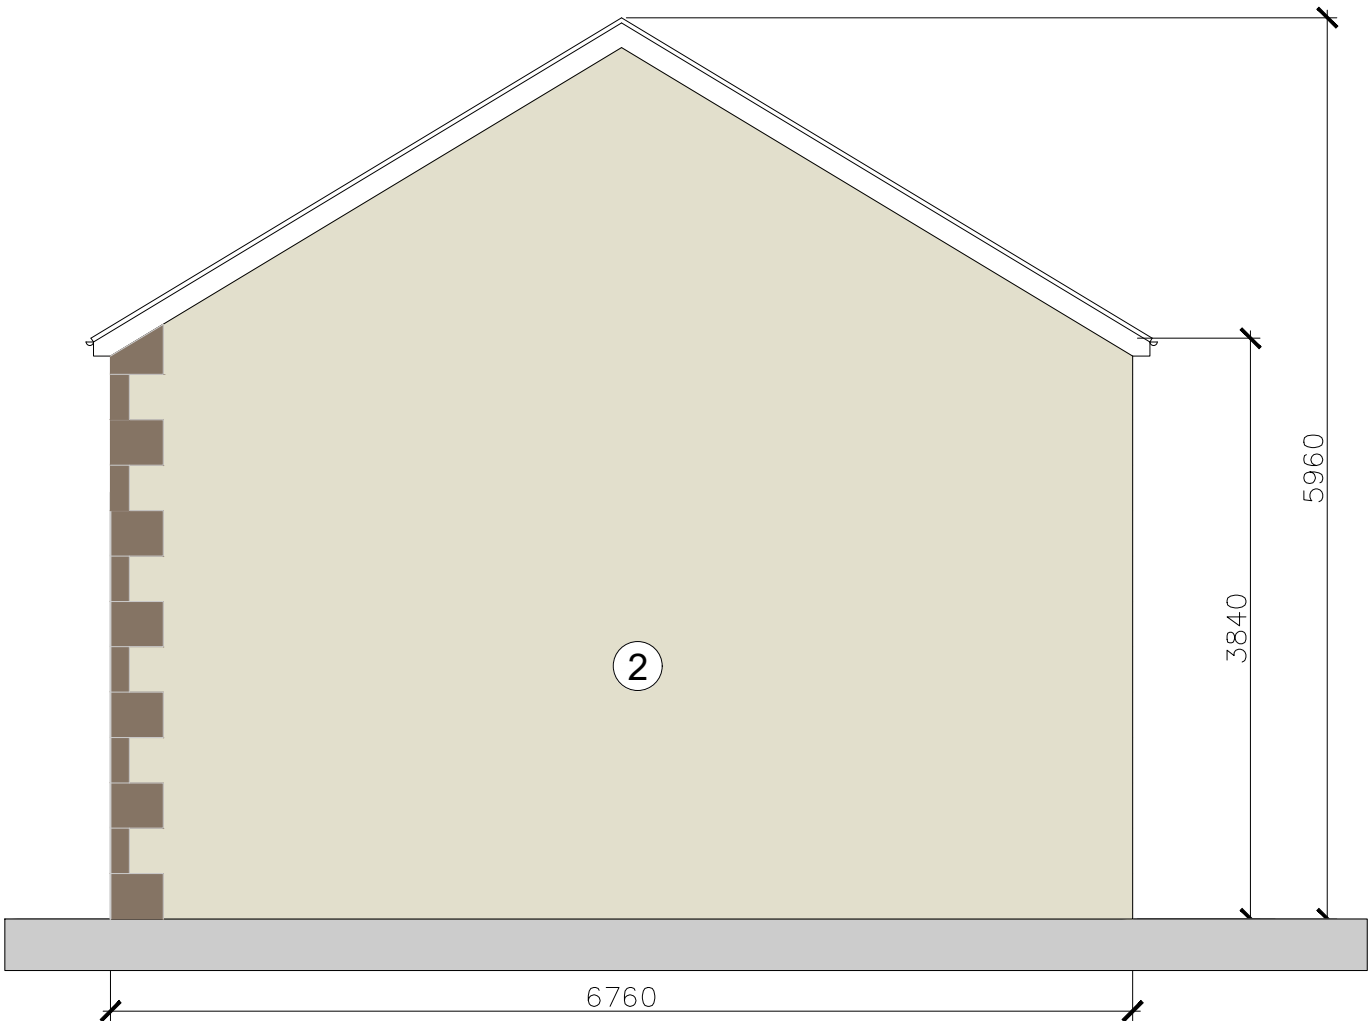


1 As Built North Elevation
Scale 1:50

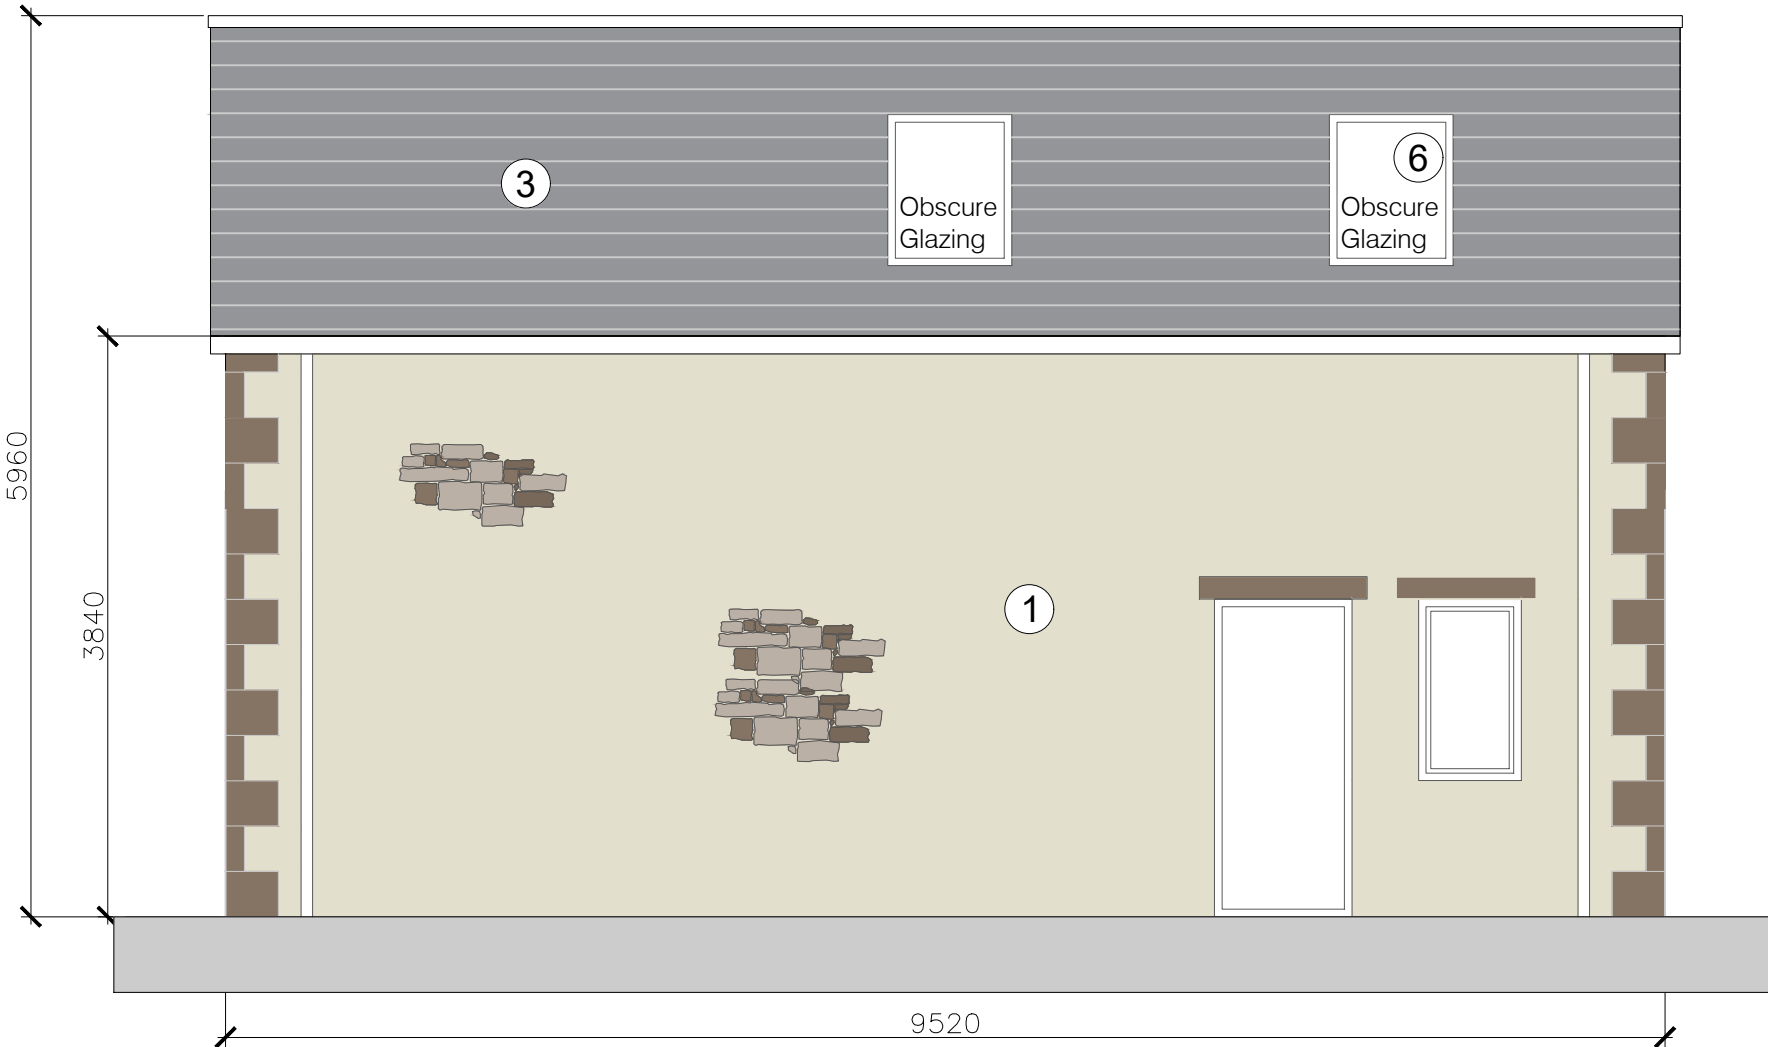


2 As Built East Elevation
Scale 1:50

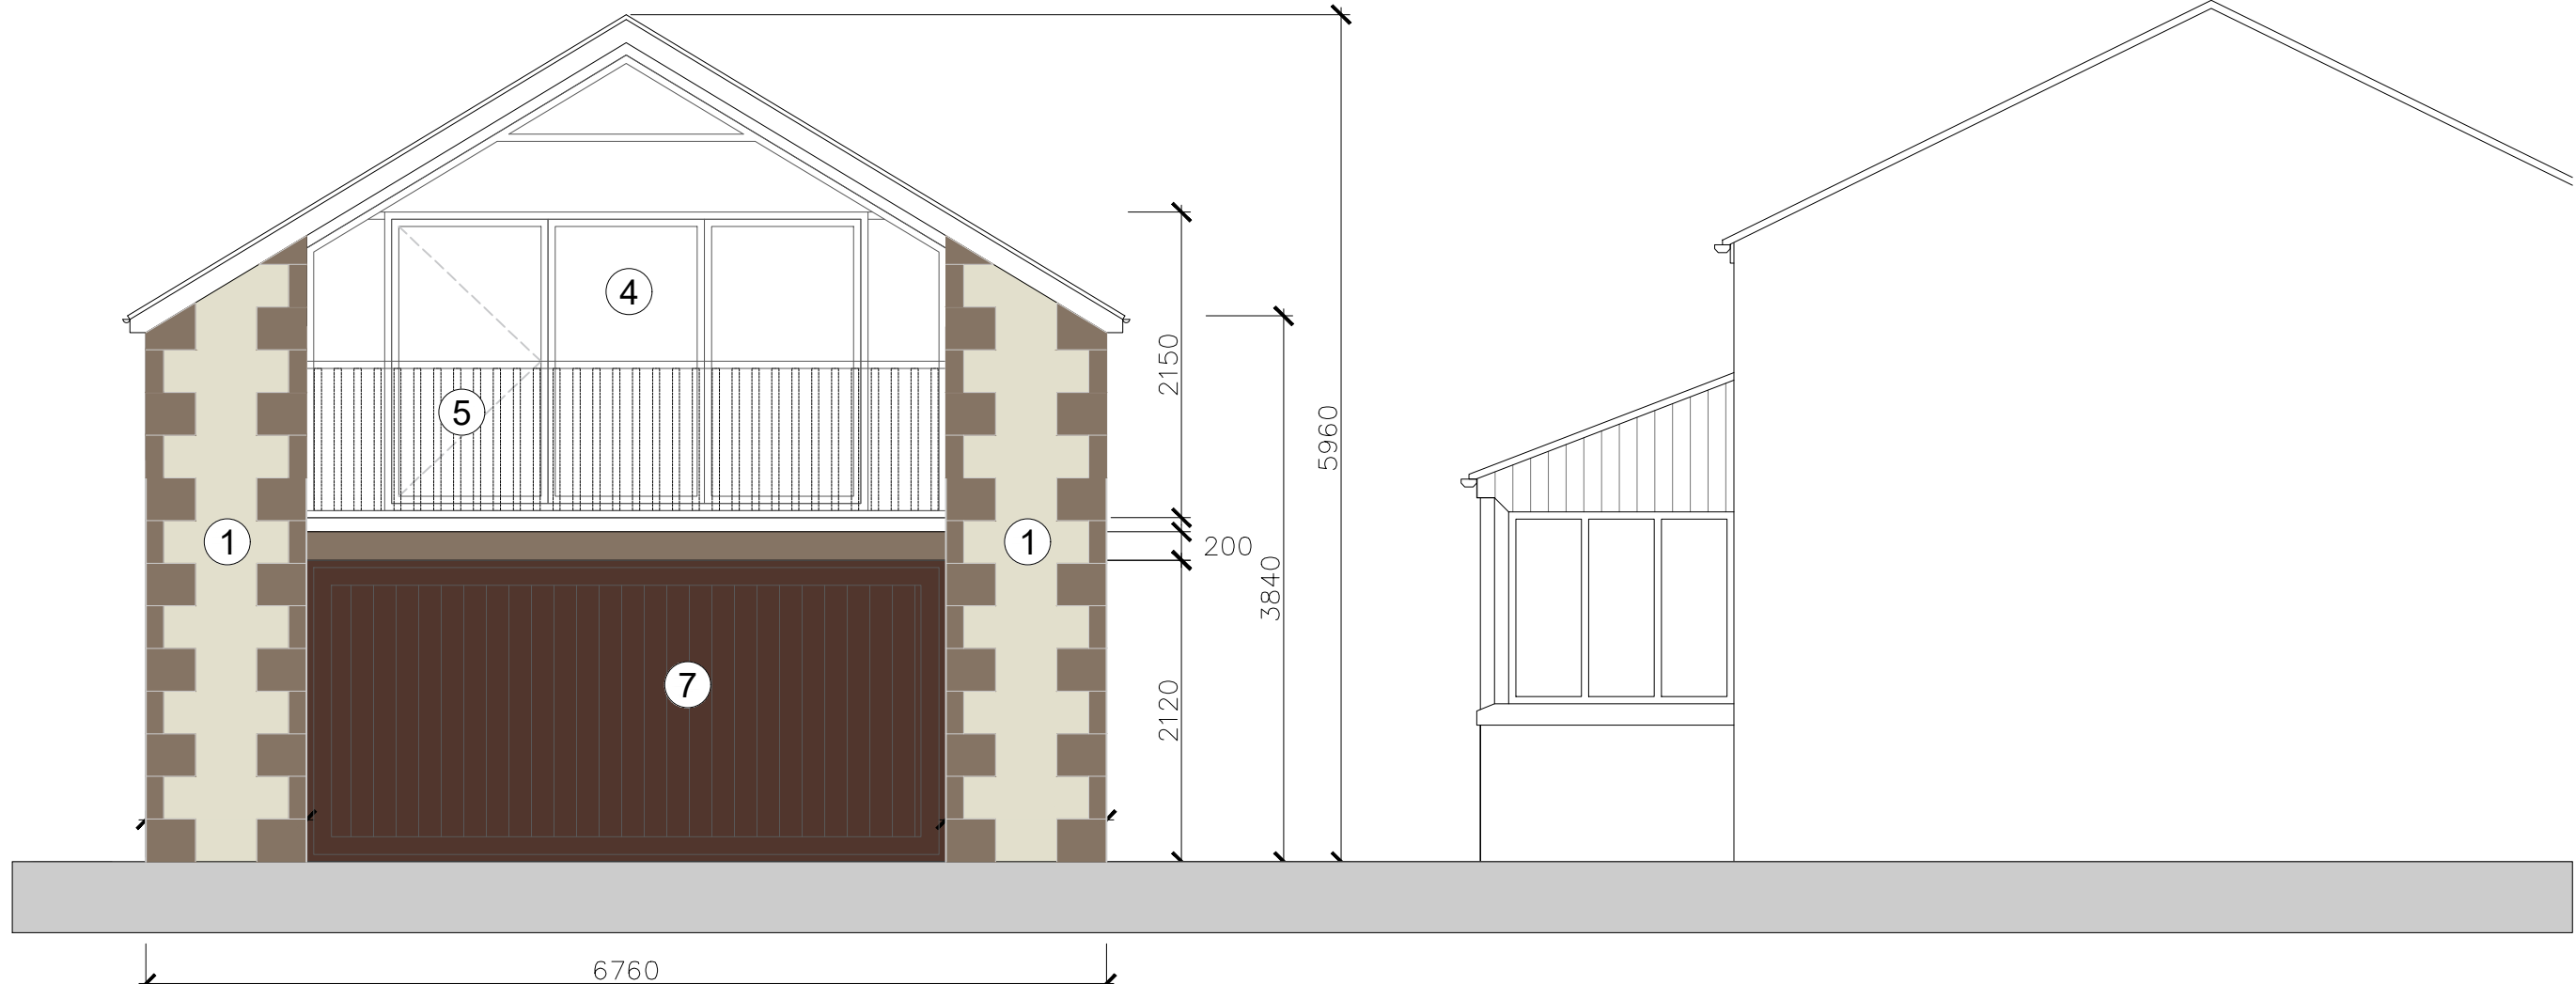

3 As Built South Elevation
Scale 1:50

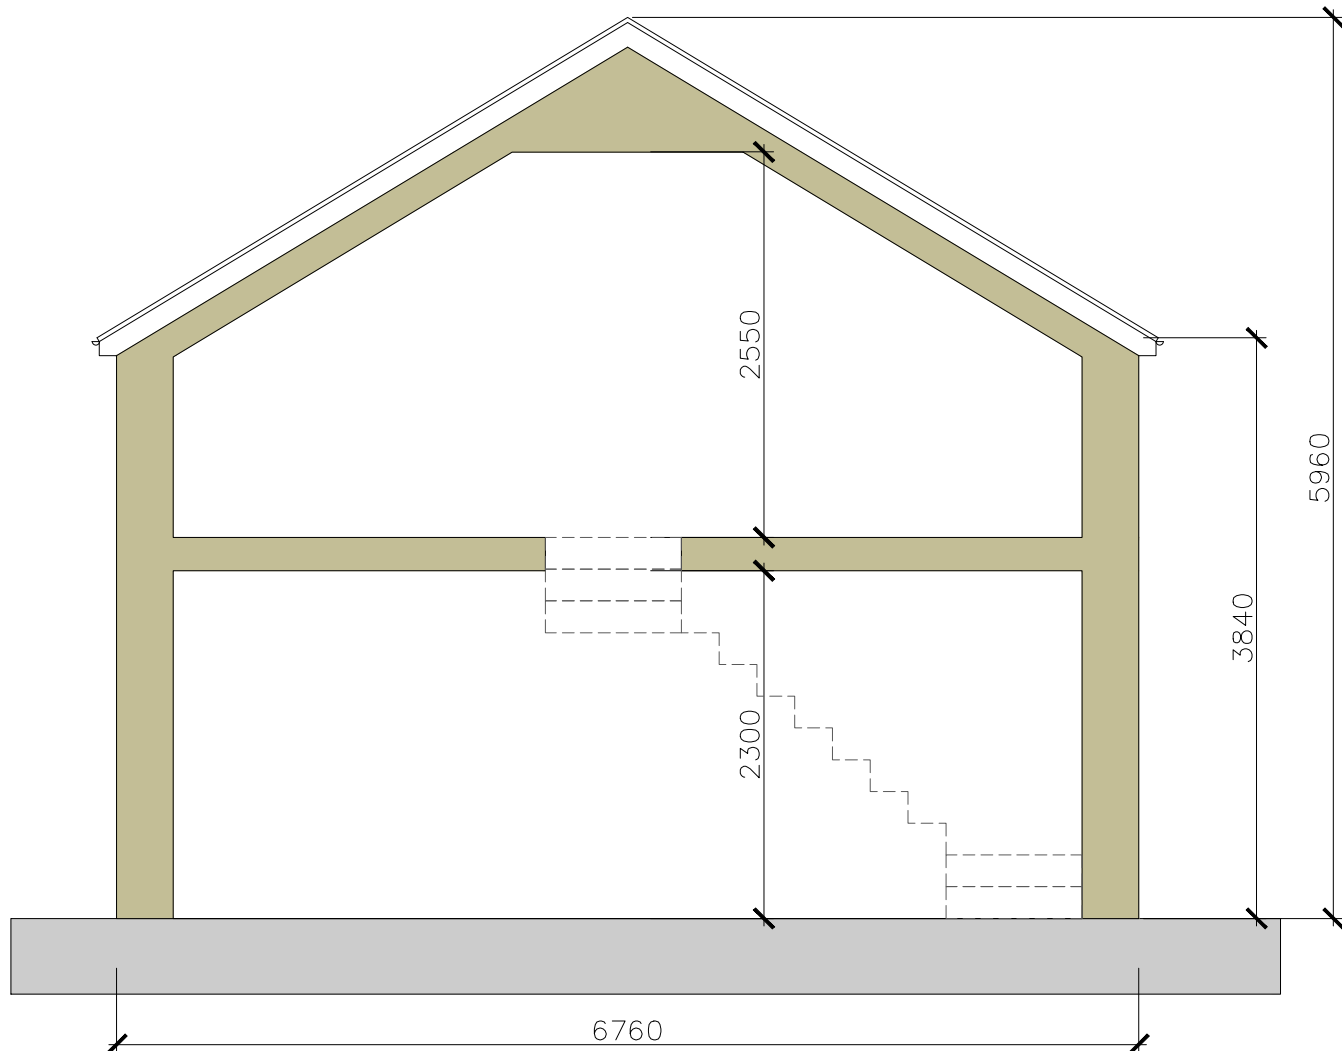

4 As Built Cross Section
Scale 1:50

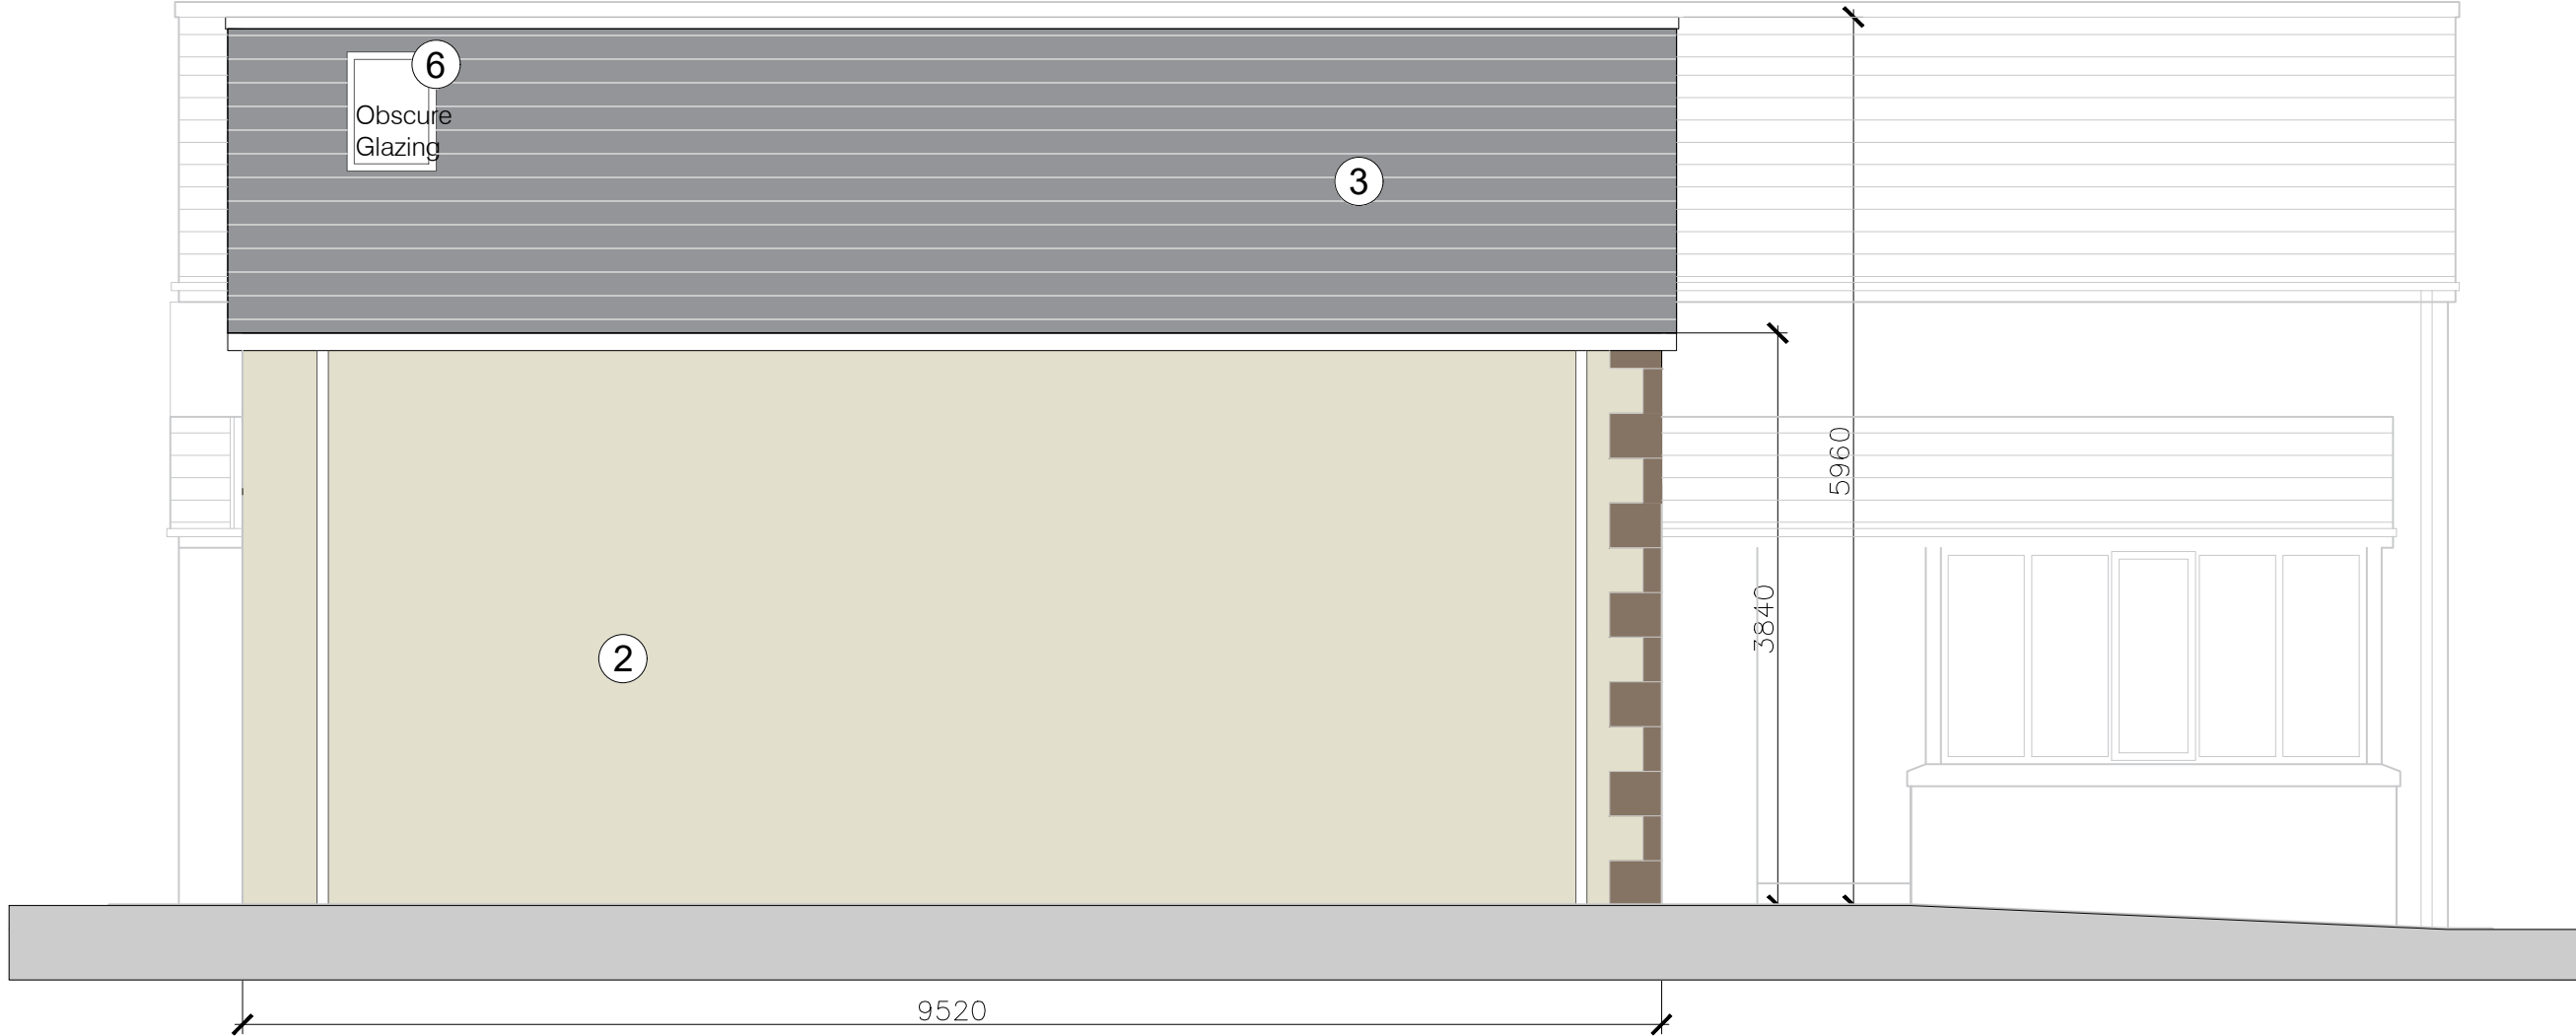


5 As Built West Elevation
Scale 1:50

P03 - Drawing name changed from 'Proposed' to 'As Built' as per planning request

Material Key

- 1 | Stonework
- 2 | Render
- 3 | Slate
- 4 | PPC Inward Folding Doors
- 5 | Steel Juliet Balcony
- 6 | PPC Obscure Roof Lights
- 7 | Timber Garage Door

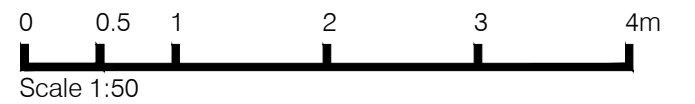

MC

AU

Modern City

Architecture & Urbanism

Avenue HQ

17 Mann Island

Liverpool

L3 1BP

t: 0161 974 7203

e: info@mcau.co.uk

www.mcau.co.uk

Client
Mr & Mrs Richardson
Project
Riverside Barn, Longridge

Description
As Built Elevations and Sections

Status	Planning	Drawn By	LM
Job Number	SP178-MCAU	Scale	1:50@A1
Drawing Number	P.05-XX-002	Date	May 24
		Revision	P03