




	Description	By	Date
P01	Initial Issue	LM	15.05.24
P02	Roof Changes	LM	16.05.24
P03	Drawing Name Changed	LM	16.07.24

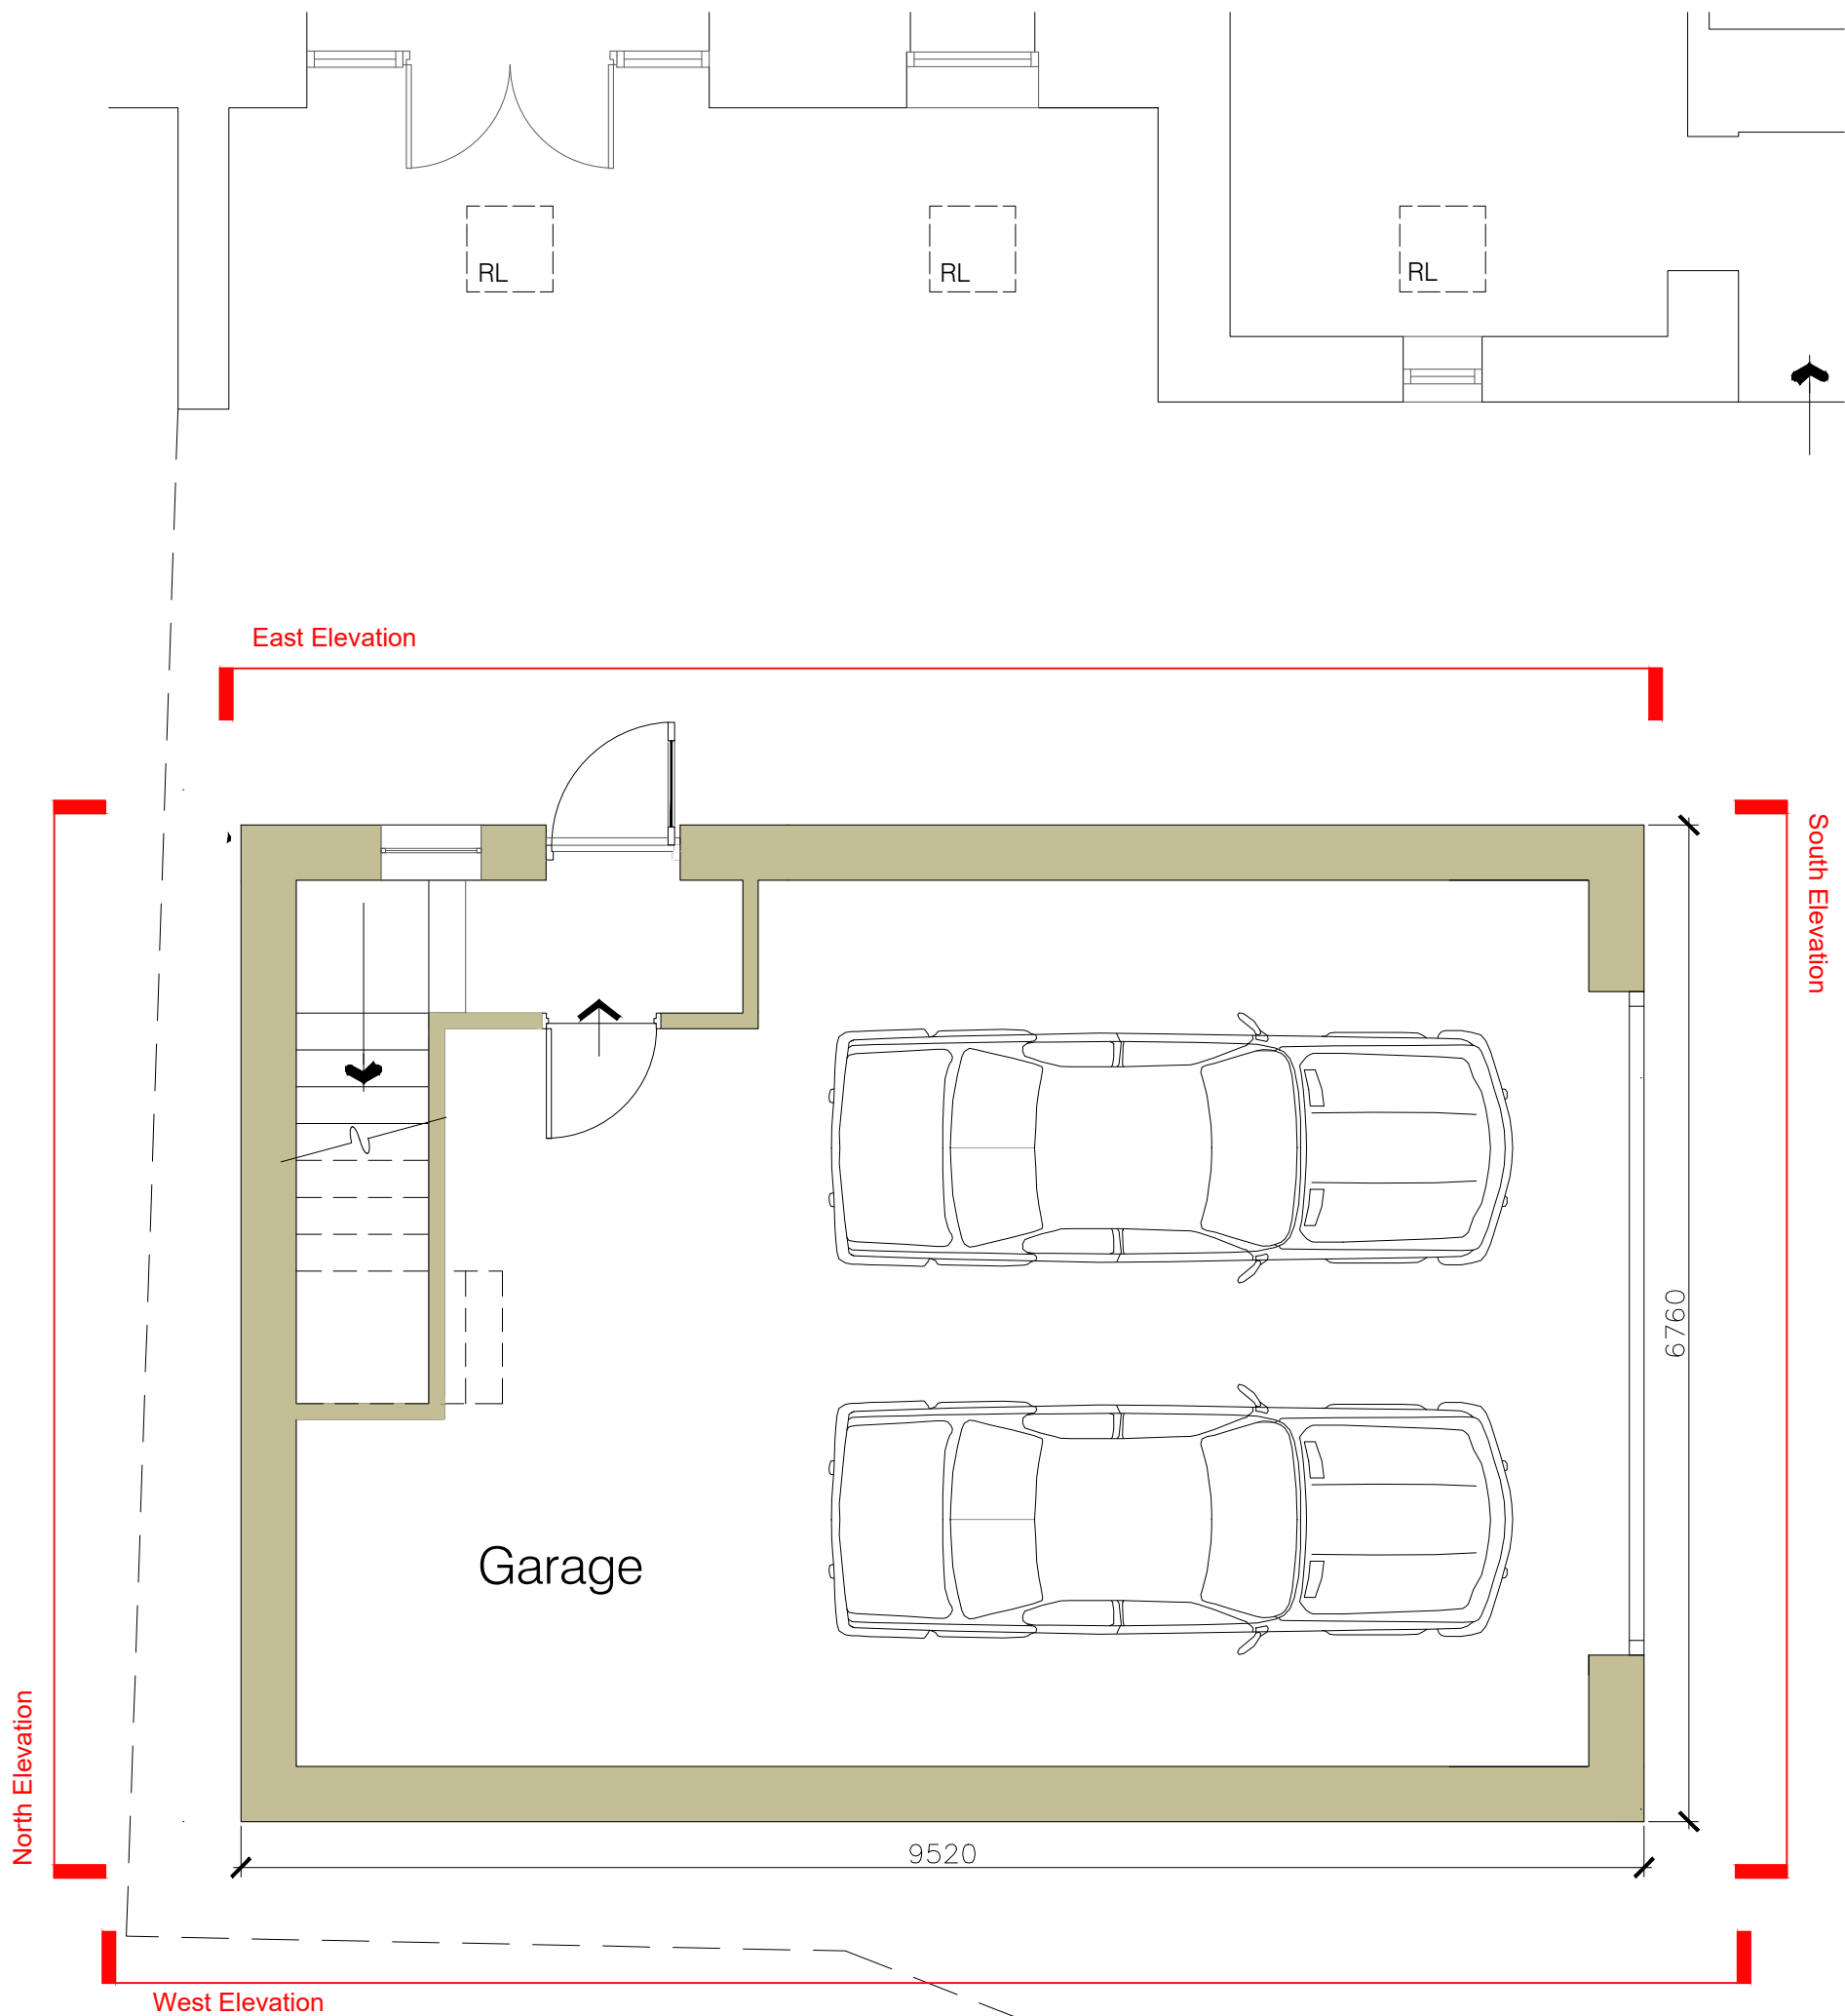

3 As Built Roof Plan

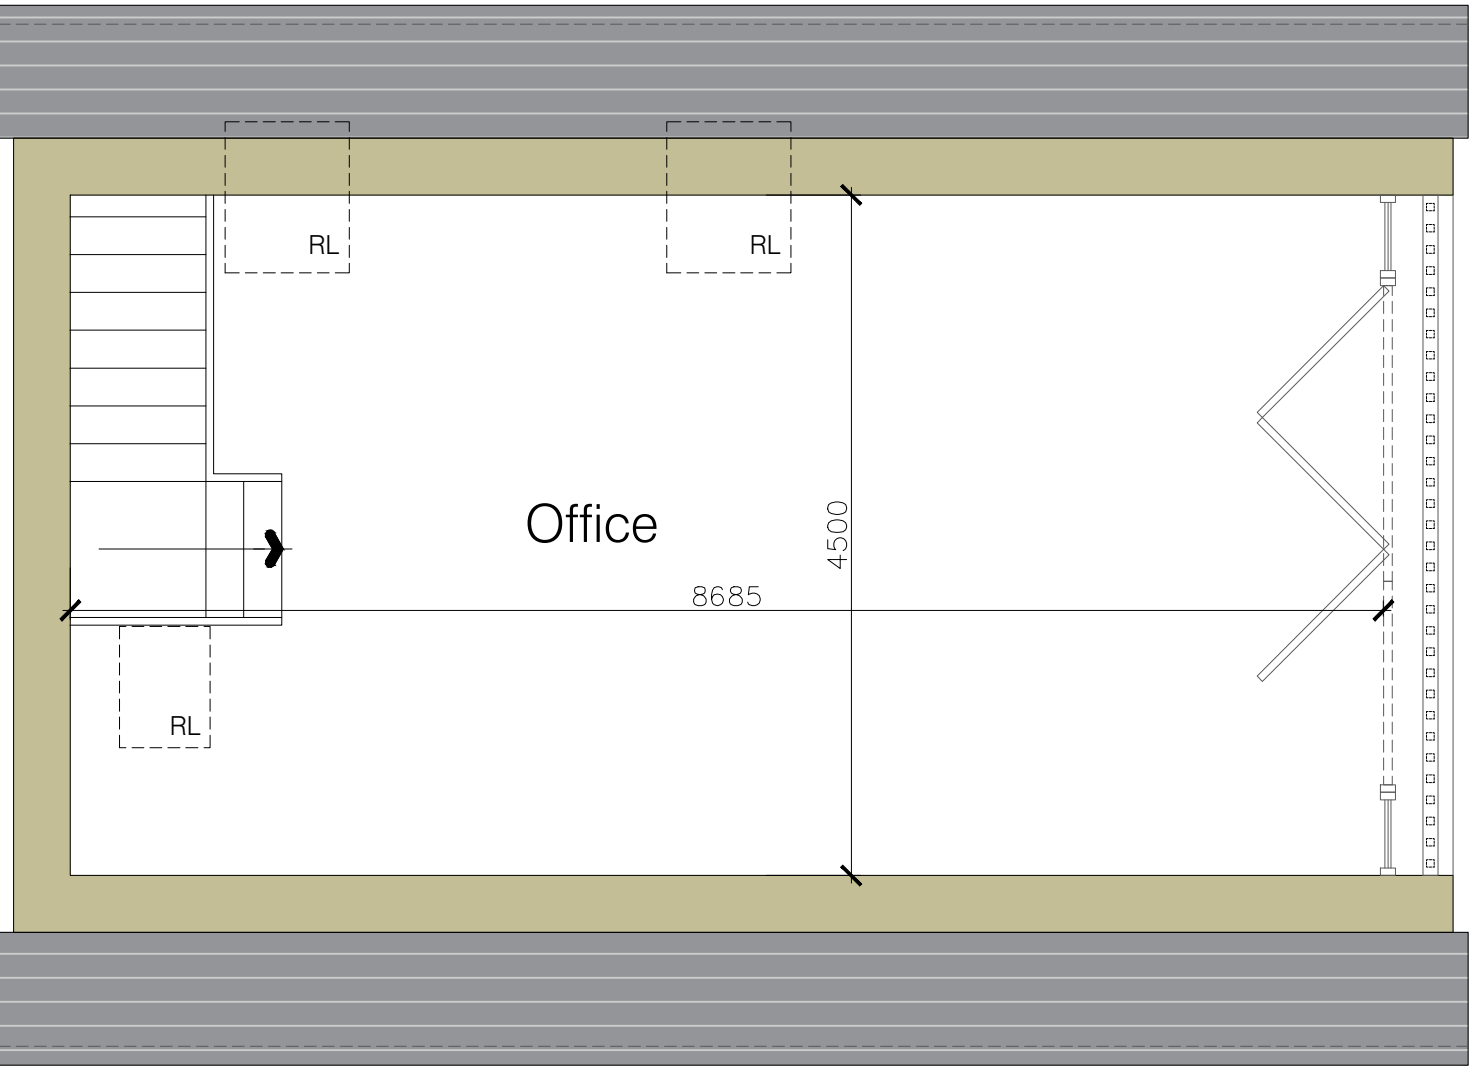

P03 - Drawing name changed from 'Proposed' to 'As Built' as per planning request

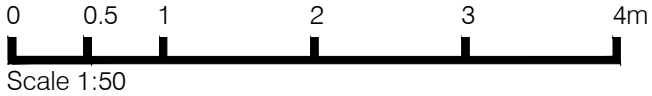

MC

AU

Modern City

Architecture & Urbanism

Avenue HQ

17 Mann Island

Liverpool

L3 1BP

t: 0161 974 7203

e: info@mcau.co.uk

www.mcau.co.uk

Client
Mr & Mrs Richardson

Project
Riverside Barn, Longridge

Description
As Built Floor Plans

Status	Planning	Drawn By	LM
Job Number	SP178-MCAU	Date	May 24
Drawing Number	P.03-ZZ-002	Revision	P03