

NOTES


THIS DRAWING IS TO BE READ IN CONJUNCTION WITH ALL OTHER DRAWINGS FOR THIS PROJECT. ALL LEVELS AND DIMENSIONS ARE TO BE CHECKED ON SITE BY THE CONTRACTOR, PRIOR TO PLACING ORDERS OR COMMENCING ANY OF THE RELEVANT WORKS. ALL DIMENSIONS ARE IN MILLIMETRES UNLESS STATED OTHERWISE. ANY DISCREPANCIES BETWEEN THE INFORMATION SHOWN ON THE PLAN AND THAT FOUND ON SITE ARE TO BE REPORTED TO THE DESIGNER IMMEDIATELY.

NEW PROFILED SHEET ROOFING TO UNIT IN MOCK TIMBER BOARDING COLOUR TO BE GREEN ON TOP OF PROFILED SHEET UNDERLAY

NEW PROFILED SHEET WALLING TO UNIT IN MOCK TIMBER BOARDING COLOUR TO BE GREEN ON TOP OF PROFILED SHEET UNDERLAY

NEW PVC GUTTERS FORMED IN BLACK SHAPED SQUARE WITH SQUARE DOWNPIPES

NEW ROLLER SHUTTER DOORS FULL HEIGHT TO ALLOW FOR STORAGE AND ACCESS COLOUR TO BE GOOSEWING GREY

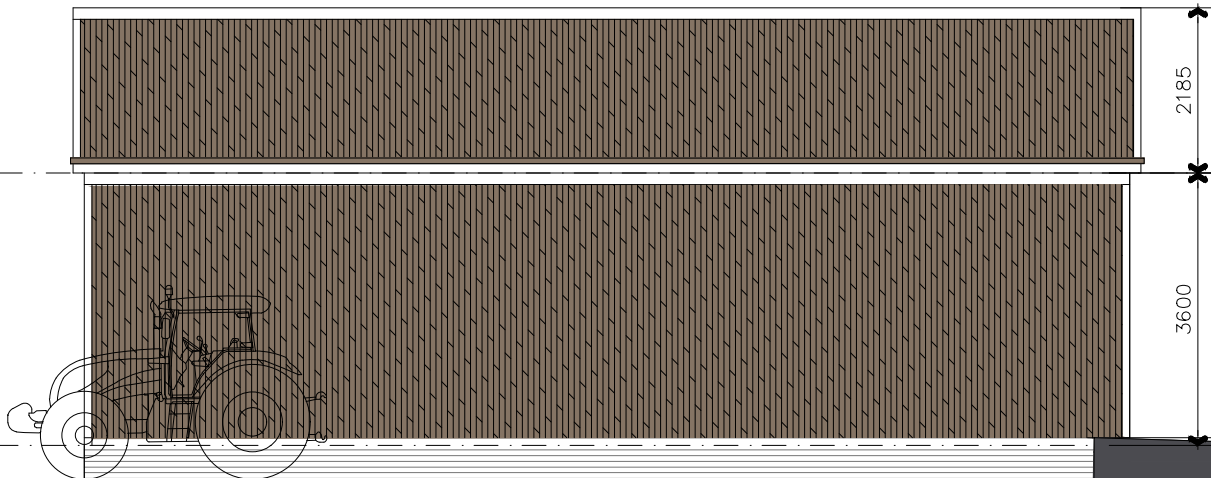

NORTH ELEVATION

EAST ELEVATION

- D 10.10.24 door colour amended for planner
- C 13.06.24 Title amended to suit planner
- B 17.05.24 plan amended to suit as built on site
- A 08.02.21 plan amended to suit planners comments 05.02.21

Rev.	Date	Description
------	------	-------------

A.L.H. Design Services
Barley Cottage, Brewery Street, Longridge, Lancs
PR3 3NB, Tel & Fax : (01772) 785719

Client

Mr & Mrs S Rich,
Stella Maris,
Alston Lane,
Nr Preston Lancs,
PR3 3BN
Job/Scheme Title

ERECTION OF AGRICULTURAL
UNIT ON VACANT LAND AND
ASSOCIATED SITE WORKS

Drawing Title

PROPOSED ELEVATIONS
(Sheet 2 of 2)

Job/Scheme Number	Drawing Number
-------------------	----------------

0591/93 Drawing No 16D

Scale	Date	Drawn	Checked
-------	------	-------	---------

1 / 100 | Nov 20 | a.t.l-h. |