


NOTES:
THIS DRAWING IS TO BE READ IN CONJUNCTION WITH ALL OTHER DRAWINGS FOR THIS PROJECT.
ALL LEVELS AND DIMENSIONS ARE TO BE CHECKED ON SITE BY THE CONTRACTOR, PRIOR TO
PLACING ORDERS OR COMMENCING ANY OF THE RELEVANT WORKS.
ALL DIMENSIONS ARE IN MILLIMETRES UNLESS STATED OTHERWISE.
ANY DISCREPANCIES BETWEEN THE INFORMATION SHOWN ON THE PLAN AND THAT FOUND ON
SITE ARE TO BE REPORTED TO THE DESIGNER IMMEDIATELY.

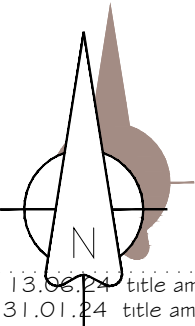

- DASHED LINE INDICATES LOCATION OF PREVIOUSLY APPROVED RED EDGE BOUNDARY
- DASHED LINE INDICATES LOCATION OF PREVIOUSLY APPROVED BUILDING LOCATION
- G 13.06.24 title amended to suit planner
F 31.01.24 title amended to suit planner
E 06.08.22 concrete apron added for Planning officer
D 08.02.21 plan amended to suit planners comments 05.02.21
C 13.01.21 red edge amended to all land access omitted
A 16.11.20 red edge amended for planner

Rev.	Date	Description
------	------	-------------

A.L.H. Design Services
Barley Cottage, Brewery Street, Longridge, Lancs
PR3 3NB, Tel & Fax : (01772) 785719

Client

Mr & Mrs S Rich,
Stella Maris,
Alston Lane,
Nr Preston Lancs,
PR3 3BN

Job/Scheme Title

FORMATION OF HARDSTANDING
AND AGRICULTURAL UNIT

Drawing Title

PROPOSED SITE PLAN
(As built)

Job/Scheme Number	Drawing Number
-------------------	----------------

0591/93 Drawing No 12G

Scale	Date	Drawn	Checked
-------	------	-------	---------

1 / 200 | Sept20 | a.t.l-h.