


NOTES

THIS DRAWING IS TO BE READ IN CONJUNCTION WITH ALL OTHER DRAWINGS FOR THIS PROJECT. ALL LEVELS AND DIMENSIONS ARE TO BE CHECKED ON SITE BY THE CONTRACTOR, PRIOR TO PLACING ORDERS OR COMMENCING ANY OF THE RELEVANT WORKS. ALL DIMENSIONS ARE IN MILLIMETRES UNLESS STATED OTHERWISE. ANY DISCREPANCIES BETWEEN THE INFORMATION SHOWN ON THE PLAN AND THAT FOUND ON SITE ARE TO BE REPORTED TO THE DESIGNER IMMEDIATELY.

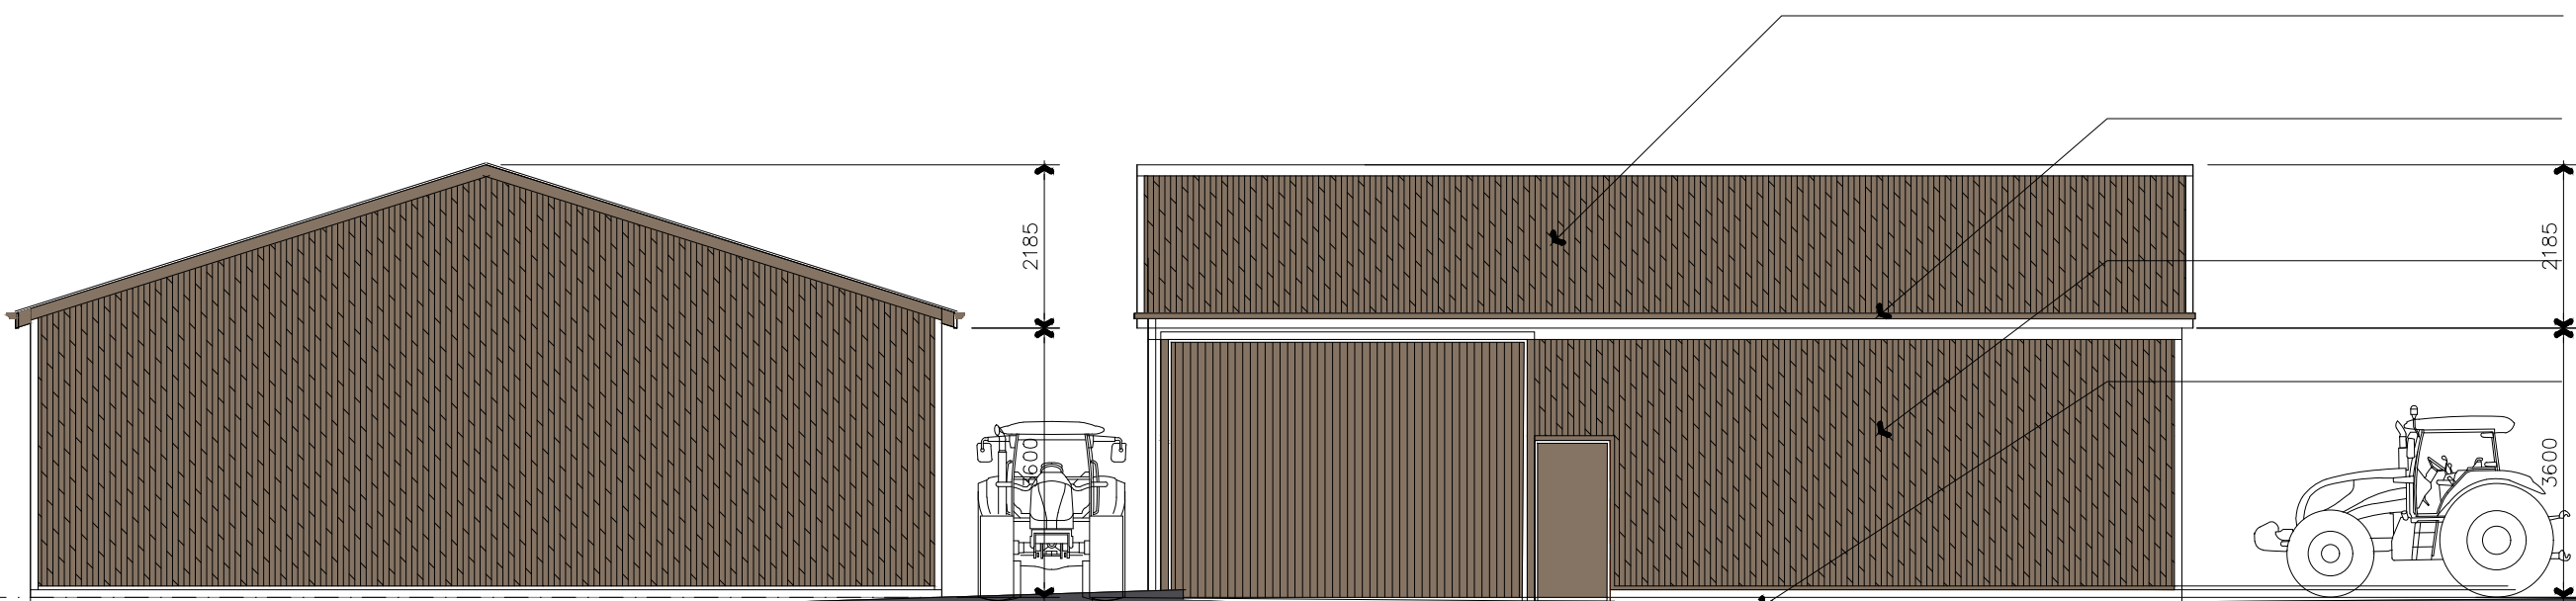

WEST ELEVATION

SOUTH ELEVATION

- C 13.06.24 Title amended to suit
- B 17.05.24 plan amended to suit as built on site
- A 08.02.21 plan amended to suit planners comments 05.02.21

Rev.	Date	Description
------	------	-------------

A.L.H. Design Services
Barley Cottage, Brewery Street, Longridge, Lancs
PR3 3NB, Tel & Fax : (01772) 785719

Client

Mr & Mrs S Rich,
Stella Maris,
Alston Lane,
Nr Preston Lancs,
PR3 3BN

Job/Scheme Title

ERECTION OF AGRICULTURAL
UNIT ON VACANT LAND AND
ASSOCIATED SITE WORKS

Drawing Title

PROPOSED ELEVATIONS AS
BUILT
(Sheet 1 of 2)

Job/Scheme Number	Drawing Number
-------------------	----------------

0591/93 Drawing No 15C

Scale	Date	Drawn	Checked
-------	------	-------	---------

1 / 100 | Nov 20 | a.t.l-h. |