



3/2024/0492 + 3/2024/0491
6181200

This drawing is the property of
BGArchitecture. It shall not be
copied or scanned, in part or whole,
without prior consent of
BGArchitecture. Do not scale this
drawing.

Key:




Garage approved under:
3/2017/0511



Container as part of Lawful development application:
3/2024/0492

PA3/2024/0491

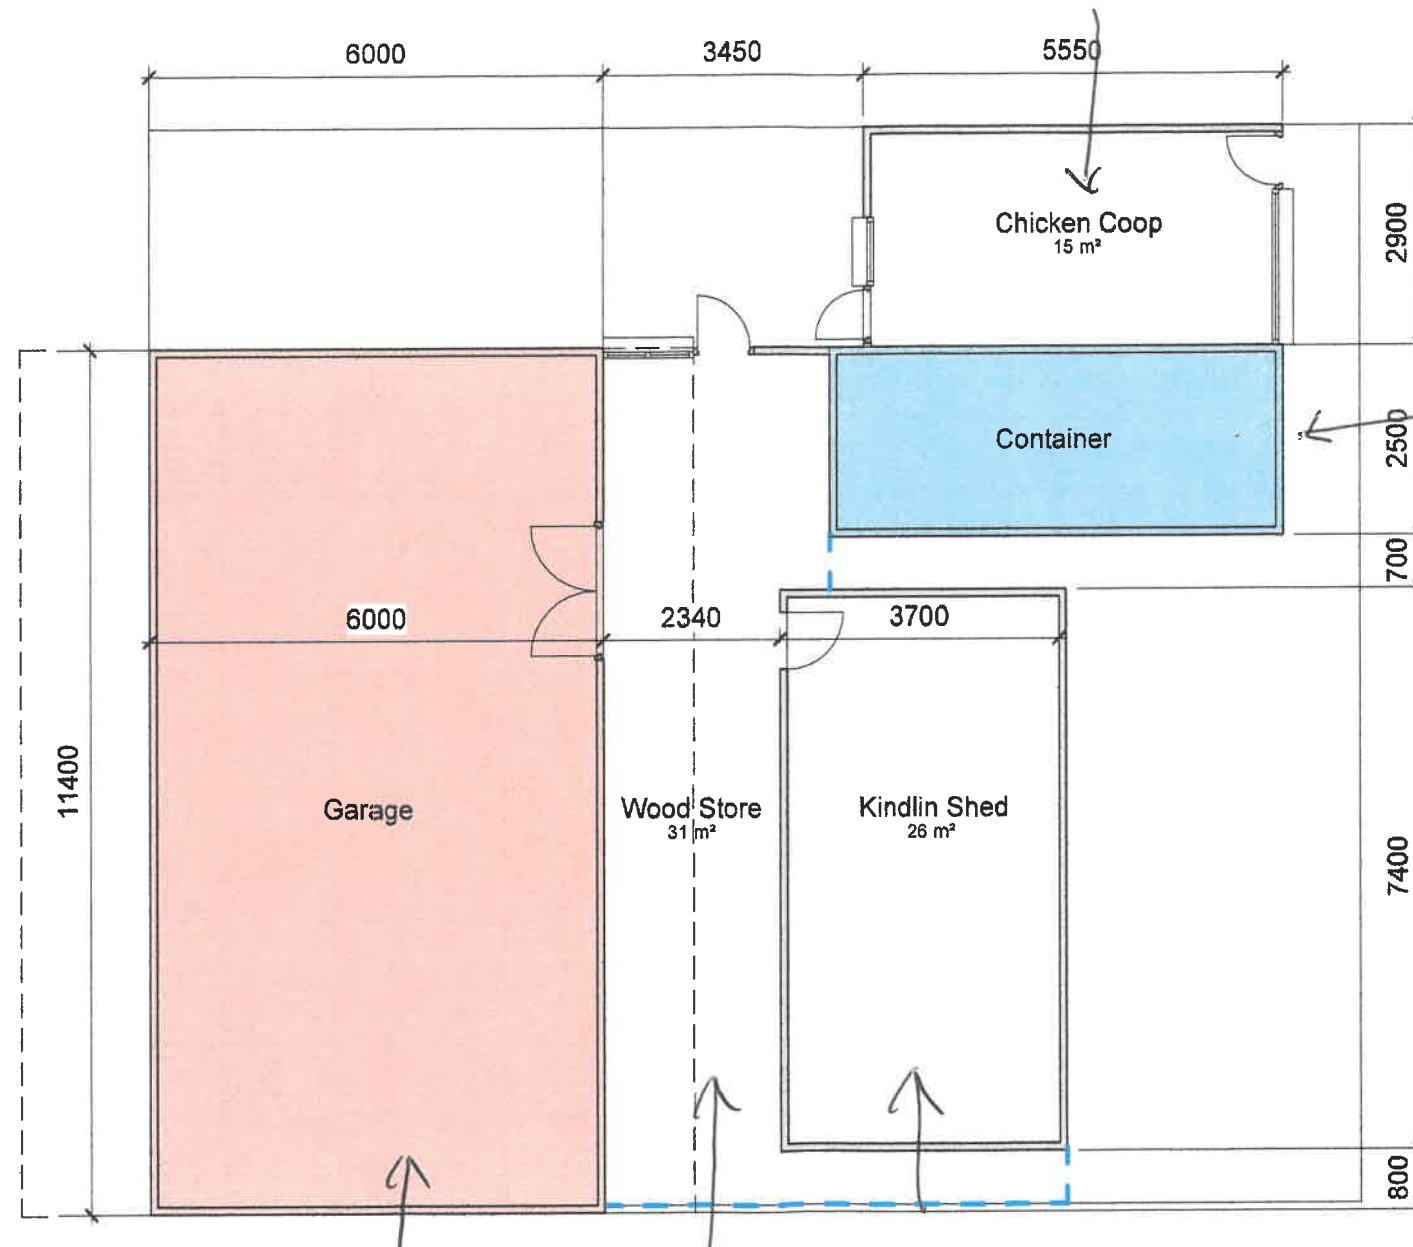

C of L
3/2024/0492

PA 3/2024/0491
PERMISSION GRANTED

Building Schedule

Name	Area
------	------

Garage	
Kindlin Shed	26 m²
Container	
Chicken Coop	15 m²
Wood Store	31 m²

Rev	Revision Note	Issued by	Date
-----	---------------	-----------	------

Client:

Robert Garnett

Project Title:

Retrospective Planing

Address:

Beacon Cottage
Carr Lane
BB2 7LN

Drawing Title:

Floor Plans

Drawing No:

BGA-BCO-004

Dwn:

BG

Scale:

As indicated

As indicated

Ckd:

BG

Paper Size:

A3

Rev:

Date:

02/08/24

Rev:

Rev:

Rev:

Floor Plan

1 : 100



1:100