




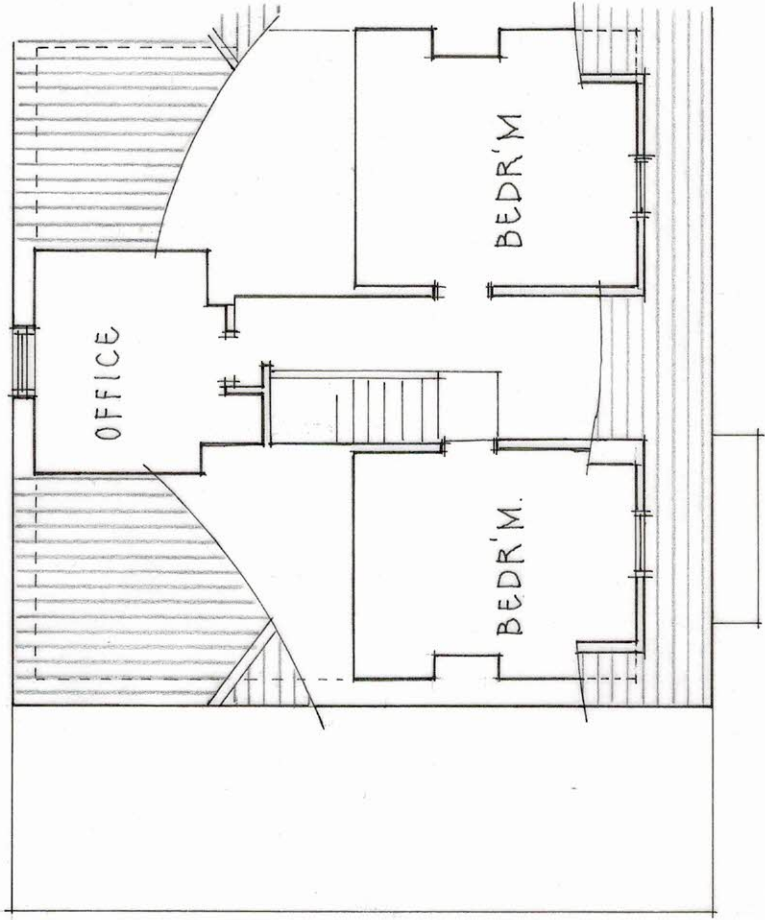


FIRST FLOOR PLAN

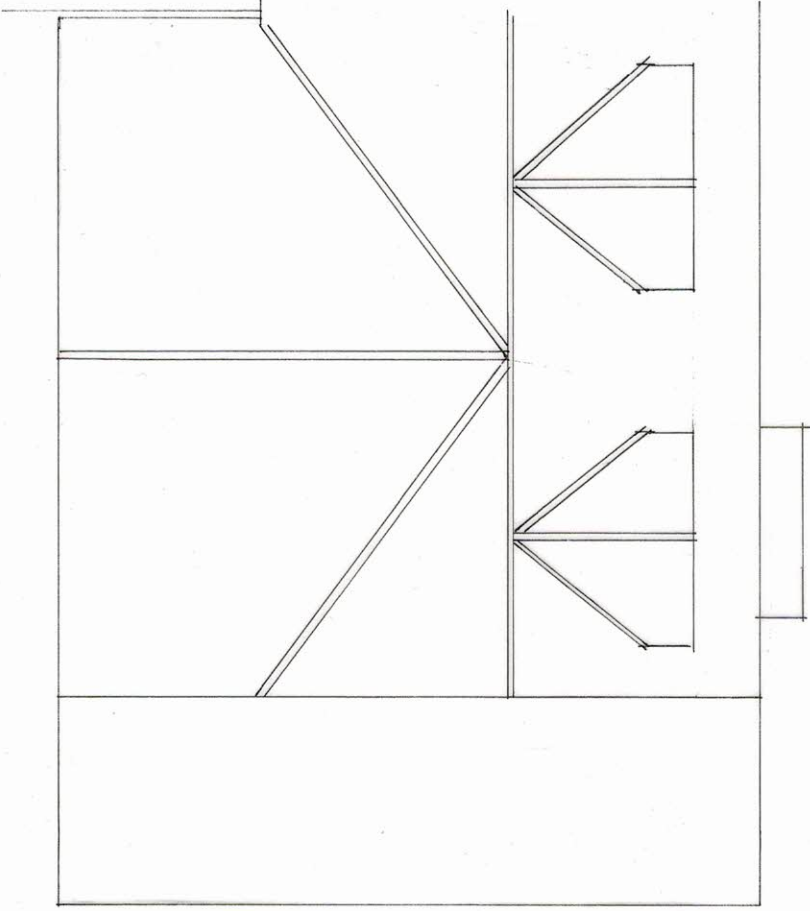


ROOF PLAN

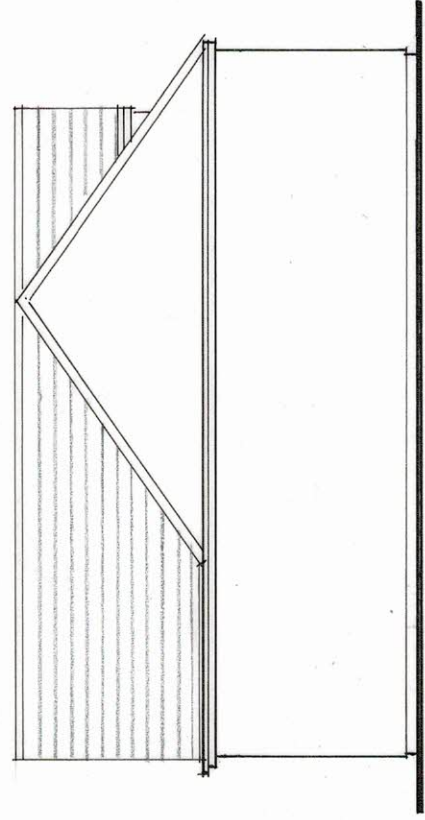


GABLE ELEVATION

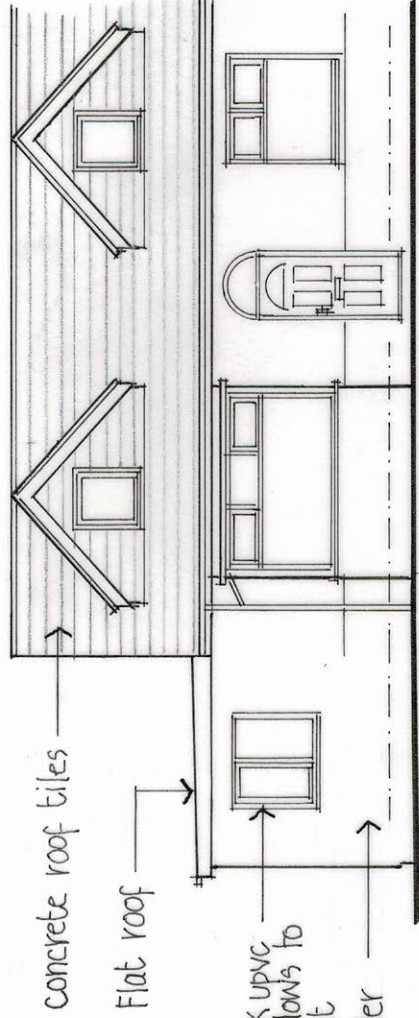


FRONT ELEVATION

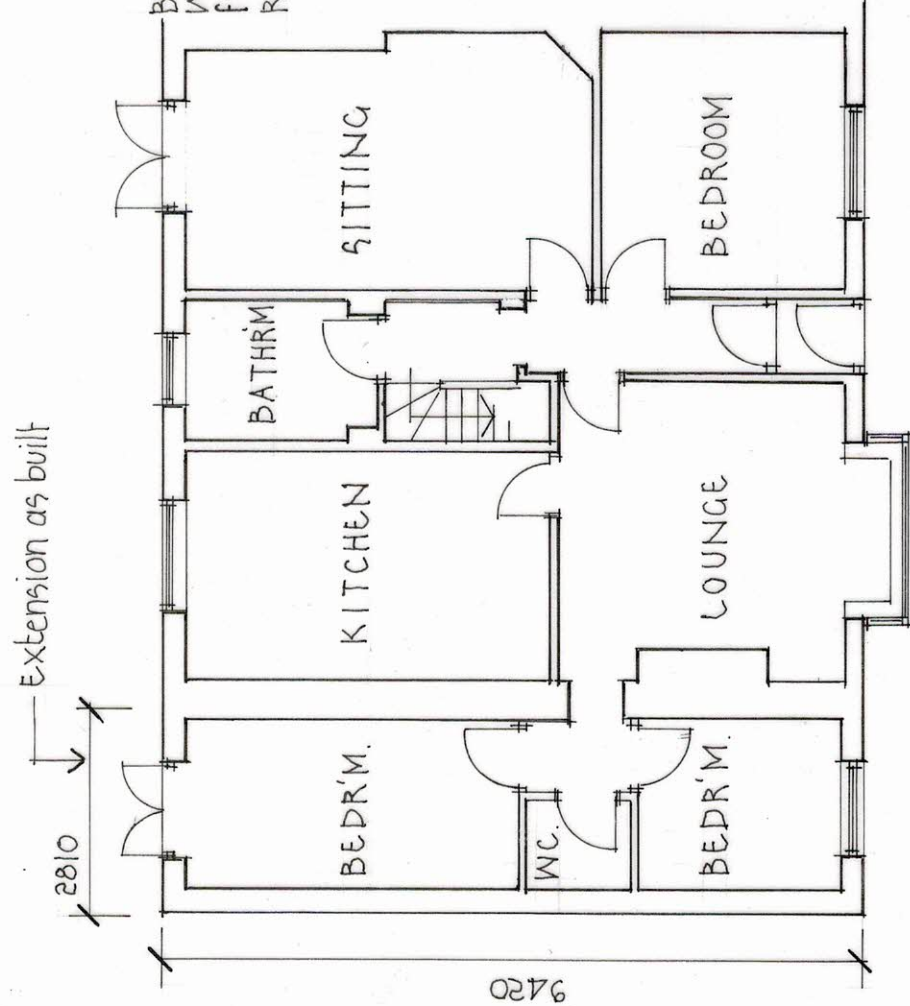

GROUND FLOOR PLAN

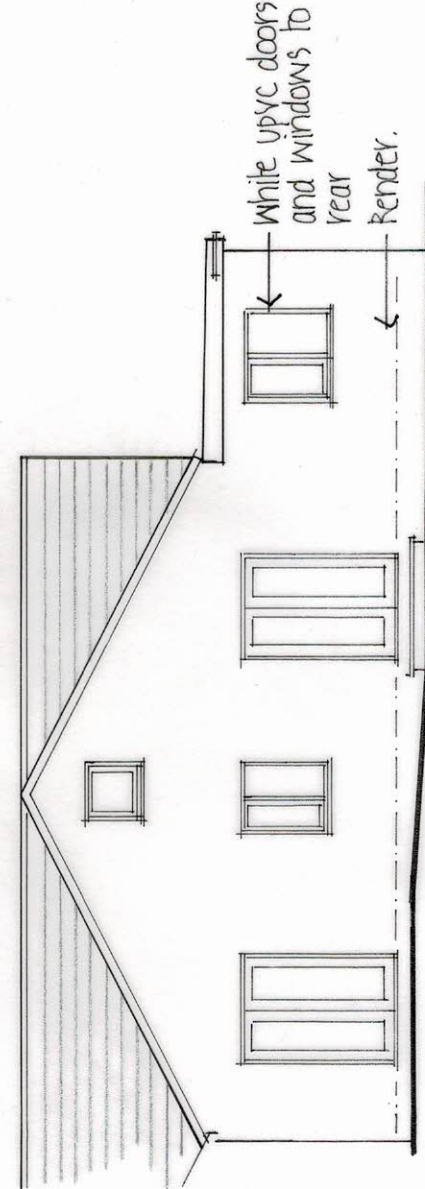

REAR ELEVATION

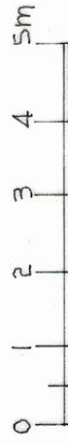

REVISION	DATE	DR	CH
----------	------	----	----

Architectural
Design
Partnership

Kirksyde
9 Castle Road
Colne
Lancashire BB8 7AR
Tel: 01282 861876

PROJECT
PROPOSED PITCHED ROOF TO BUILT
EXTENSION AT
26 WHALLEY ROAD
LANGHO

DRAWING TITLE
EXISTING PLANS AND ELEVATIONS

THIS DRAWING IS COPYRIGHT
THIS DRAWING IS NOT TO BE SCALED
ALL DIMENSIONS TO BE CHECKED ON SITE
BEFORE COMMENCEMENT OF WORK
ADP TO BE NOTIFIED OF ANY ERRORS

DRAWN	K J NOLAN	DATE	JULY 2024
CHECKED		SCALE	1:100 @ A3

DRAWING NO
709/2