




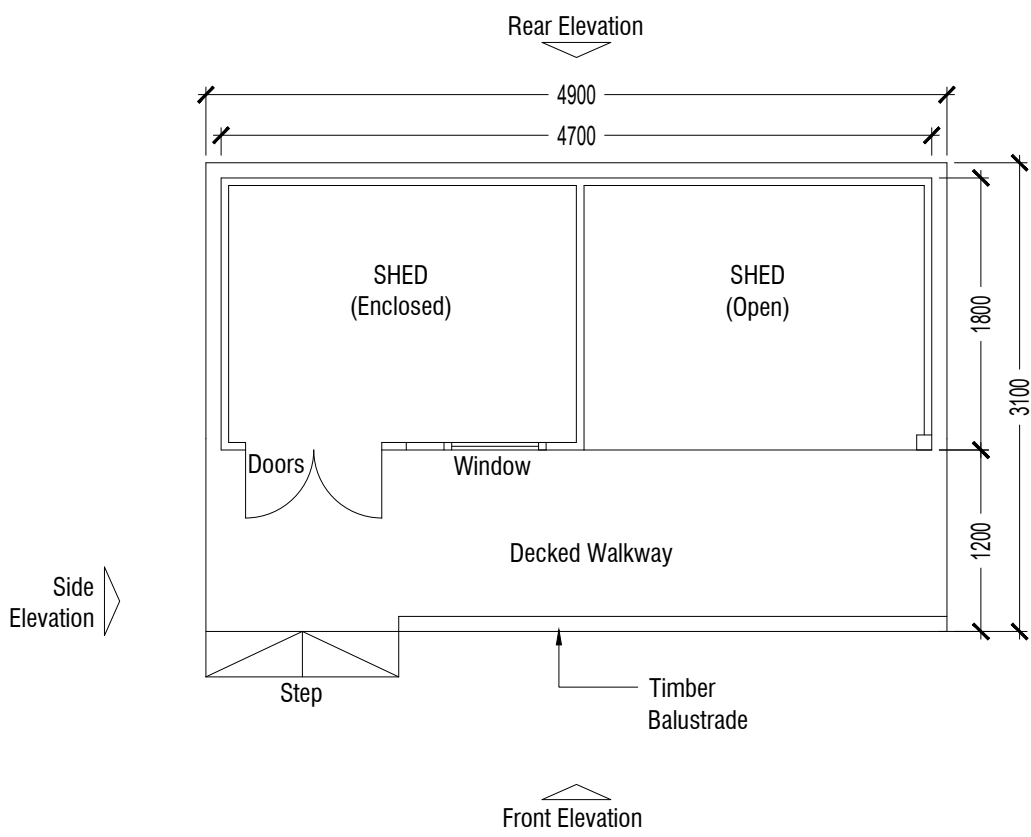


Floor Plan

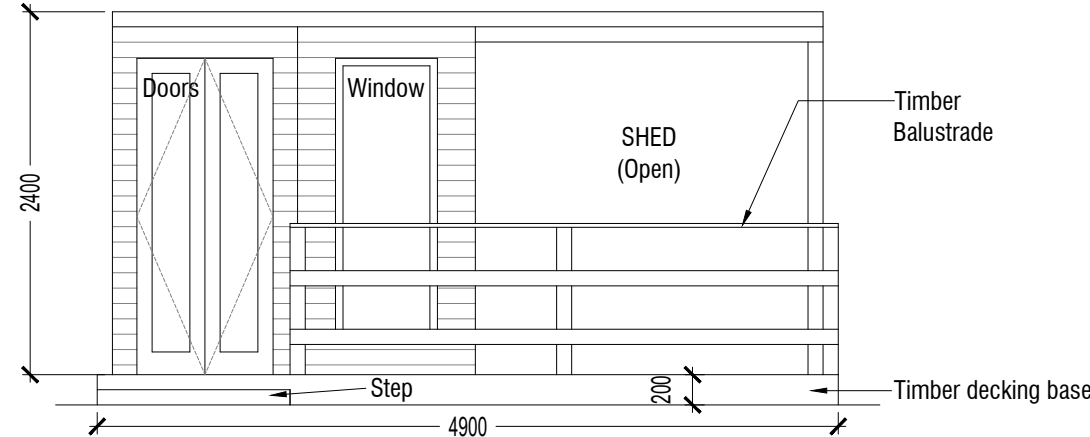

Front Elevation

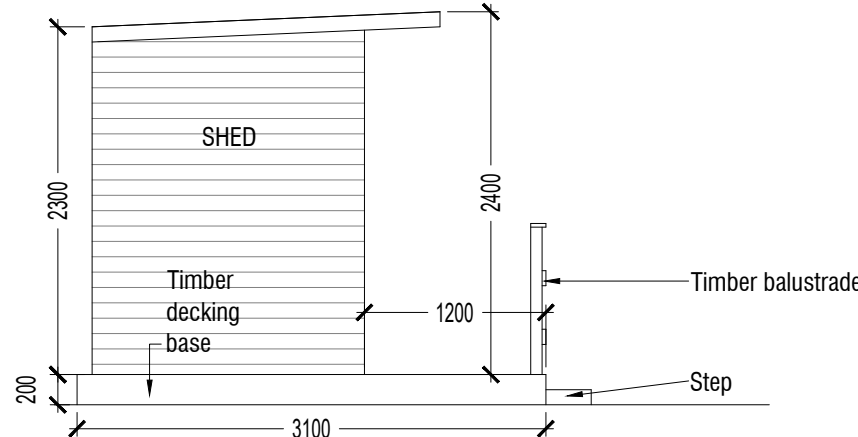

Side Elevation

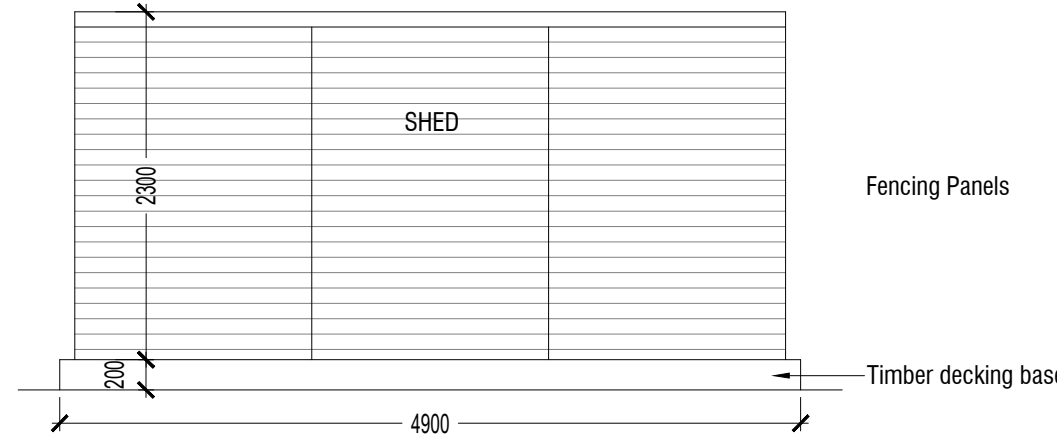

Rear Elevation

NOTES

This drawing is the property of Equilibrium Architects and copyright is reserved by them. This drawing is not to be copied or disclosed by or to any unauthorised persons without the prior written consent of Equilibrium Architects.

Do not scale from this drawing.

All dimensions are to be checked on site prior to construction, manufacture of any components and ordering of materials and equipment.

Any discrepancies are to be reported to the architect for clarification.

All materials and workmanship to be in accordance with the current British Standards and codes of practice.

This drawing is to be read in conjunction with all relevant Architectural, Structural Engineers, Mechanical Engineers, Electrical Engineers and Specialists drawings and specifications.

As with all construction projects the CDM 2015 regulations apply and the work on this project may require both the issue of a notification to the HSE (because of the duration of the works on site) and the client may also need to appoint a Principal Designer because there may be more than one contractor working on site. The Principal Designer will be able to coordinate the pre-construction information and also ensure that all duty holders under CDM comply with their relevant duties.

The building owner is to serve a Party Wall Act Notice as applicable to adjoining property owners as outlined in The Party Wall Act 1996. The Building Contractor is to verify the thickness of the party walls prior to commencement of the proposed works.



PROPOSED HOT TUB PLAN SCALE 1:500

B	Updated plan	PM	24.07.24
A	Amended the blue line as per client	PM	23.07.24
REV	DESCRIPTION	CHECK	DATE

CLIENT
Jonathan Butterworth

PROJECT
The Higher Trapp Country House Hotel,
Simonstone, BB12 7QW. Outdoor Hot Tubs

DRAWING
Proposed Hot Tub Enclosures

SCALE	DATE	DRAWN	CHECKED
1:500@A1	July 2024	PM	
DRAWING NO.	CAD REFERENCE NO.	REVISION	
C-0533-40		B	



2A Bank Street Bury Lancashire BL9 0LA T: 0161 797 2077 F: 0161 797 2088
info@equilibriumarchitects.co.uk www.equilibriumarchitects.co.uk