


Retrospective planning consent for the retention of an air source heat pump system within 1m of the boundary. Air source heat pump model No.AG2Pro-09N8D0-Q(U)


PROPOSED ACOUSTIC ENCLOSURE DETAILS:

JAKOUSTIC ACOUSTIC FENCING


LENGTH: 1300mm
WIDTH: 560mm
HEIGHT: 1500mm

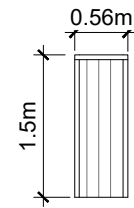

Side Elevations

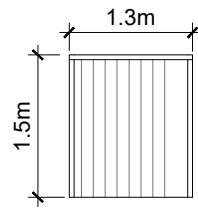


Front Elevation

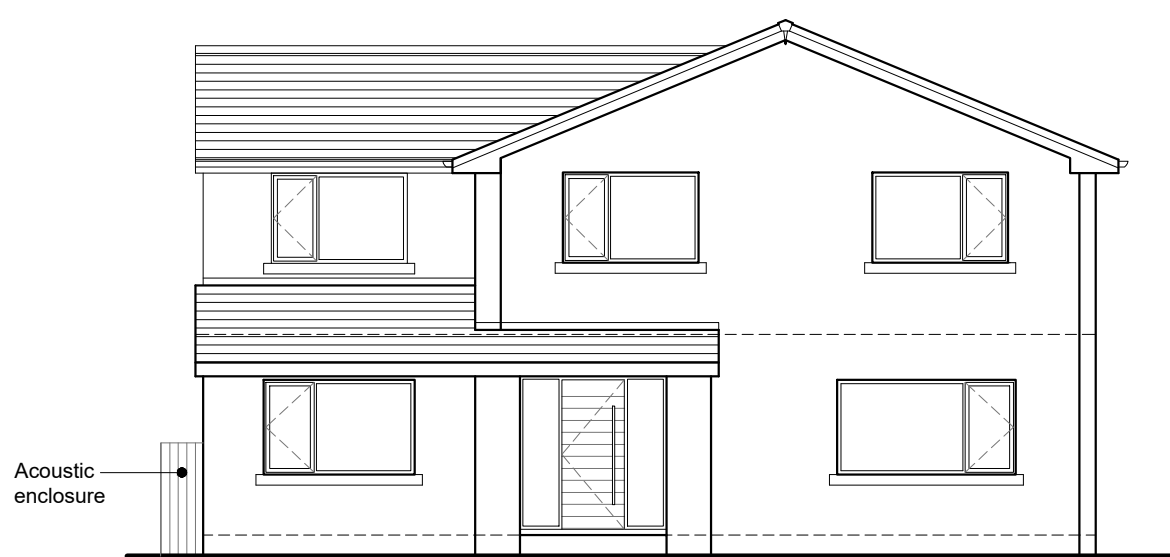


NORTH ELEVATION

Scale 1:100

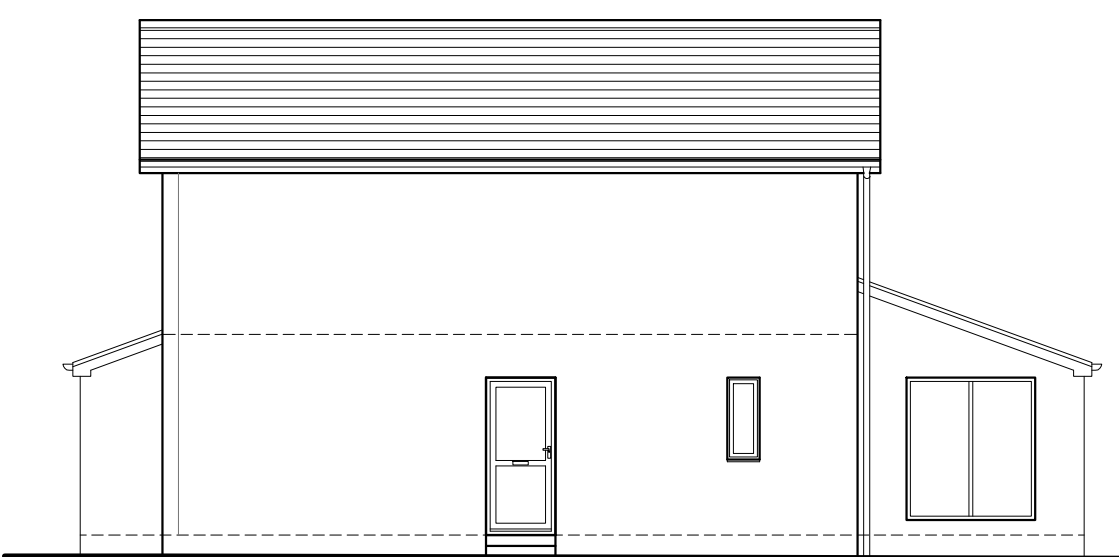


WEST ELEVATION

Scale 1:100

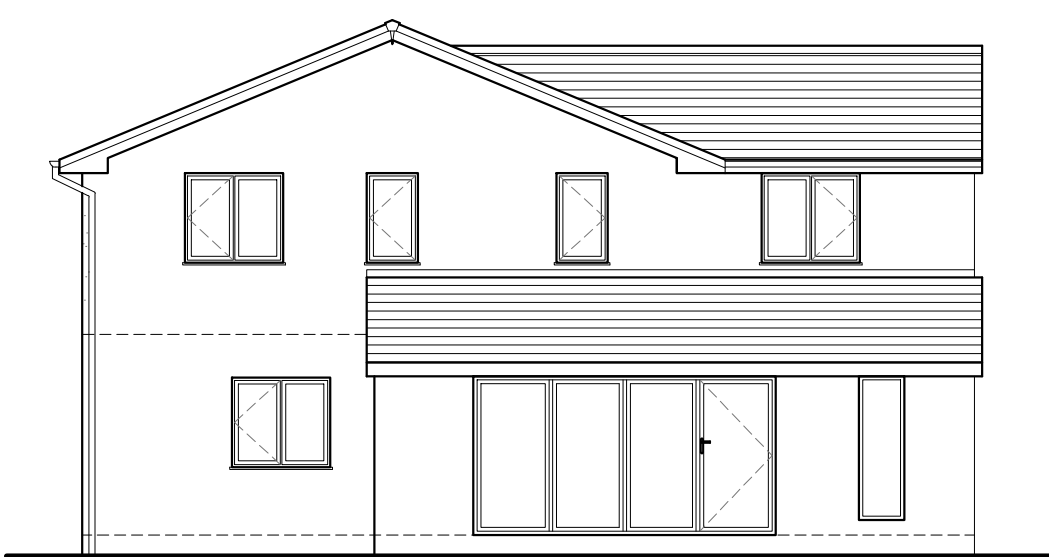


SOUTH ELEVATION

Scale 1:100

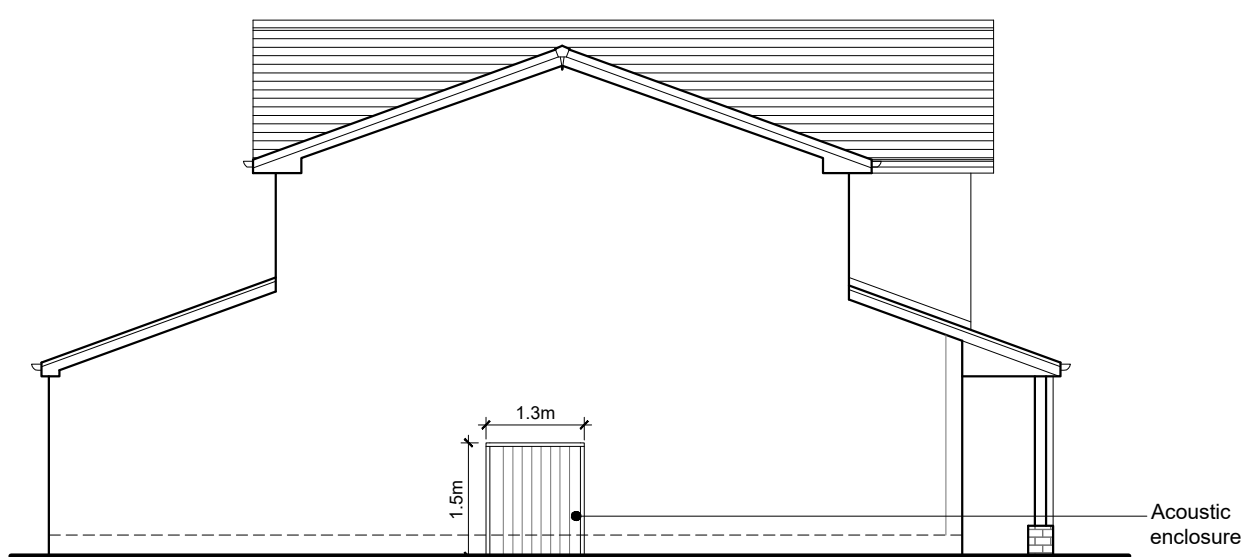

EAST ELEVATION

Scale 1:100

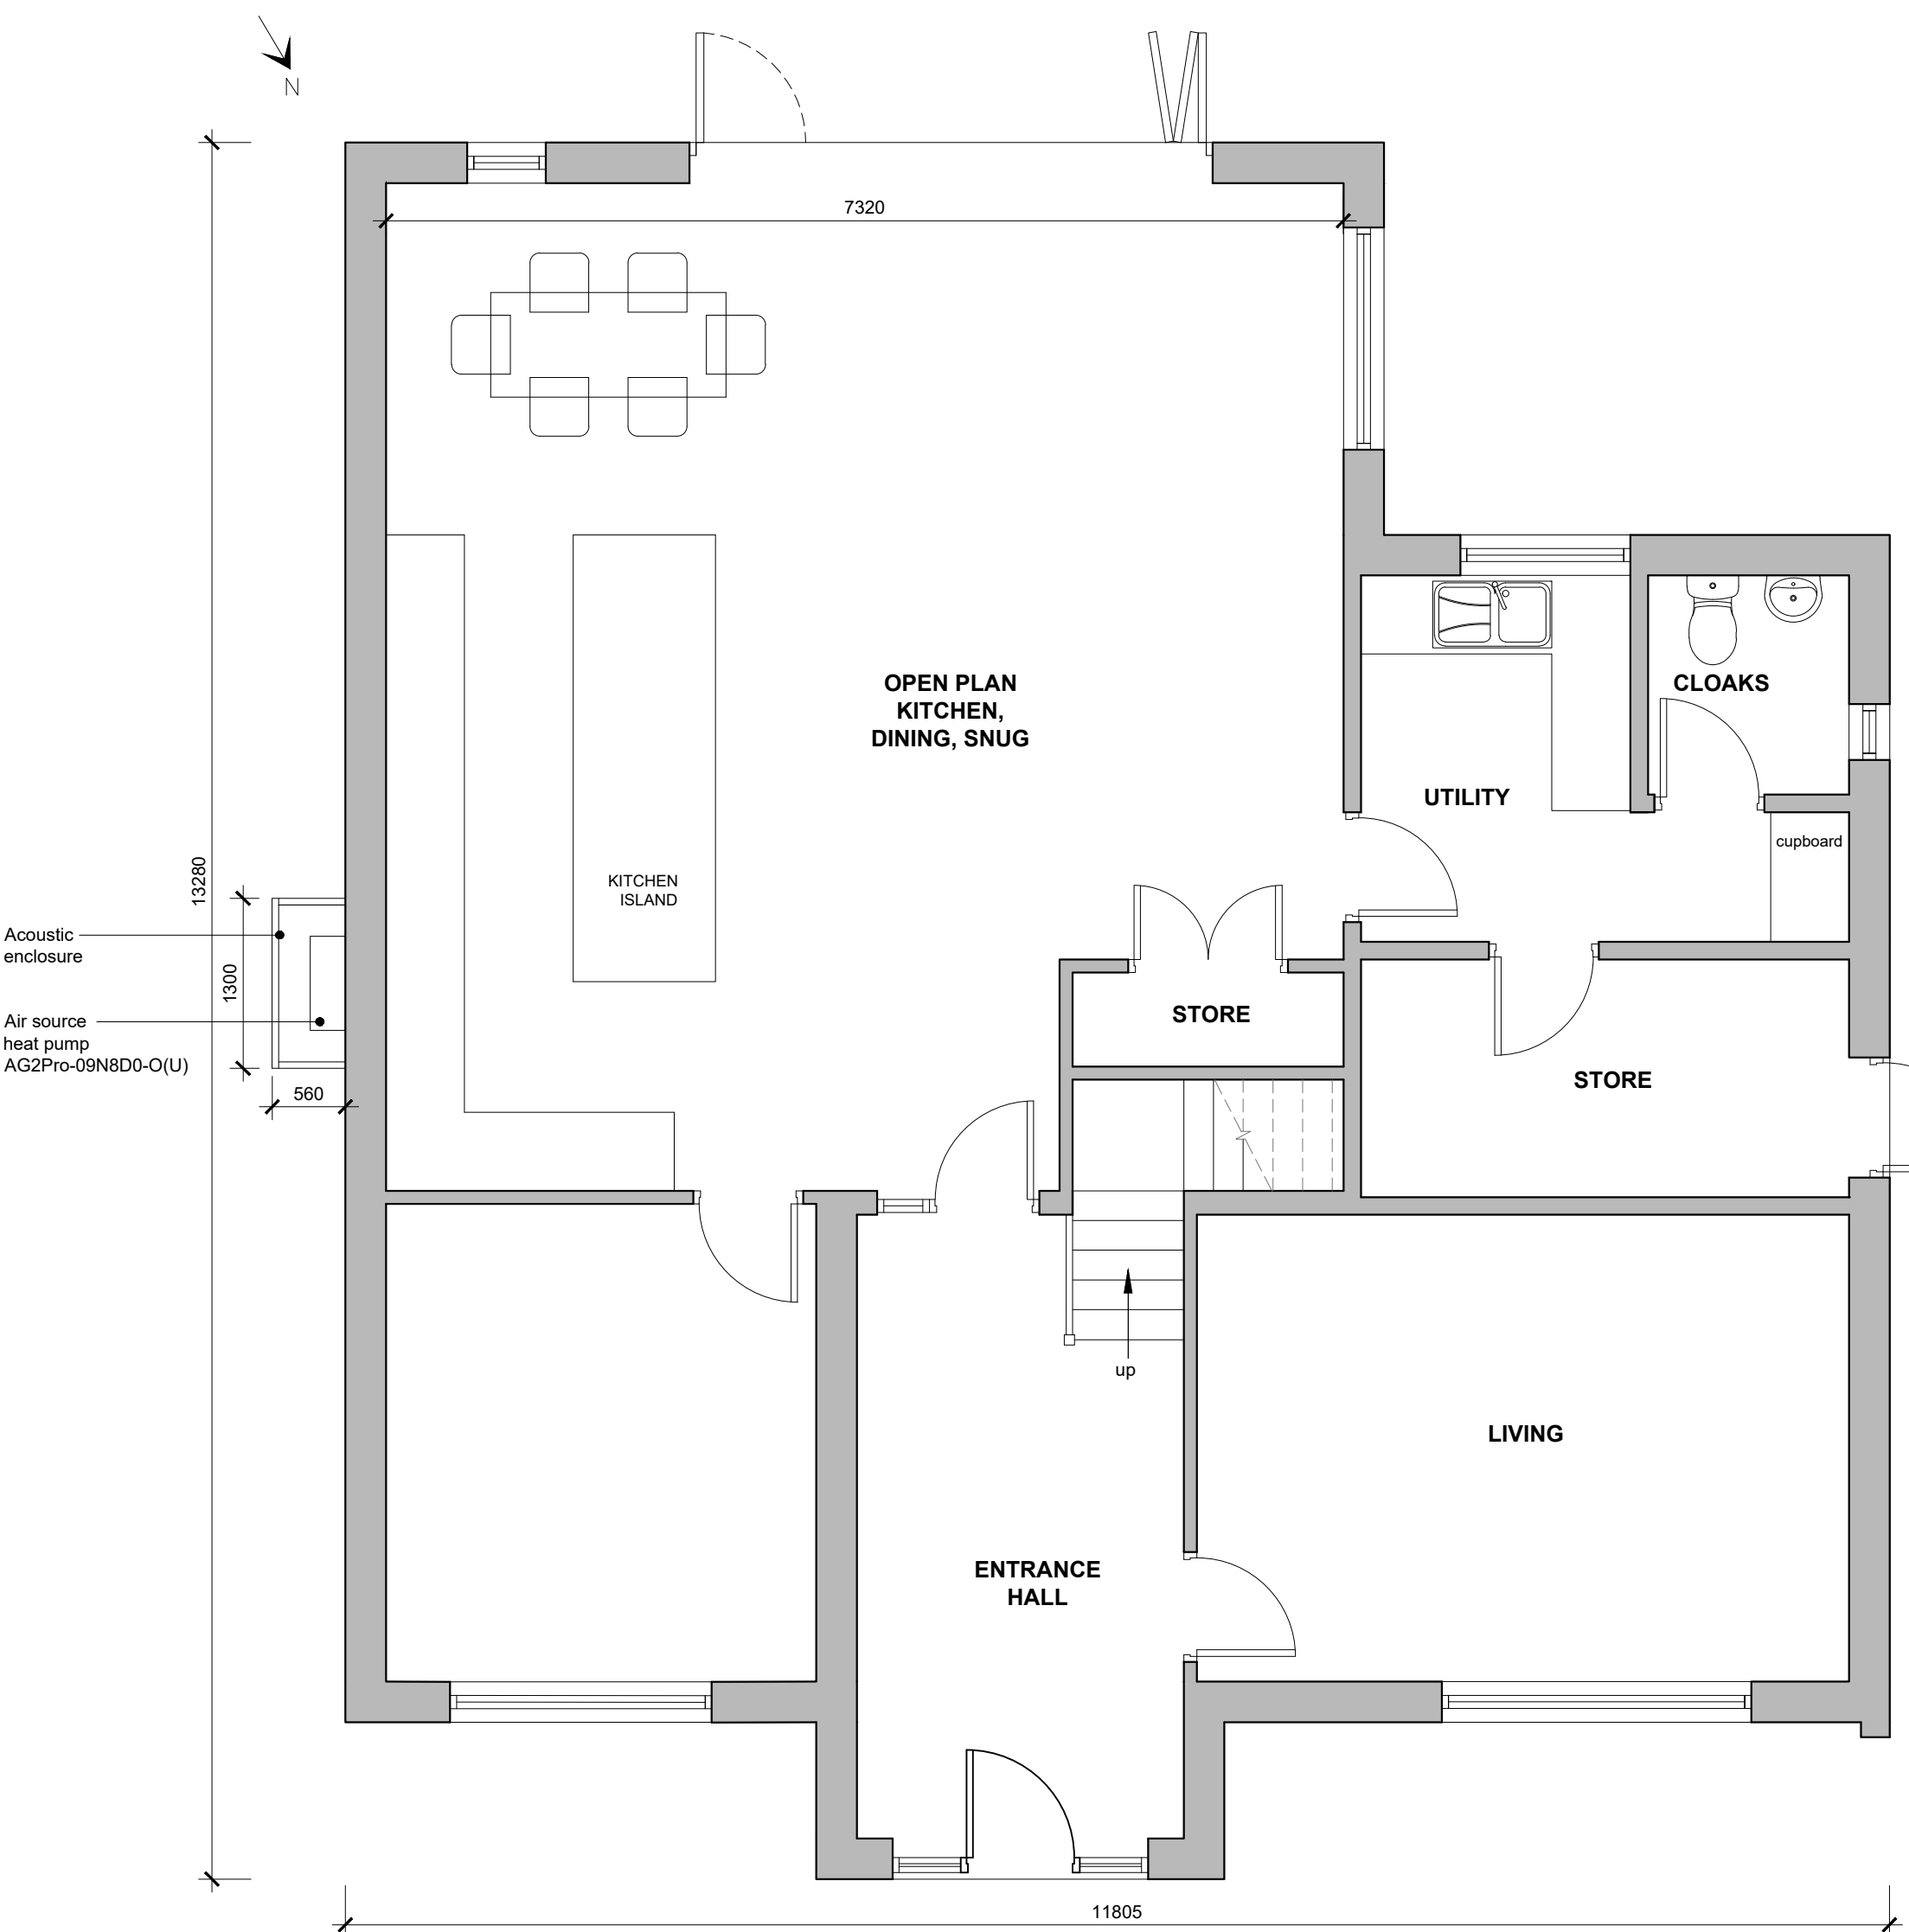


GROUND FLOOR PLAN

Scale 1:50



FIRST FLOOR PLAN

Scale 1:50

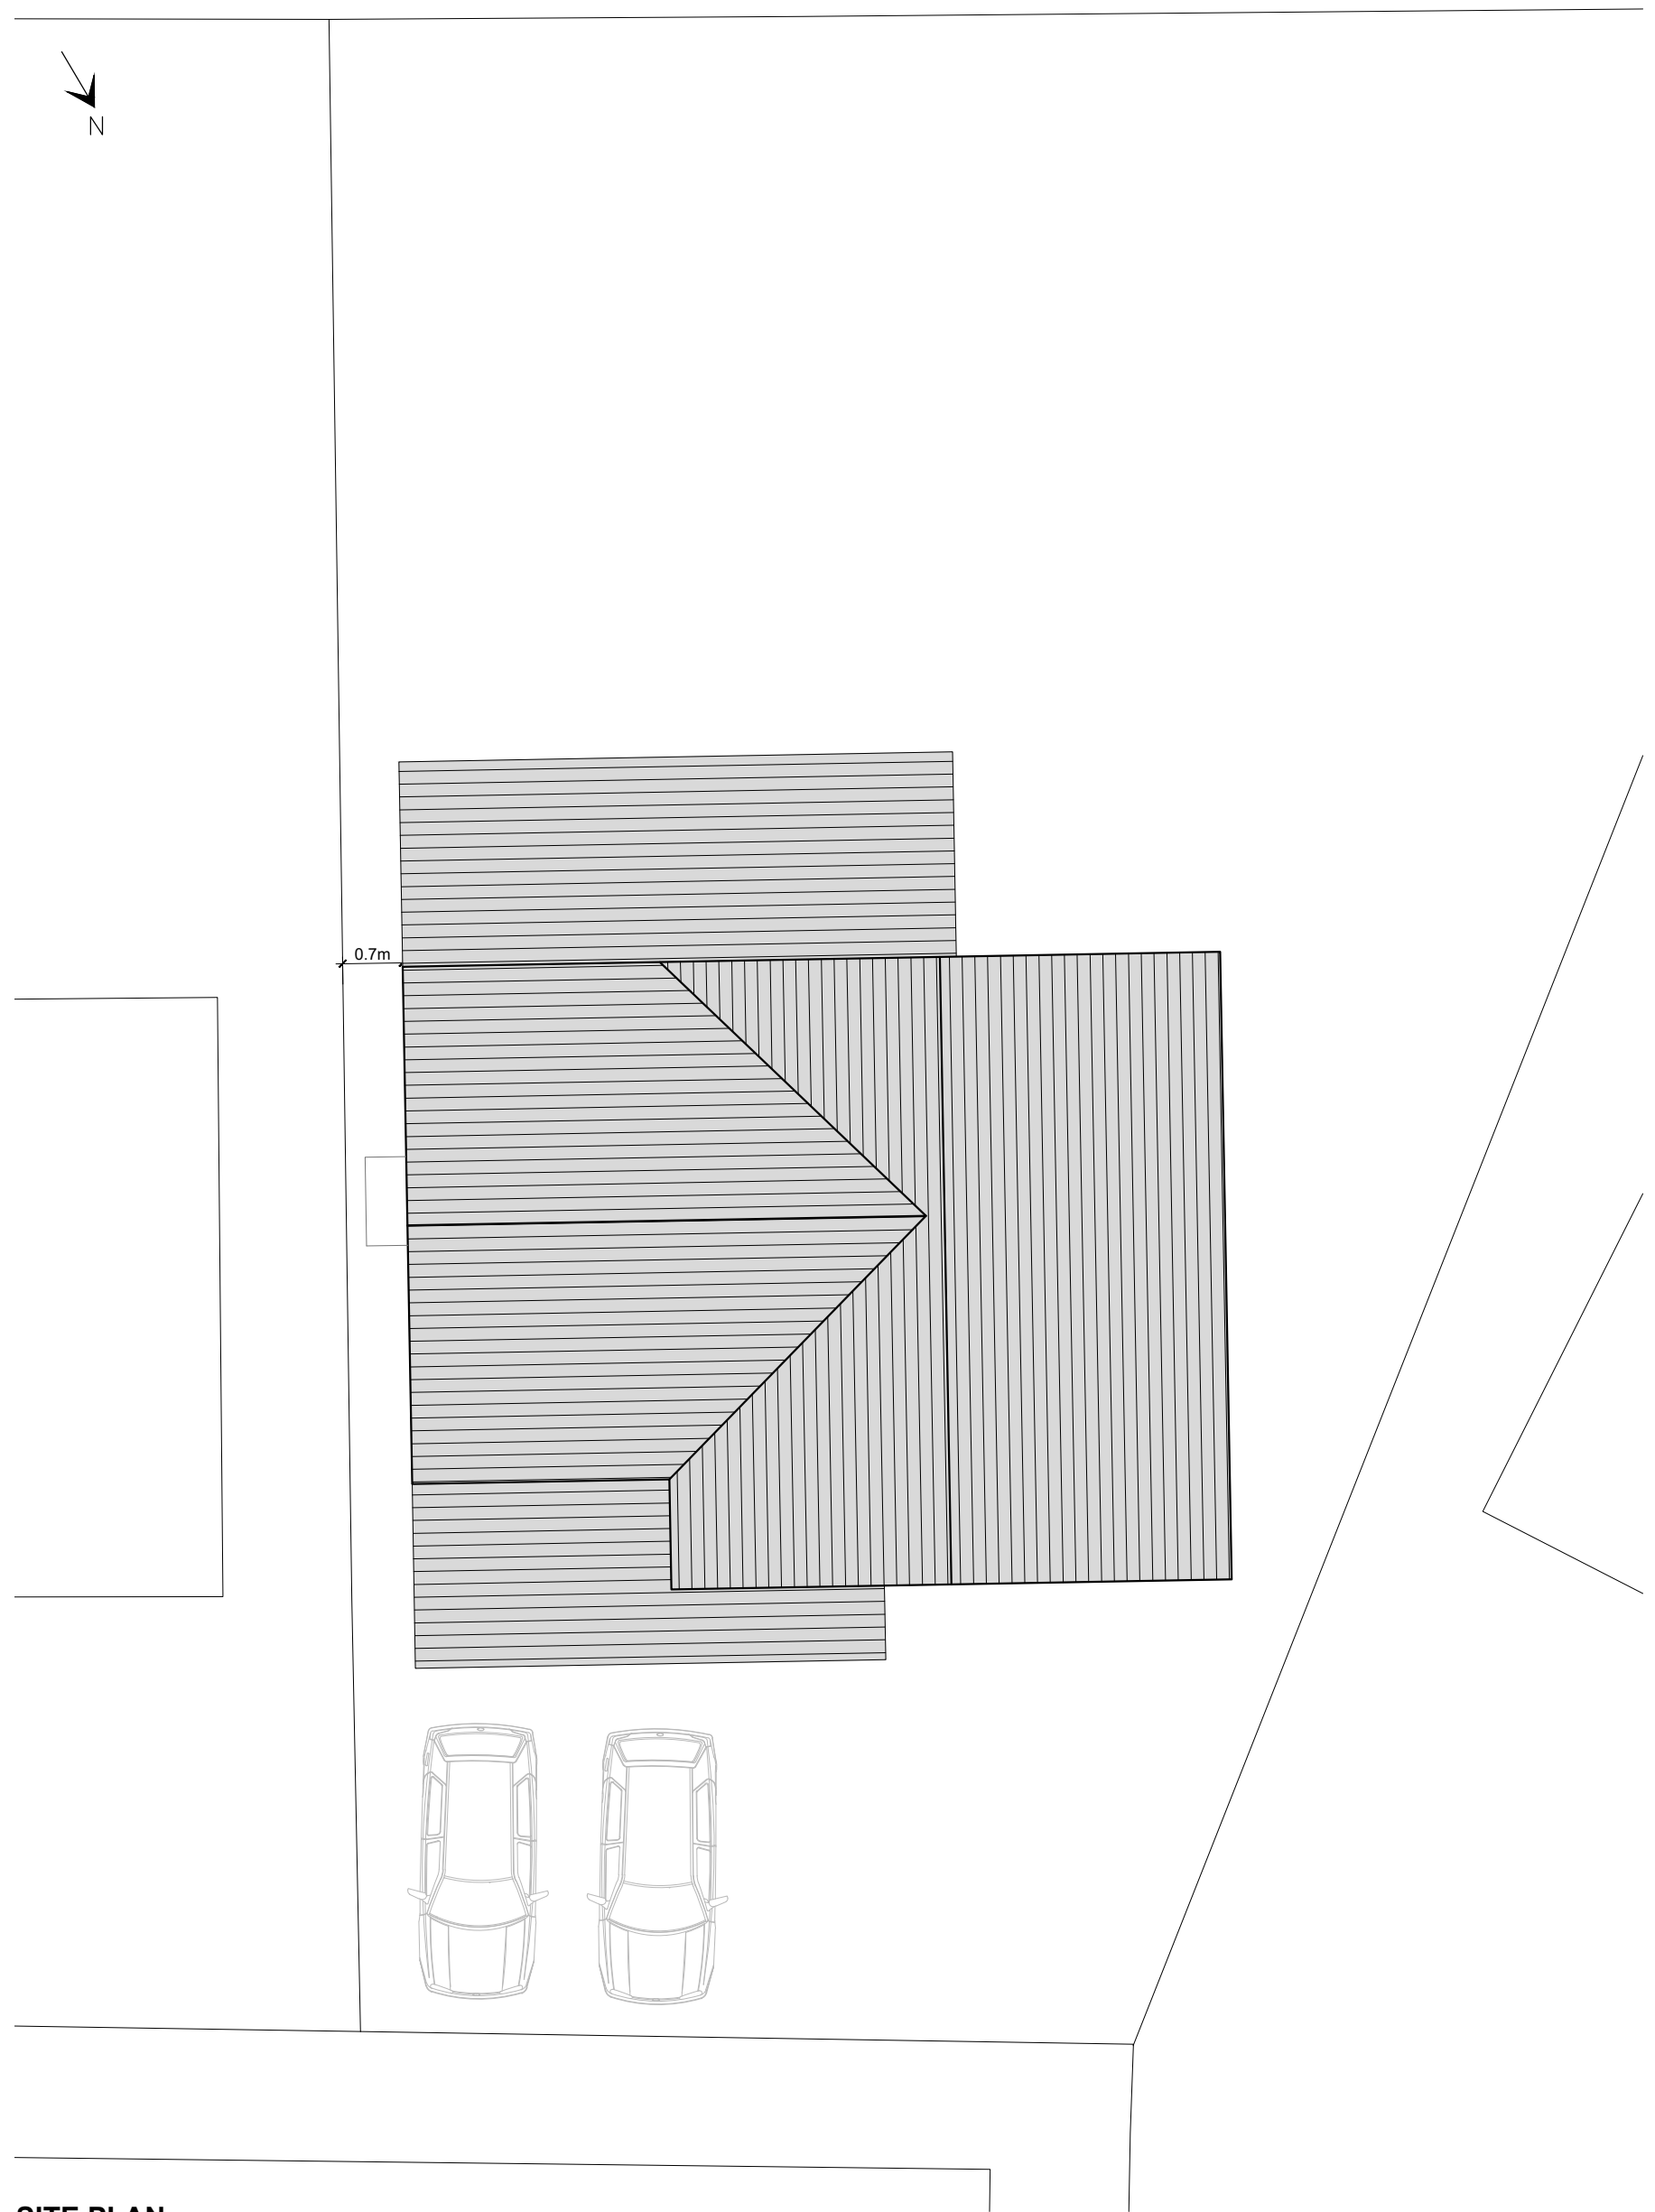

SITE PLAN

Scale 1:100