
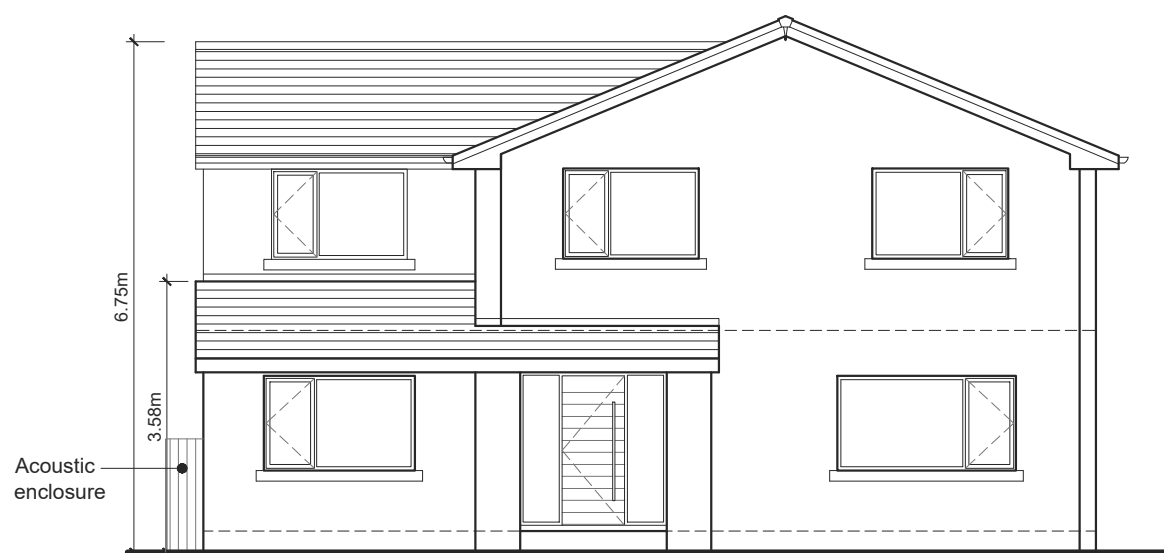


Retrospective planning consent for the retention of an air source heat pump system within 1m of the boundary. Air source heat pump model No.AG2Pro-09N8D0-Q(U)


PROPOSED TIMBER SCREENING / ACOUSTIC ENCLOSURE DETAILS:

LENGTH: 1100mm
WIDTH: 600mm
HEIGHT: 1500mm

100mm x 25mm 'hit and miss' timber cladding acoustic panel with 75 x 75mm timber posts.

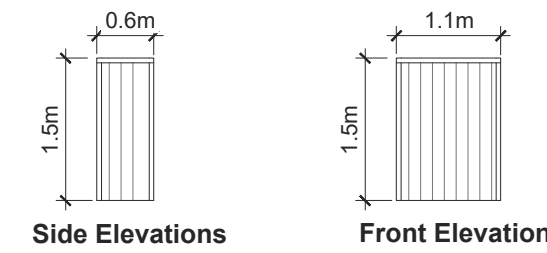


NORTH ELEVATION
Scale 1:100

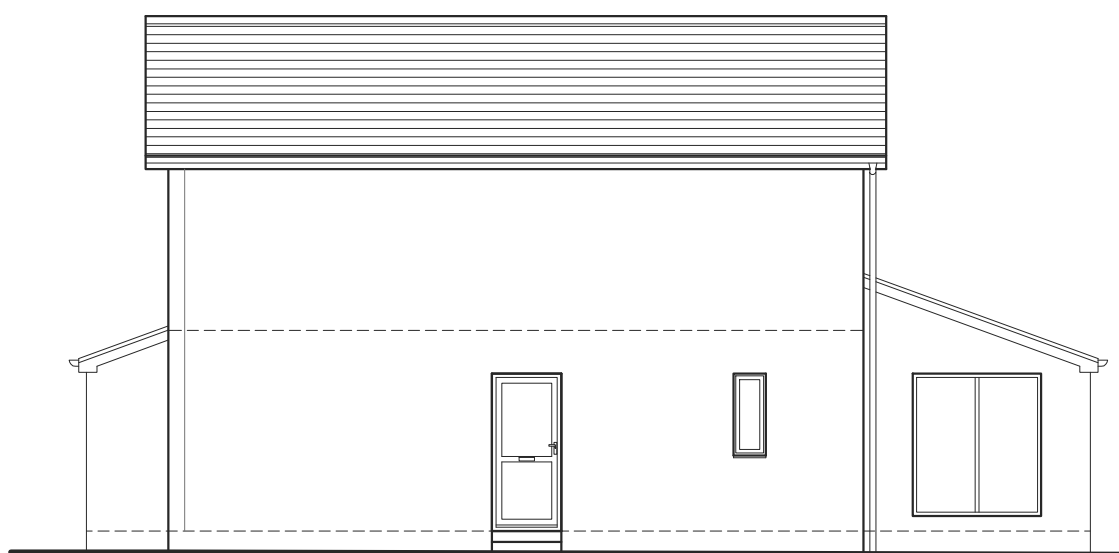


WEST ELEVATION
Scale 1:100



SOUTH ELEVATION
Scale 1:100

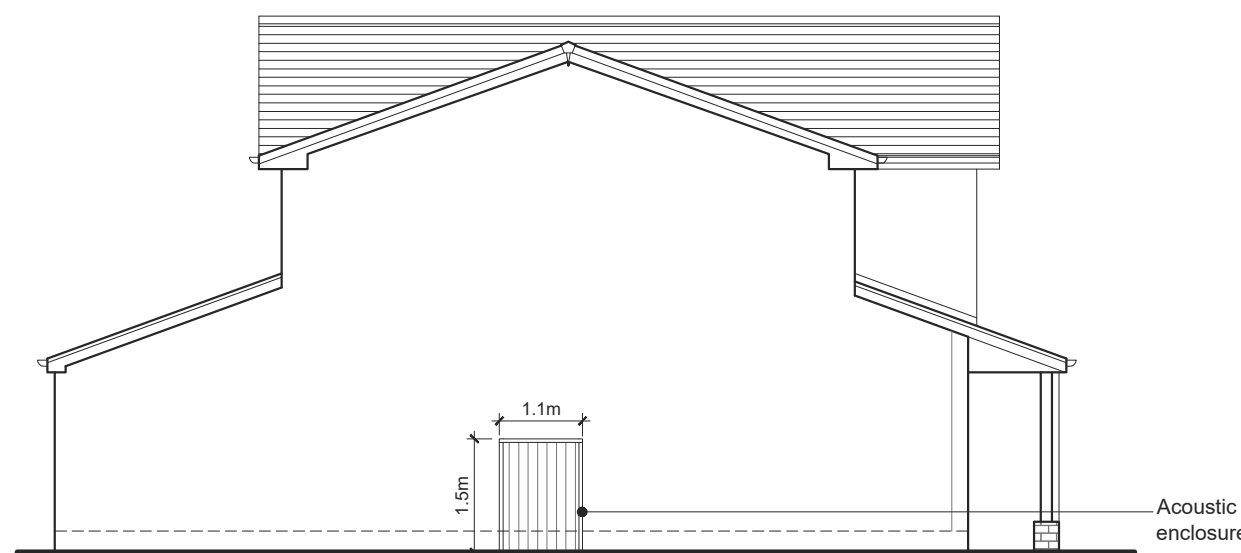


EAST ELEVATION
Scale 1:100

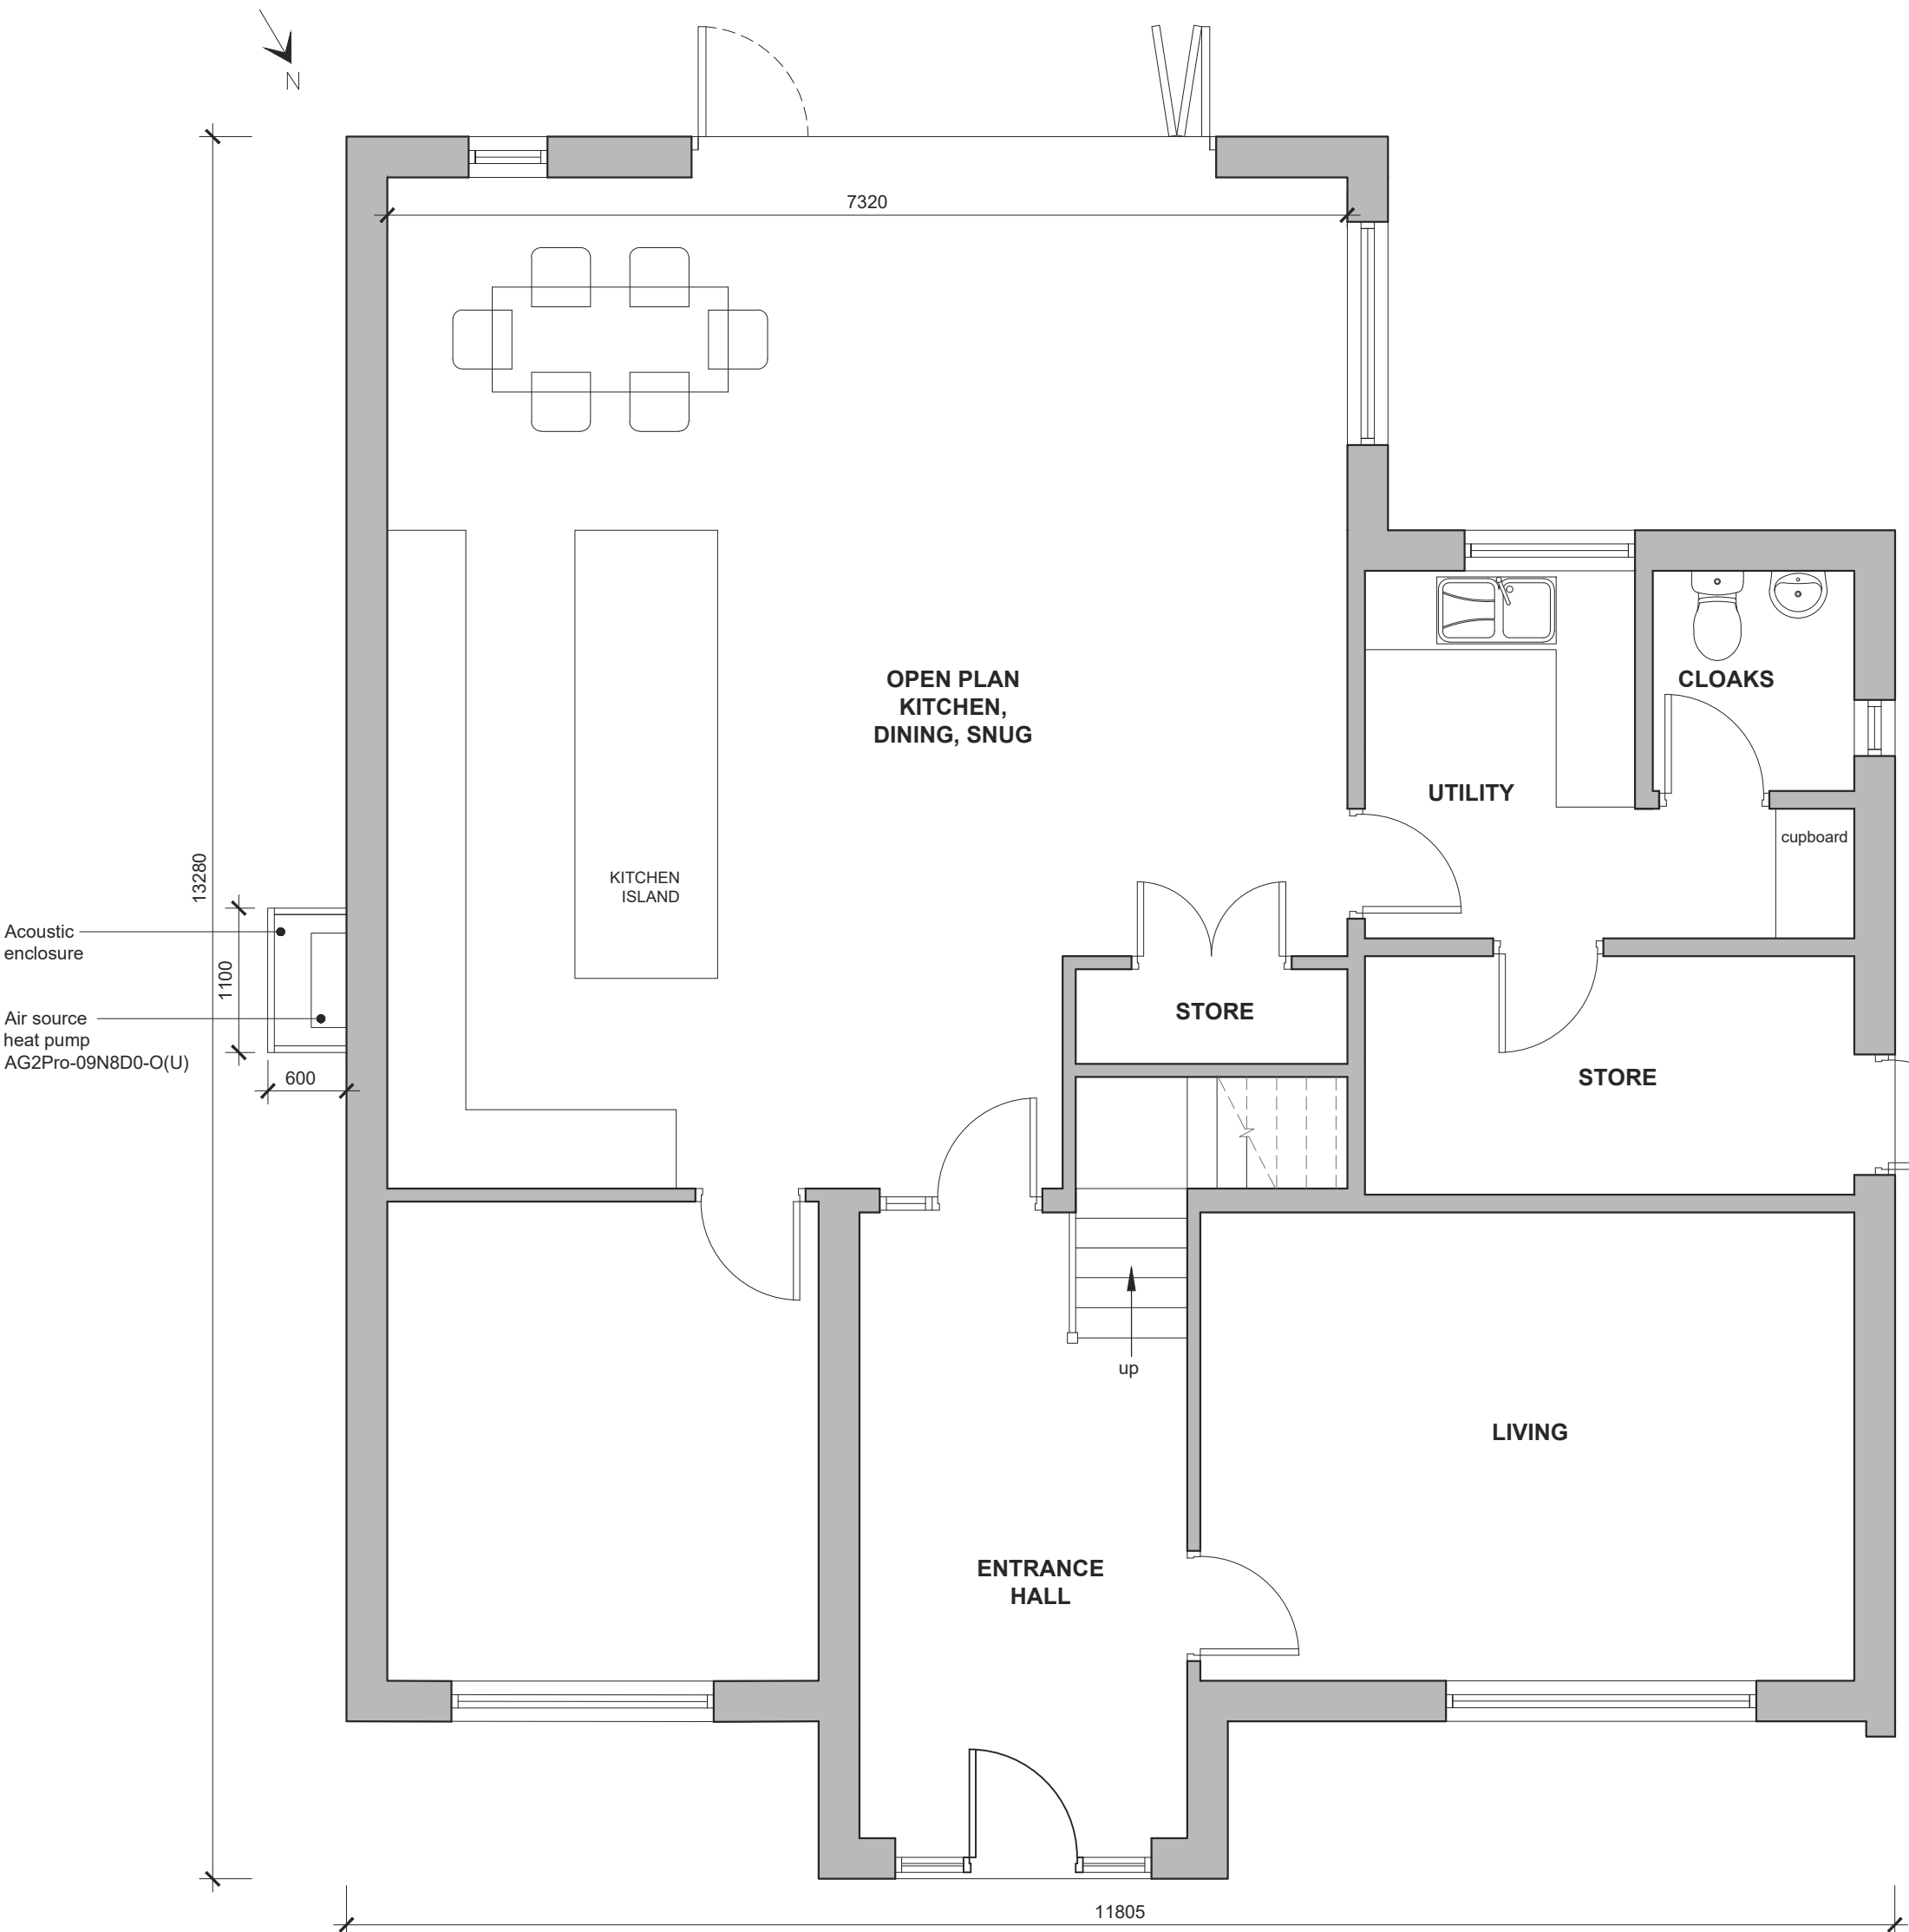

GROUND FLOOR PLAN
Scale 1:50



FIRST FLOOR PLAN
Scale 1:50

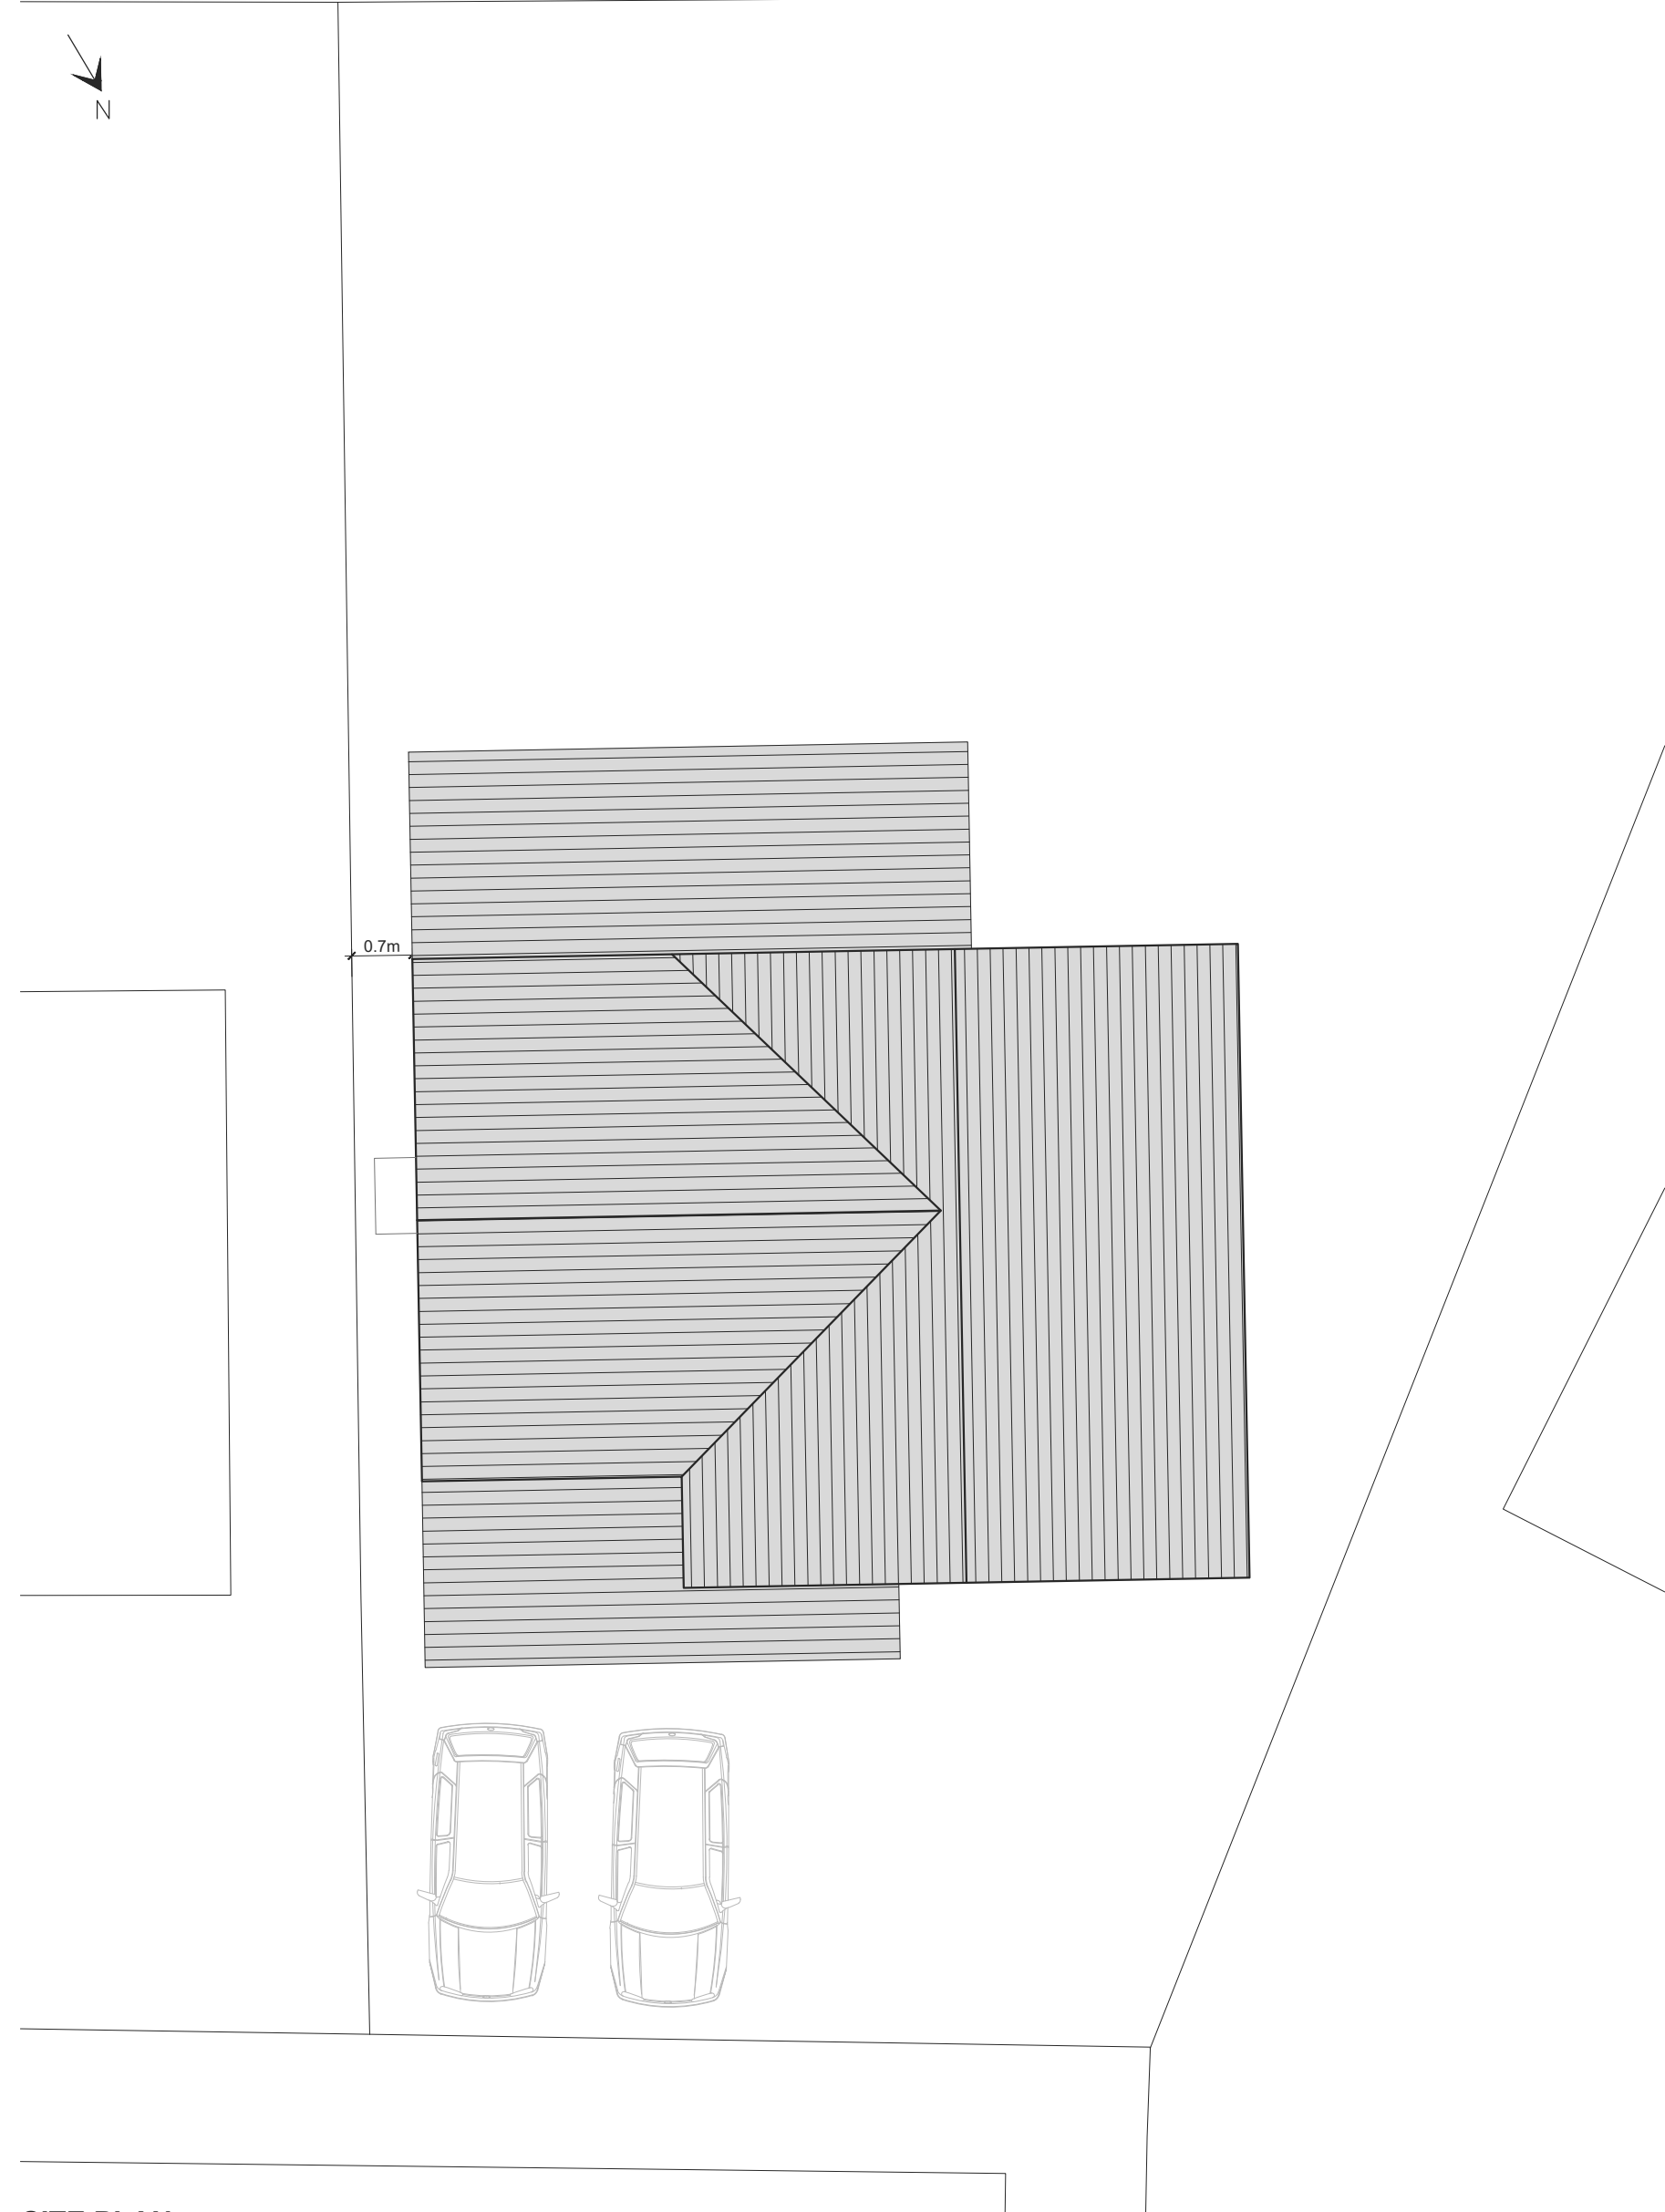

SITE PLAN
Scale 1:100